



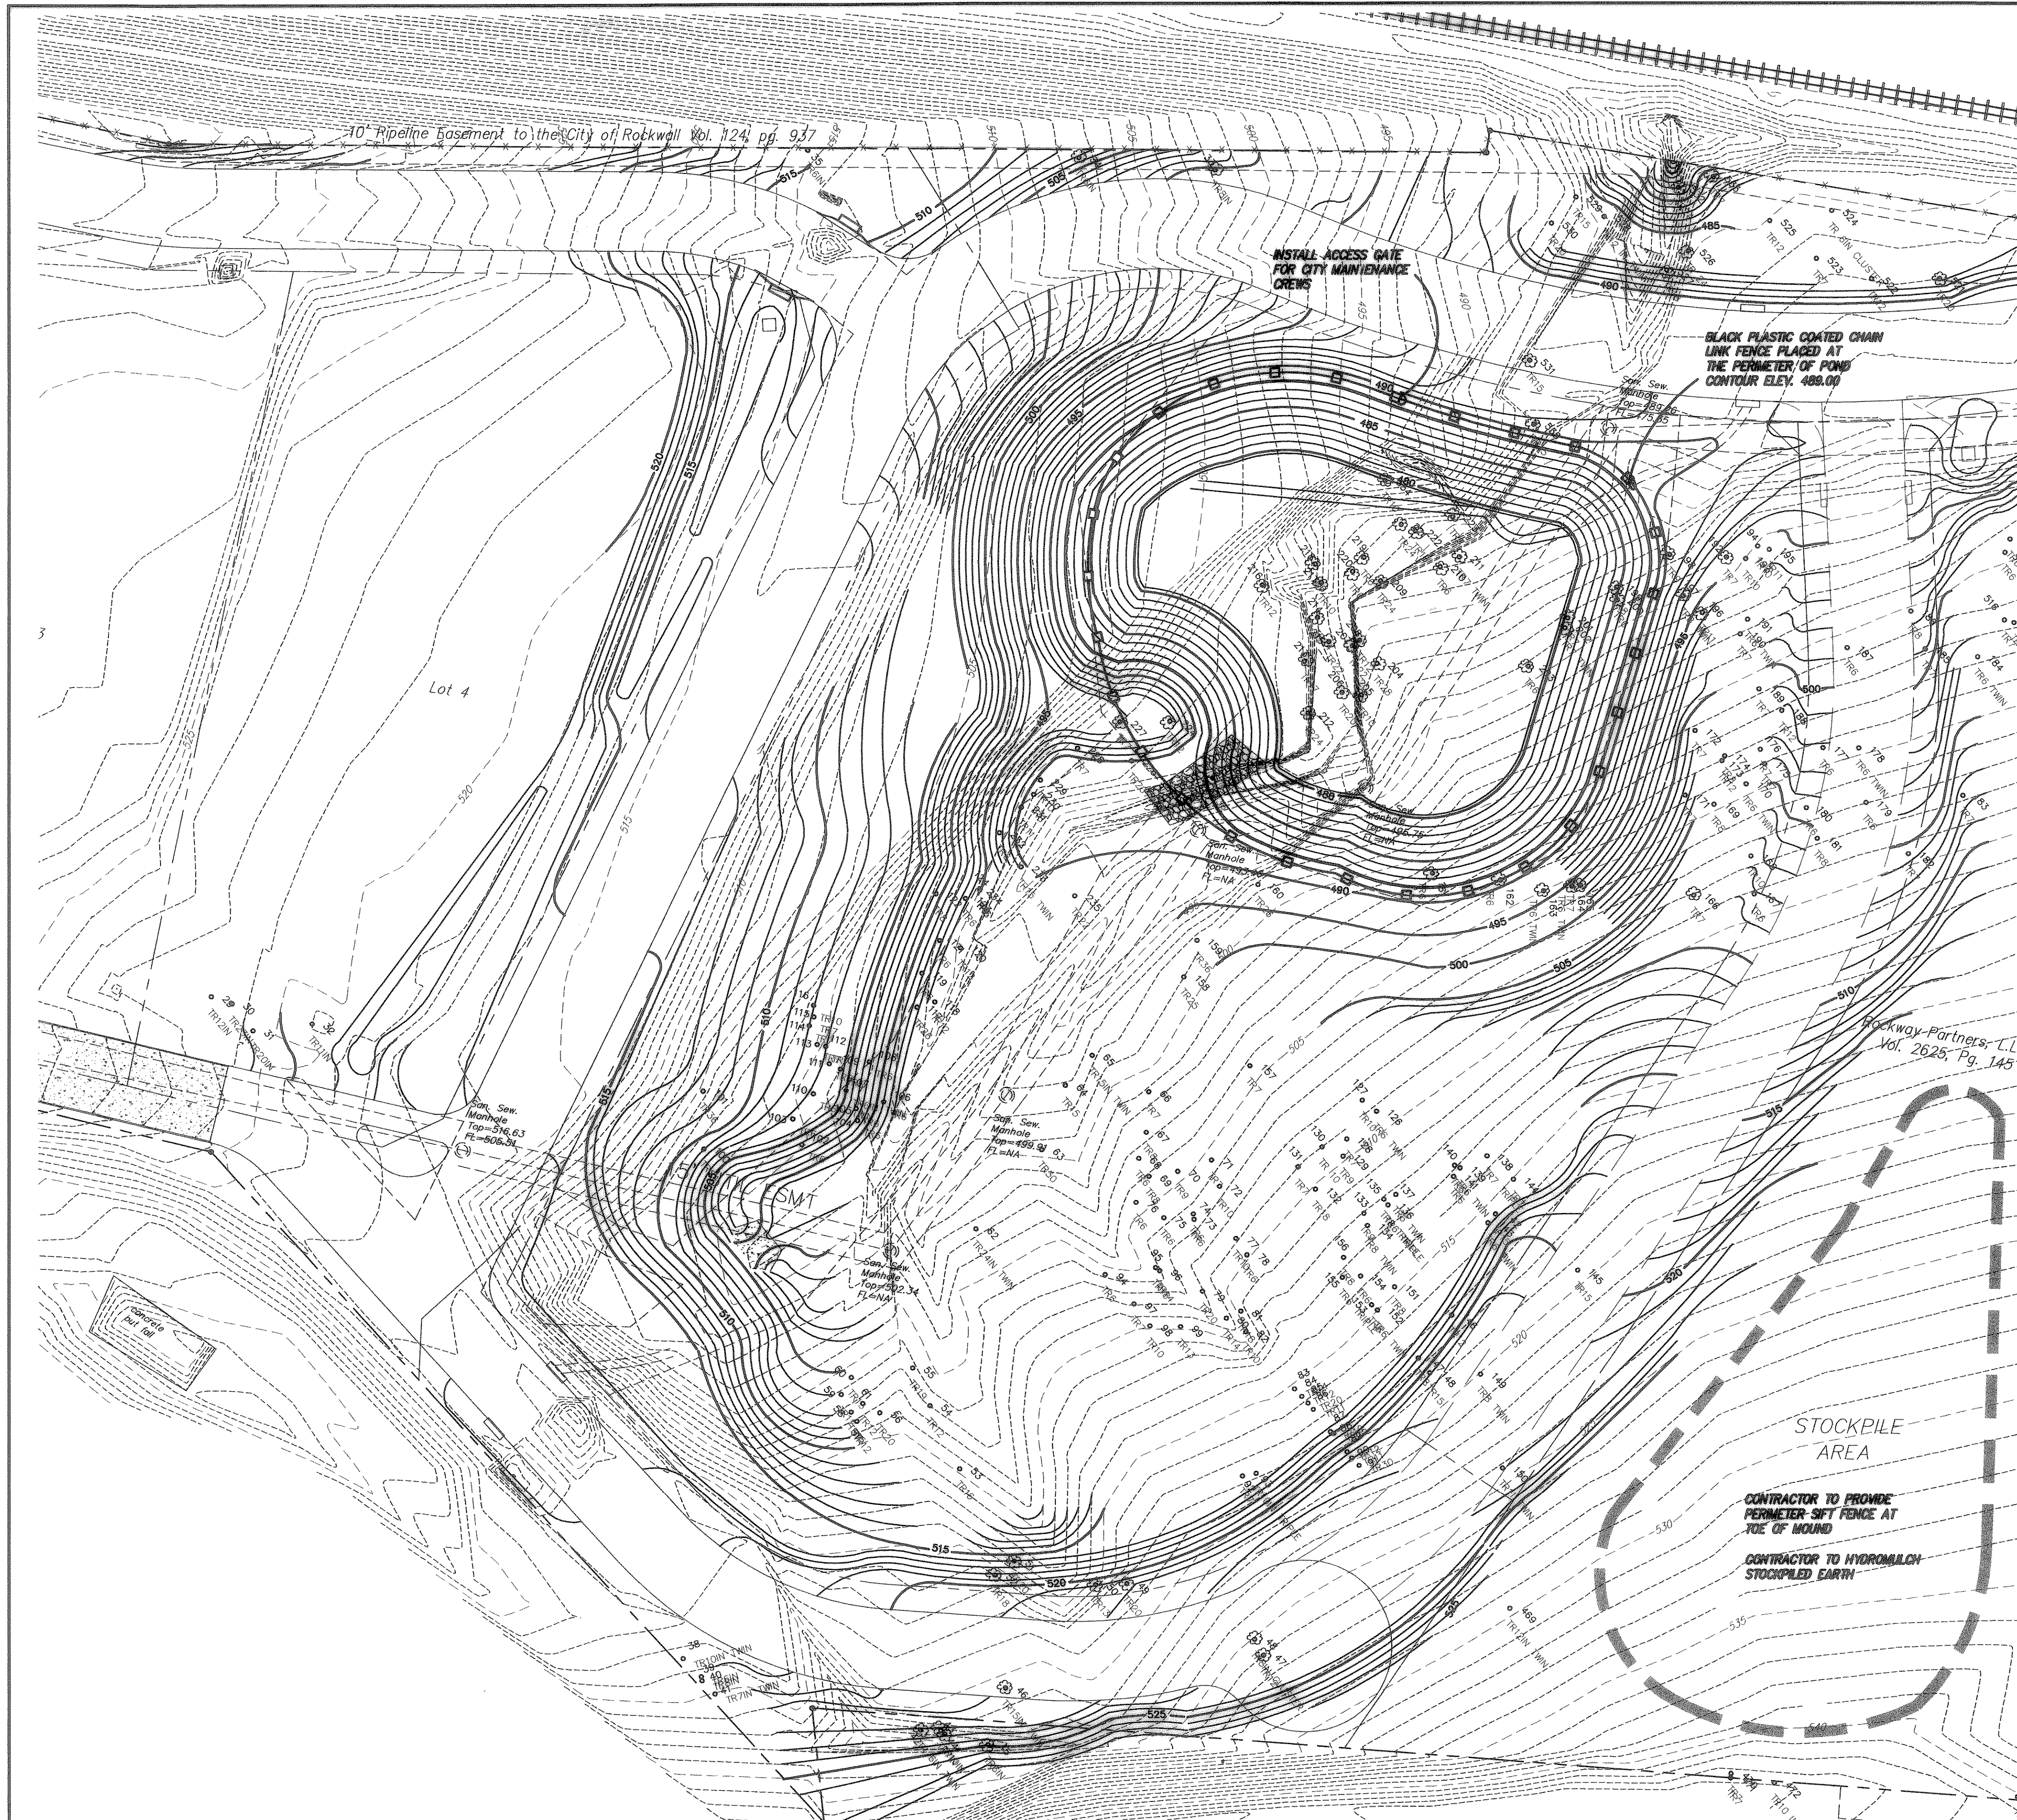

AREA - 1

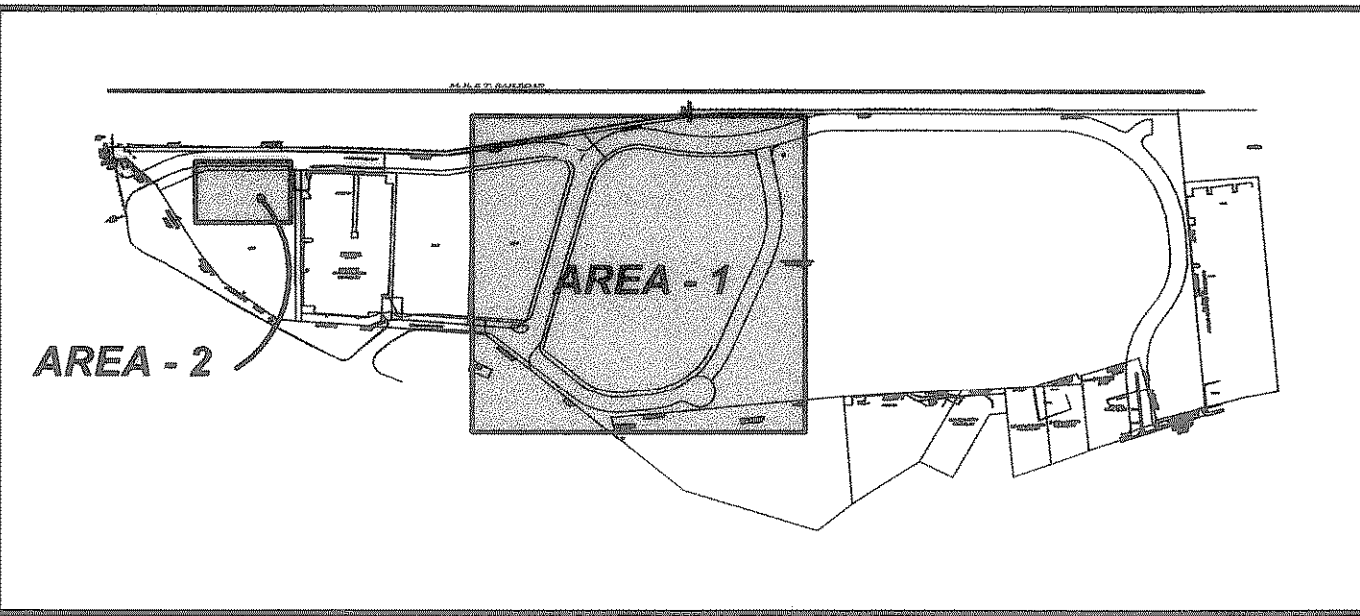


LOCATION MAP
N.T.S.

NOTE:
ALL FILL SHALL BE COMPACTED
11/ SHEEPSFOOT ROLLER TO
90% STD. PROCTOR MIN.


NOTE:
SEE TREE MITIGATION PLAN FOR
PROTECTED TREES AND TREE
REMOVAL CLARIFICATION

EXISTING TREE TO REMOVE

RECORD DRAWINGS
AS PROVIDED BY:
I.C.S. COMMERCIAL
Michael S. Allen
MICHAEL S. ALLEN, P.E.
DATE: 9/25/03

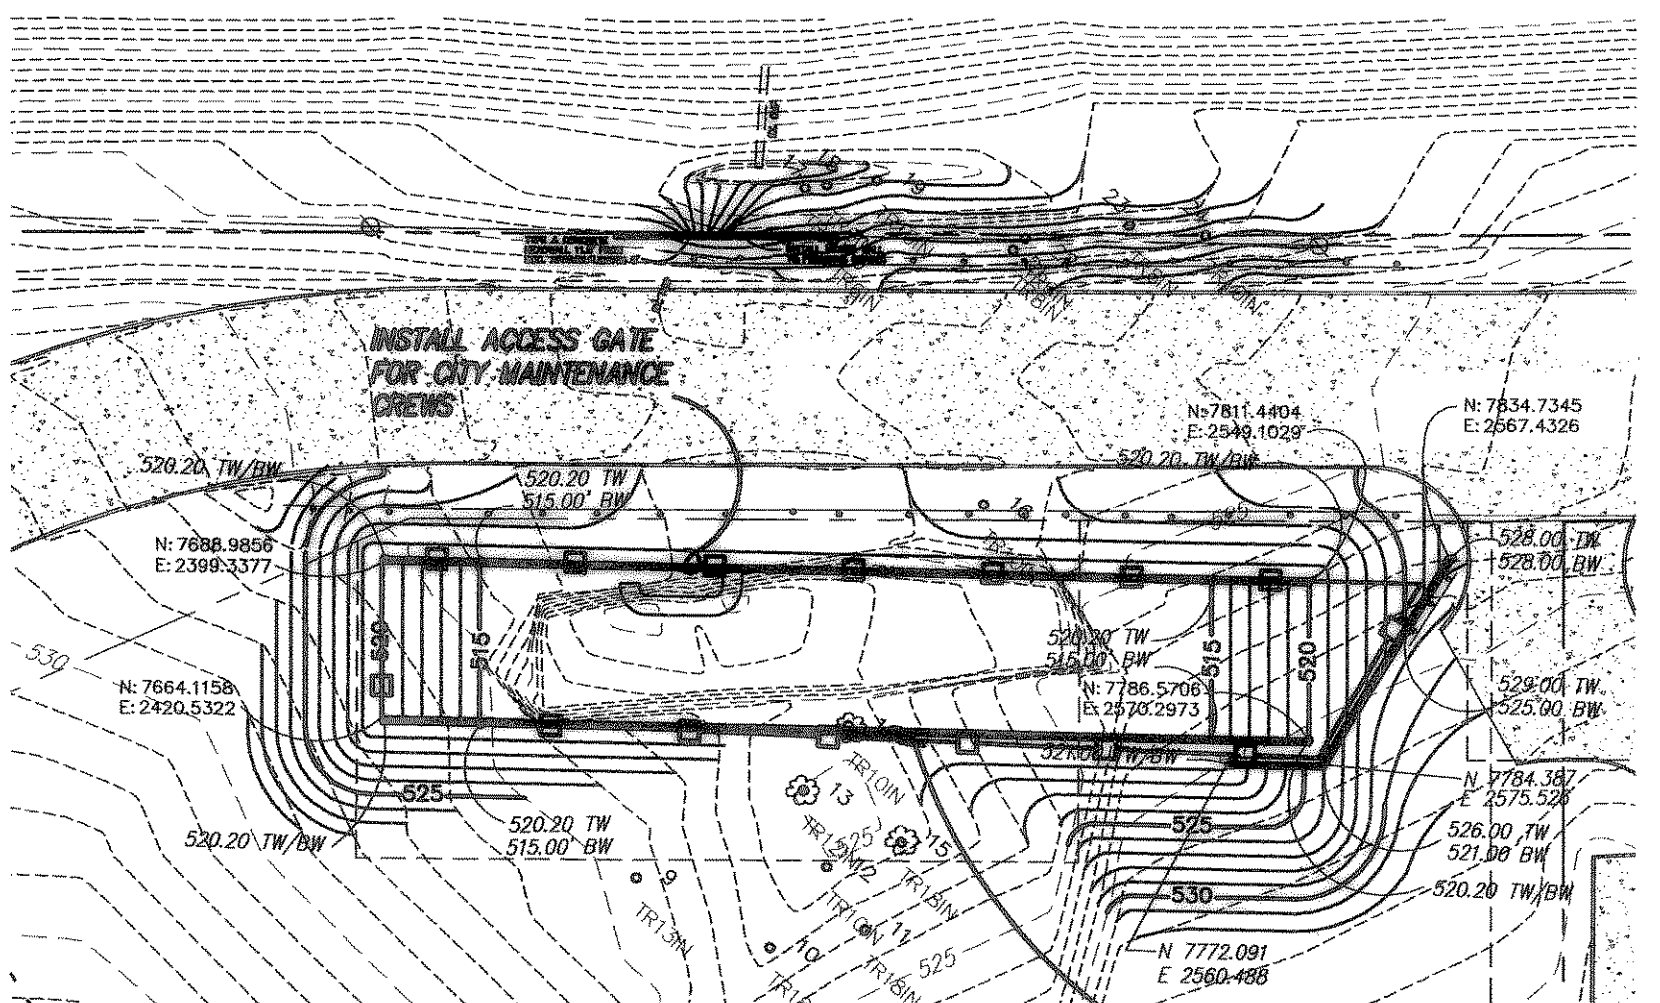

AREA - 2

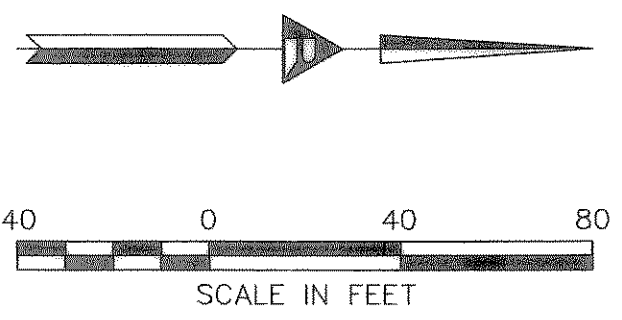

MSA	8/6/03	REVISED GRADING TO SAVE TREES ALONG CATAVINA EXTENSION	
MSA	6/27/03	REVISED GRADING AND EXTENDED WALL	
MSA	6/20/03	REVISED GRADING FOR ROADWAY	
MSA	5/14/03	REVISED GRADING ADDING WALLS TO POND 1	
MSA	5/13/03	REVISED GRADING TO SPILL EXCESS DIRT	
App.	No.	Date	Revisions

Allen & Ridinger Consulting, Inc.
109 W. Main Street
Lewisville, Texas 75057
Tel. No. (972) 353-8000
Fax No. (972) 353-8011

La Jolla Pointe Addition
ROCKWALL, TEXAS

GRADING PLAN

Scale: 1"=40' HOR., 1"=4' VERT.
Designed by: MSA
Drawn by: MSA
Checked by: MSA
Date: April 1, 2003
Project No. 018-001