



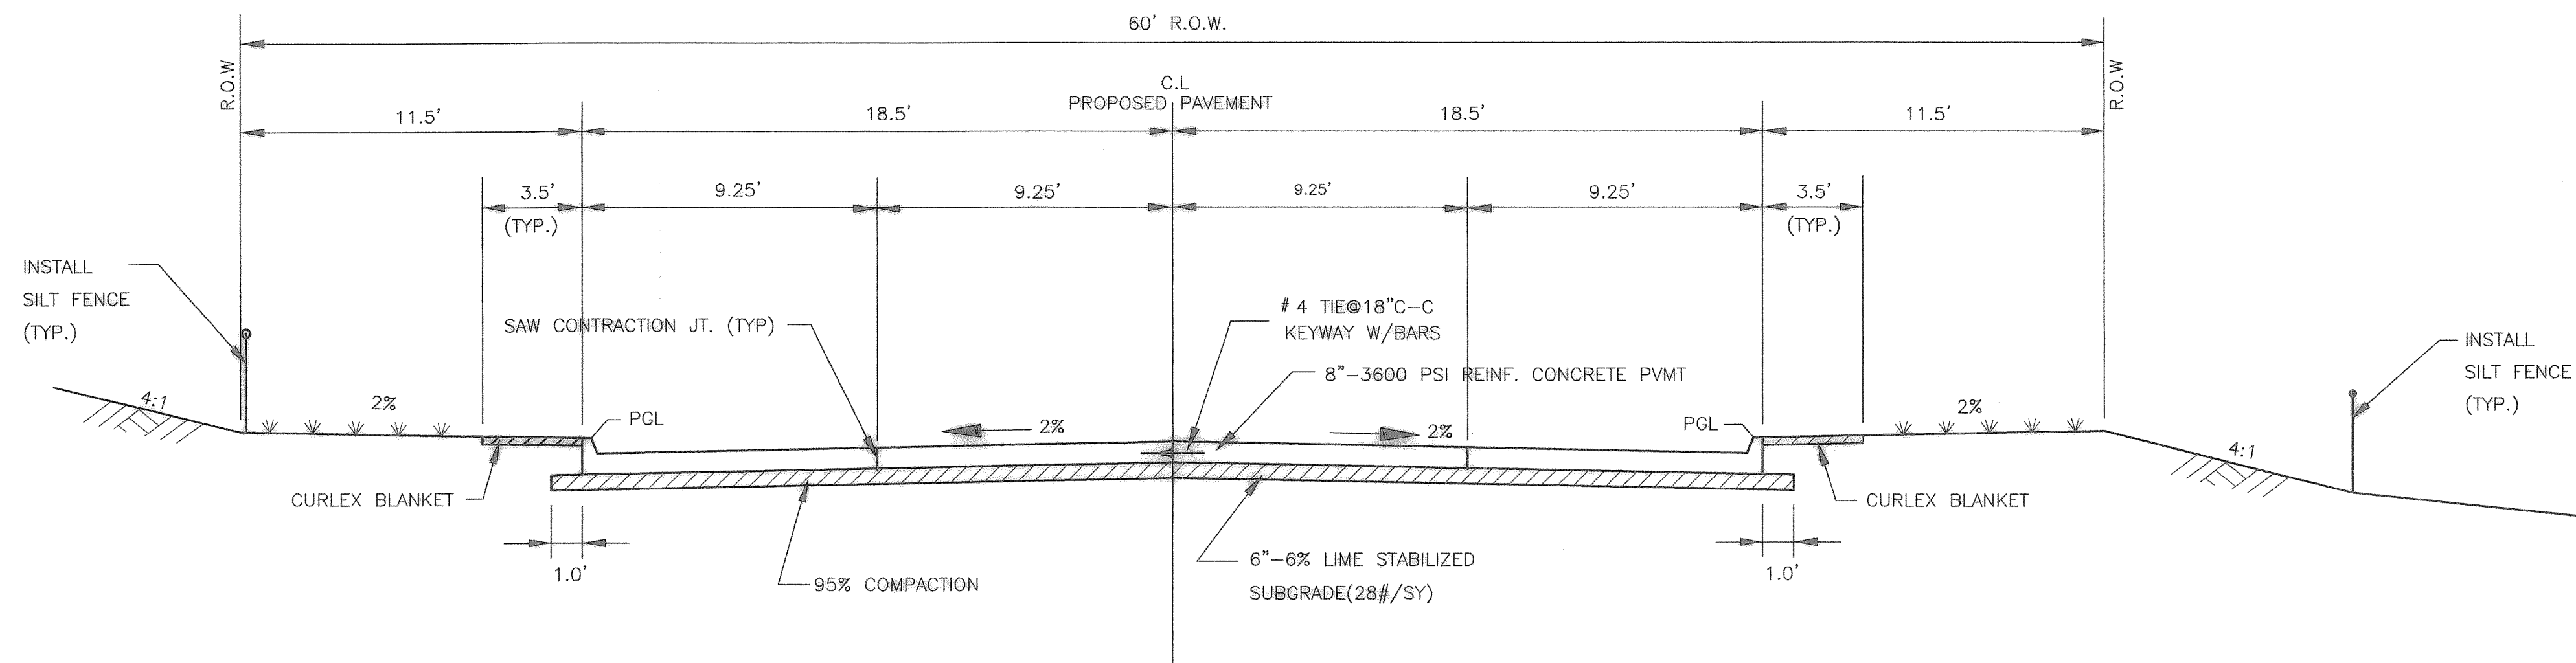


TYPICAL PAVING SECTION
(37' B-B)

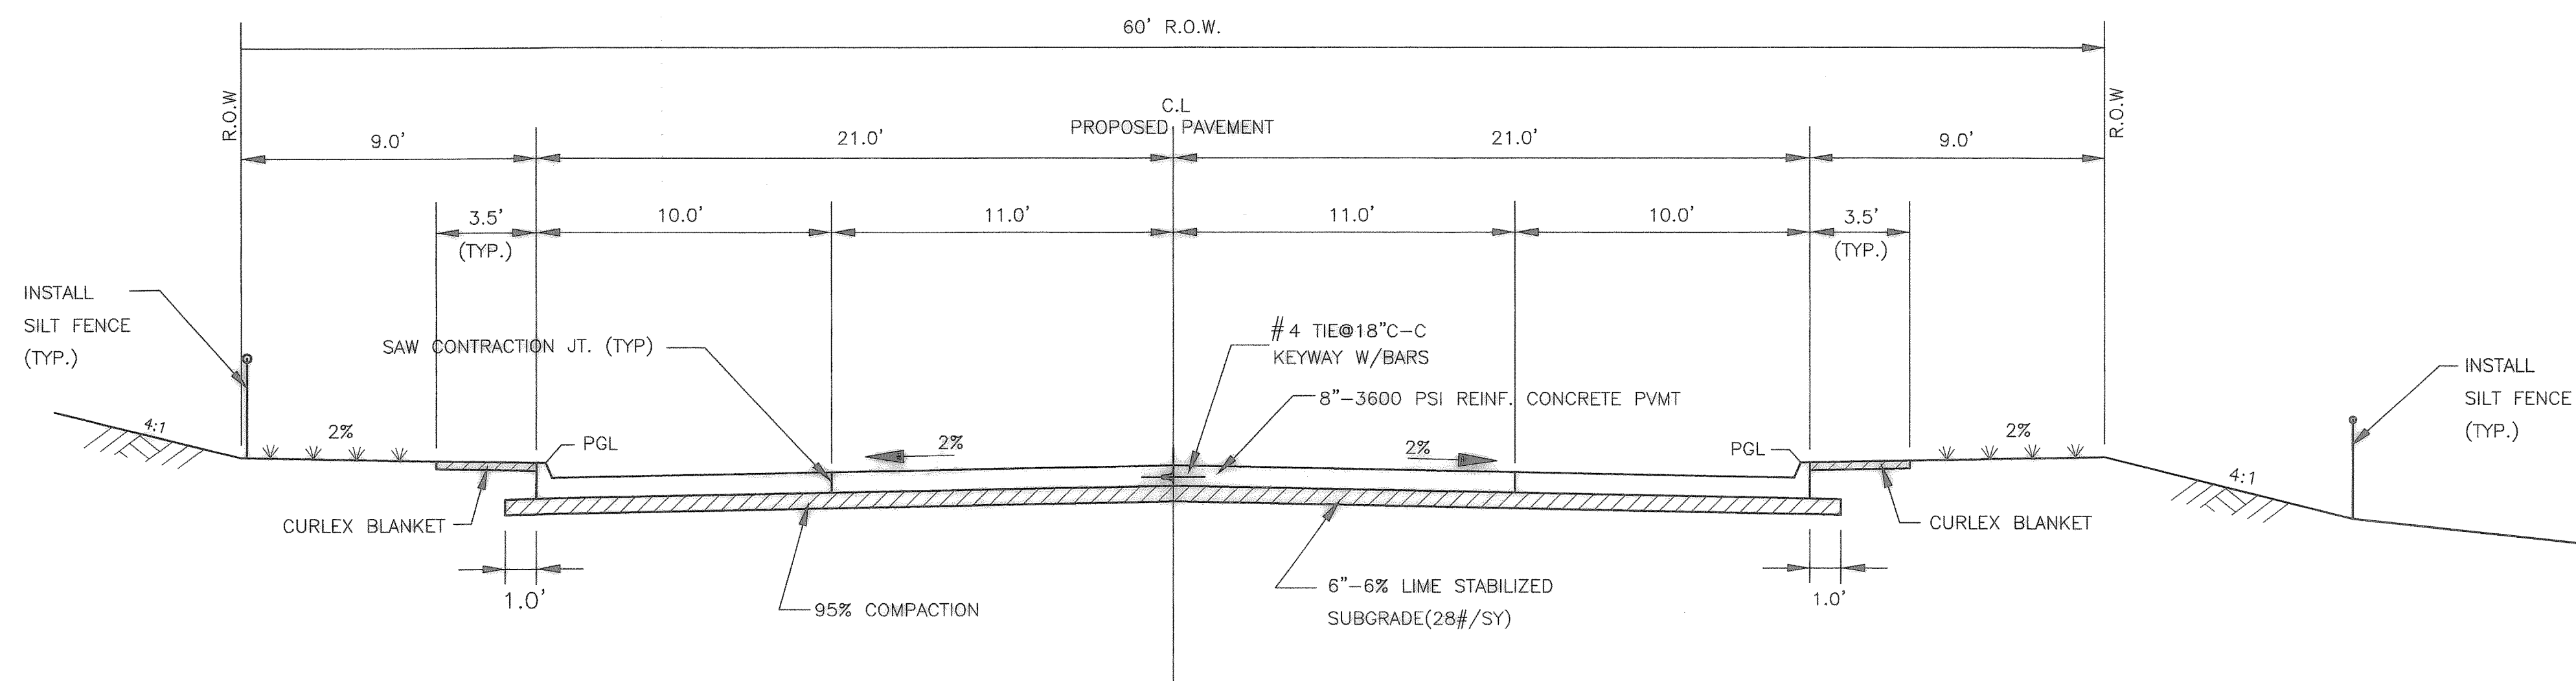

TYPICAL PAVING SECTION
(42' B-B)

RECORD DRAWINGS
AS PROVIDED BY:
I.C.S. COMMERCIAL
Michael S. Allen
MICHAEL S. ALLEN, P.E.
DATE: 9/25/03

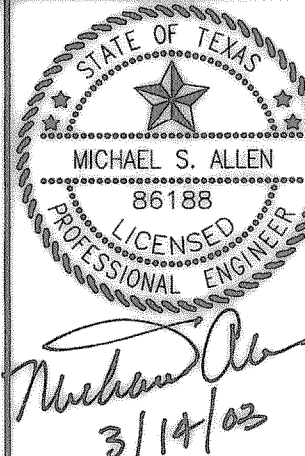


La Jolla Pointe Addition
ROCKWALL, TEXAS

PAVING DETAILS
TYPICAL PAVING SECTIONS

Scale: NTS
Designed by: MSA
Drawn by: MSA
Checked by: MSA
Date: March 14, 2003
Project No. 018-001

SHEET
C-19
OF **25**

No.	Date	Revisions	App.

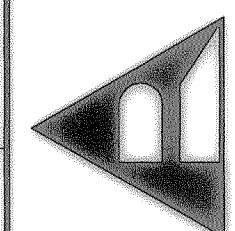

Allen & Ridinger
Consulting, Inc.
100 W. Main Street
Lewisville, Texas 75057
Tel. No. (972) 355-5000
Fax. No. (972) 355-5001