





CONCRETE SIDEWALK

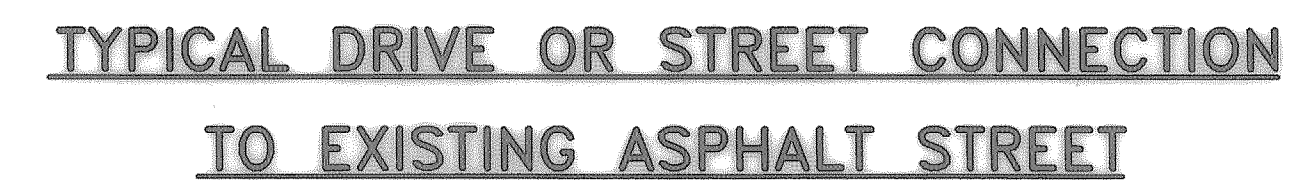


DRIVEWAY RETURN DETAILS

NOTE:
NO SAND UNDER PAVEMENT

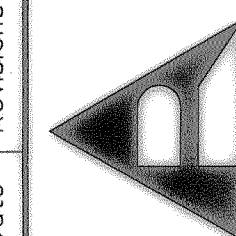[illegible]

**Allen &
Ridinger
Consulting, Inc.**

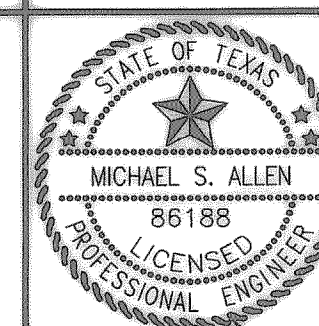

Michael Lee
3/14/03

La Jolla Pointe Addition
ROCKWALL, TEXAS

PAVING DETAILS

Scale:	NTS
Designed by:	
Drawn by:	
Checked by:	
Date:	Mo
Project No.	

SHEET

C-20

OF 25

RECORD DRAWINGS
AS PROVIDED BY:
I.C.S. COMMERCIAL

Michael S. Allen
MICHAEL S. ALLEN, P.E.
DATE: 9/25/03