

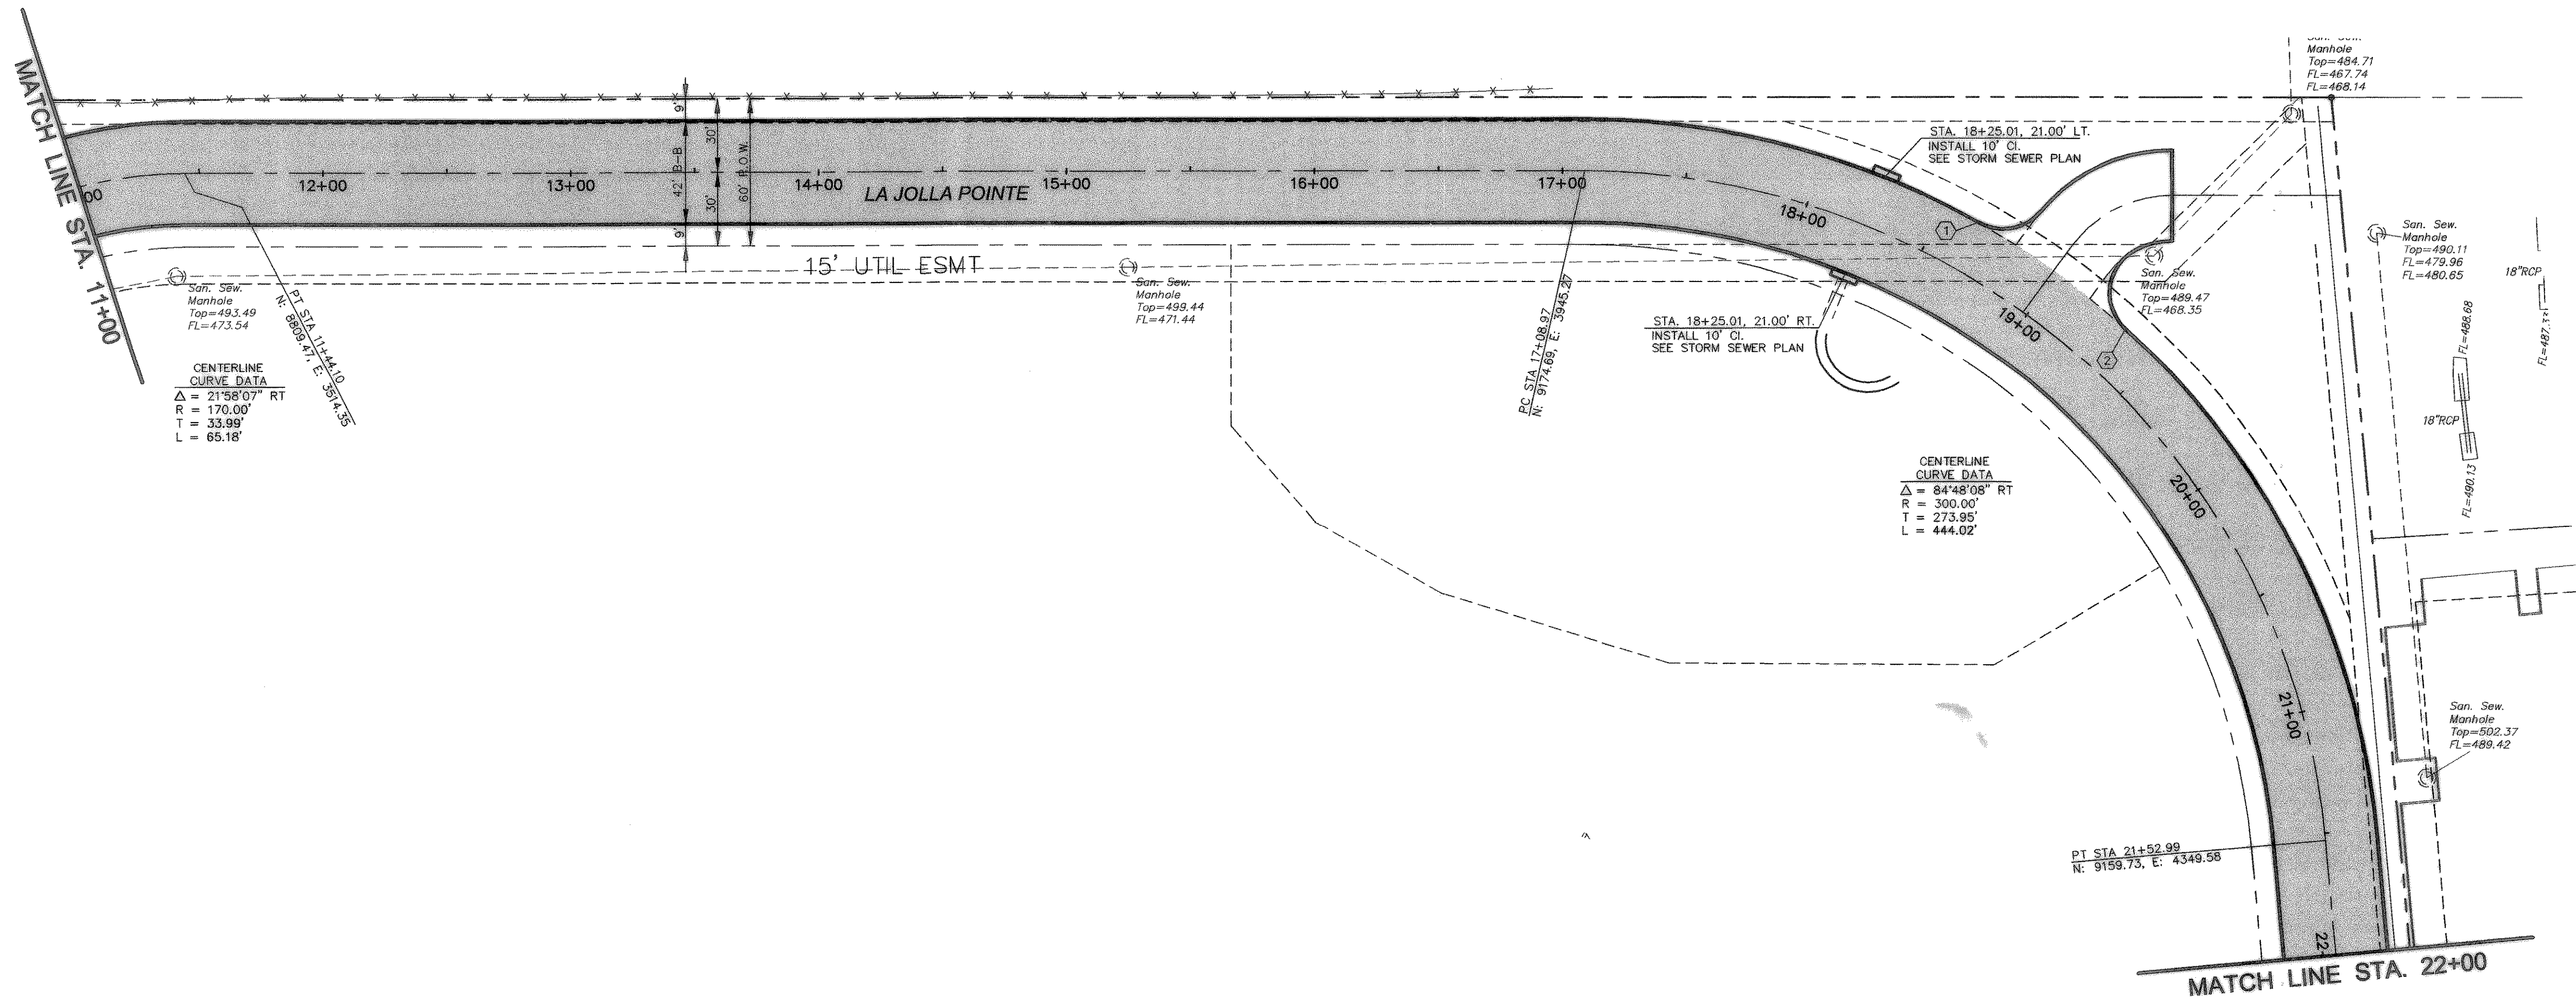


\\nas01\project\016001 - Rockwall\02-LA Jolla 2.dwg, 3/13/2003 4:24:58 PM, 140

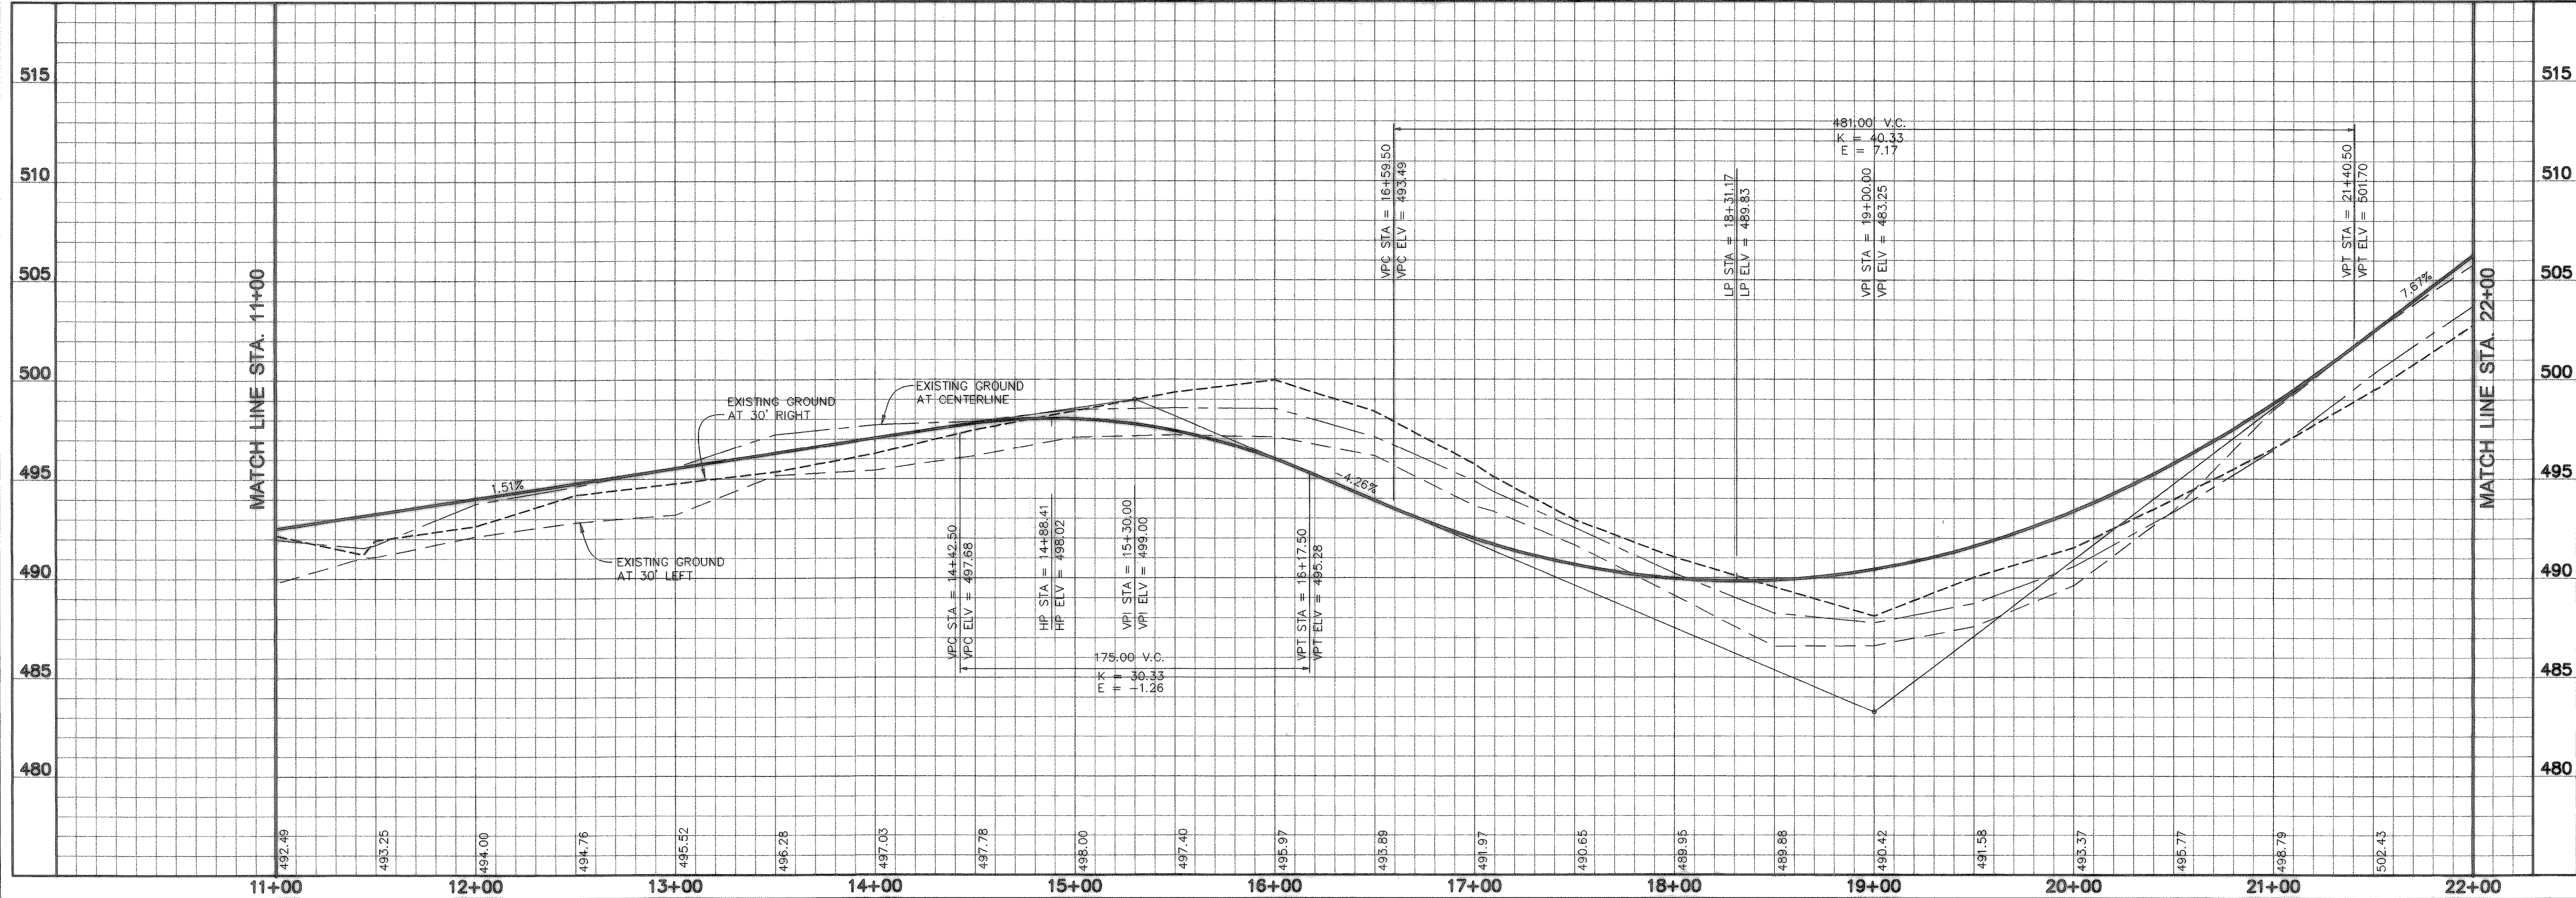

| DESIGN POINT TABLE |          |            |       |           |
|--------------------|----------|------------|-------|-----------|
| PT. NO.            | STATION  | OFFSET     | DESC. | T/C ELEV. |
| 1                  | 18+64.27 | 21.00' LT. | C.R.  | 489.97    |
| 2                  | 19+33.08 | 21.00' LT. | C.R.  | 491.12    |

RECORD DRAWINGS  
AS PROVIDED BY:  
I.C.S. COMMERCIAL  
*Michael S. Allen*  
MICHAEL S. ALLEN, P.E.  
DATE: 9/25/03

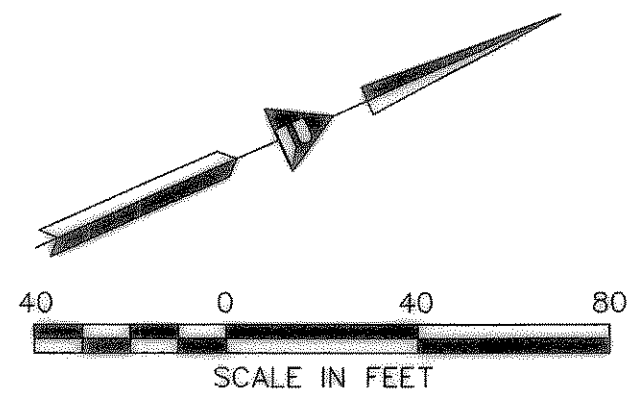

Scale: 1"=40' HOR., 1"=4' VERT.  
Designed by: MSA  
Drawn by: MSA  
Checked by: MSA  
Date: March 14, 2003  
Project No. 018-001

PAVING PLAN AND PROFILE  
**LA JOLLA POINTE**  
STA 11+00 TO STA. 22+00

**La Jolla Pointe Addition**  
ROCKWALL, TEXAS

STATE OF TEXAS  
MICHAEL S. ALLEN  
86188  
LICENSED PROFESSIONAL ENGINEER  
*Michael S. Allen*  
3/14/03

**Allen & Ridinger Consulting, Inc.**  
100 W. Main Street  
Lewisville, Texas 75057  
Tel. No. (972) 353-8000  
Fax No. (972) 353-8011