

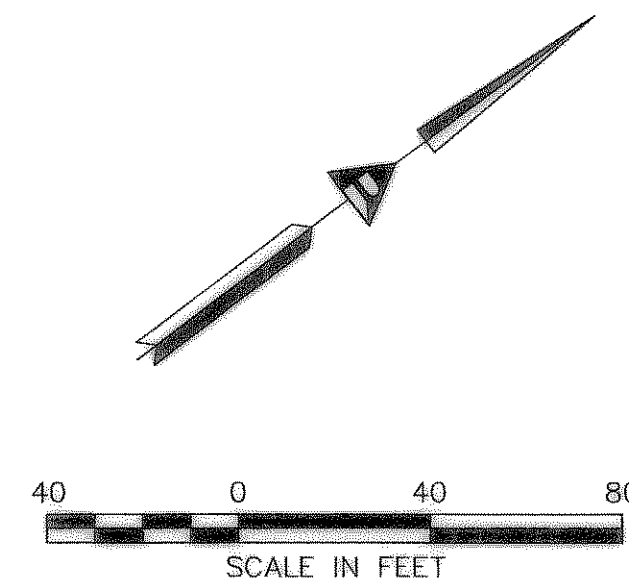


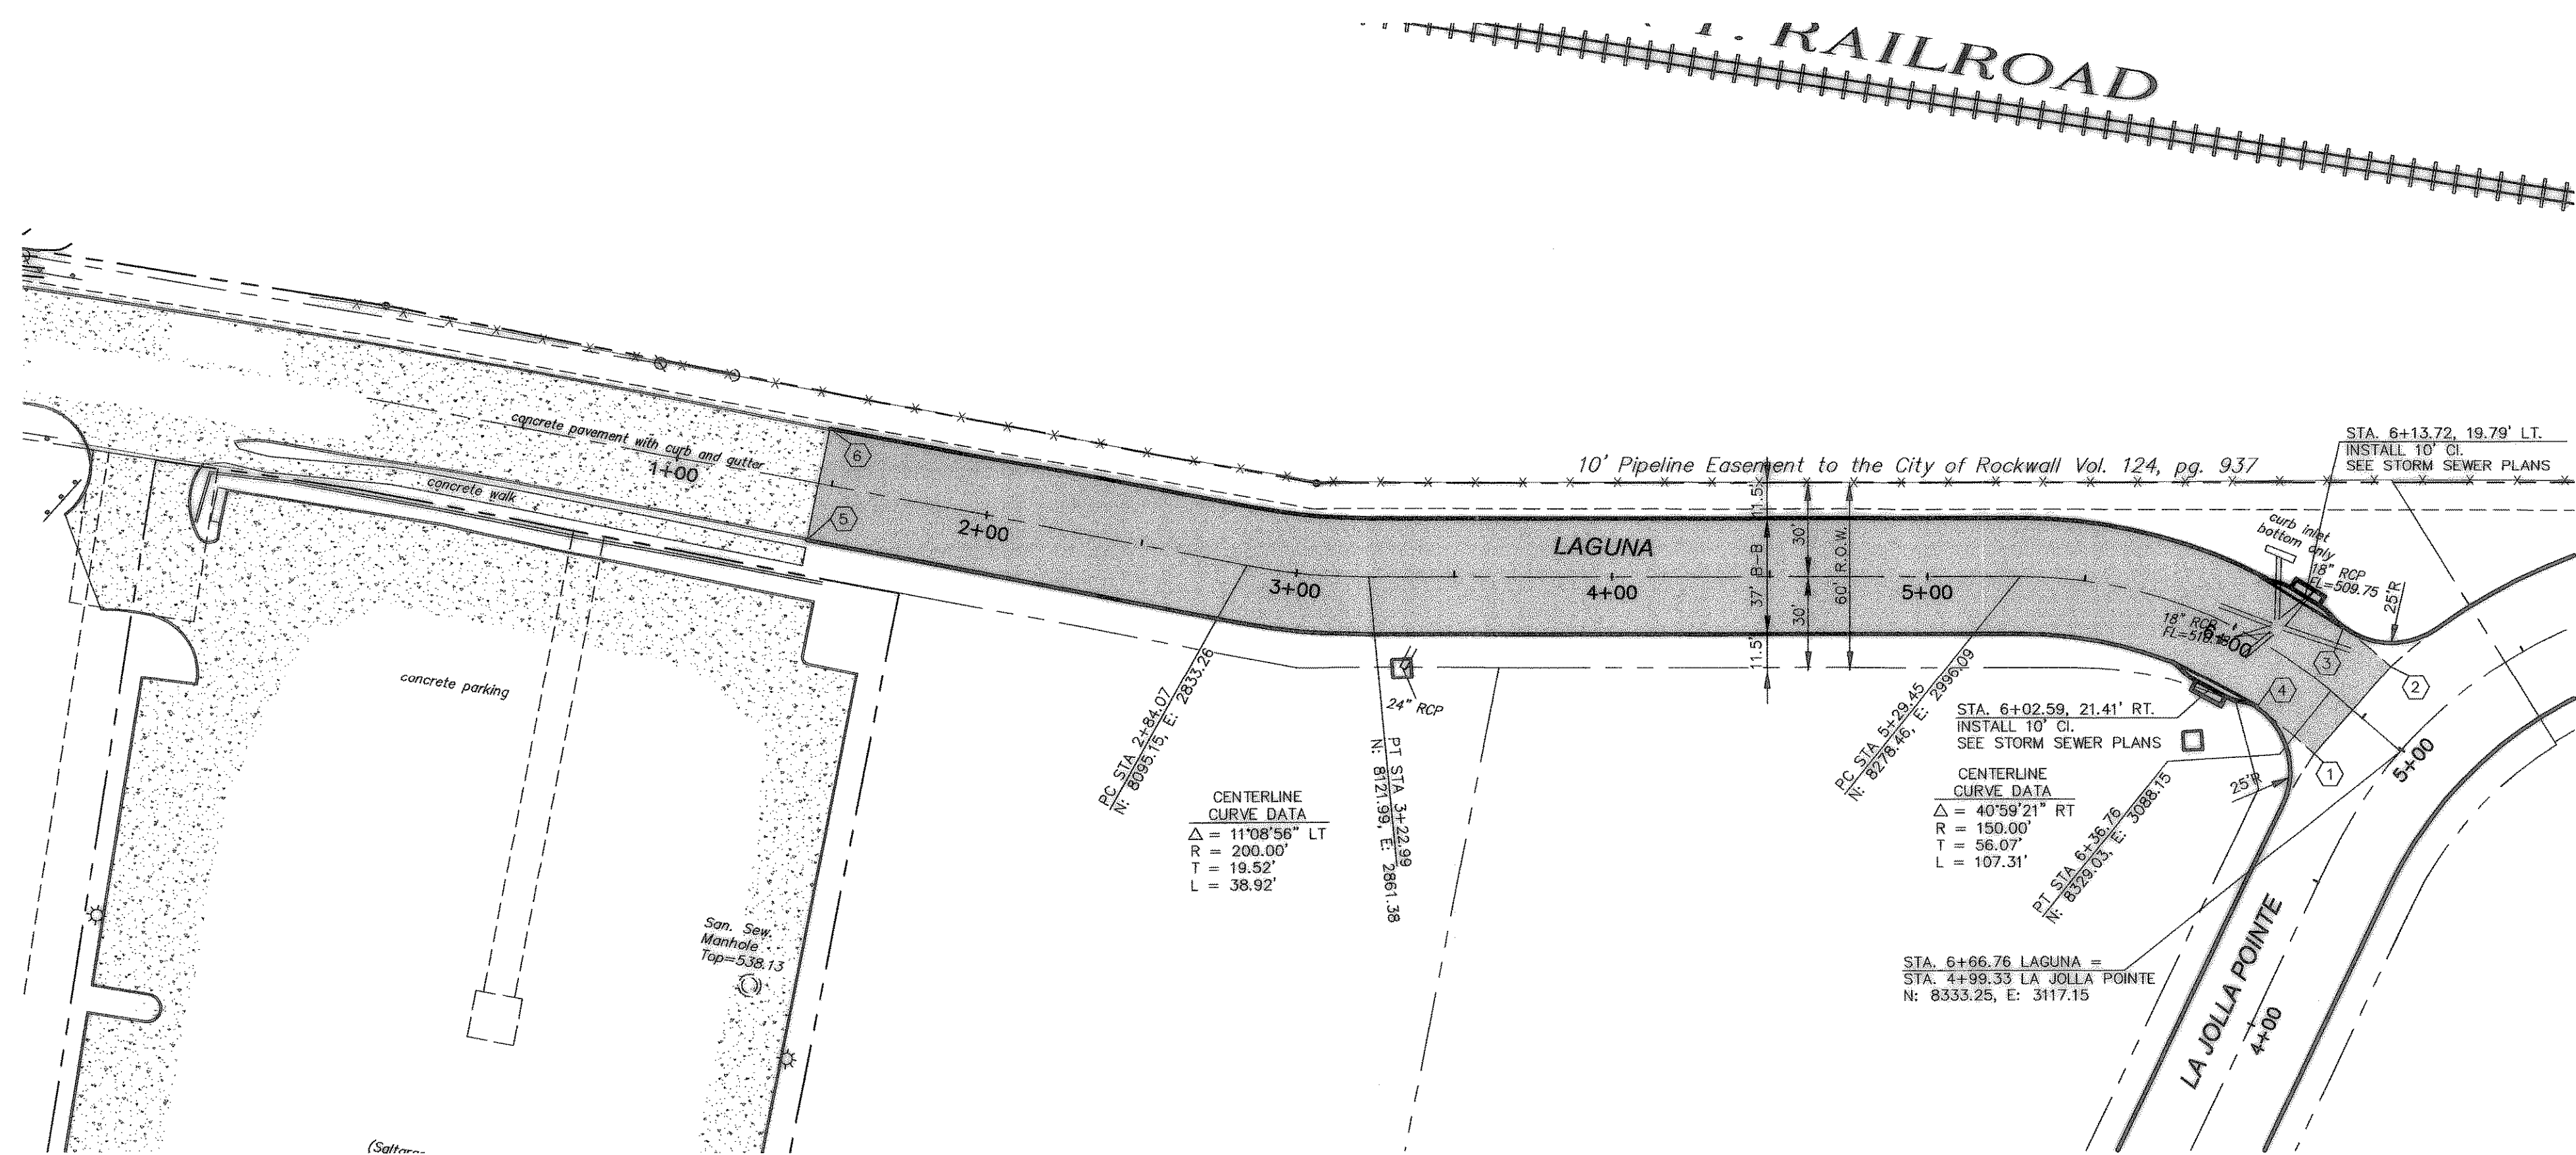

PT. NO.	STATION	OFFSET	DESC.	T/C ELEV.
1	6+46.07	18.50' RT.	P.I.	509.95
2	6+46.07	18.50' LT.	P.I.	508.18
3	6+27.54	18.50' LT.	C.R.	509.71
4	6+20.31	18.50' RT.	C.R.	511.71
5	1+45.64	18.50' LT.	TC	533.28
6	1+45.77	18.50' RT.	TC	533.28

RECORD DRAWINGS
AS PROVIDED BY:
I.C.S. COMMERCIAL
Michael S. Allen
MICHAEL S. ALLEN, P.E.
DATE: 9/25/03

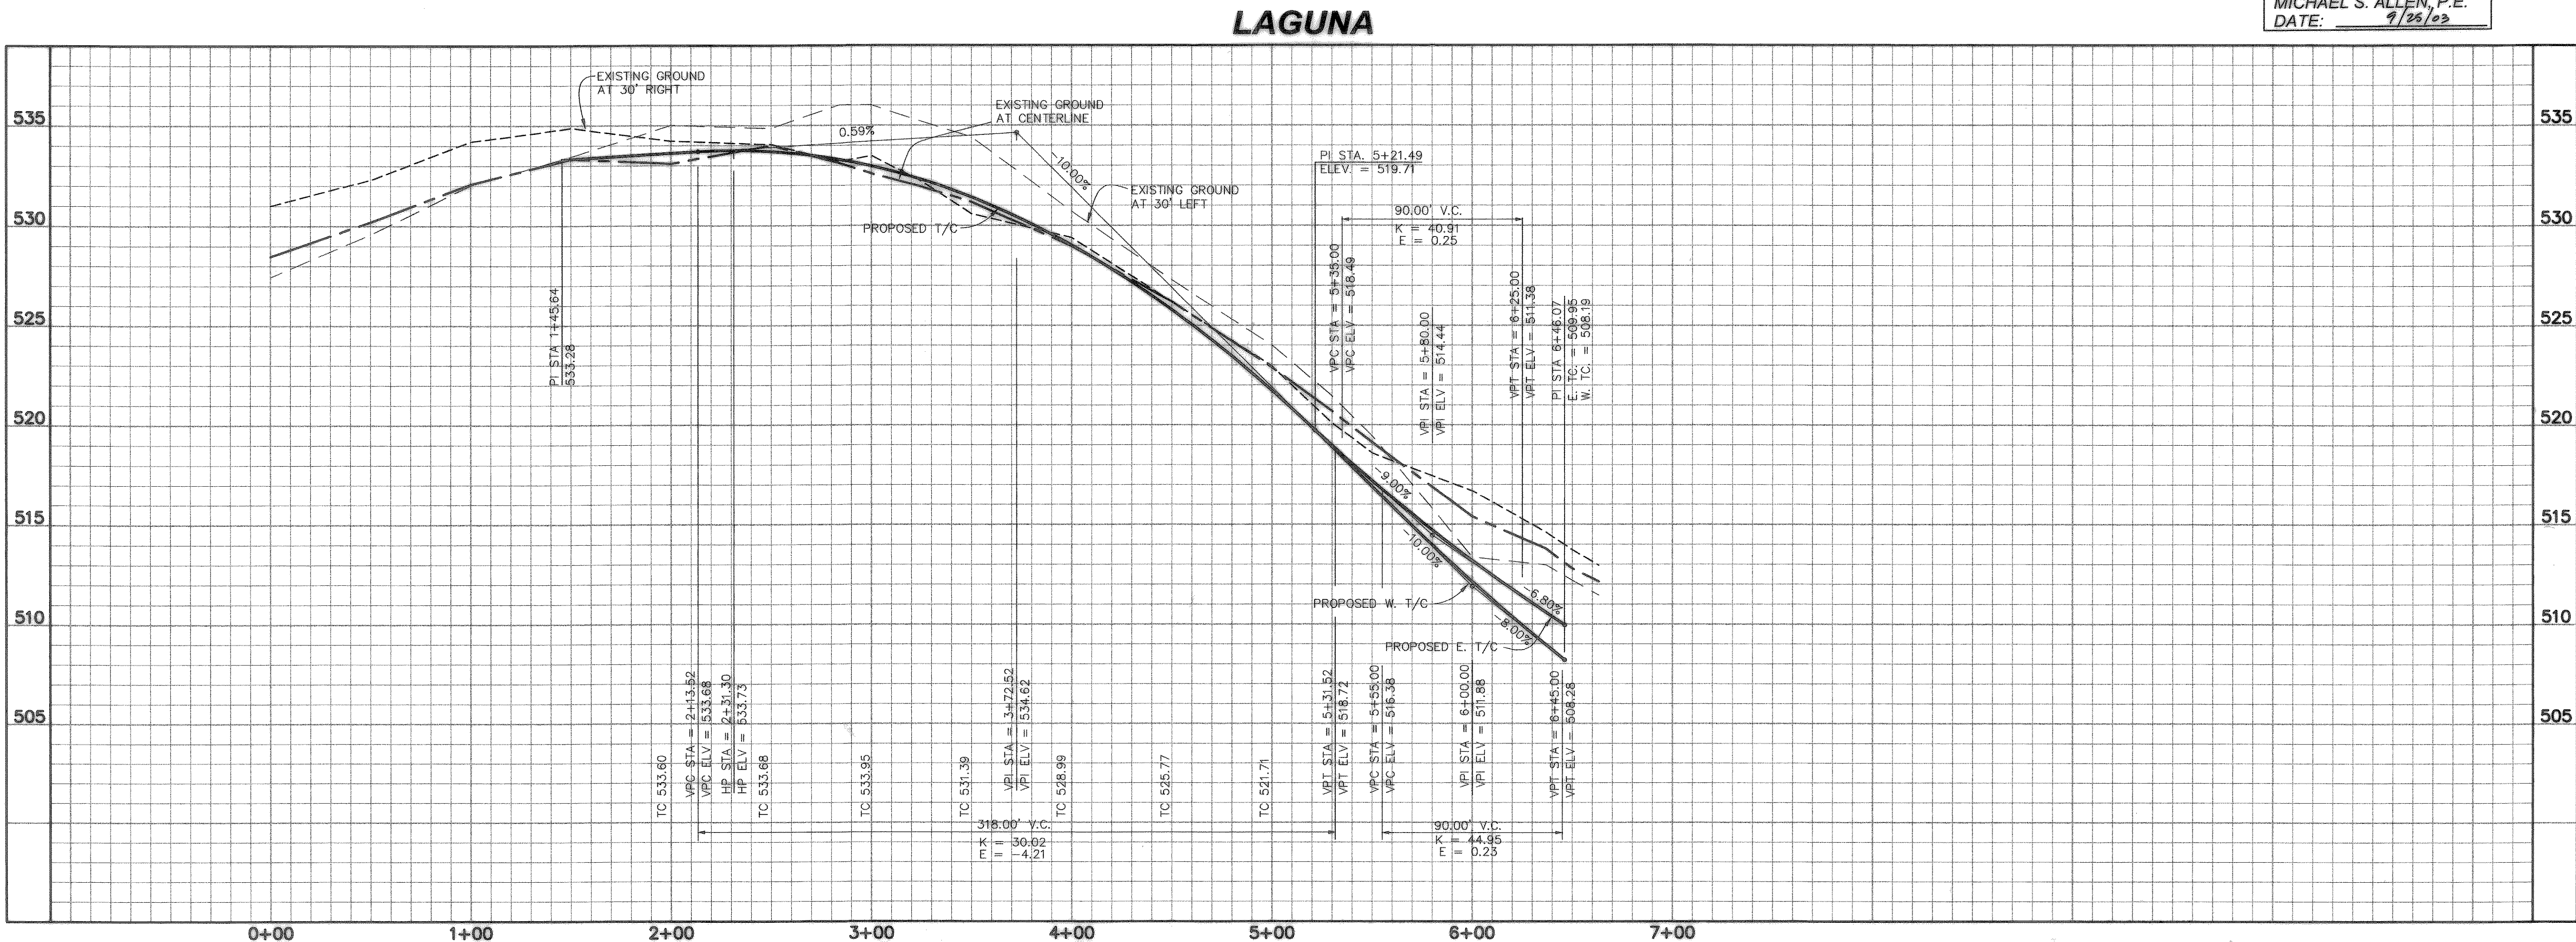

Scale: 1"=40' HOR., 1"=4' VERT.

Designed by: MSA

Drawn by: MSA

Checked by: MSA

Date: April 1, 2003

Project No. 018-001

SHEET

C-5

OF 25

LA JOLLA POINTE ADDITION
ROCKWALL, TEXAS

PAVING PLAN AND PROFILE

LAGUNA

STA 0+00 TO END

4/1/03

REISSUED SHT. CHG. GRADES FOR EX. WAT.

USA

App.

Revisions

Date

No.

Allen & Ridinger Consulting, Inc.

109 W. Main Street
Lewisville, Texas 75057

Tel. No. (972) 353-8000
Fax No. (972) 353-8011

STATE OF TEXAS

MICHAEL S. ALLEN

86188

PROFESSIONAL ENGINEER

Michael S. Allen

4/1/03