
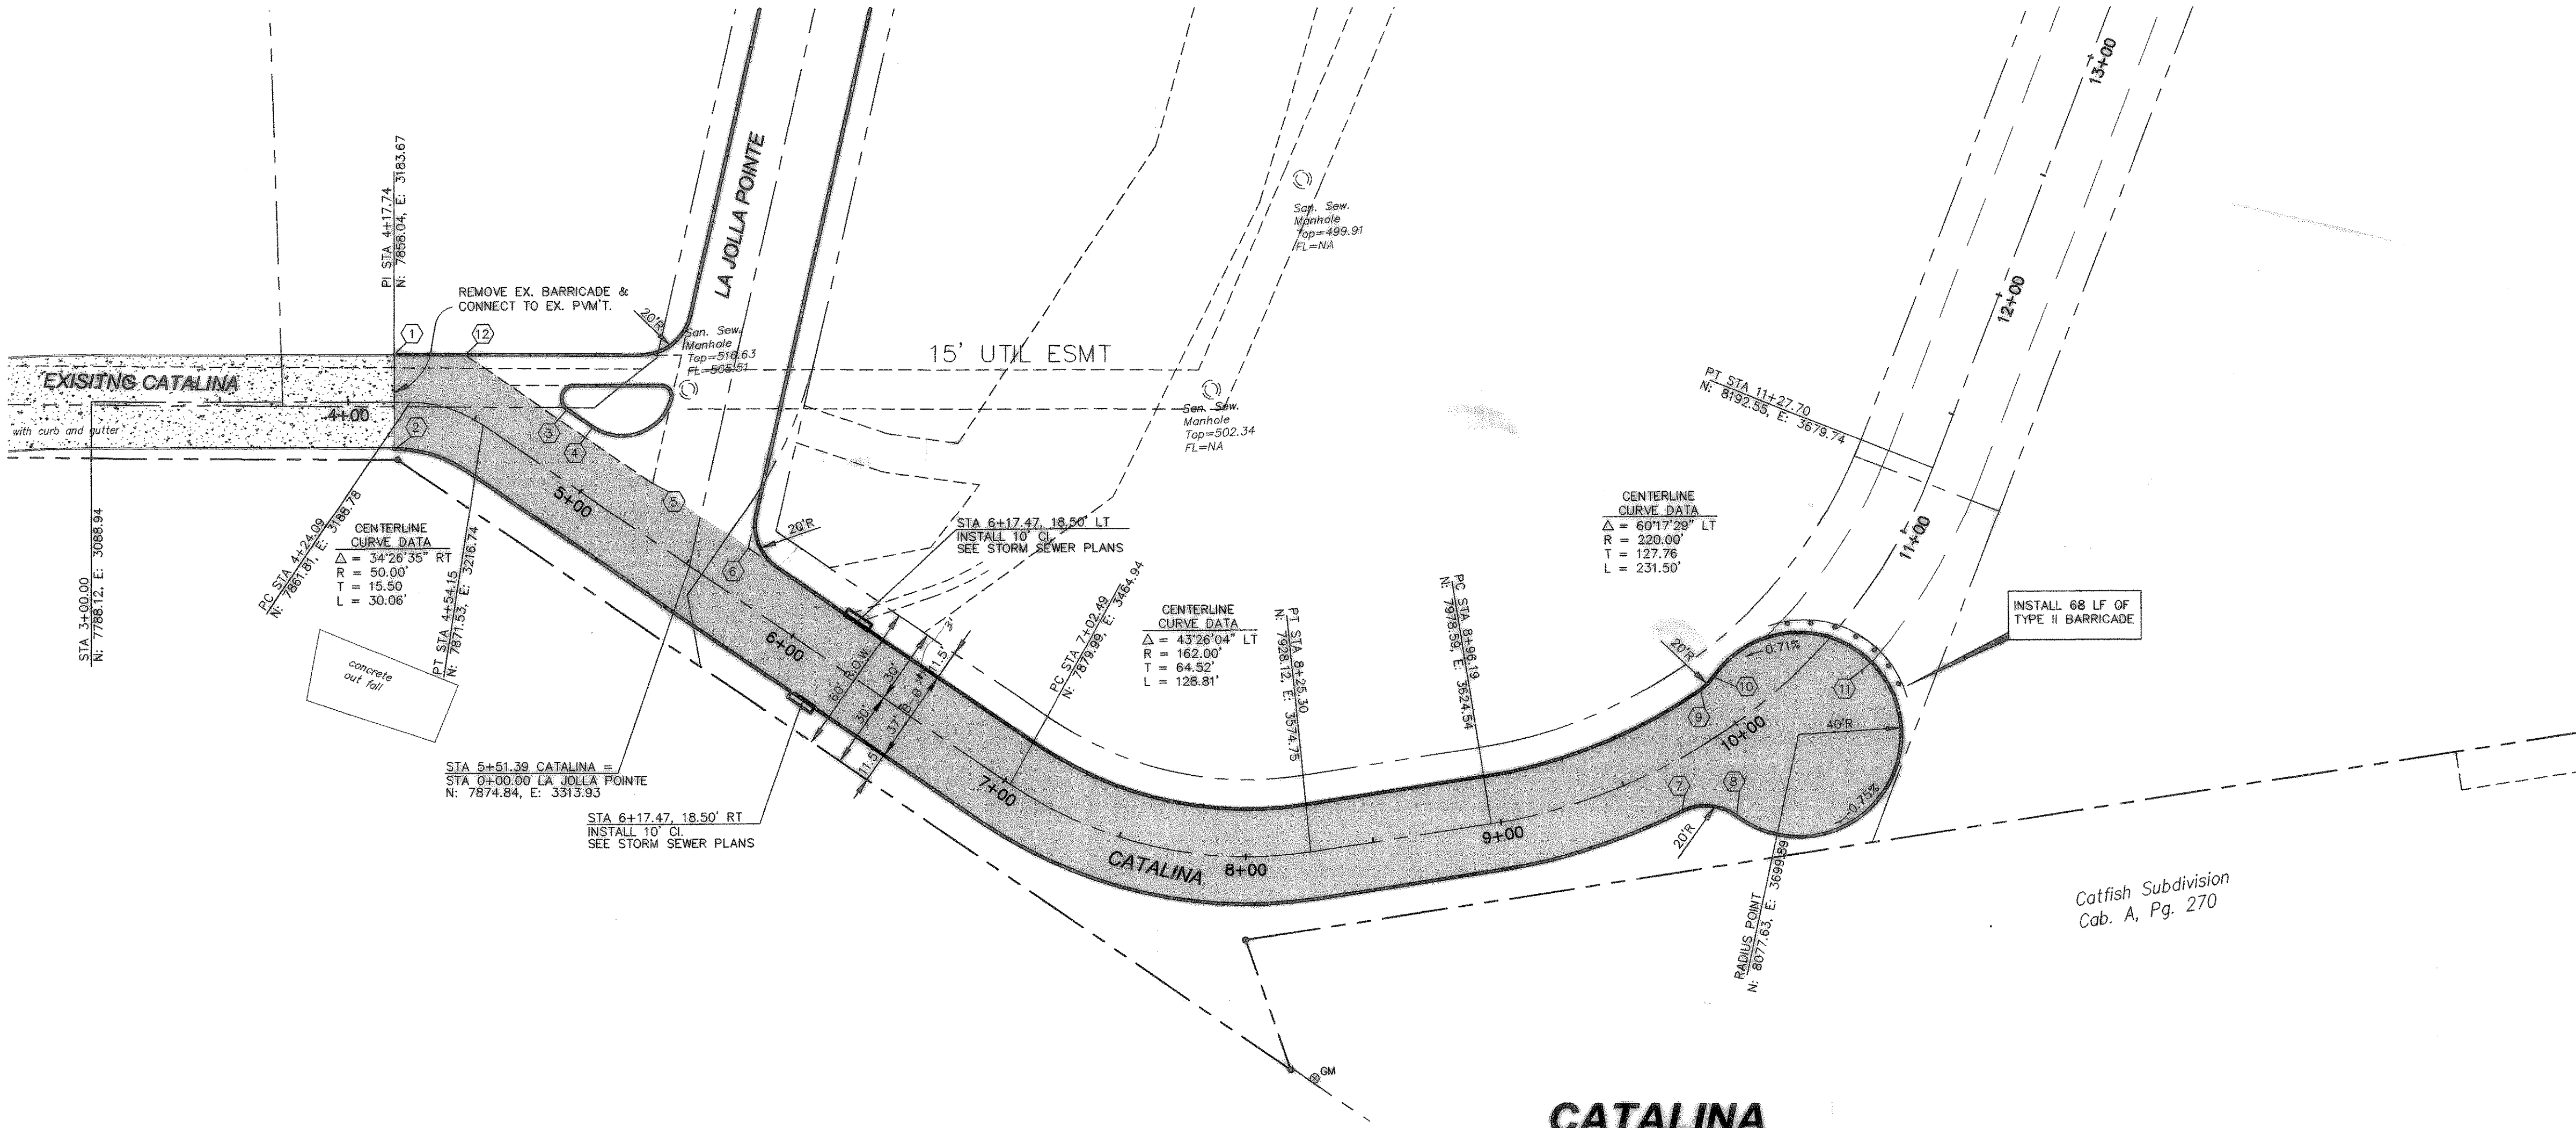


\\dallas\proj\018-001 - Rockwall\10-catalina.dwg, 3/13/2003 5:48:24 PM, 1:40

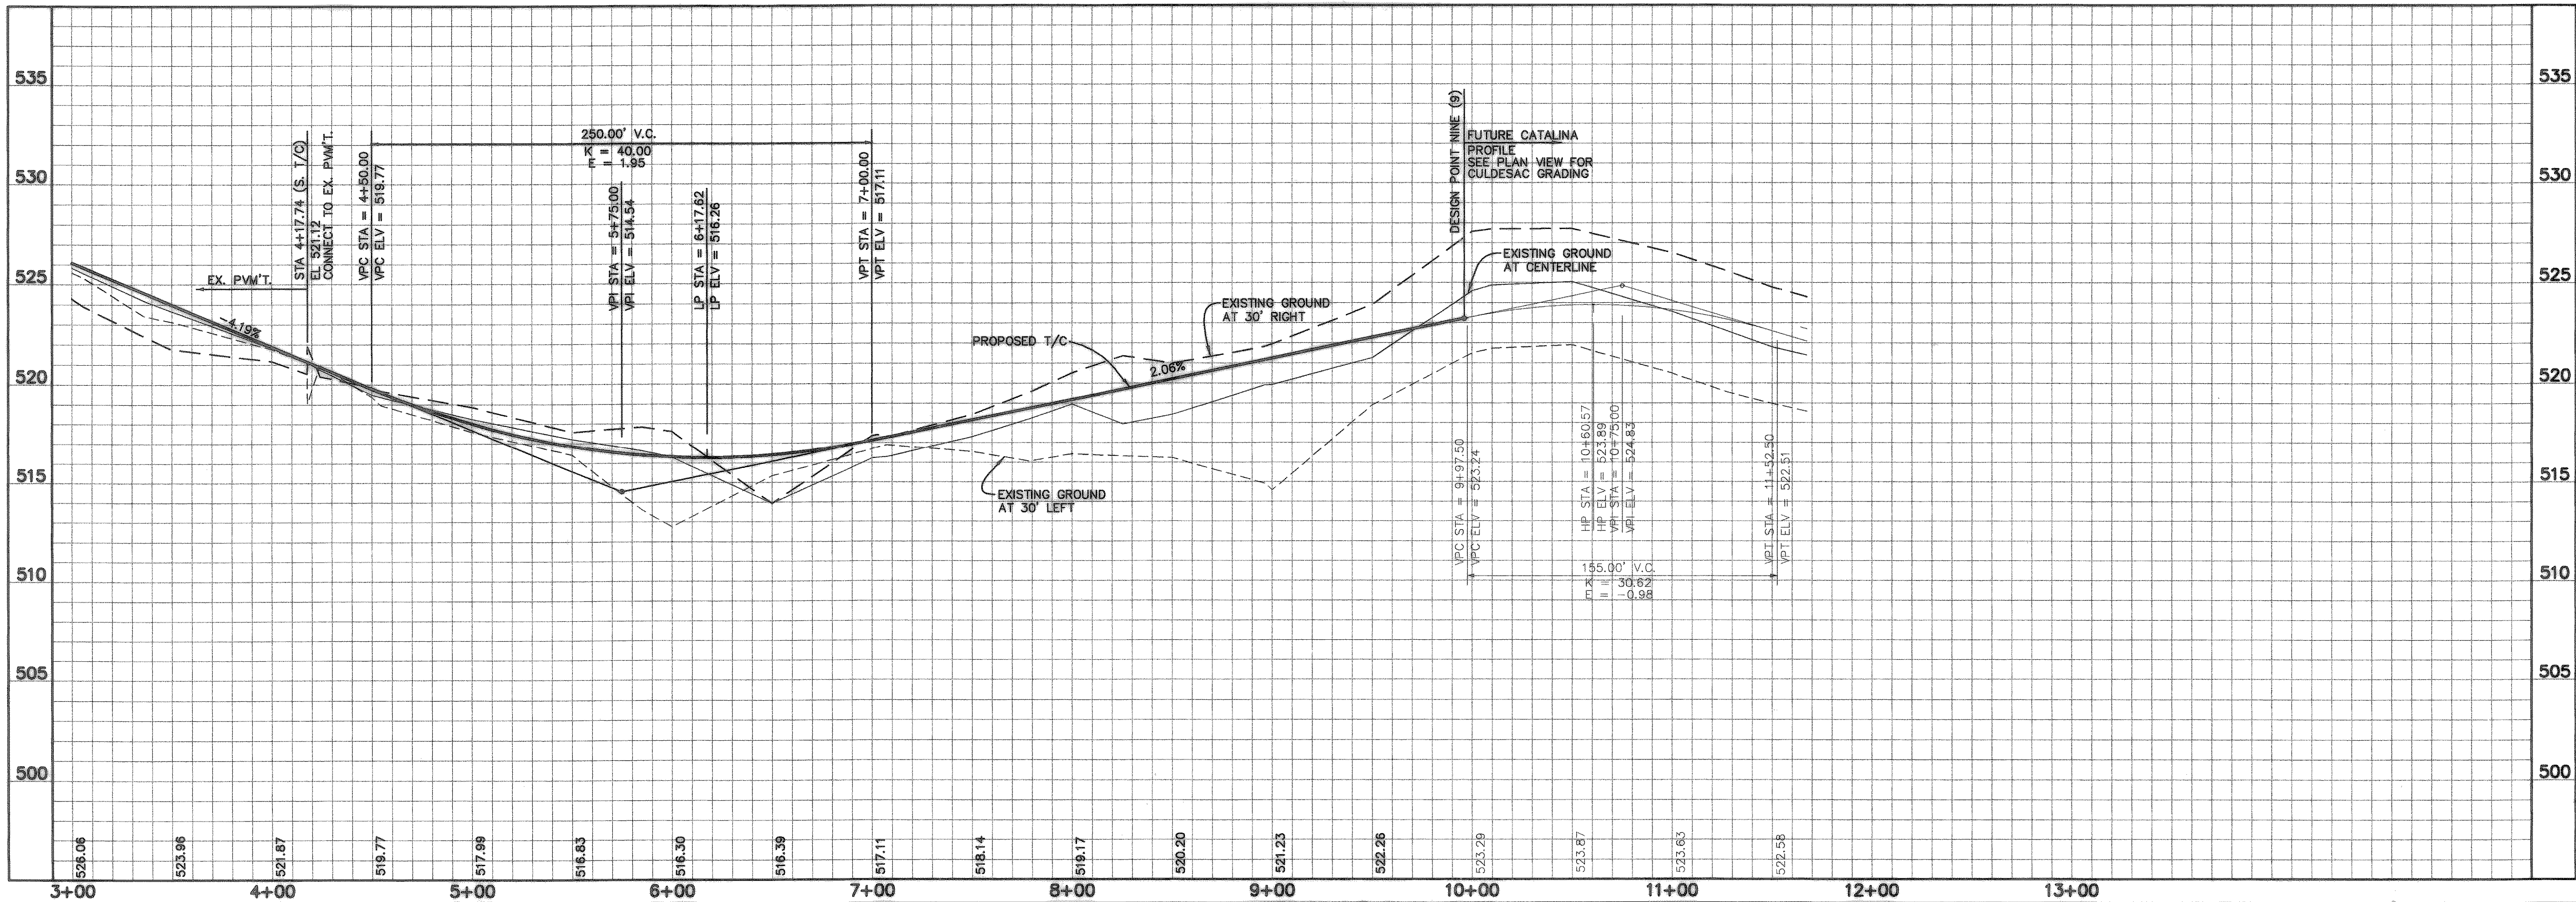

PT. NO.	STATION	OFFSET	DESC.	T/C ELEV.
1	4+17.74	18.50' LT.	T.C.	521.21
2	4+17.74	18.26' RT.	T.C.	521.12
3	4+77.55	23.50' LT.	C.R.	518.71
4	4+89.70	23.50' RT.	C.R.	518.30
5	5+21.32	18.50' LT.	P.I.	517.42
6	5+66.59	18.50' LT.	P.I.	516.58
7	9+65.63	18.50' RT.	C.R.	522.58
8	9+81.65	30.42' RT.	C.R.	522.91
9	9+96.04	18.50' LT.	C.R.	523.21
10	10+03.90	19.69' LT.	C.R.	523.30
11	10+52.50	18.50' RT.	T.C.	523.80
12	4+39.12	21.72' LT.	T.C.	520.23

RECORD DRAWINGS
AS PROVIDED BY:
I.C.S. COMMERCIAL
MICHAEL S. ALLEN, P.E.
DATE: 1/25/03

No.

Date

Revisions

App.

Allen & Ridinger Consulting, Inc.

109 W. Main Street
Lawsville, Texas 75057

Tel. No. (972) 353-8000
Fax No. (972) 353-8011

STATE OF TEXAS

MICHAEL S. ALLEN

86188

PROFESSIONAL ENGINEER

3/14/03

La Jolla Pointe Addition

ROCKWALL, TEXAS

PAVING PLAN AND PROFILE

CATALINA

STA 3+00 TO END

Scale: 1"=40' HOR., 1"=4' VERT.

Designed by: MSA

Drawn by: MSA

Checked by: MSA

Date: March 14, 2003

Project No. 018-001

SHEET

C-6

OF 25