




DATE:	09/04/03
SCALE:	1"= 50'
CALC. BY:	J.B.S.
DRAWN BY:	J.B.S.
CHK. BY:	D.M.F.
JOB NO.:	2301329

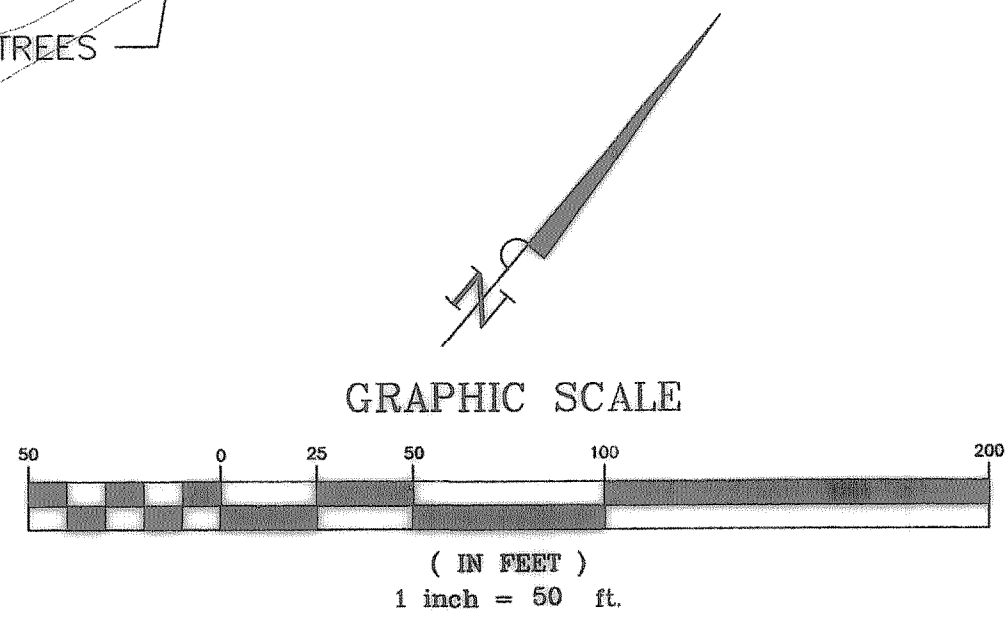

'AS-BUILT' TREE MITIGATION PLAN
LA JOLLA POINTE ADDITION
35.989 ACRES ACRES
W. BLEVINS SURVEY, ABSTRACT NO. 200
CITY OF ROCKWALL
ROCKWALL COUNTY, TEXAS

LandPatterns, Inc.

Landscape Architecture
Landscape Construction
Landscape Maintenance

3824 Oak Lawn Avenue, Suite 320
Dallas, Texas 75219
T: 214-219-3683
F: 214-219-7005

DESIGN BY: JBB
DRAWN BY: JBB
CHECKED BY: CHP
DATE: SEPTEMBER 4, 2003

RECORD DRAWINGS
AS PROVIDED BY:
I.C.S. COMMERCIAL
MICHAEL S. ALLEN, P.E.
DATE:

SHEET
LP1.3