


M. K. & T. RAILROAD

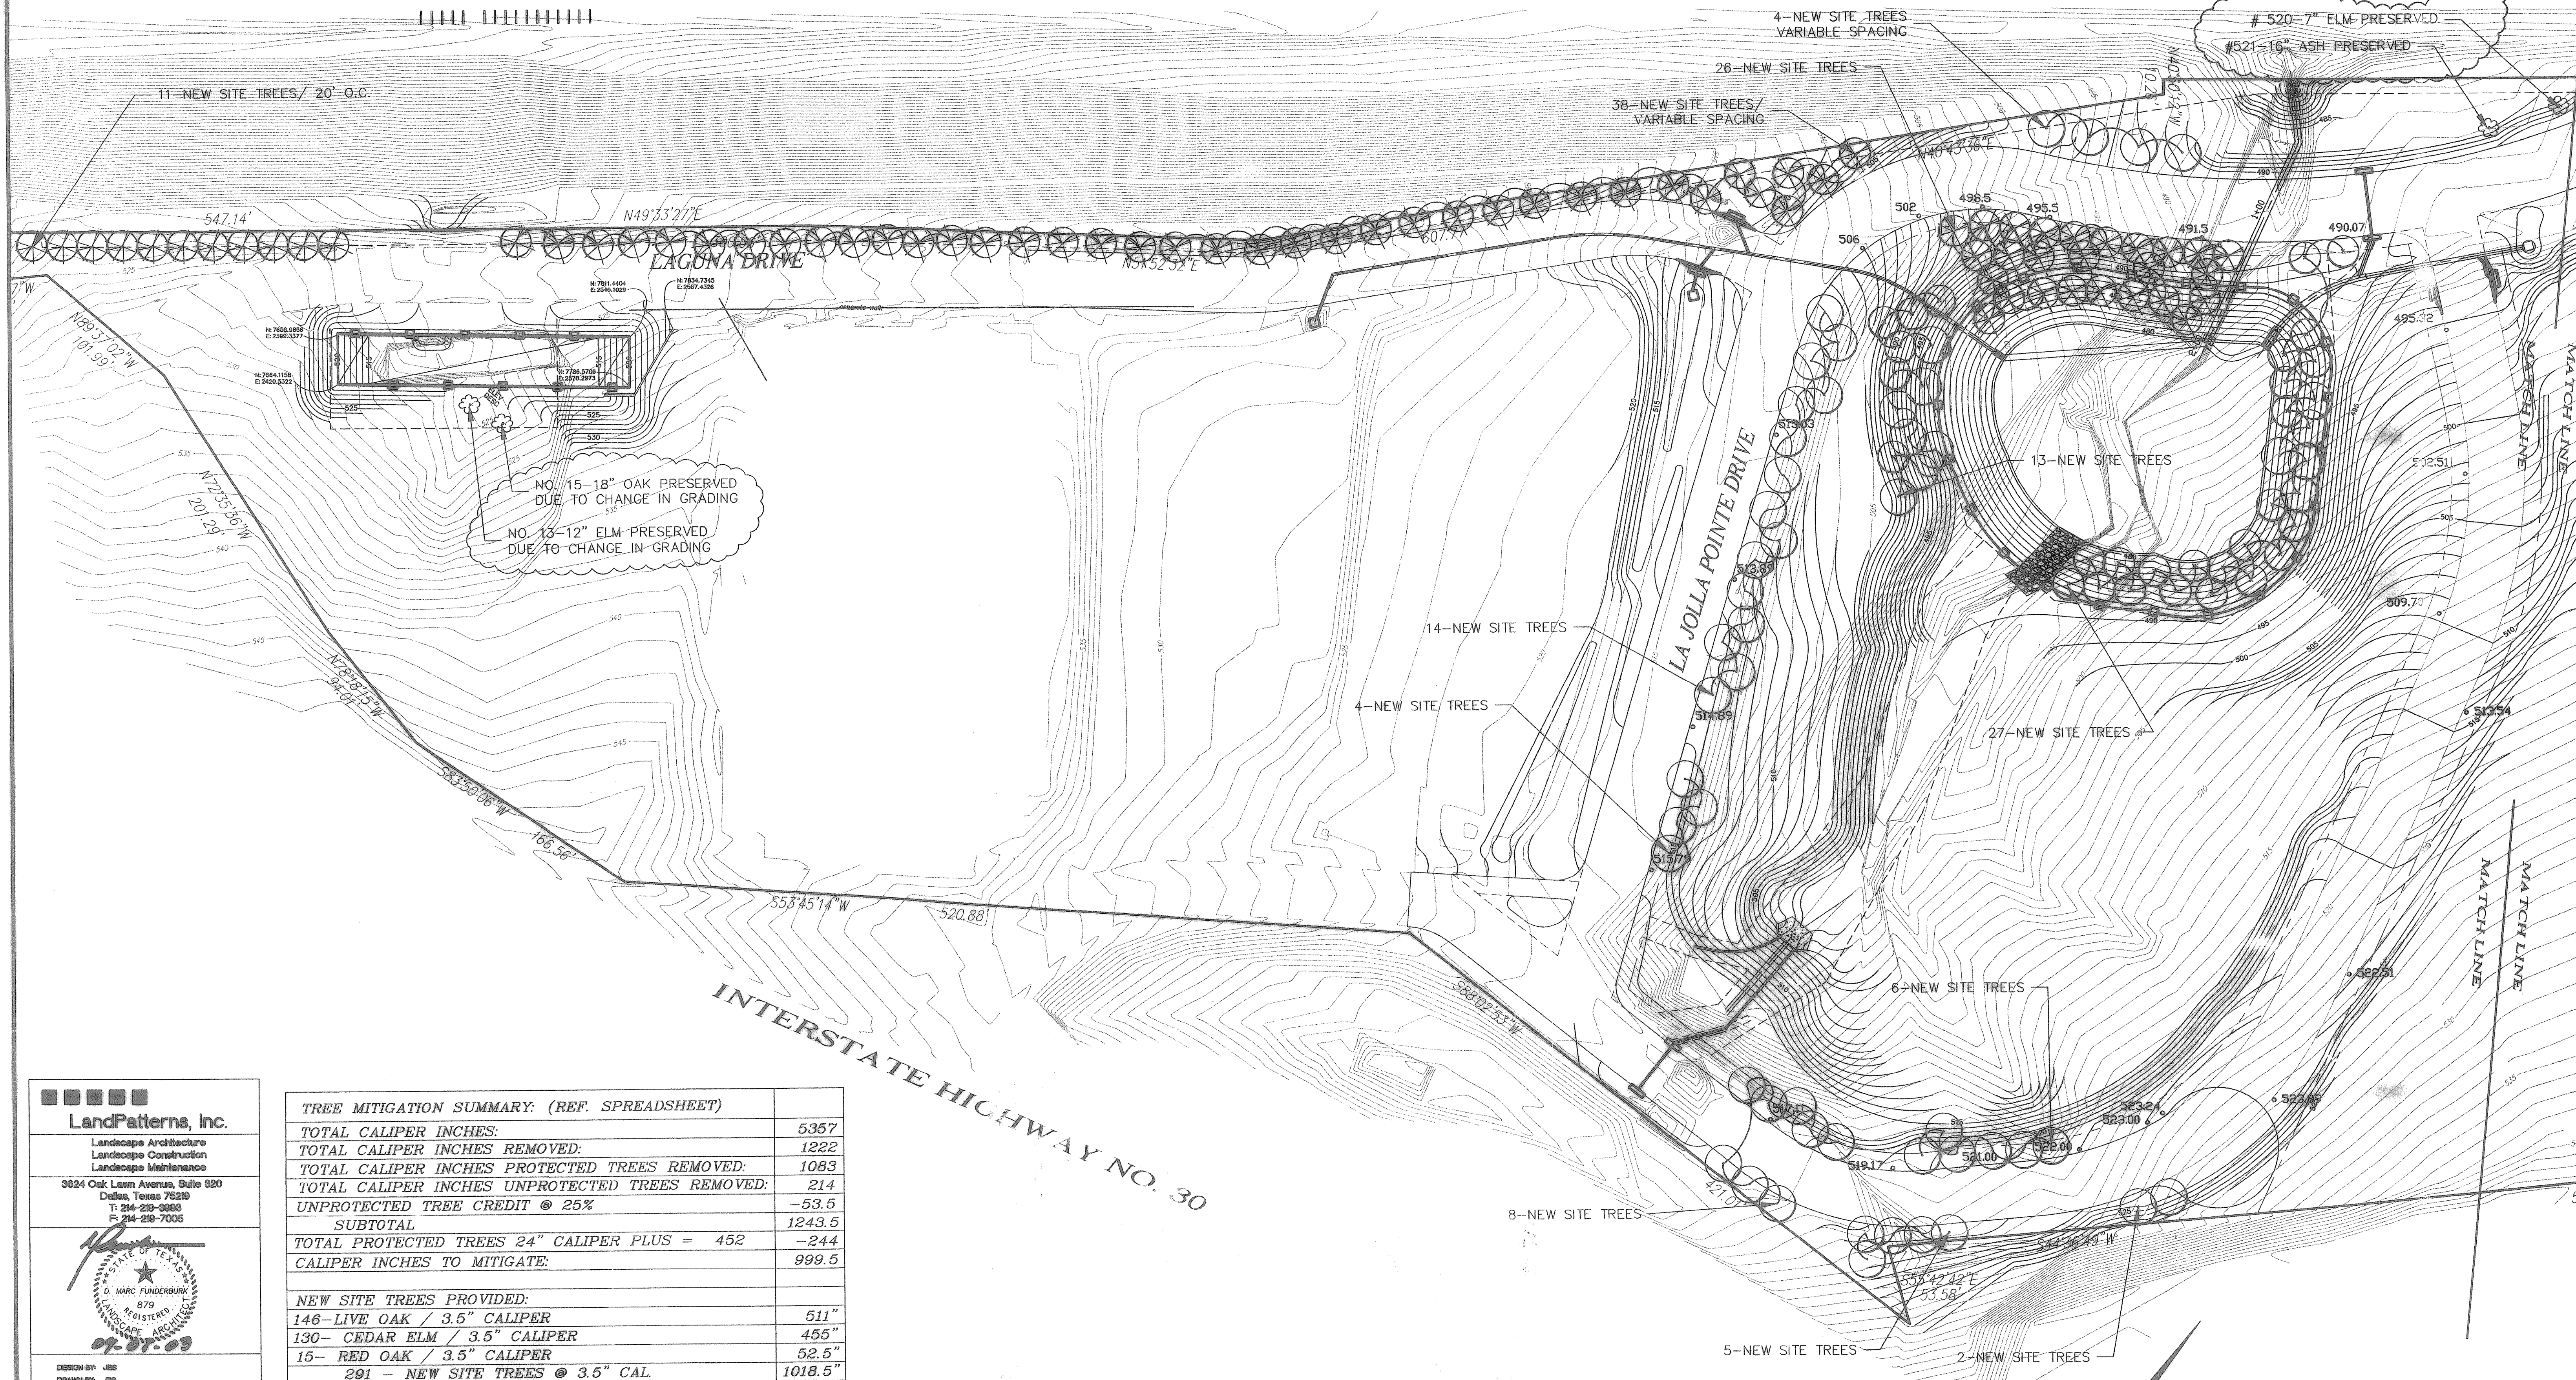

LandPatterns, Inc.
Landscape Architecture
Landscape Construction
Landscape Maintenance
3624 Oak Lawn Avenue, Suite 320
Dallas, Texas 75219
T: 214-219-3693
F: 214-219-7005

STATE OF TEXAS
LANDSCAPE ARCHITECT
D. MARC FINDERBURN
REGISTERED
879
09-07-09

DESIGN BY: JBS
DRAWN BY: JBS
CHECKED BY: DMF
DATE: SEPTEMBER 4, 2009


TREE MITIGATION SUMMARY: (REF. SPREADSHEET)	
TOTAL CALIPER INCHES:	5357
TOTAL CALIPER INCHES REMOVED:	1222
TOTAL CALIPER INCHES PROTECTED TREES REMOVED:	1083
TOTAL CALIPER INCHES UNPROTECTED TREES REMOVED:	214
UNPROTECTED TREE CREDIT @ 25%	-53.5
SUBTOTAL	1243.5
TOTAL PROTECTED TREES 24" CALIPER PLUS =	452
CALIPER INCHES TO MITIGATE:	999.5
NEW SITE TREES PROVIDED:	
146-LIVE OAK / 3.5" CALIPER	511"
130- CEDAR ELM / 3.5" CALIPER	455"
15- RED OAK / 3.5" CALIPER	52.5"
291 - NEW SITE TREES @ 3.5" CAL.	1018.5"

NOTE: ABOVE TABLE COINCIDES WITH SUMMARY SPREADSHEET PROVIDED TO CITY OF ROCKWALL ON MARCH 6, 2003. PER THIS AS BUILT DRAWING AN ADDITIONAL 53" INCHES PROTECTED TREES PRESERVED BY ON-SITE GRADING CHANGES. ADDITIONAL PRESERVED TREES NOT INCLUDED IN TABULATIONS.

AS-BUILT TREE MITIGATION PLAN
LA JOLLA POINTE ADDITION
35.989 ACRES ACRES
W. BLEVINS SURVEY, ABSTRACT NO. 200
CITY OF ROCKWALL
ROCKWALL COUNTY, TEXAS

RECORD DRAWINGS
AS PROVIDED BY:
I.C.S. COMMERCIAL

MICHAEL S. ALLEN, P.E.
DATE:

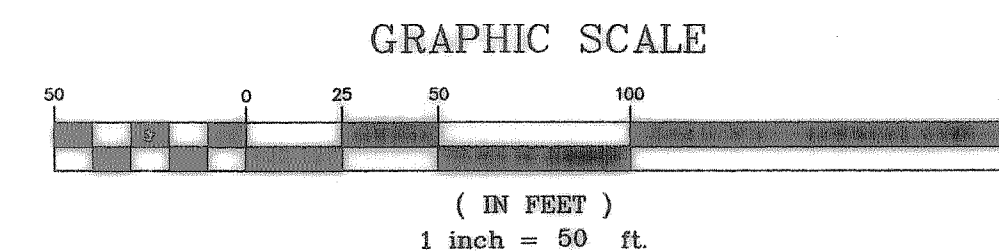

SHEET
LP1.2