




SECTION 1


SECTION 2

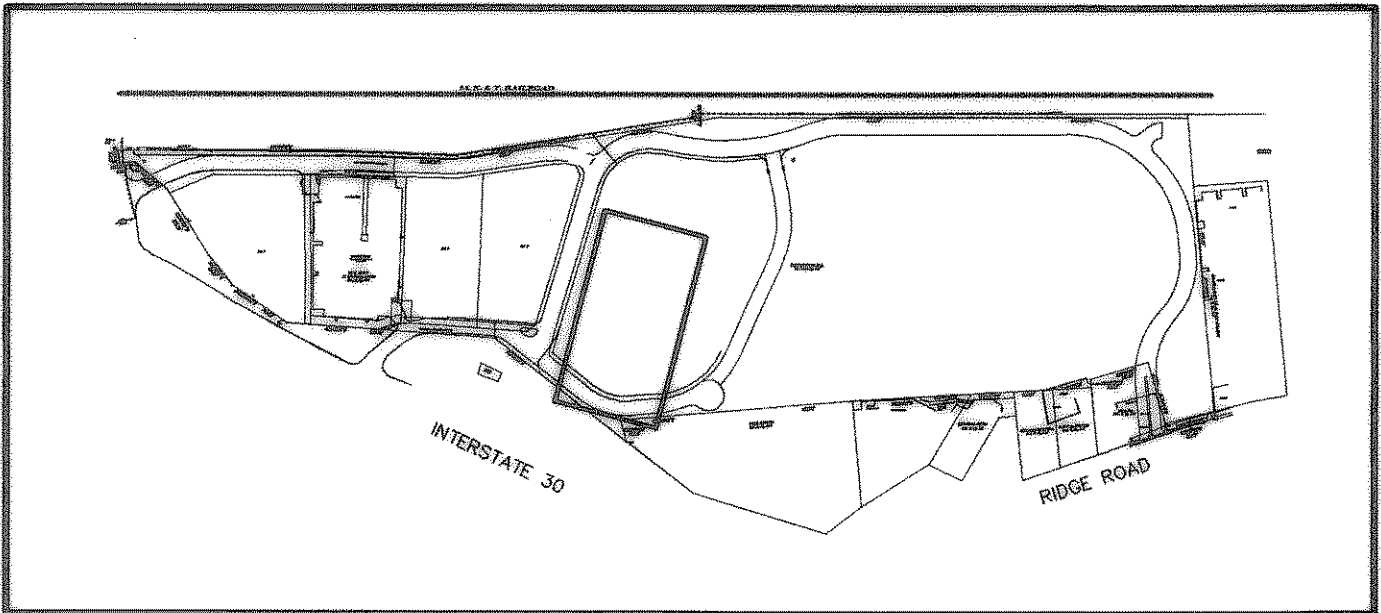

SECTION 3

VICINITY MAP

RECORD DRAWINGS
AS PROVIDED BY:
I.C.S. COMMERCIAL
MICHAEL S. ALLEN, P.E.
DATE: 9/25/03

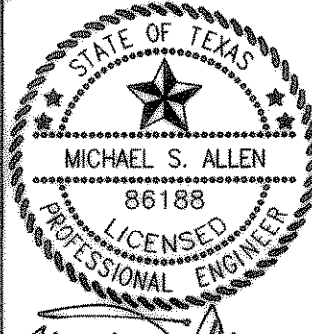

3/14/03

La Jolla Pointe Addition
ROCKWALL, TEXAS

DRAINAGE EASEMENT SECTIONS

Scale: 1"=40' HOR., 1"=4' VERT.
Designed by: MSA
Drawn by: MSA
Checked by: MSA
Date: March 14, 2003
Project No. 018-001

SHEET
C-25
OF 25

