




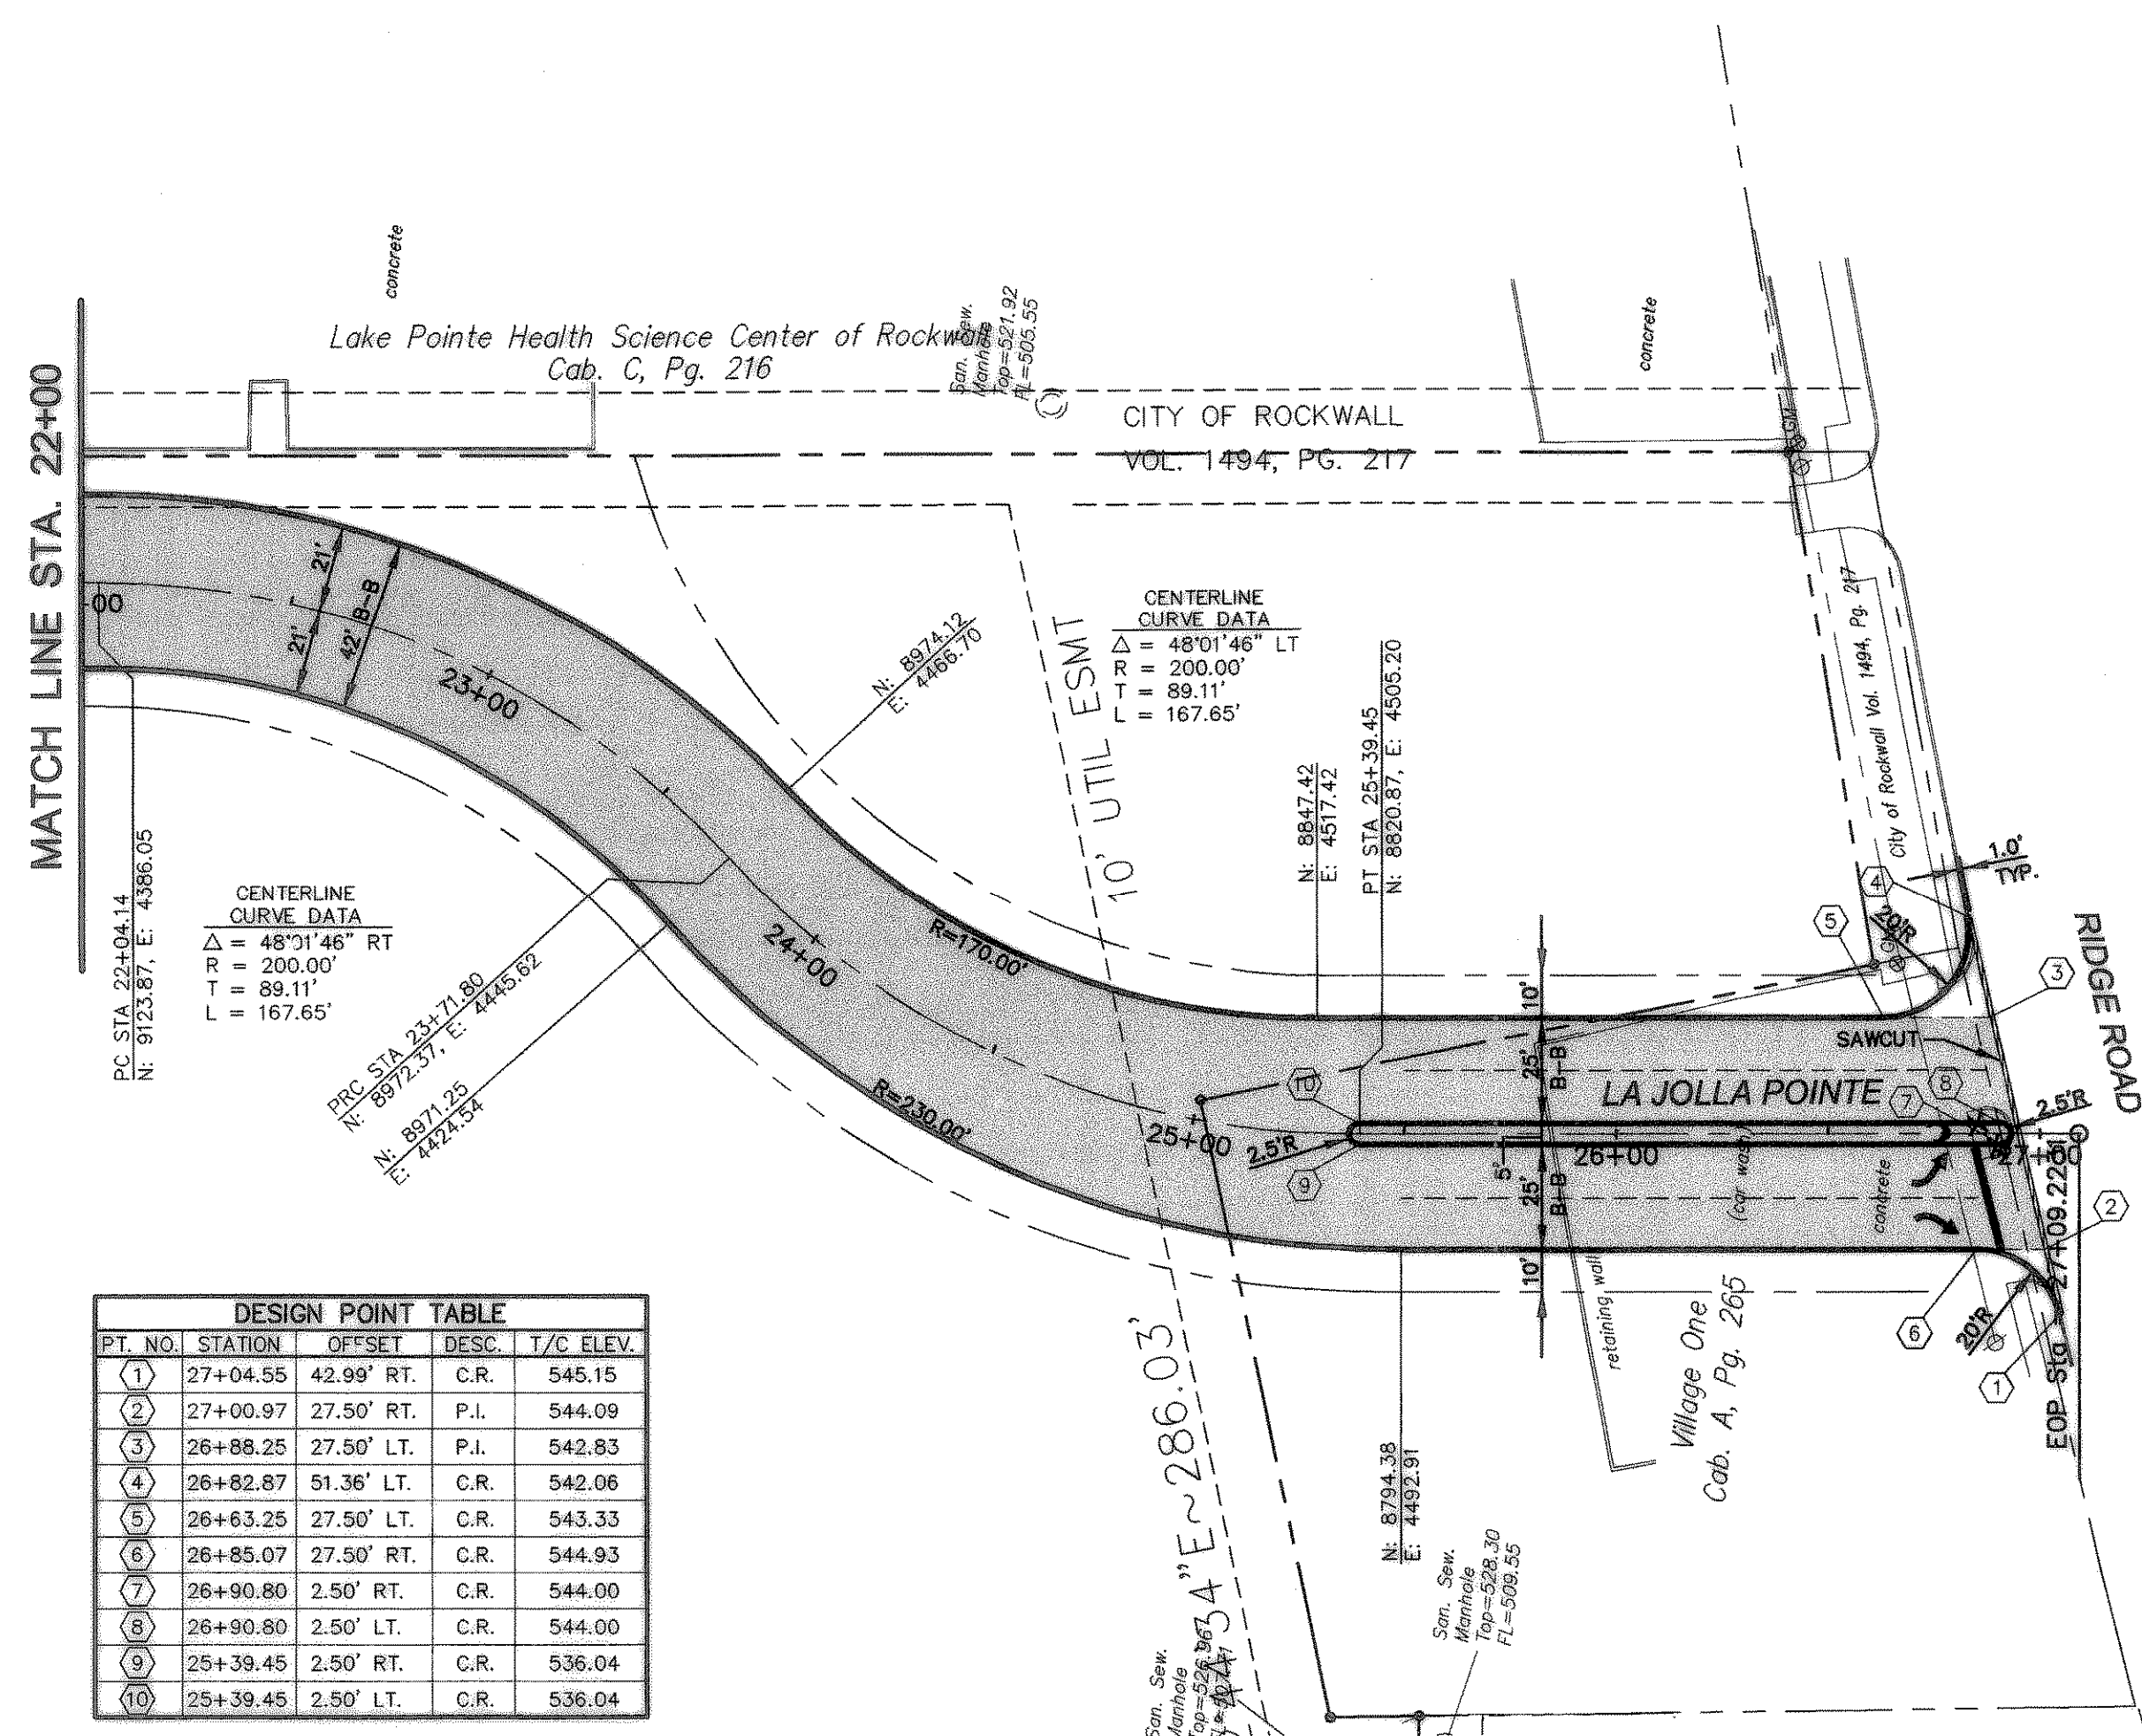

LA JOLLA POINTE

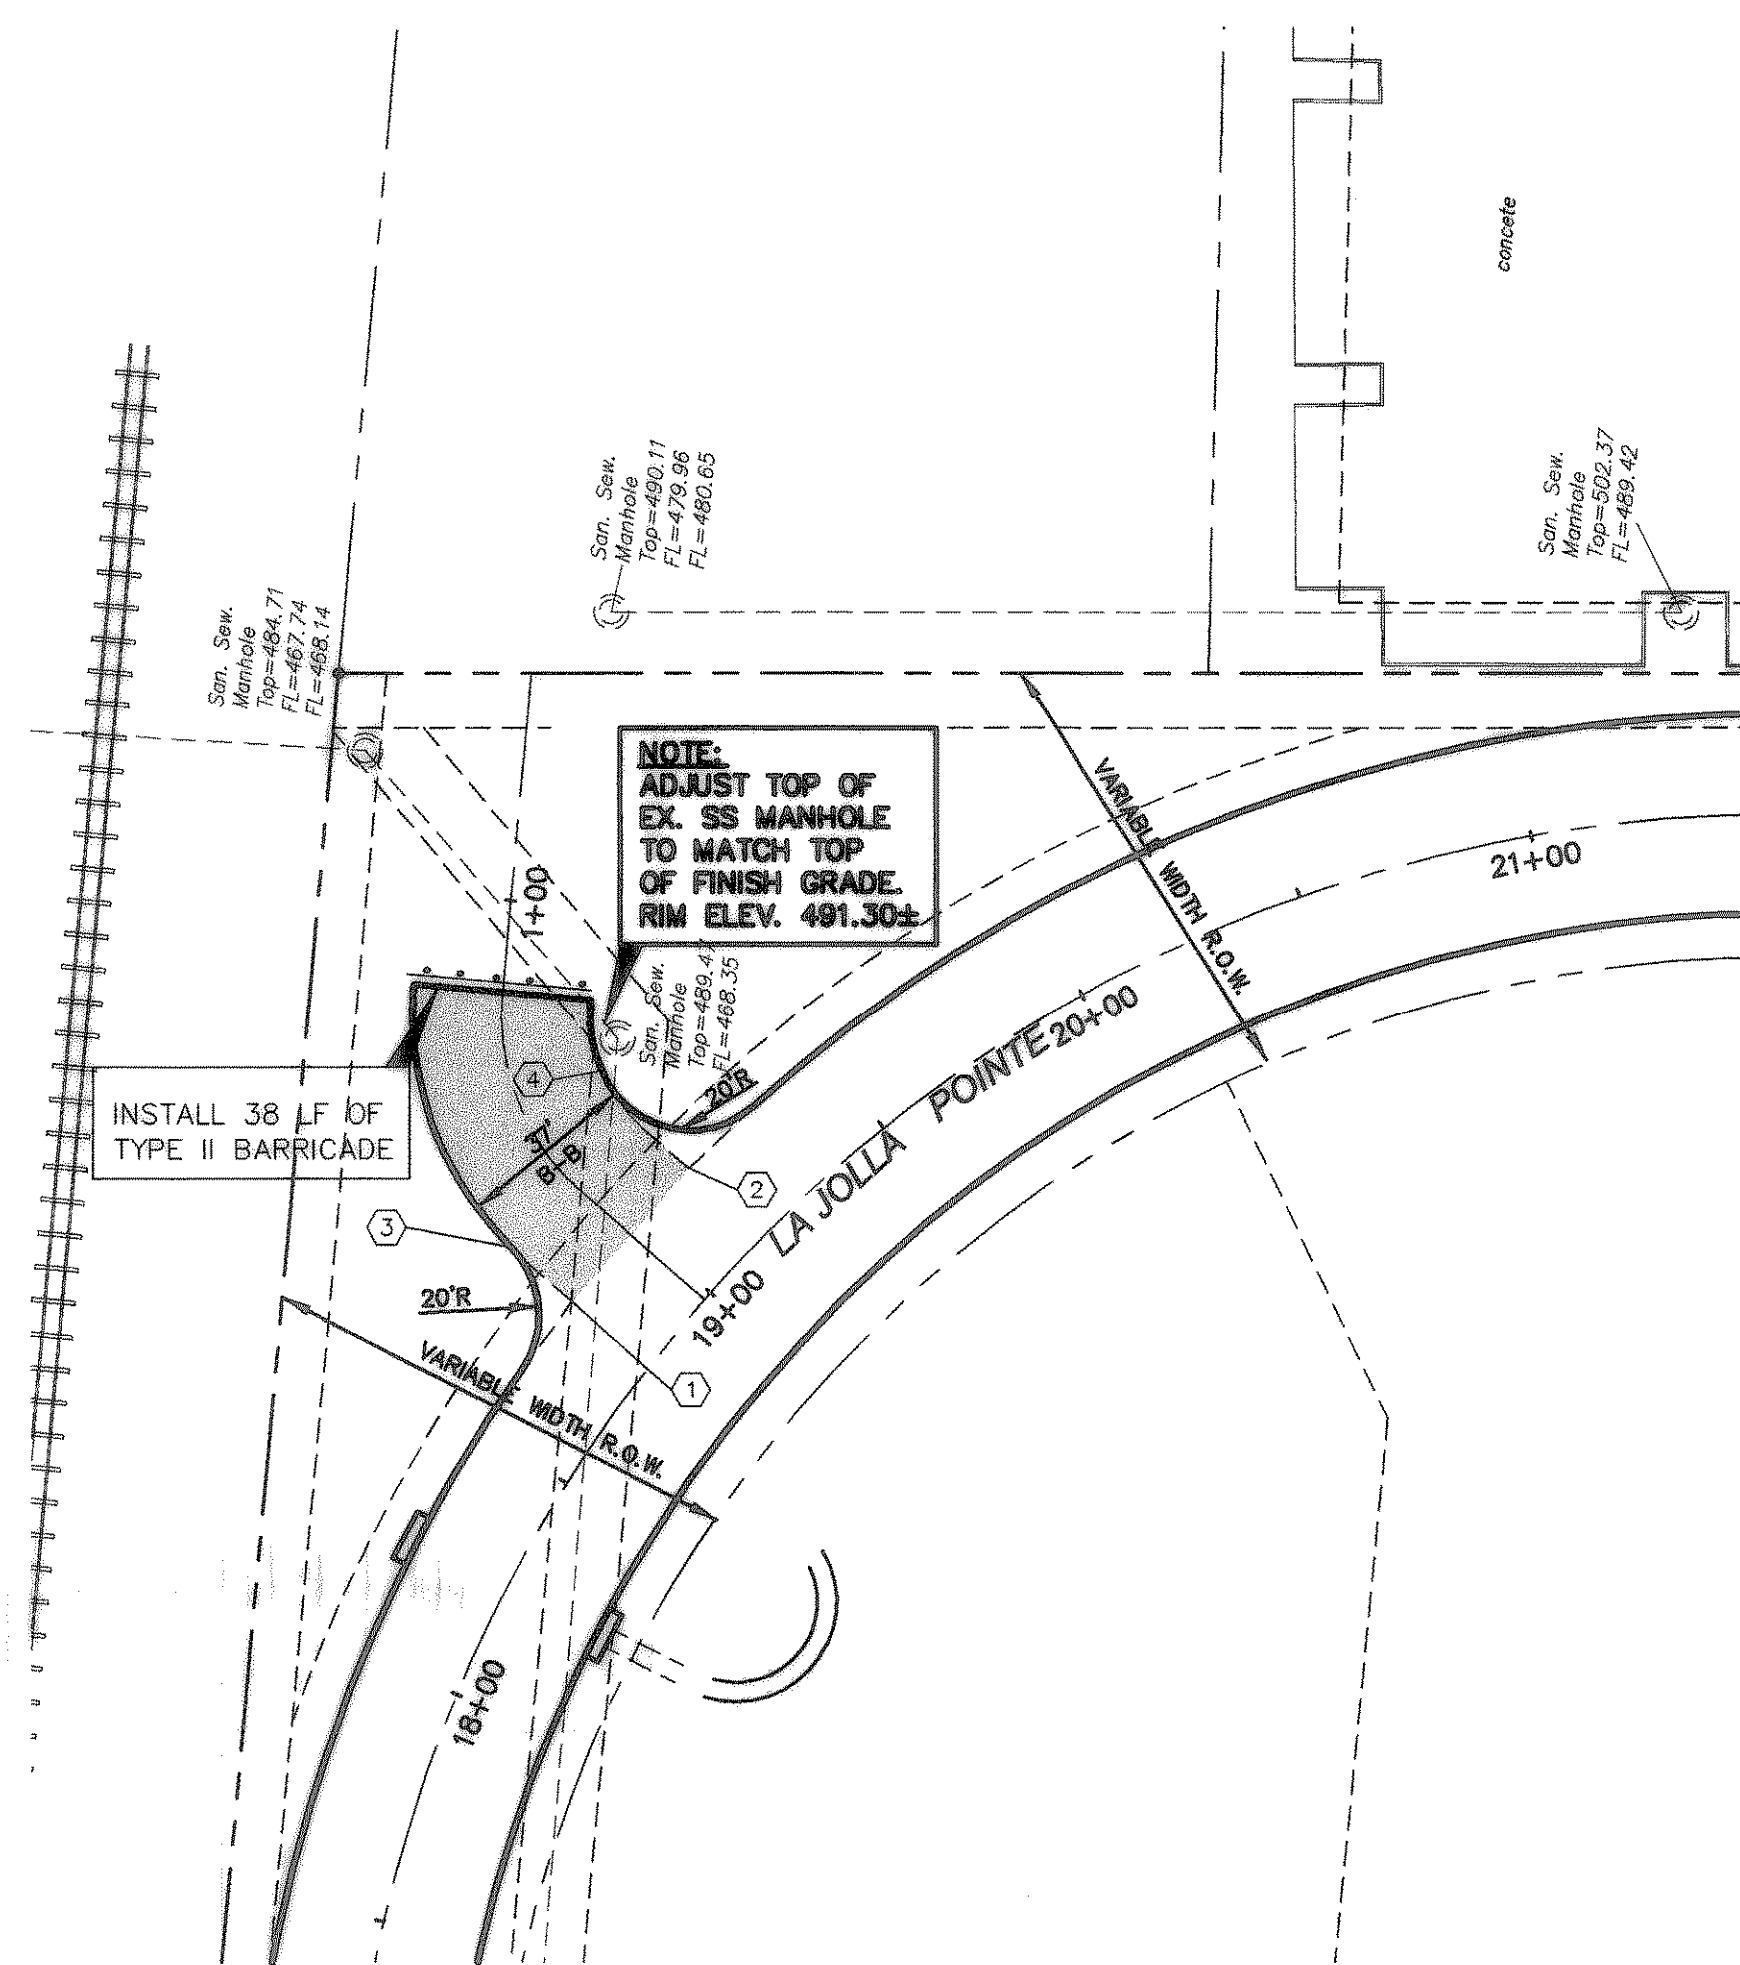

LA JOLLA POINTE DRIVE STUB

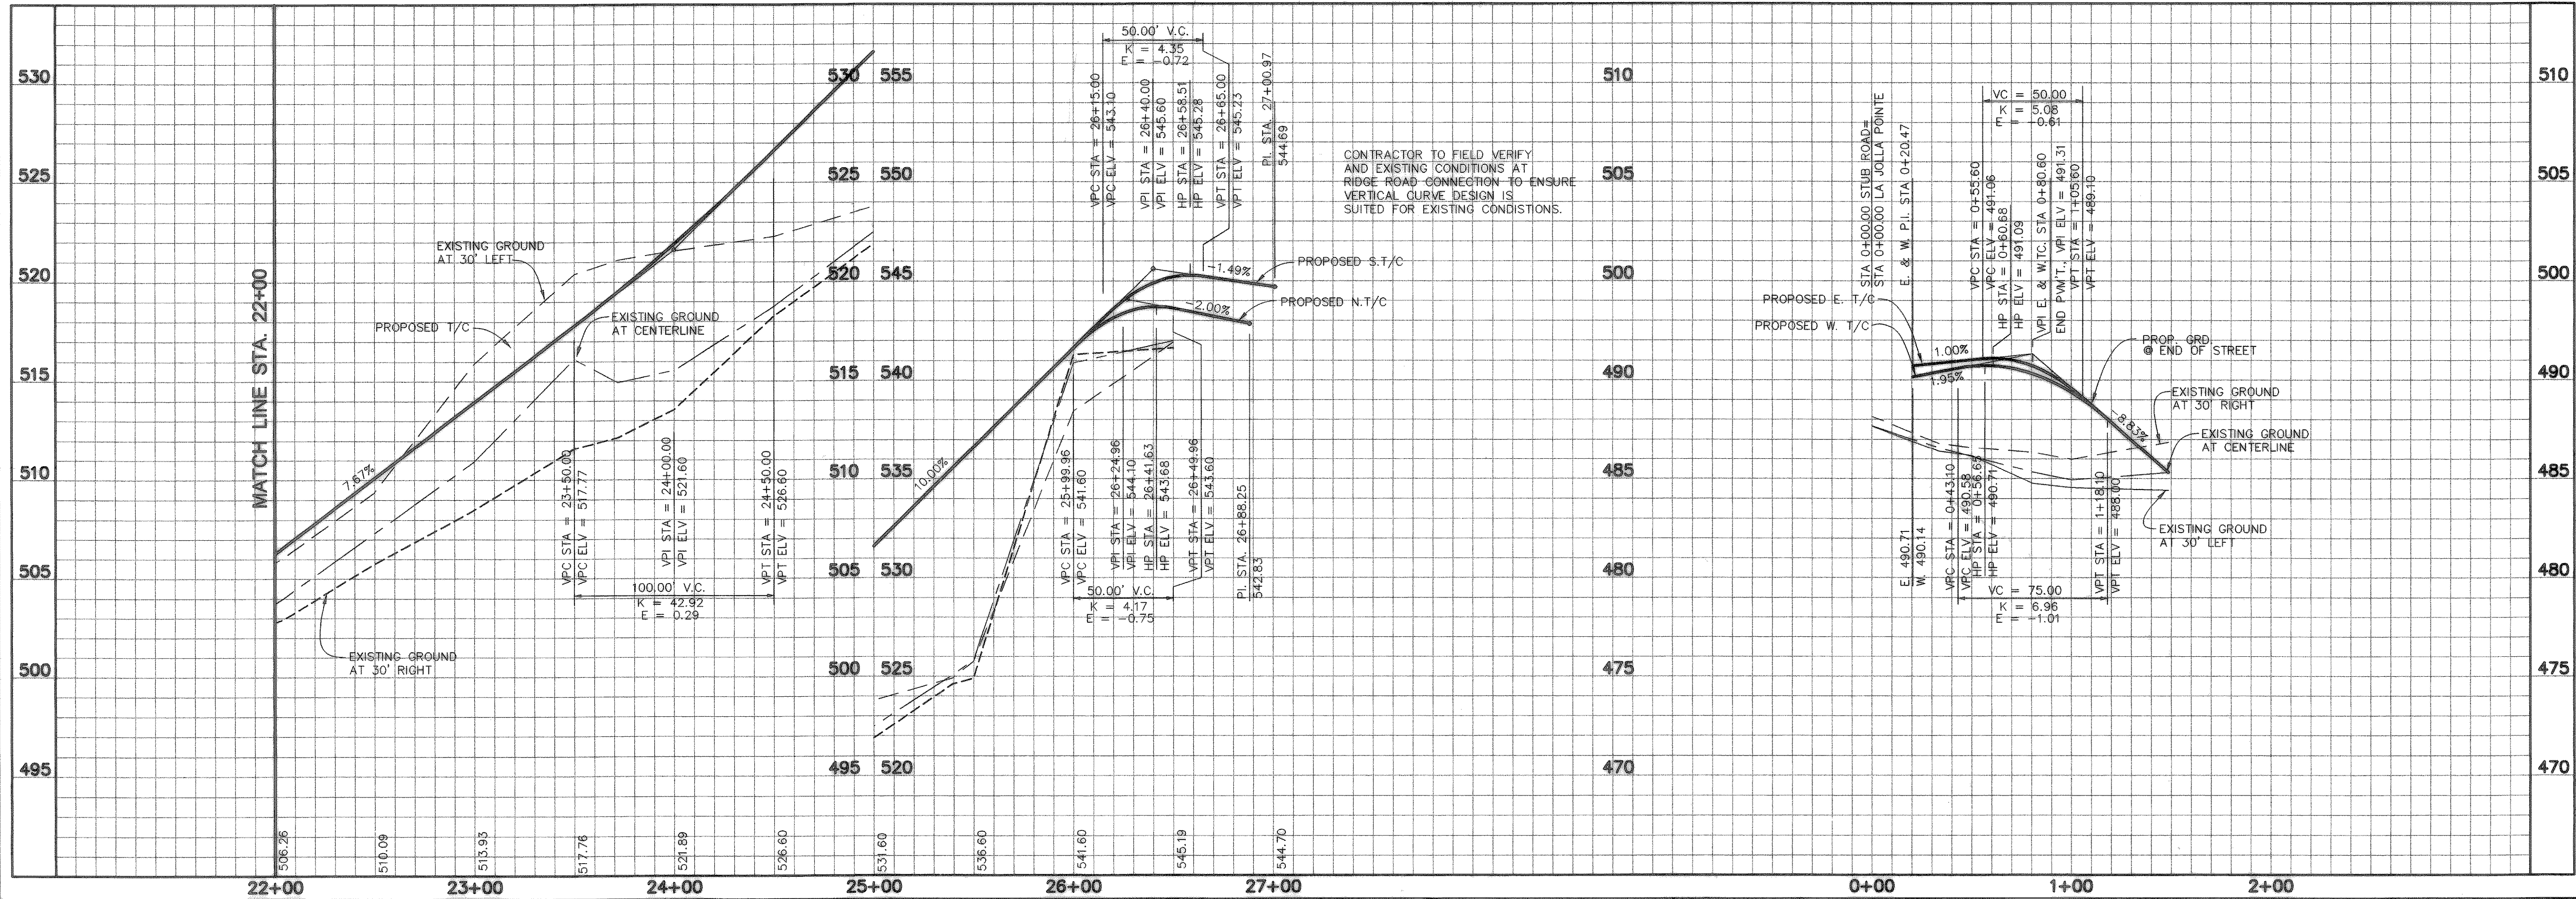

PAVING PLAN AND PROFILE
LA JOLLA POINTE
STA 22+00 TO END

Scale: 1"=40' HOR., 1"=4' VERT.
Designed by: MSA
Drawn by: MSA
Checked by: MSA
Date: March 14, 2003
Project No. 018-001

SHEET
C-4
OF 25

La Jolla Pointe Addition
ROCKWALL, TEXAS

Michael S. Allen
Professional Engineer
3/14/03

Allen & Ridinger
Consulting, Inc.
103 W. Main Street
Lewisville, Texas 75057
Tel. No. (972) 353-8000
Fax No. (972) 353-8011

DESIGN POINT TABLE

PT. NO.	STATION	OFFSET	DESC.	T/C ELEV.
1	0+20.47	18.50' LT.	P.I.	490.14
2	0+20.47	18.50' RT.	P.I.	490.71
3	0+36.55	18.50' LT.	C.R.	490.45
4	0+56.56	18.50' RT.	C.R.	491.07

RECORD DRAWINGS
AS PROVIDED BY:
I.C.S. COMMERCIAL
Michael S. Allen, P.E.
DATE: 9/25/03