


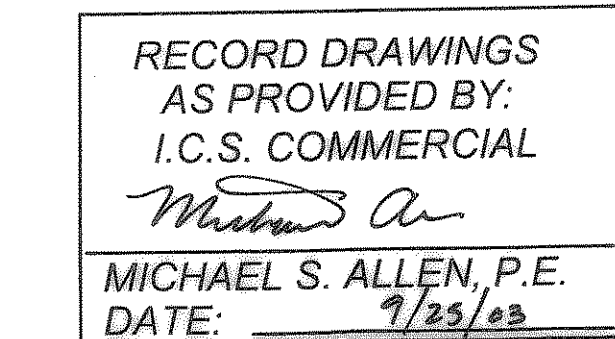


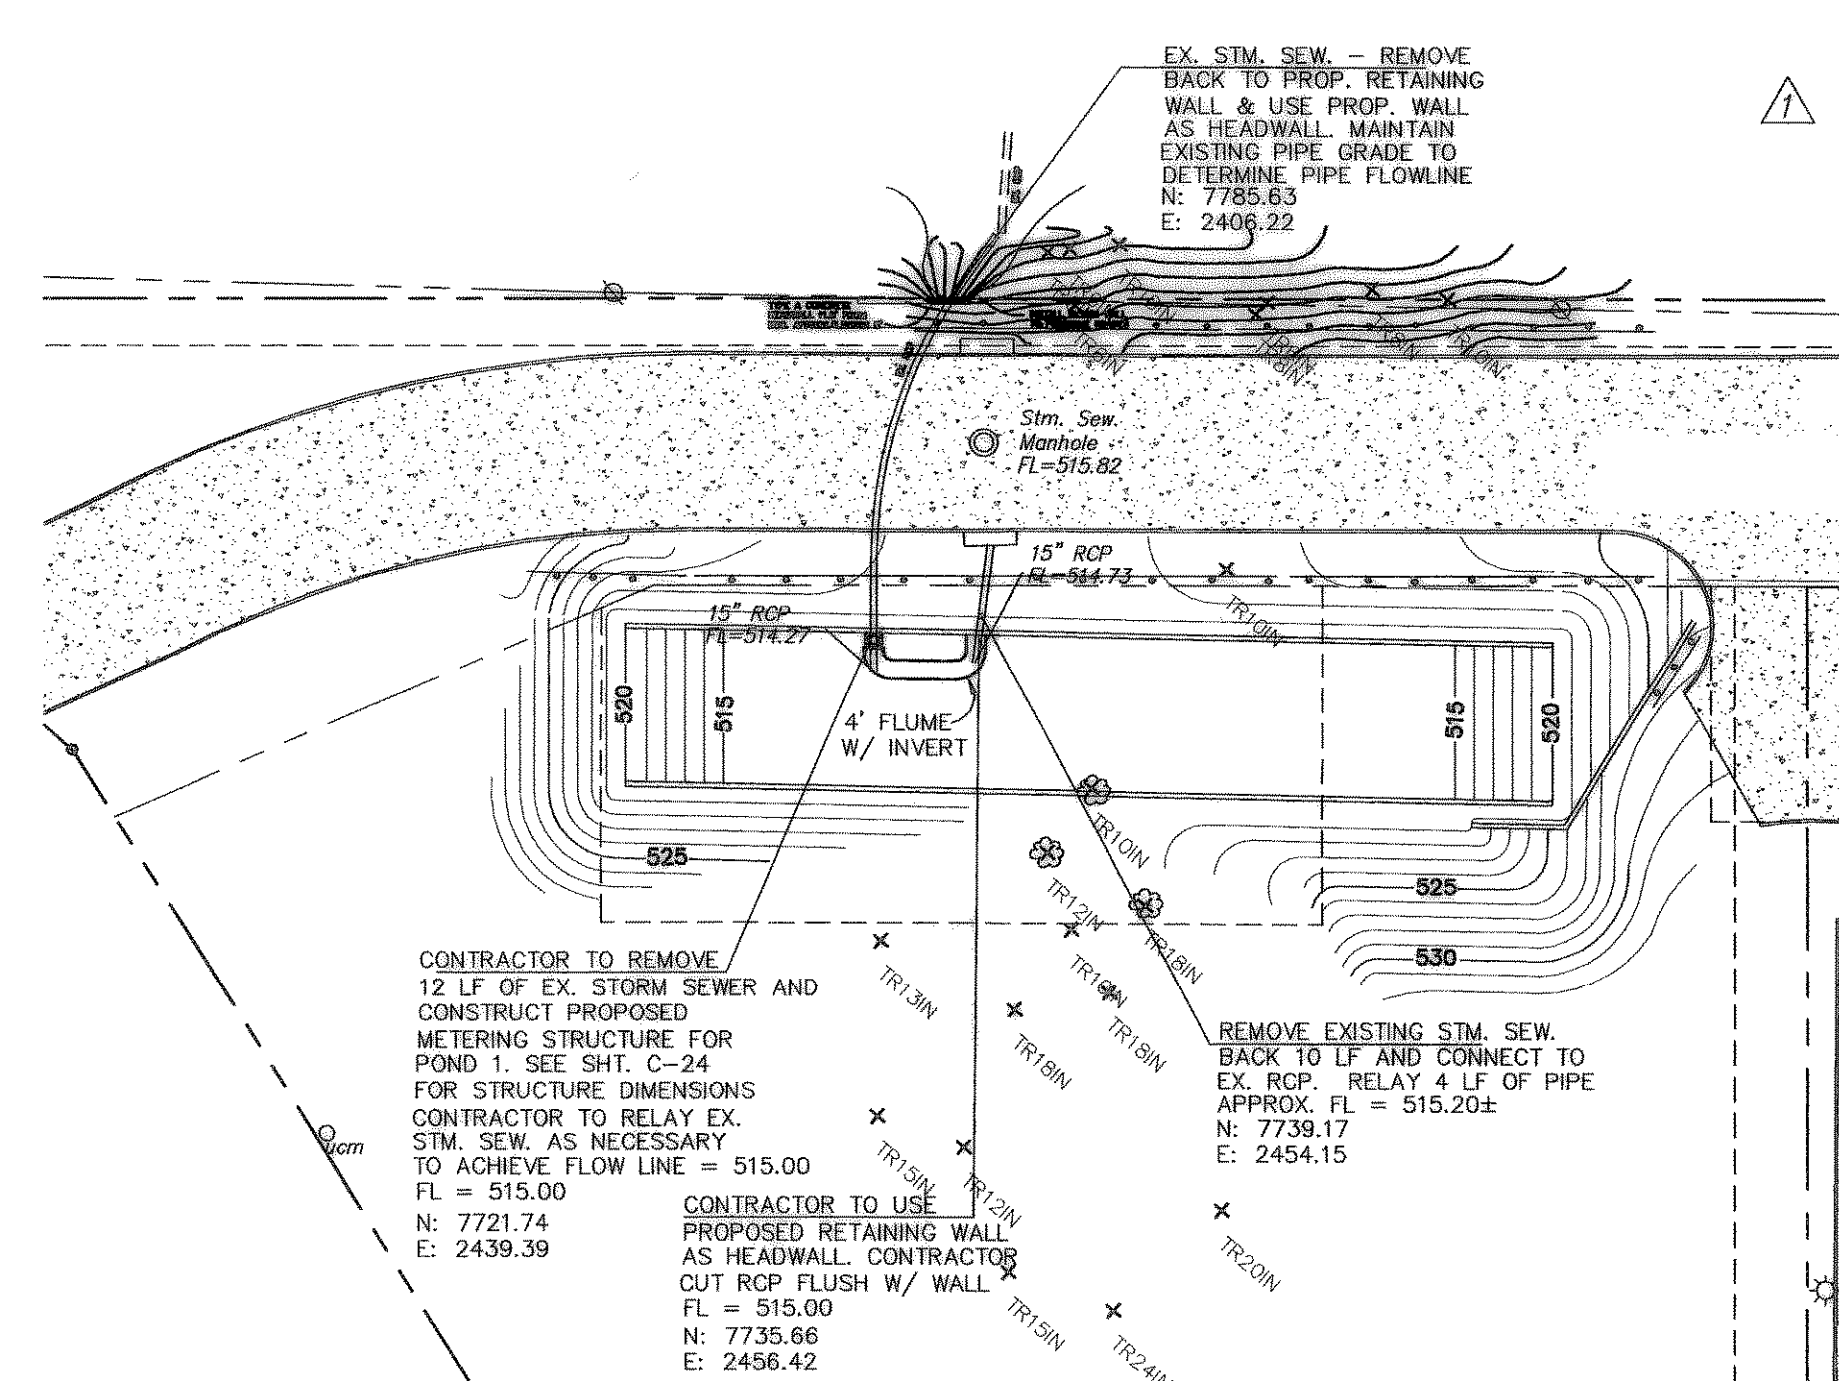

REQUIRED VOLUMES		PROVIDED VOLUMES	
BASED ON STAGE VS. STORAGE CURVE FOR FORD		BASED ON STAGE VS. STORAGE CURVE FOR FORD	
CALCULATED STORAGE ELEV. (FT)	CAL. MIN. STORAGE VALUE (FT ³)	CALCULATED STORAGE ELEV. (FT)	CAL. STORAGE VALUE (FT ³)
519.49	24,661	520	27,882
518.85	20,884	519	21,712
518.6	19,023	518	15,840
517.9	15,362	517	10,285
517.5	12,973	516	4,985
516.88	10,166	515	0

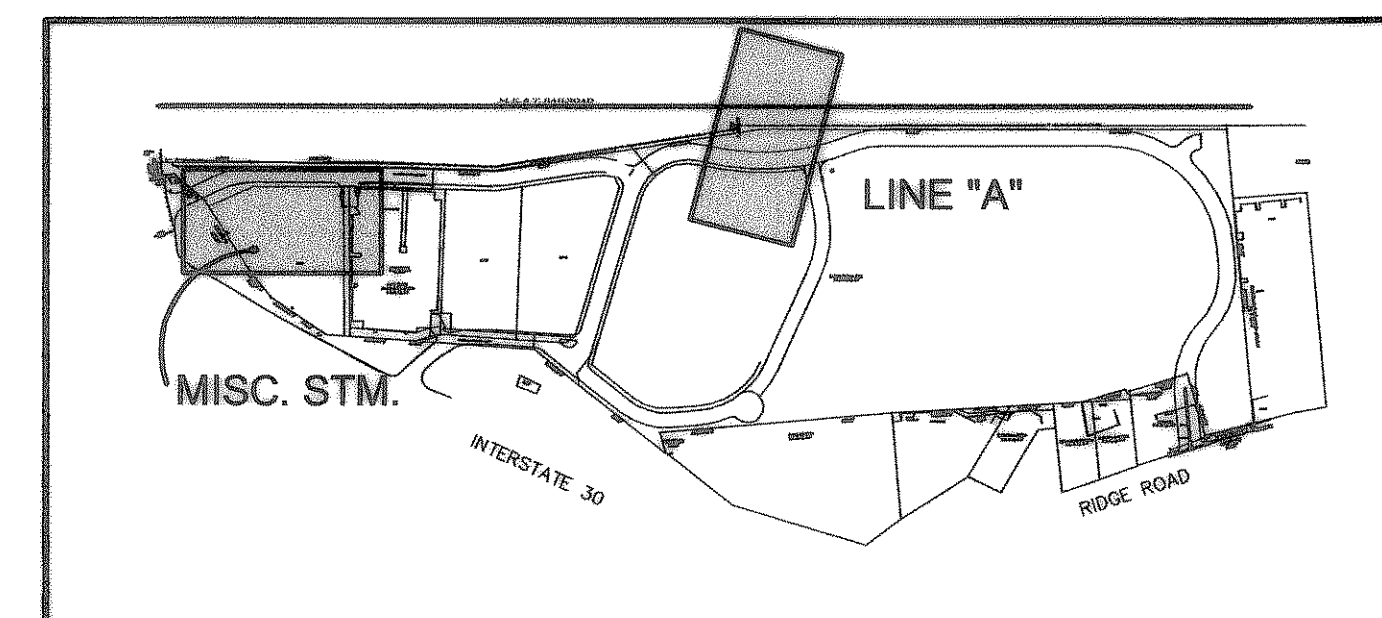

VICINITY MAP
N.T.S.

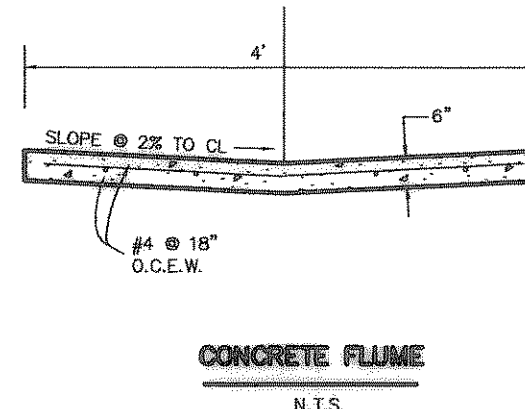