
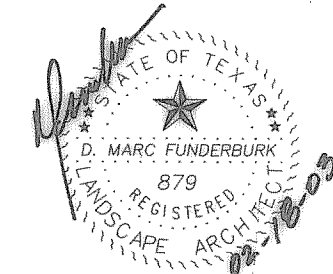


M. K. & T. RAILROAD

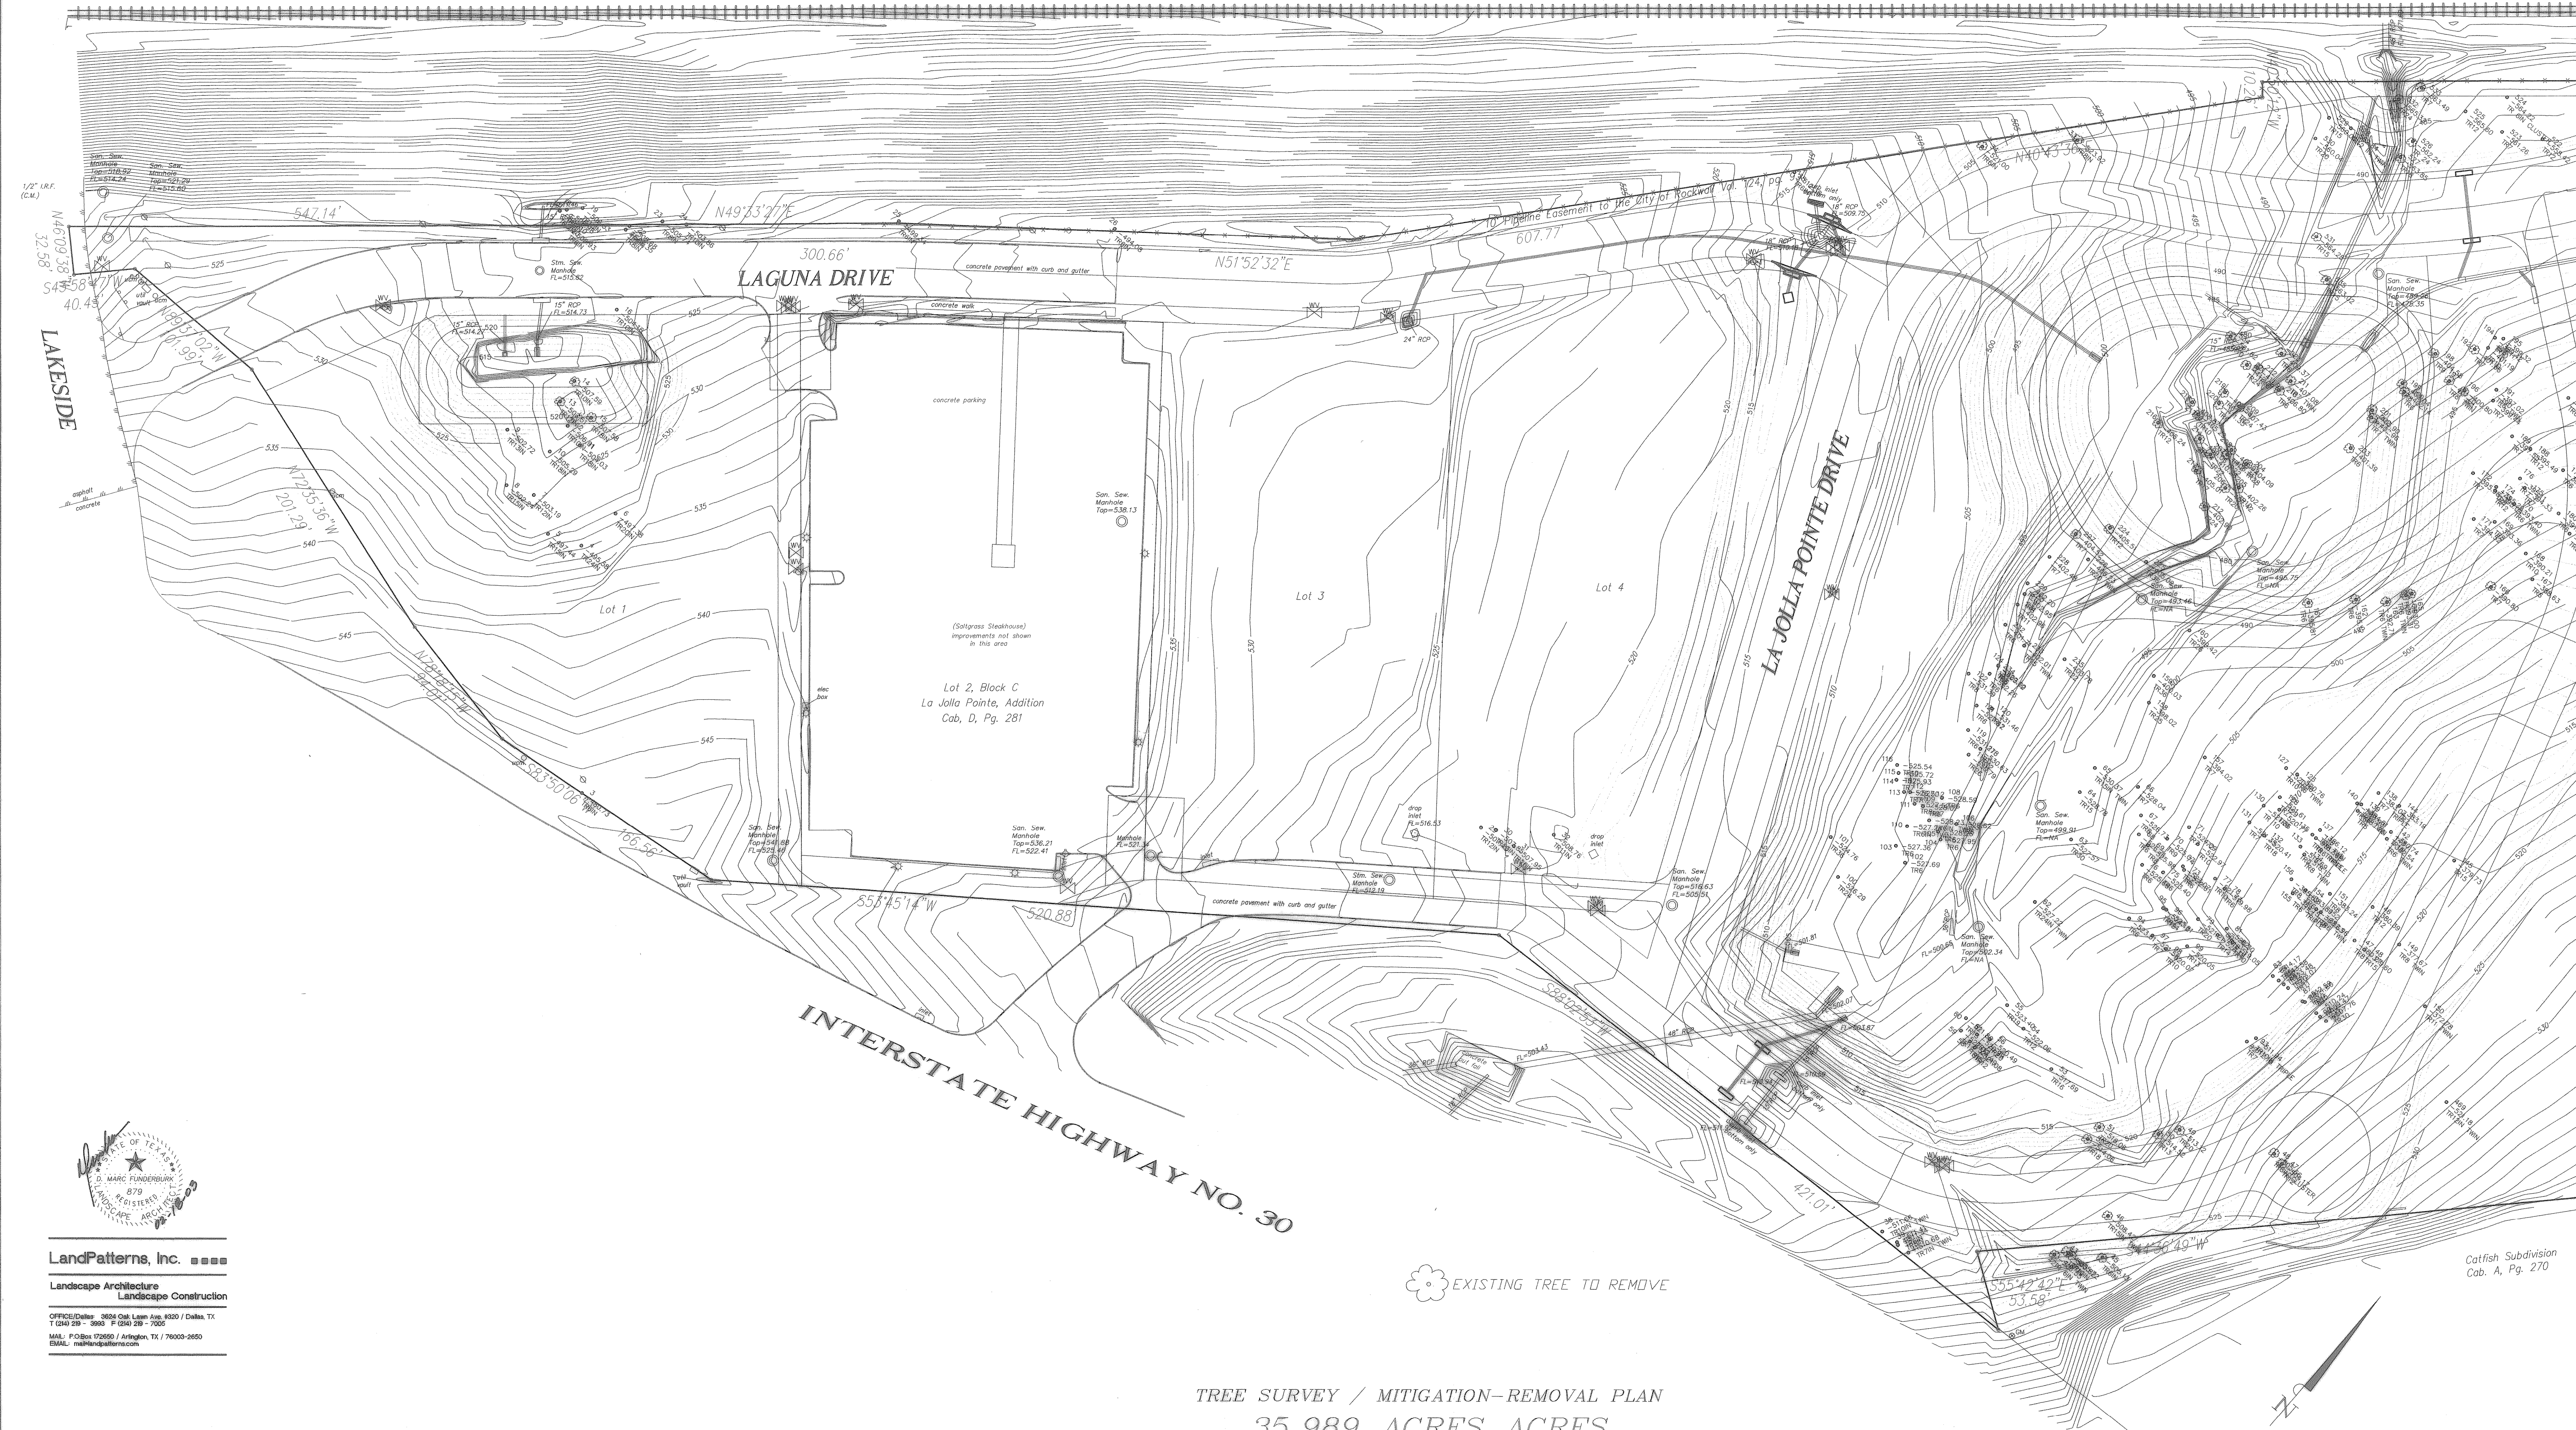


LandPatterns, Inc. ■■■■
Landscape Architecture
Landscape Construction
OFFICE/Dallas: 3604 Oak Lawn Ave. #320 / Dallas, TX
T: 214.259-1993 F: 214.259-7022
MAIL: P.O. Box 172650 / Arlington, TX / 76003-2650
EMAIL: mail@landpatterns.com

DATE:	2/17/2003
SCALE:	1" = 50'
CALC. BY:	D.M.F.
DRAWN BY:	D.M.F.
CHK. BY:	
JOB NO.:	02-LAJOLLA POINTE

TREE SURVEY / MITIGATION-REMOVAL PLAN
35.989 ACRES ACRES
W. BLEVINS SURVEY, ABSTRACT NO. 200
CITY OF ROCKWALL
ROCKWALL COUNTY, TEXAS

EXISTING TREE TO REMOVE

RECORD DRAWINGS
AS PROVIDED BY:
I.C.S. COMMERCIAL
MICHAEL S. ALLEN, P.E.
DATE:

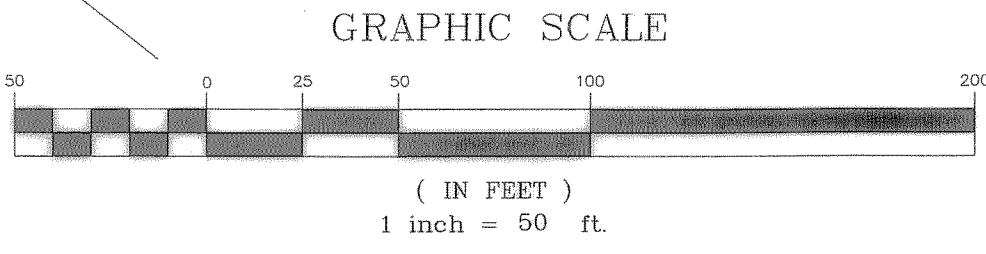

SHEET LP1.0 OF LP1.4

Catfish Subdivision
Cab. A, Pg. 270