


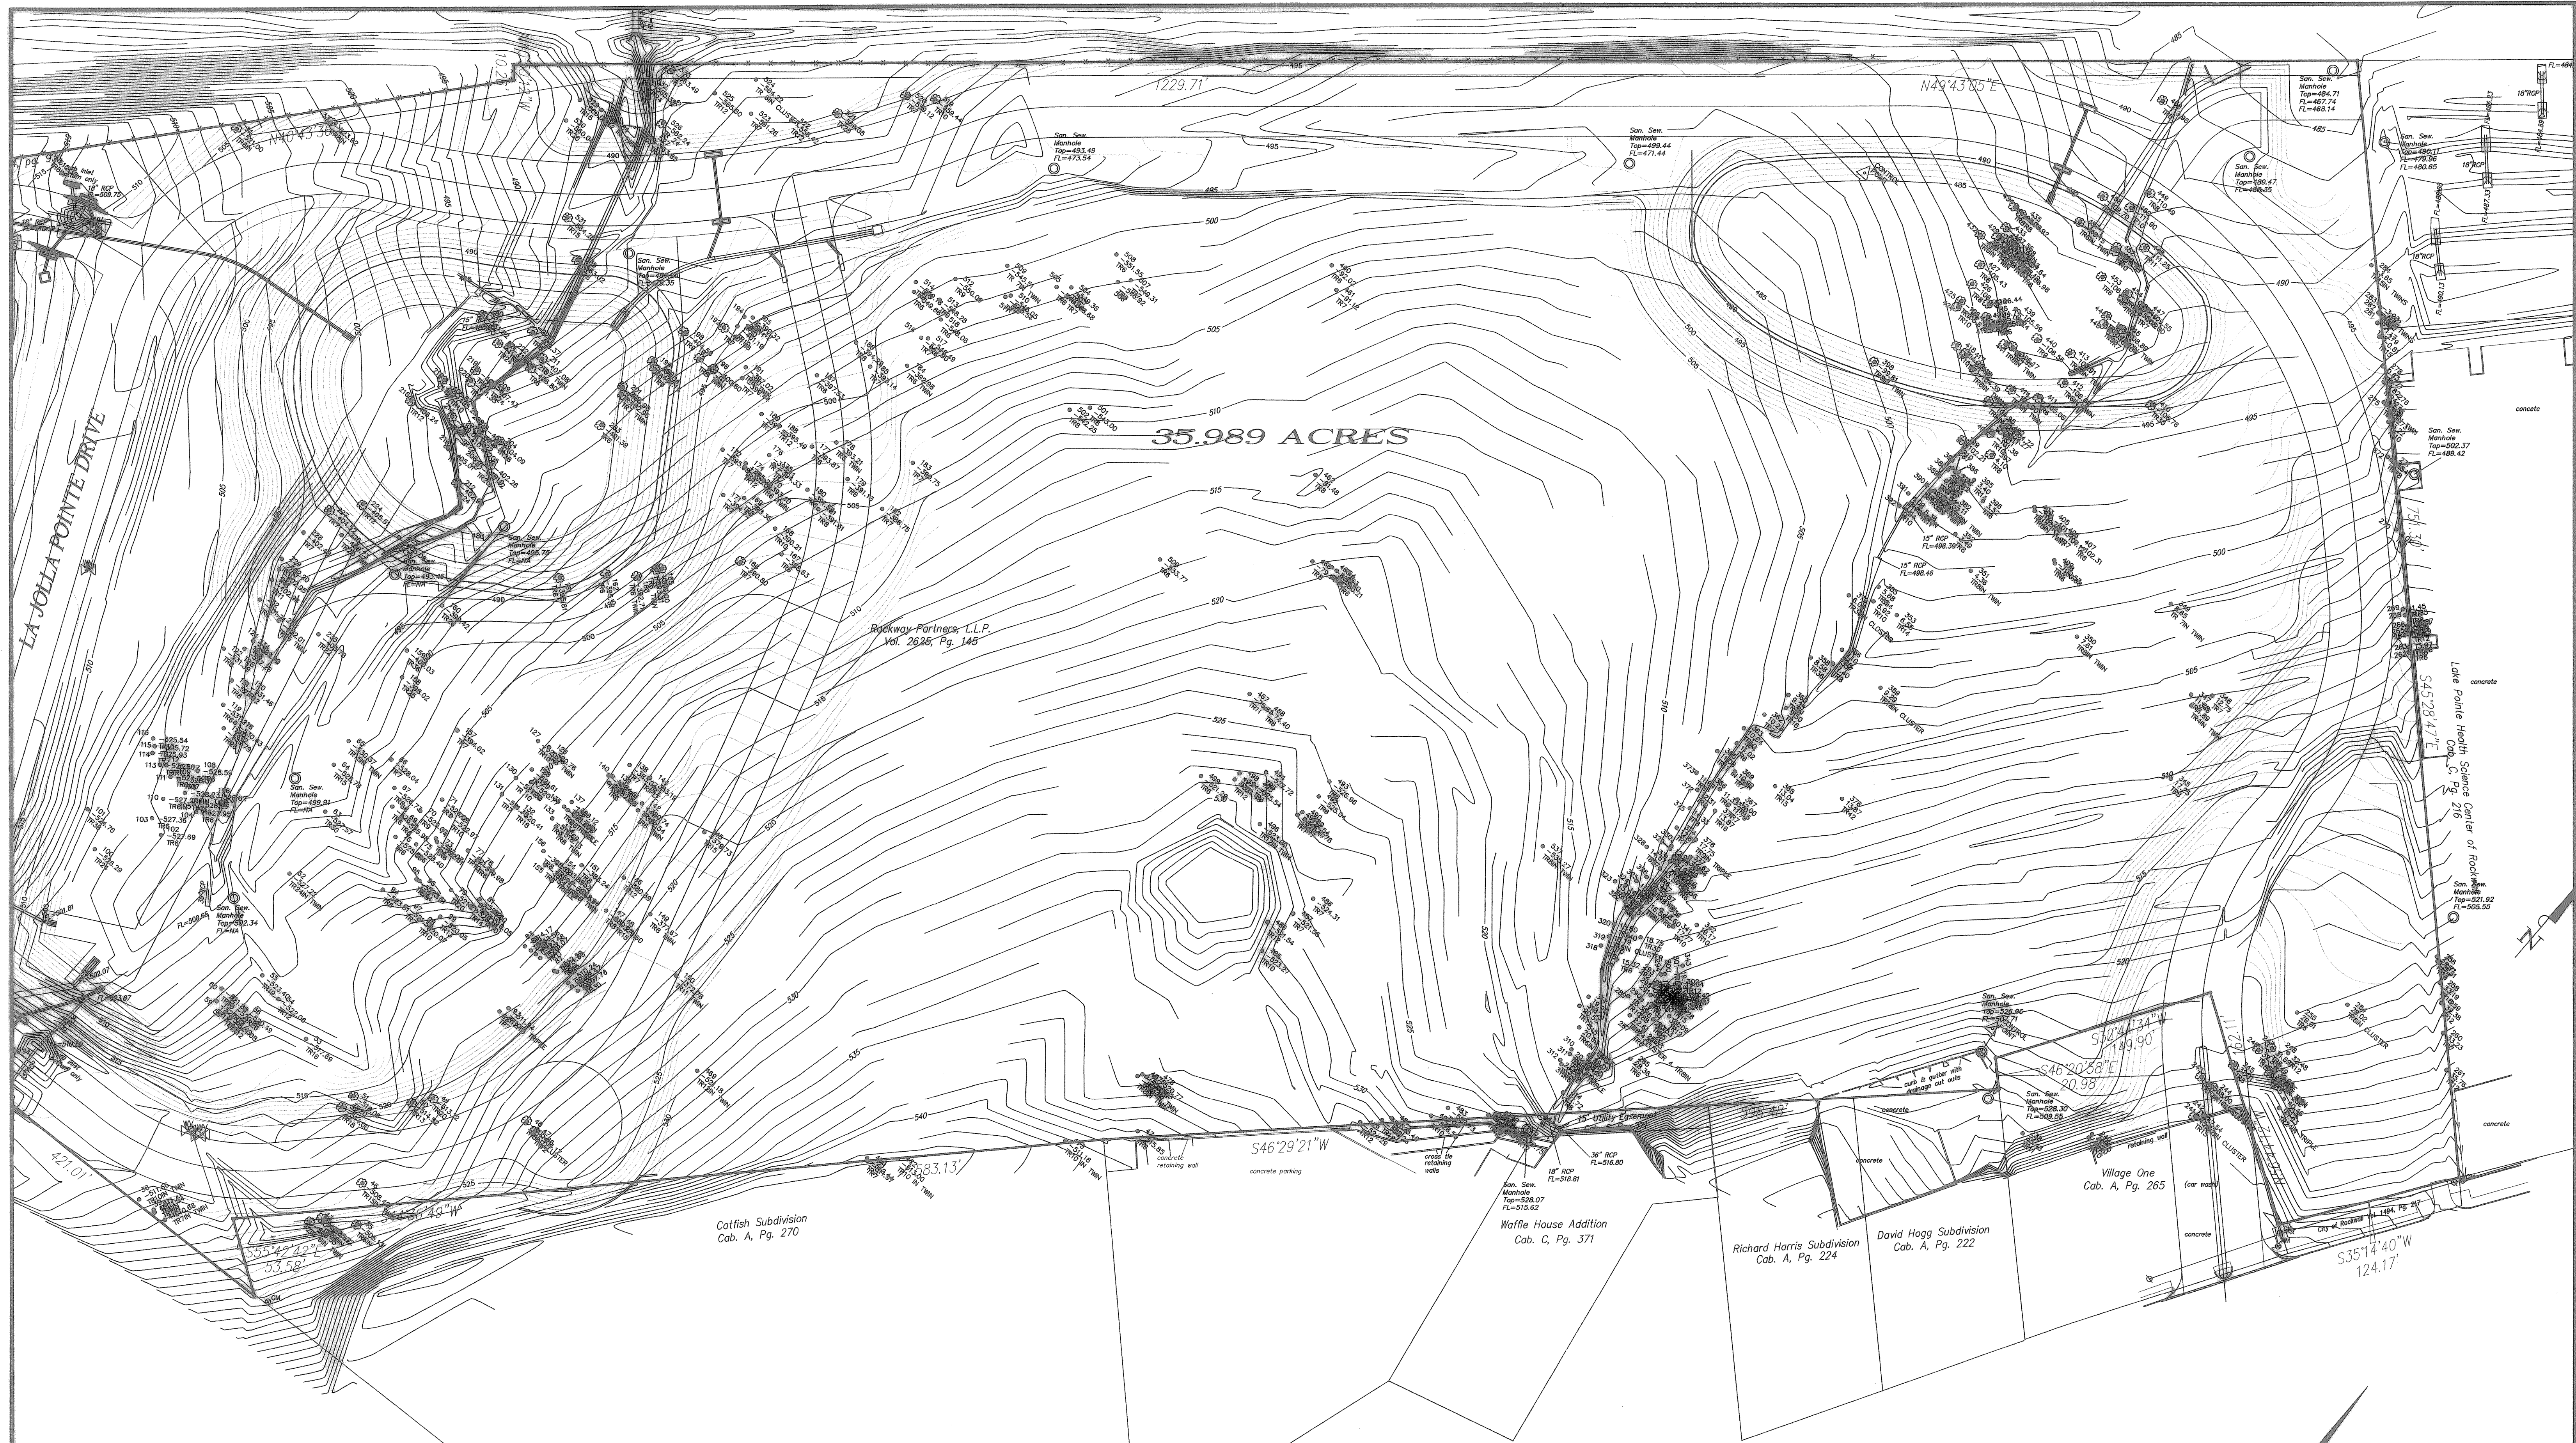

DATE: 2/17/2003
SCALE: 1" = 50'
CALC. BY: D.M.F.
DRAWN BY: D.M.F.
CHK. BY:
JOB NO.: 02-LAJOLLA POINTE

LandPatterns, Inc.
Landscape Architecture
Landscape Construction
OFFICE/DESIGN: 3800 Oak Lawn Ave. #200 / Dallas, TX
T (214) 299-7988 F (214) 299-7989
MAIL: P.O. Box 170520 / Arlington, TX 76009-0520
EMAIL: mail@landpatterns.com

TREE SURVEY / MITIGATION-REMOVAL PLAN
35.989 ACRES ACRES
W. BLEVINS SURVEY, ABSTRACT NO. 200
CITY OF ROCKWALL
ROCKWALL COUNTY, TEXAS

RECORD DRAWINGS
AS PROVIDED BY:
I.C.S. COMMERCIAL
MICHAEL S. ALLEN, P.E.
DATE:

GRAPHIC SCALE
1 inch = 50 ft.
SHEET LP1.1 OF LP1.4