


48"

DRIPLINE

ORANGE/YELLOW SAFETY FENCE OR APPROVED SUBSTITUTE.

NO GRADING, PARKING, STORAGE OR ANY OTHER CONSTRUCTION ACTIVITY WITHIN FENCED AREAS.

N.T.S.

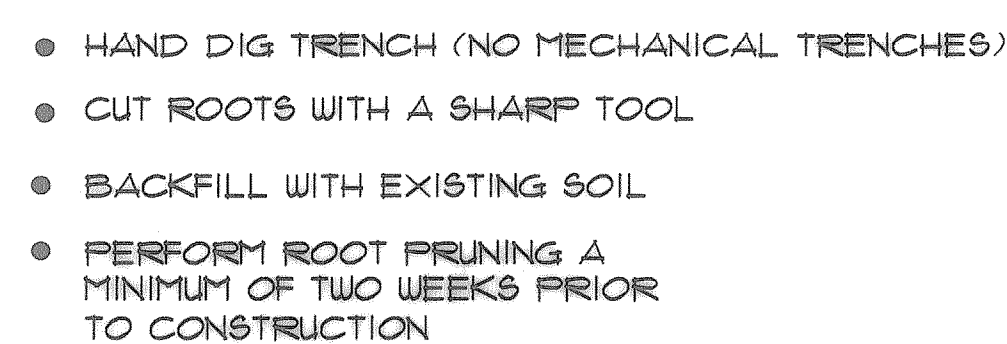

N.T.S.

TOTAL CALIPER INCHES EXIST. TREES=	5357 INCHES	
TOTAL CALIPER INCHES REMOVED =	1220 INCHES	
SPECIES TO MITIGATE AT 75% =	128 INCHES X 75%	= 96.50 INCHES
SPECIES TO MITIGATE AT 100% =	1092 INCHES X 100%	= 1152 INCHES
TOTAL GROSS CALIPER INCHES/MITIGATE		1188.50 INCHES
LESS: PRESERVATION CREDIT		(244 INCHES)
TOTAL INCHES TO MITIGATE		= 1004.50 INCHES

 EXISTING TREE TO REMOVE

(+) 127- CEDAR ELM / 3.5" CAL / 10'-12' HT = 444.5 CAL. IN.

 48 - TEXAS ASH / 3-3.5" CAL / 10'-12' HT = 168 CAL.IN.

112 - LIVE OAK /3.5" CAL / 10'-12'HT = 392 CAL. IN.
55- LIVE OAK /3." CAL / 10'-12'HT/SCREENING TREES

313- TOTAL NEW TREES FOR MITIGATION / 3"-3.5" CAL.
PROVIDING THE MINIMUM MITIGATION REQUIREMENTS


35.989 ACRES ACRES
W. BLEVINS SURVEY, ABSTRACT NO. 200

CITY OF ROCKWALL
ROCKWALL COUNTY, TEXAS

MICHAEL S. ALLEN, P.E.
DATE: _____

(IN FEET)
1 inch = 50 ft.

SHEET LP1.4 OF LP1.4

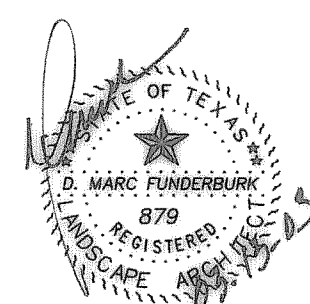

Landscape Architecture
Landscape Construction

OFFICE/Dallas: 3624 Oak Lawn Ave. 9320 / Dallas, TX 75219
T (214) 219 - 3993 F (214) 219 - 7005
MAIL: P.O.Box 172650 / Arlington, TX / 76003-2650
EMAIL: mail@handpatterns.com

DATE:	2/17/2003
SCALE:	1"= 50'
CALC. BY:	D.M.F.
DRAWN BY:	D.M.F.
CHK. BY:	
JOB NO.:	02-LAJOLLA POINTE