
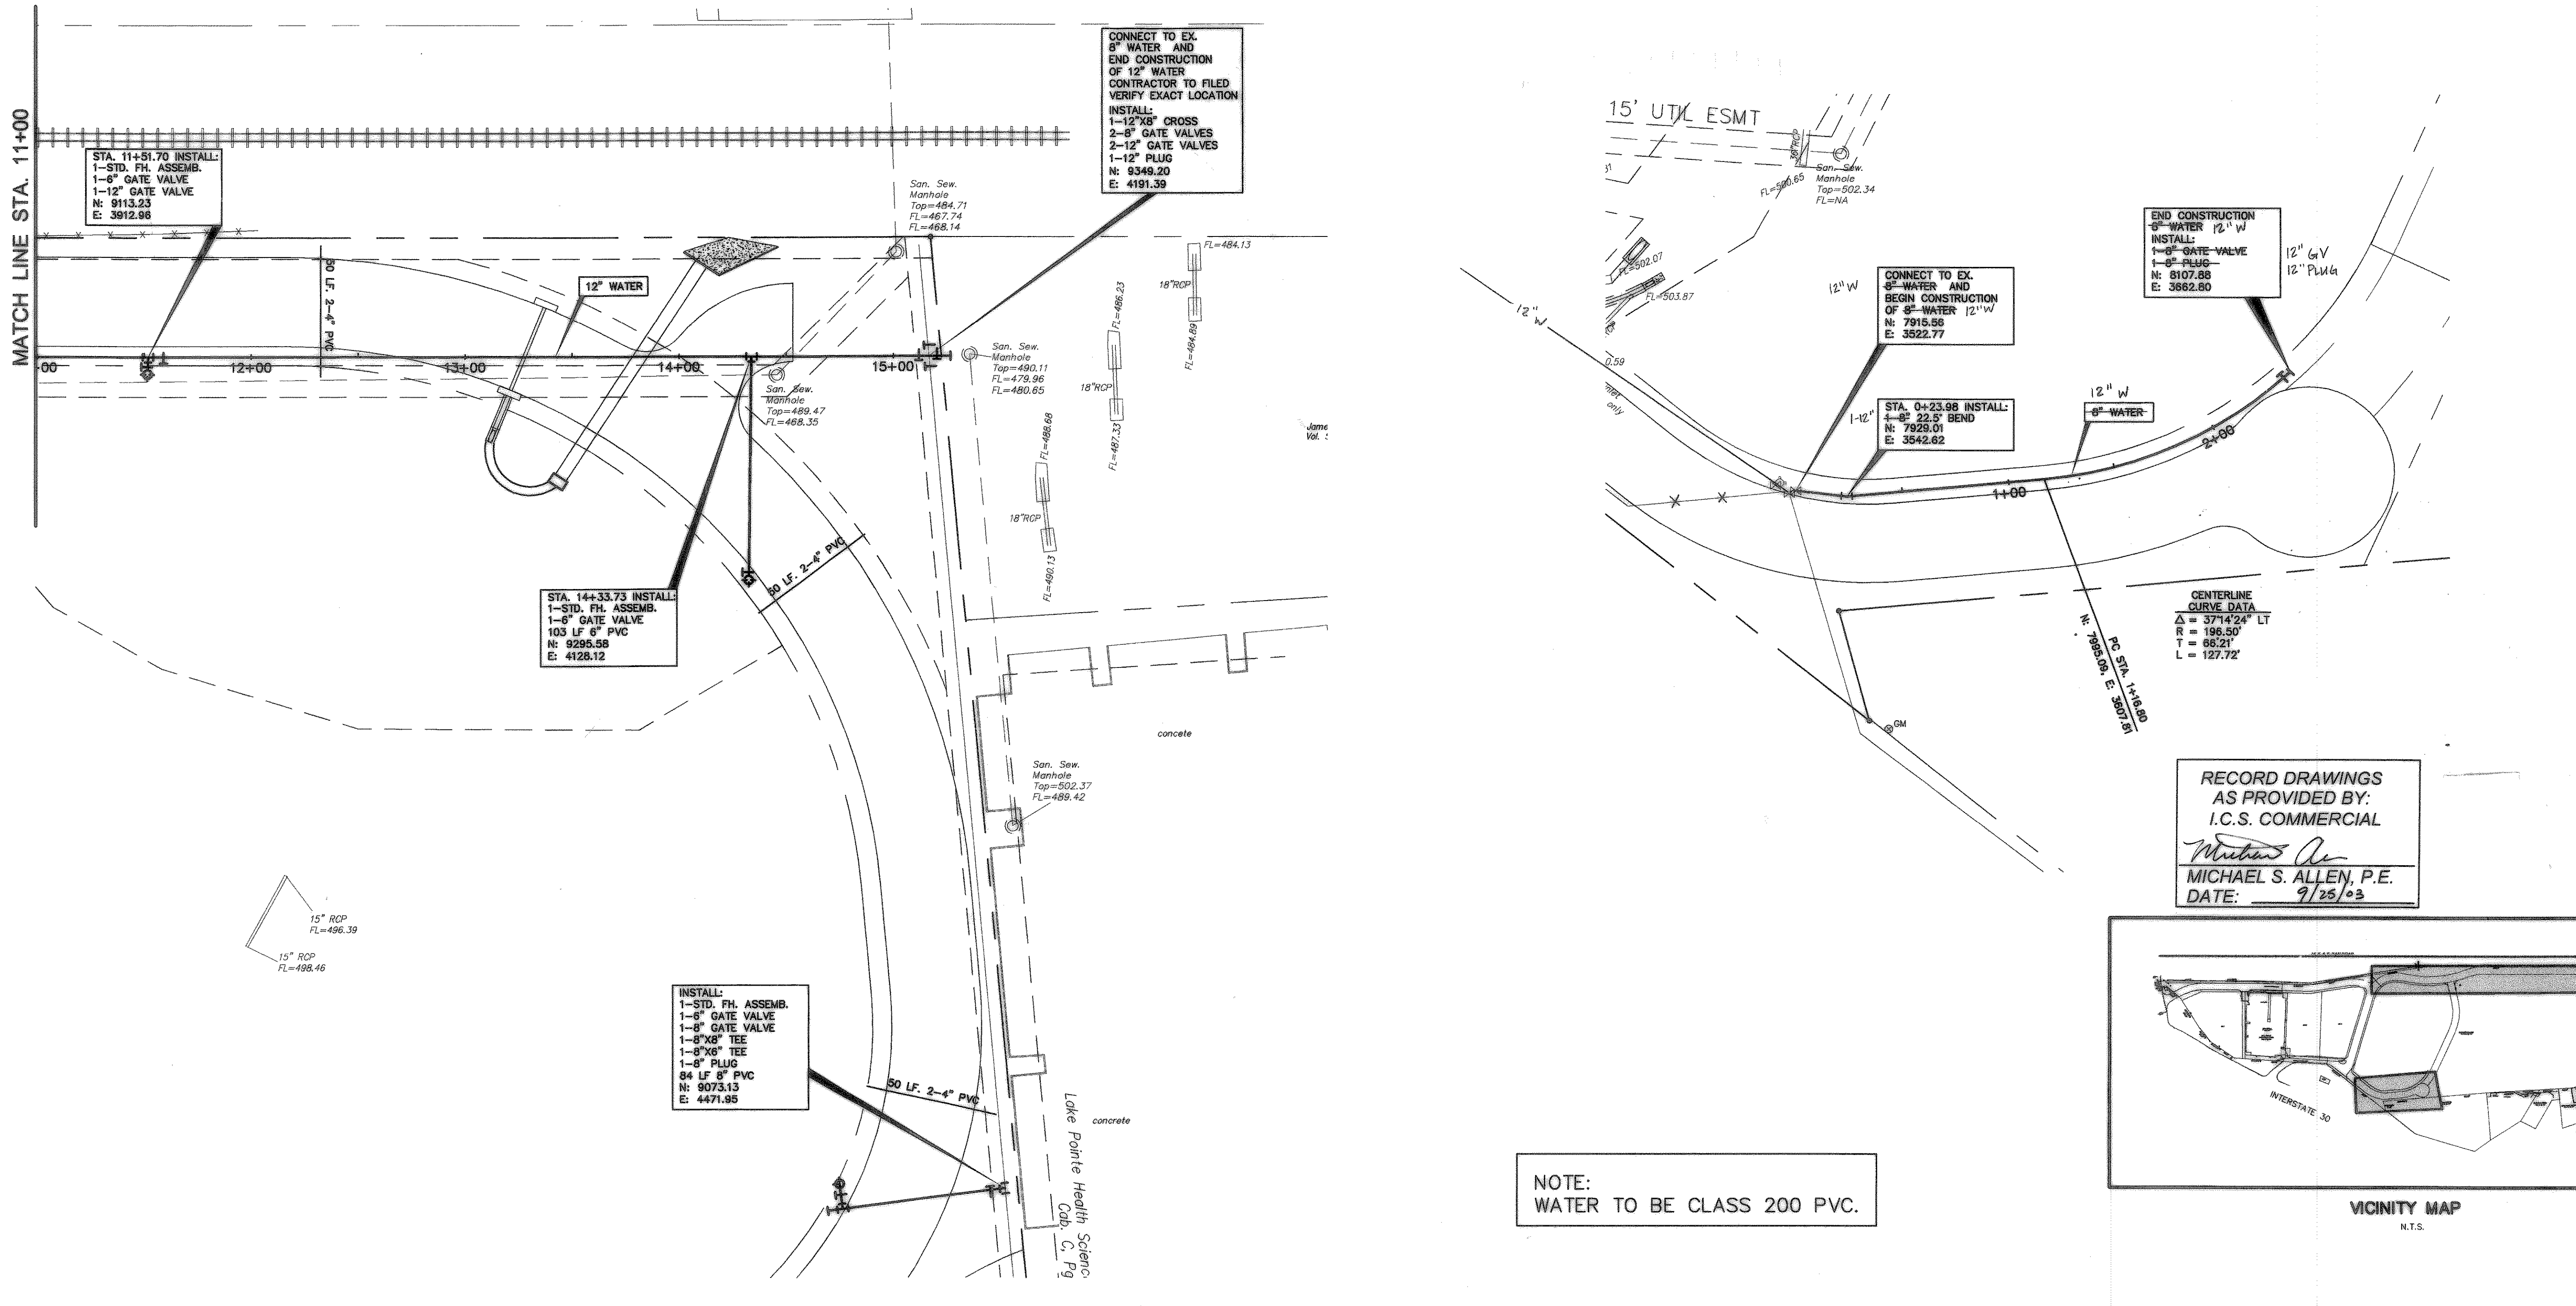


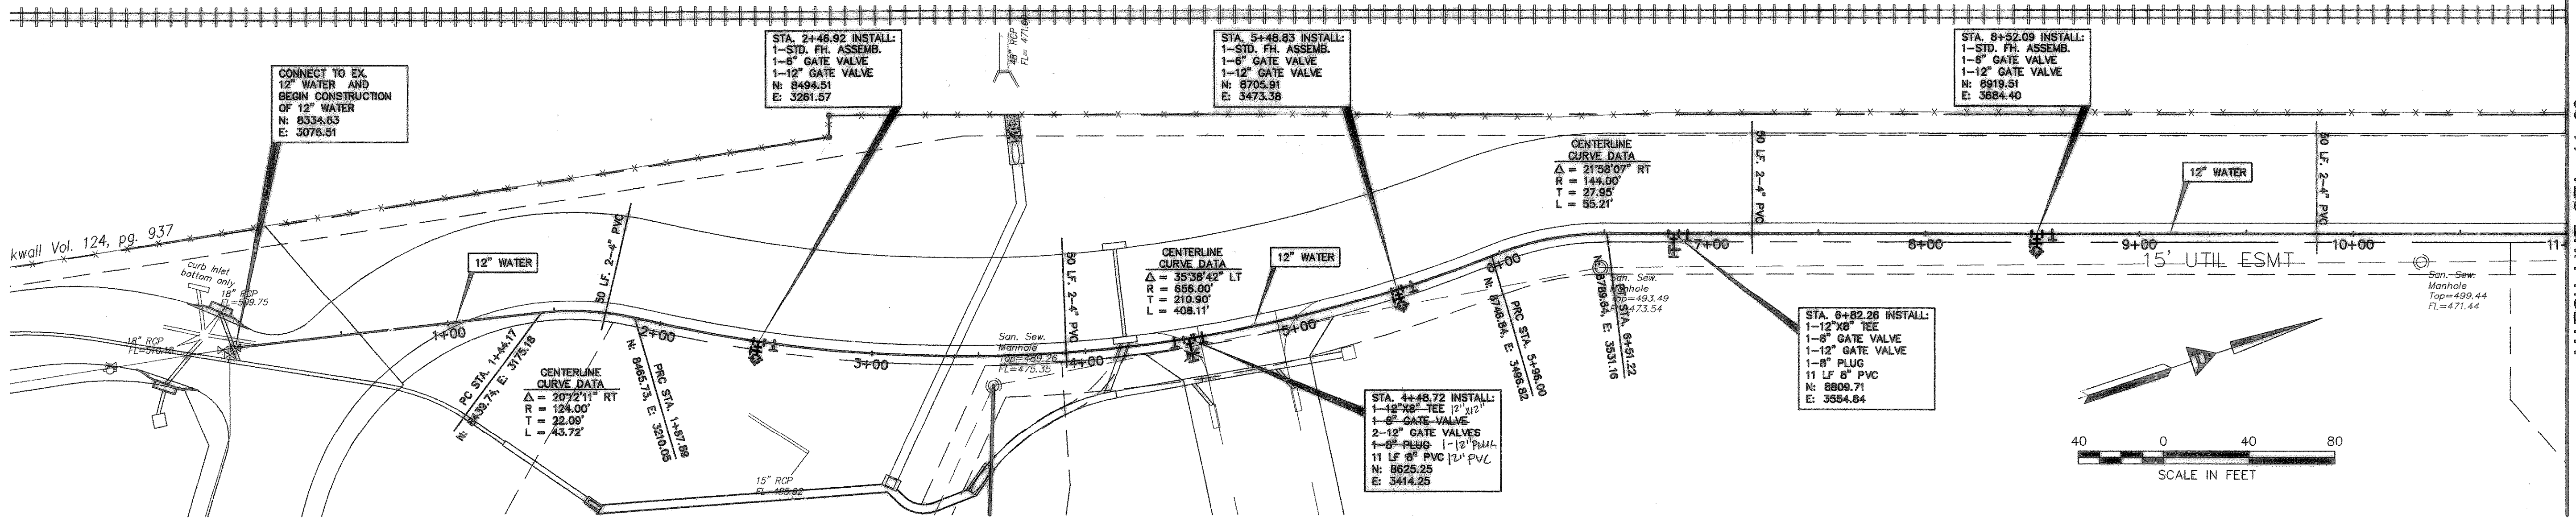

App.	
Revisions	
Date	
No.	

Allen & Ridinger Consulting, Inc.
109 W. Main Street
Lawville, Texas 75957
Tel. No. (972) 353-8000
Fax No. (972) 353-8011

Michael S. Allen
3/14/03

La Jolla Pointe Addition
ROCKWALL, TEXAS

UTILITY PLAN

Scale: 1"=40'
Designed by: MSA
Drawn by: MSA
Checked by: MSA
Date: March 14, 2003
Project No. 018-001

SHEET
C-13
OF 25