

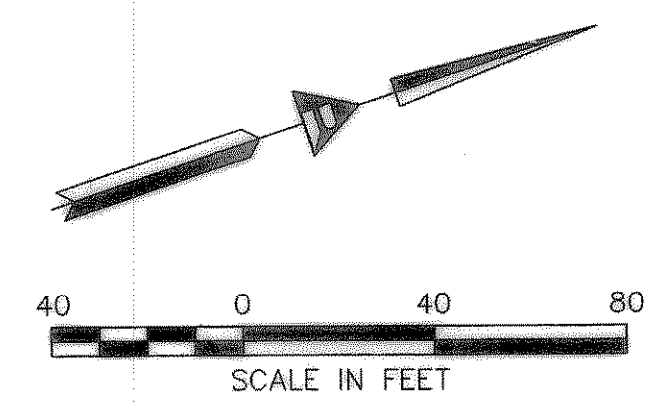
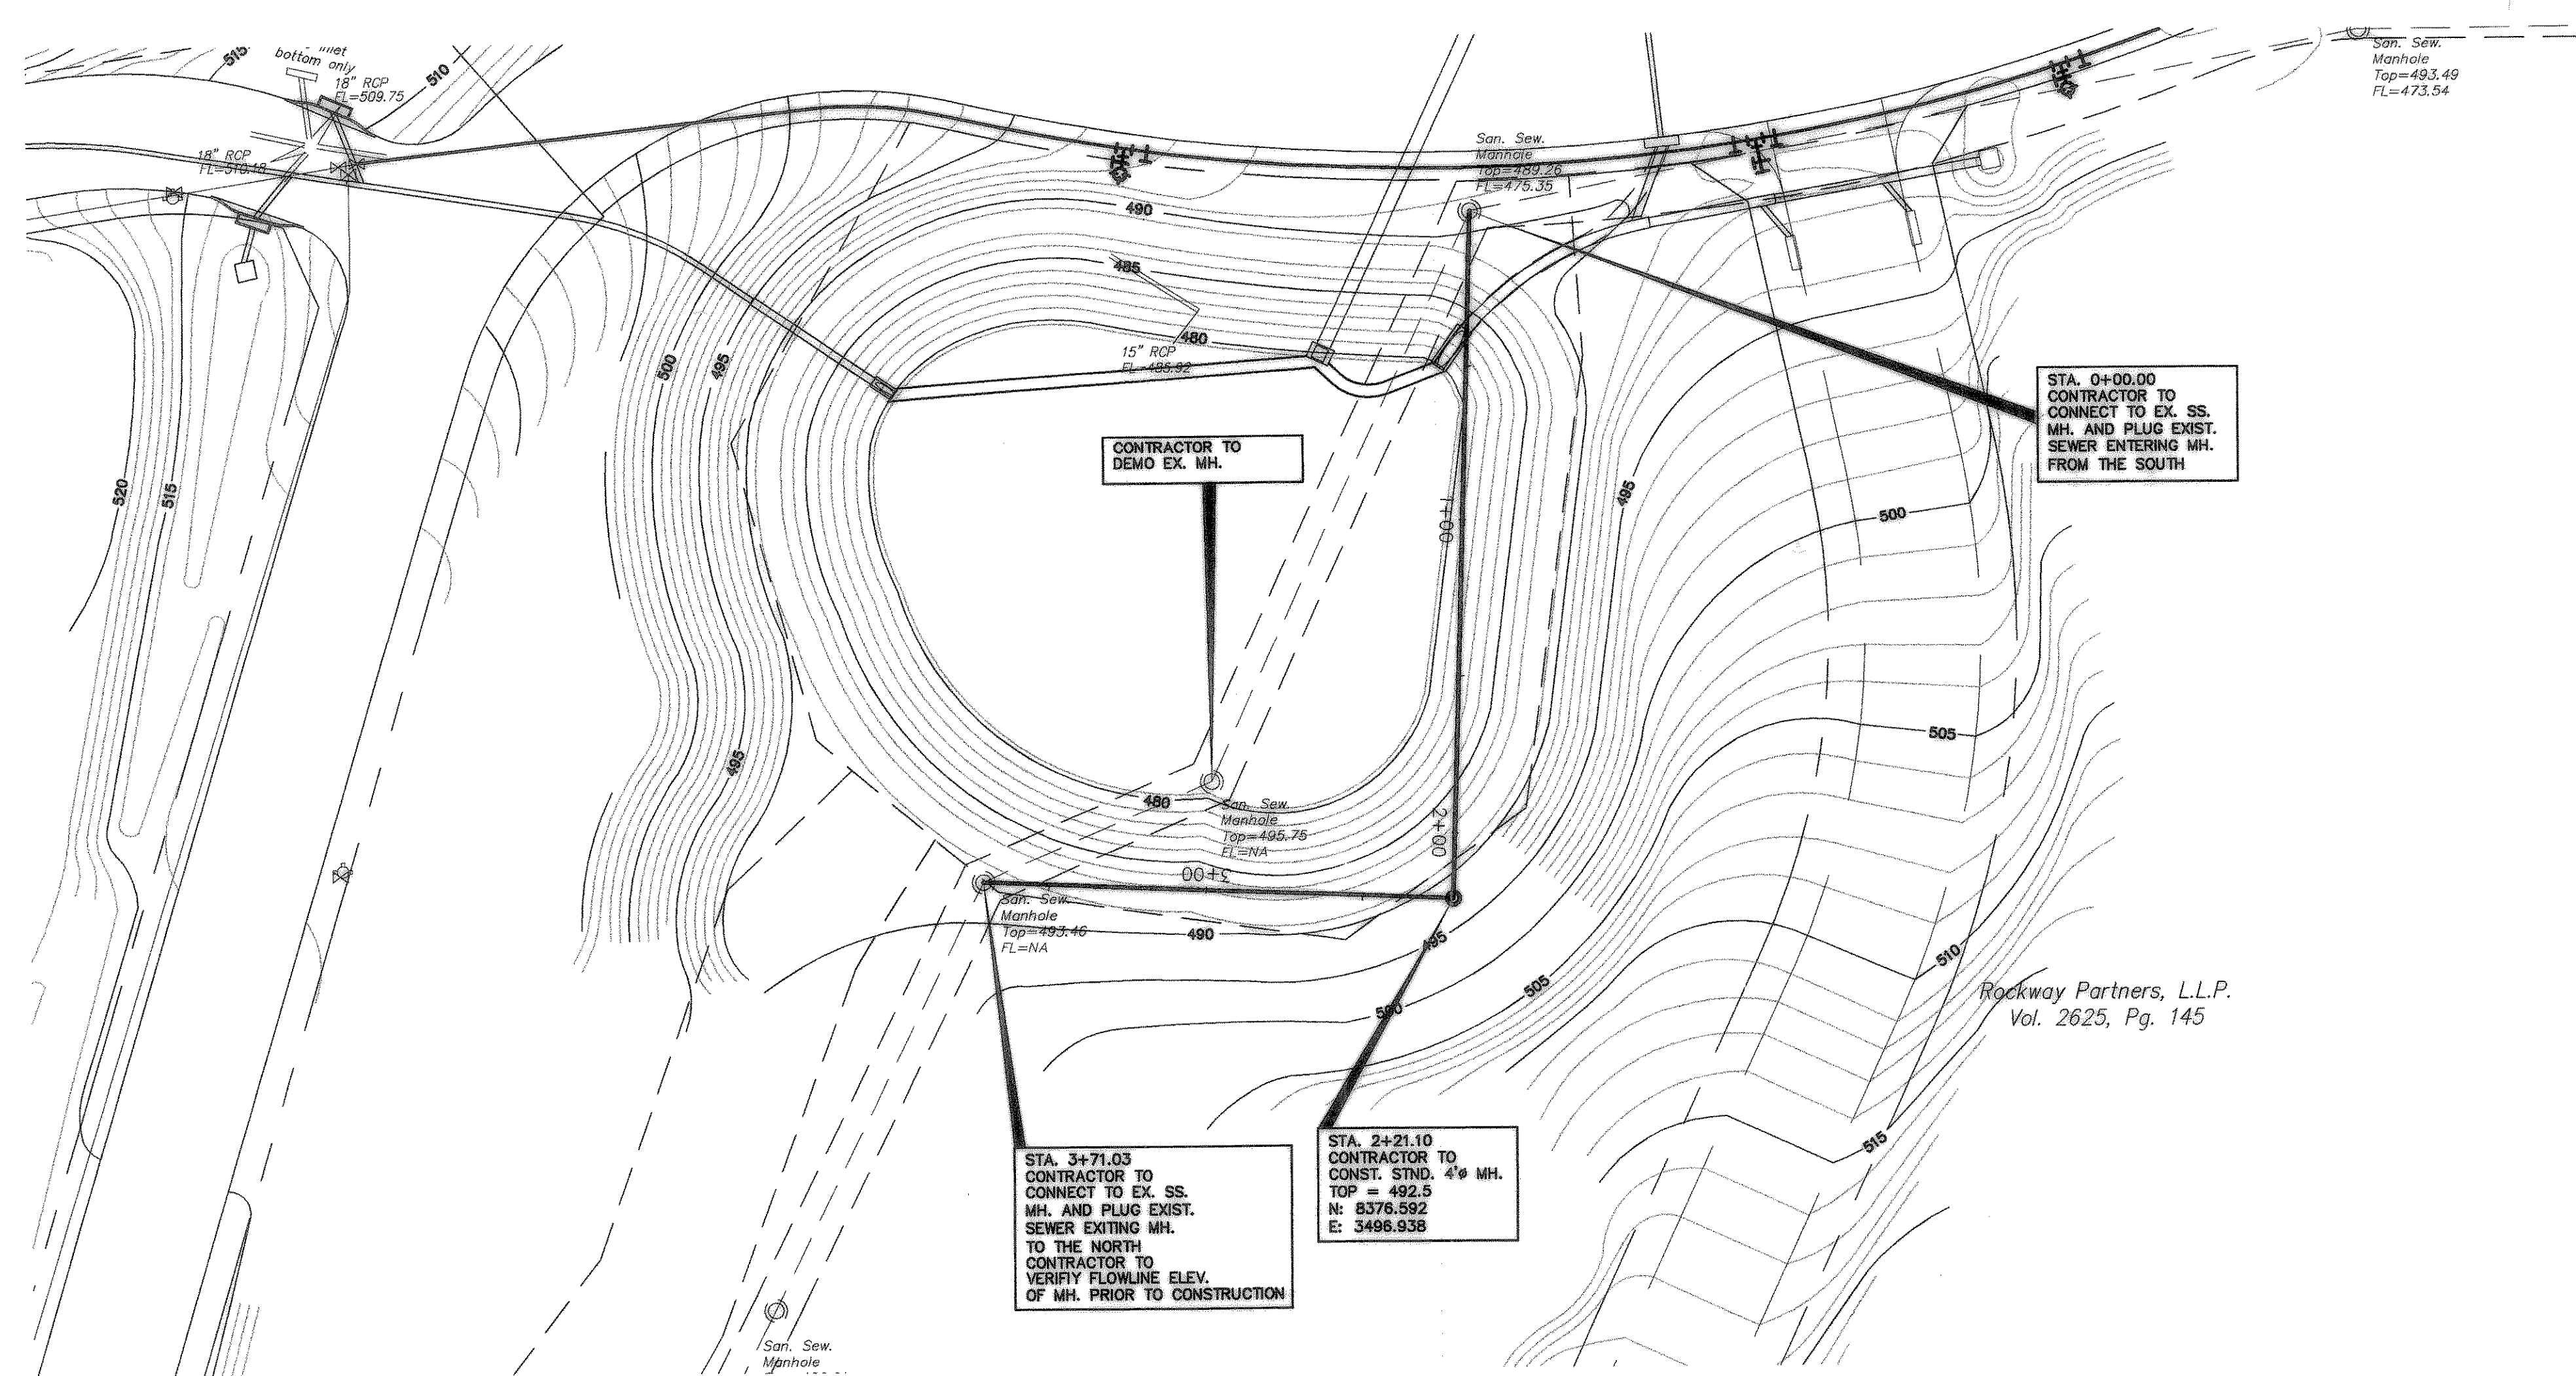


\\dallas\proj\proj\016001 - Rockwall\016001.dwg, 3/14/2003 8:02:27 AM, 140

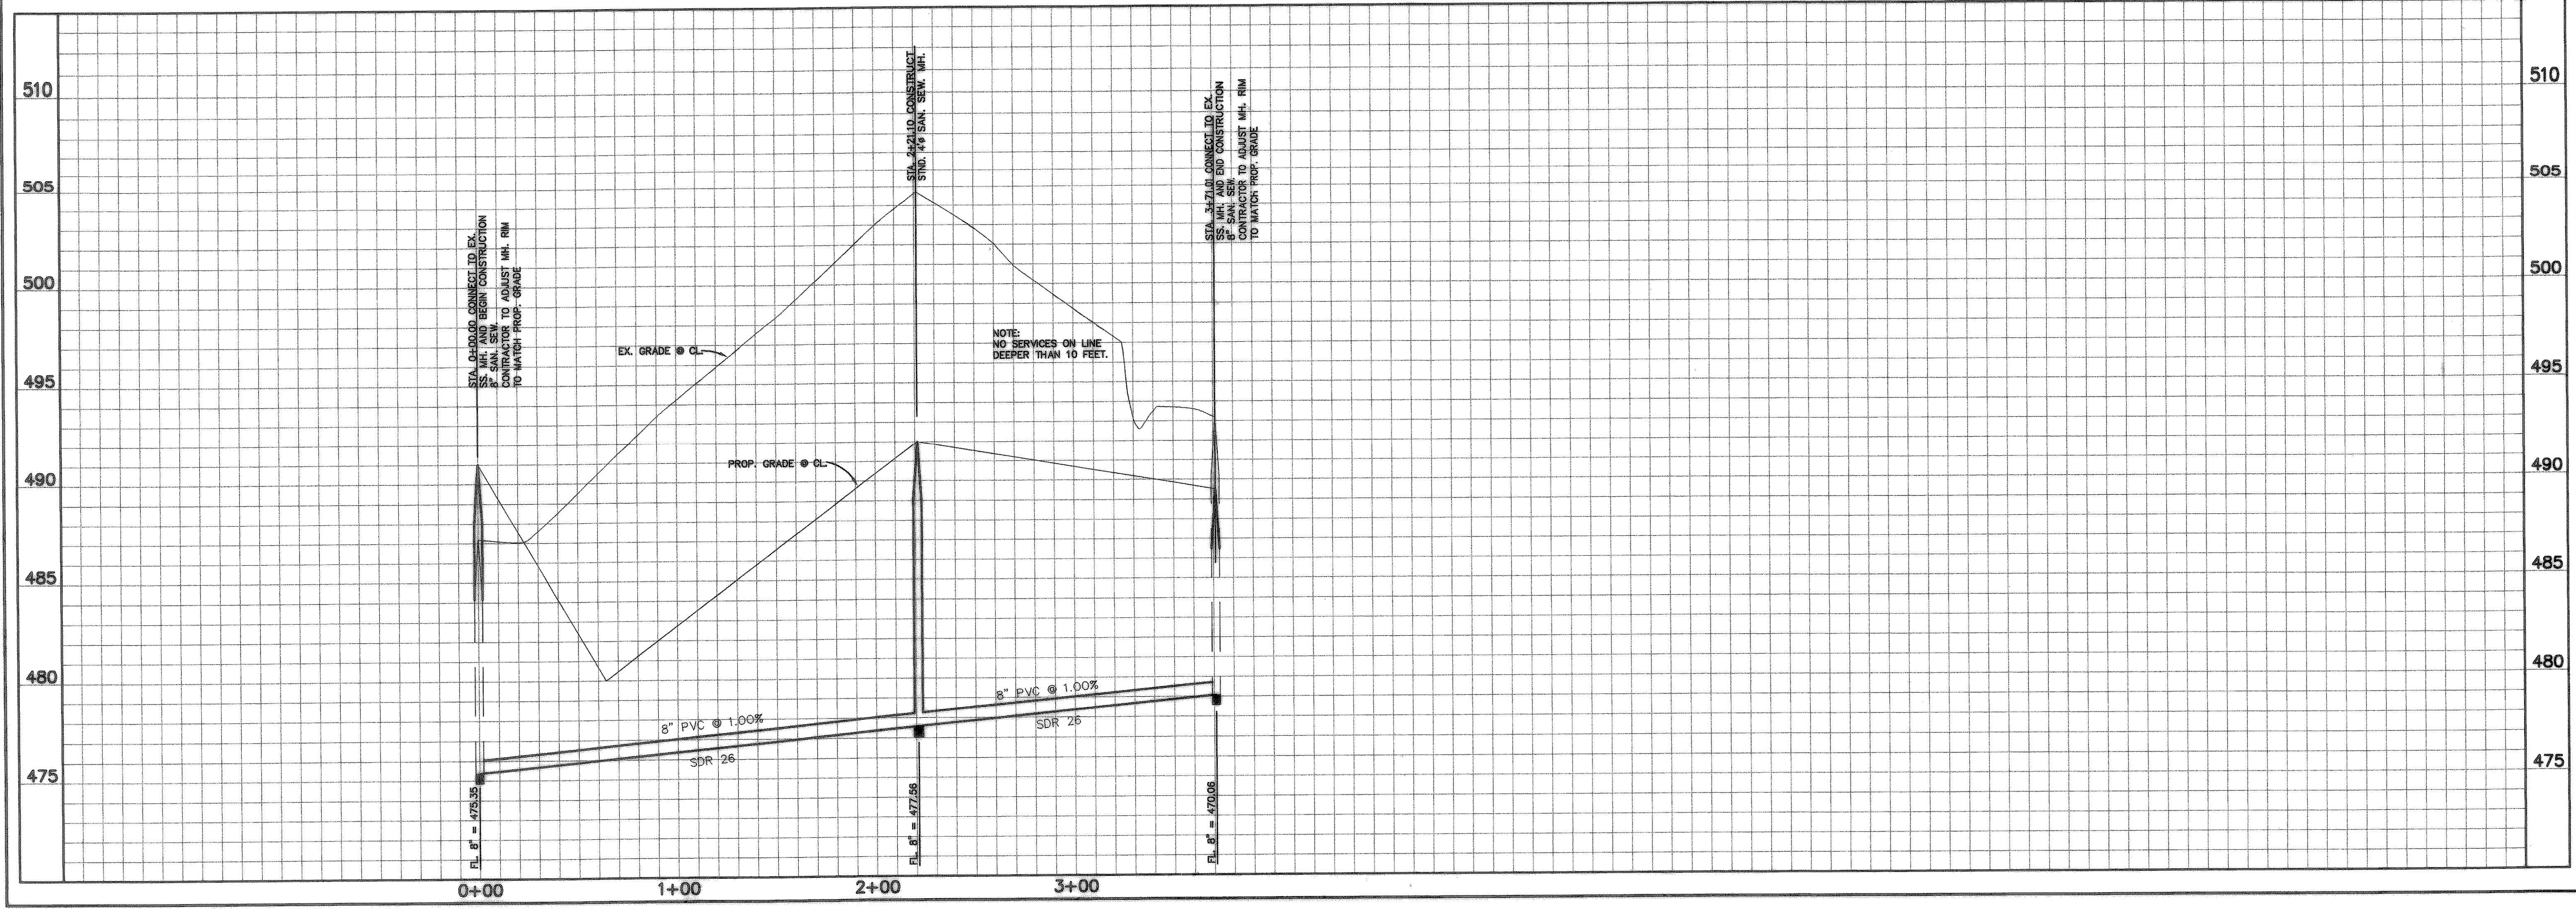

RECORD DRAWINGS
AS PROVIDED BY:
I.C.S. COMMERCIAL
Michael S. Allen
MICHAEL S. ALLEN, P.E.
DATE: 7/25/03

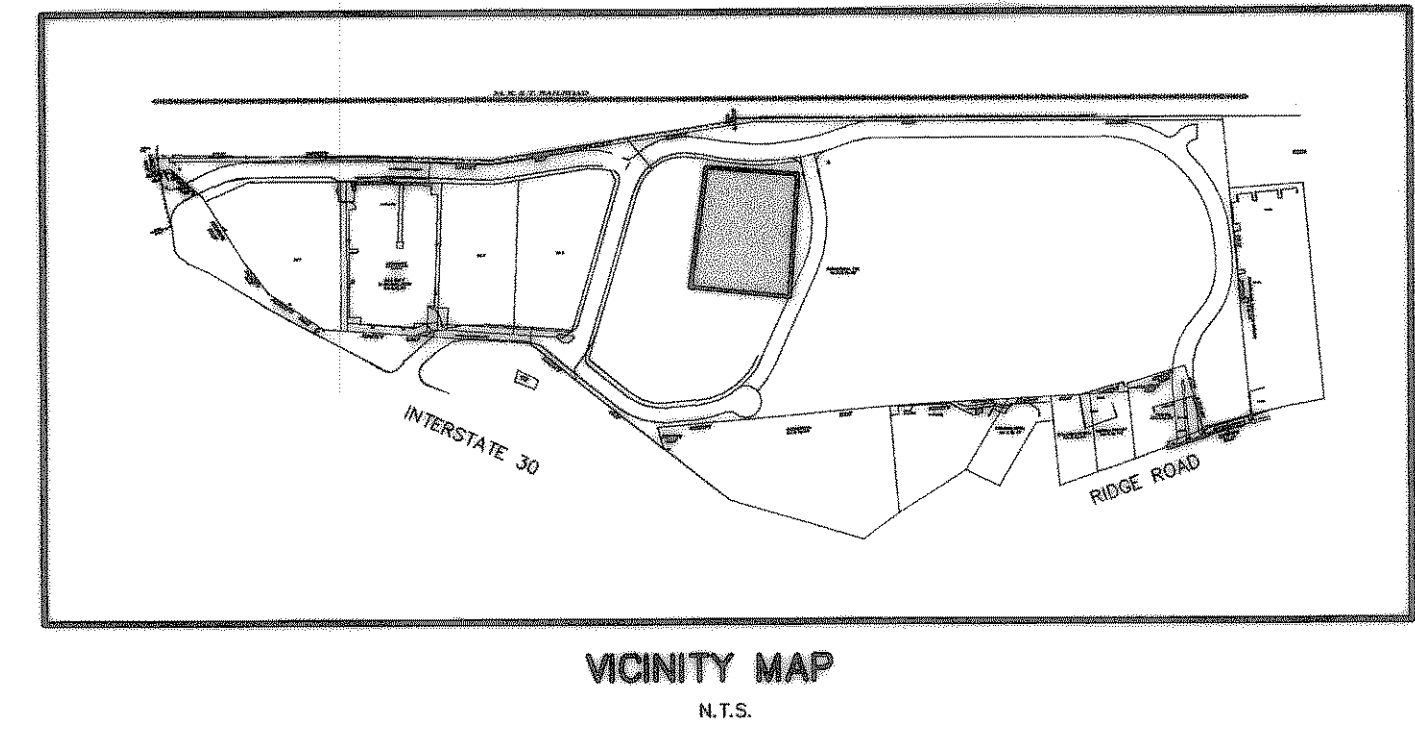

No.	Date	Revisions	App.

Allen & Ridinger Consulting, Inc.
109 W. Main Street
Lewisville, Texas 75057
Tel. No. (972) 353-8000
Fax No. (972) 353-8011

STATE OF TEXAS
MICHAEL S. ALLEN
66186
LICENSED PROFESSIONAL ENGINEER
Michael S. Allen
3/14/03

La Jolla Pointe Addition
ROCKWALL, TEXAS

SANITARY SEWER RELOCATION

Scale: 1"=40'
Designed by: MSA
Drawn by: MSA
Checked by: MSA
Date: March 14, 2003
Project No. 018-001

SHEET
C-14
OF 25