

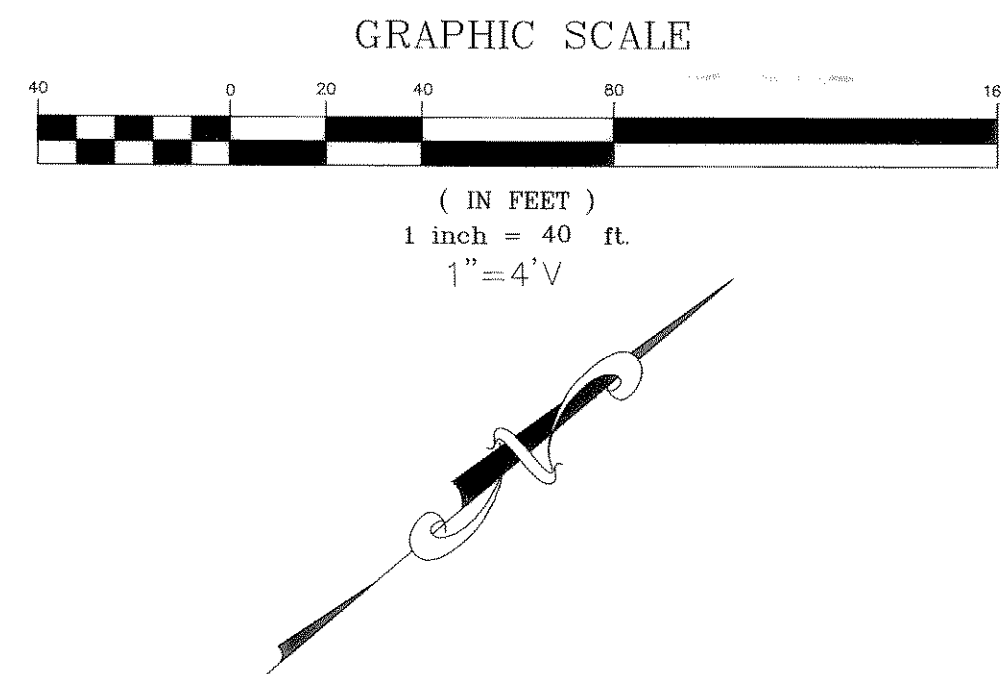


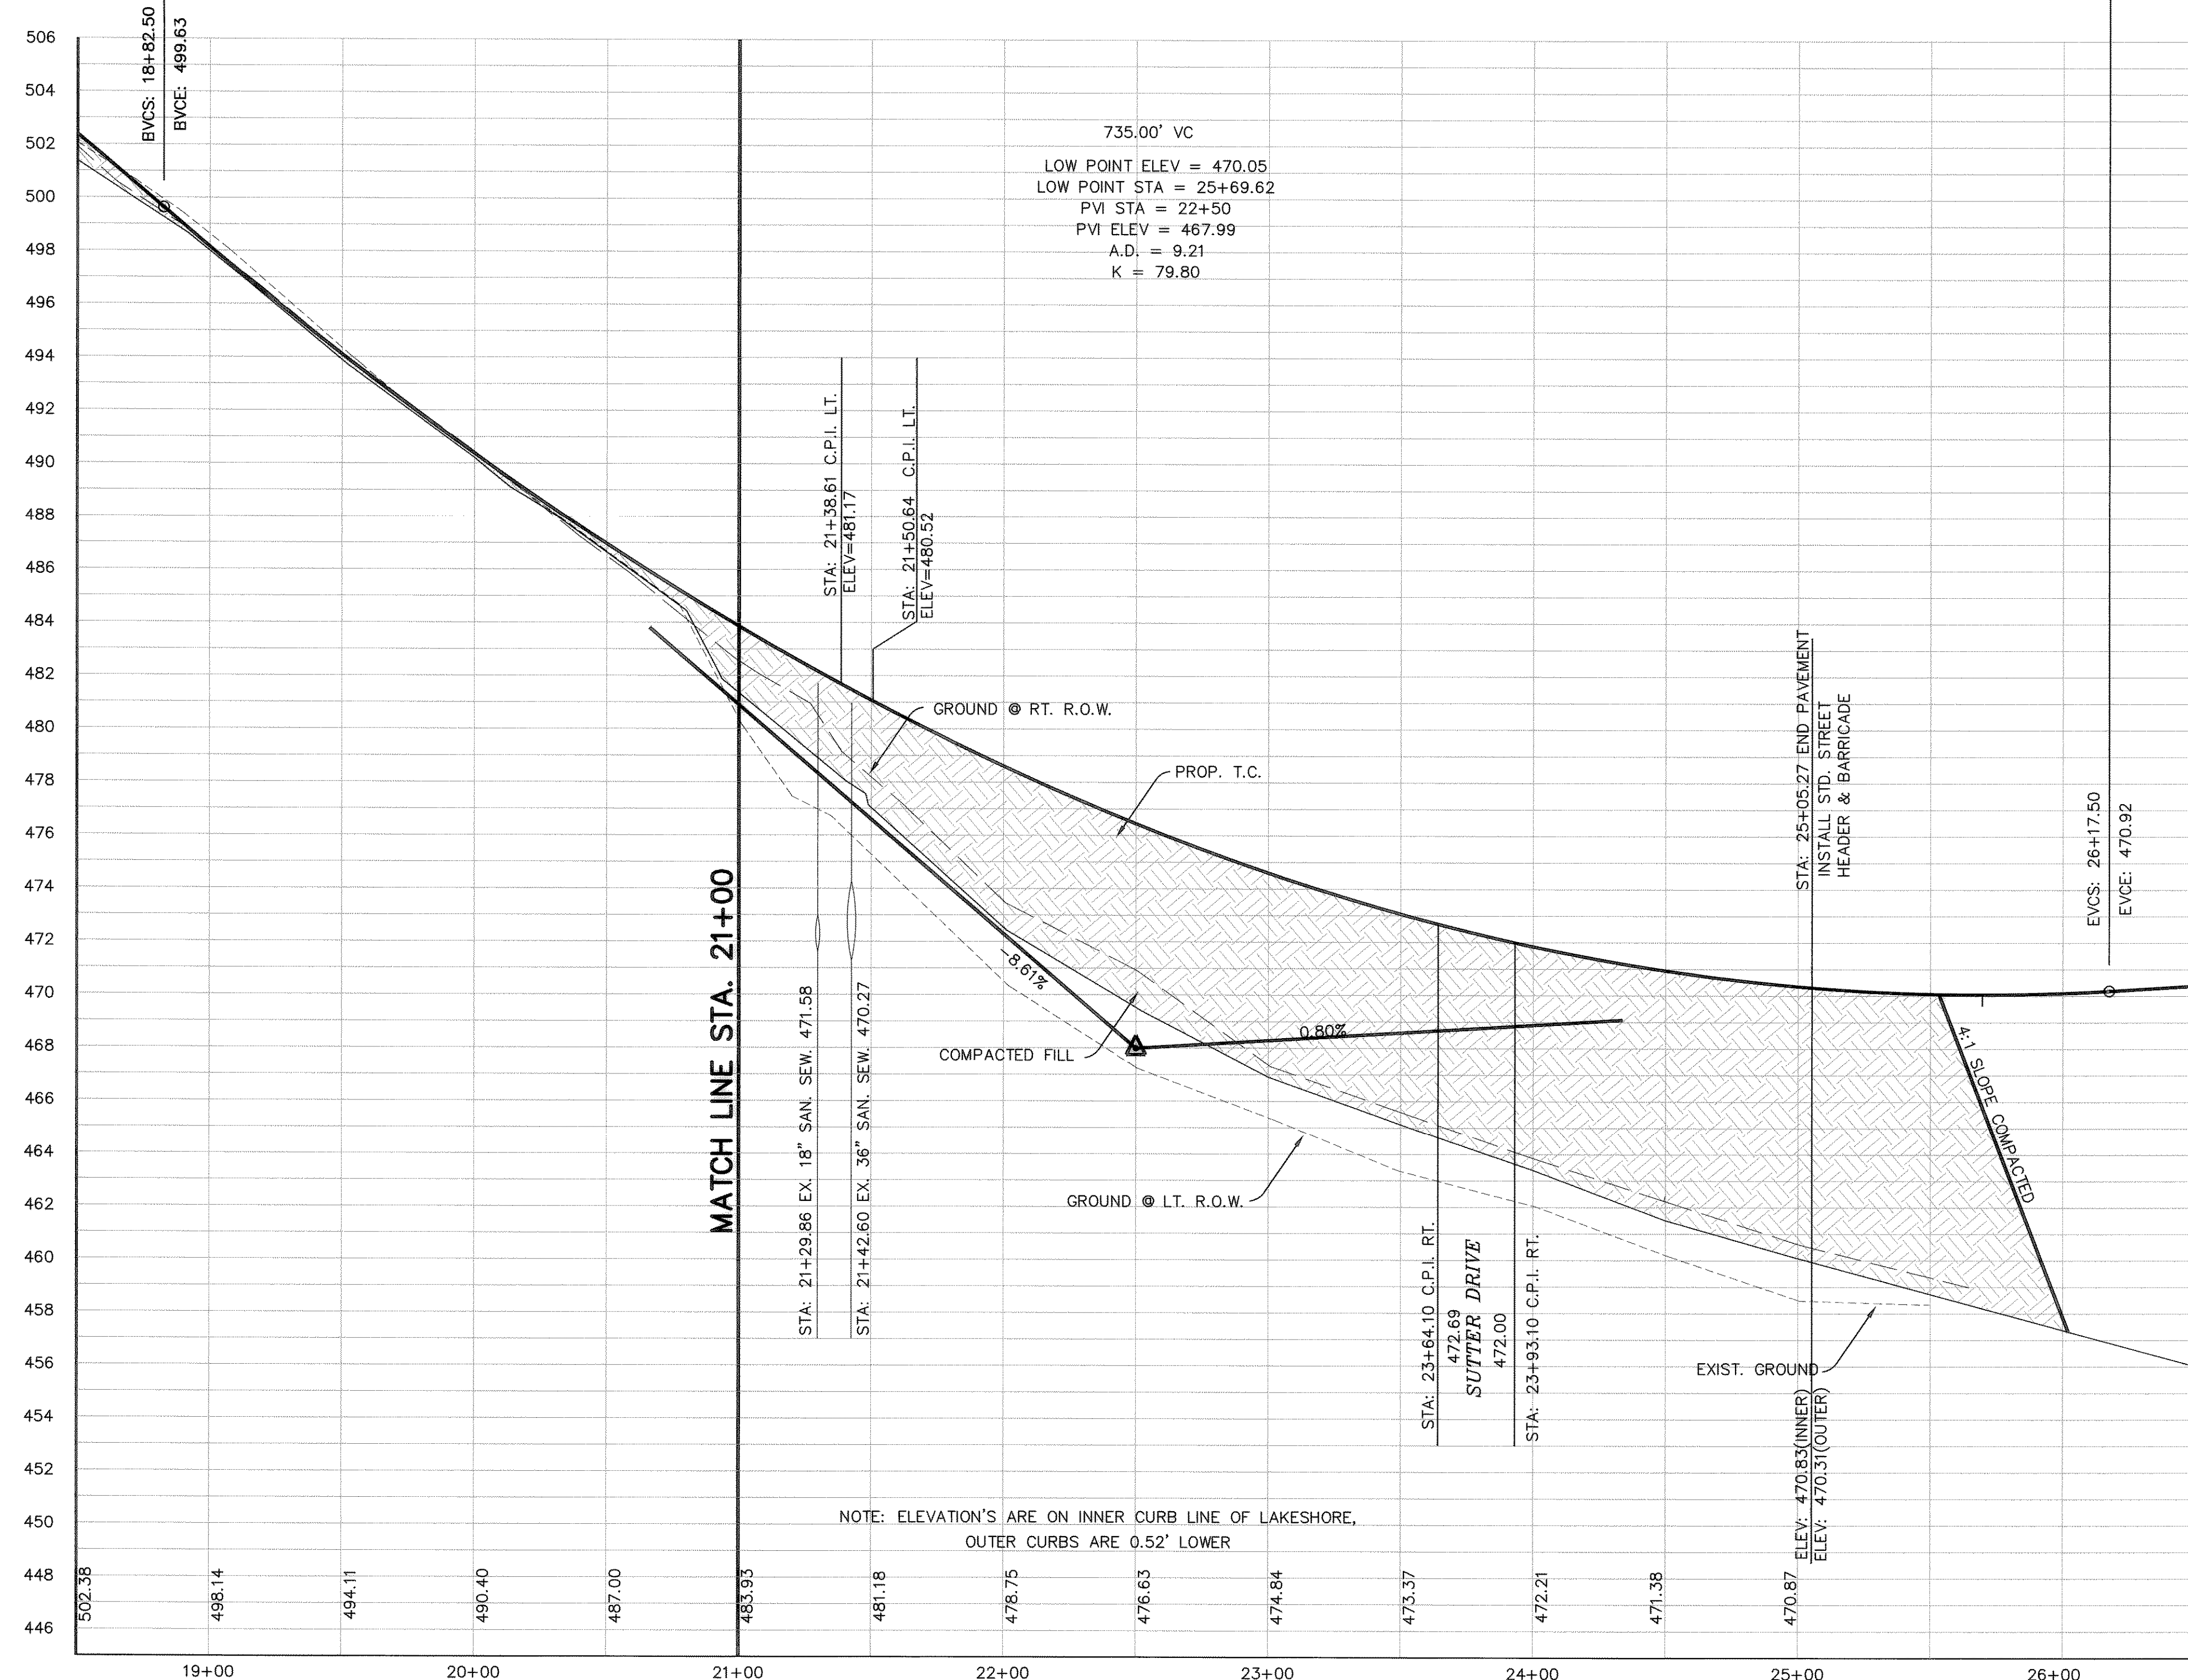


FUTURE DEVELOPMENT
LAKEVIEW SUMMIT PHASE 4

SEE DETAIL
THIS SHEET

NOTE: ELEVATION'S ARE ON INNER CURB LINE OF LAKESHORE,
OUTER CURBS ARE 0.52' LOWER

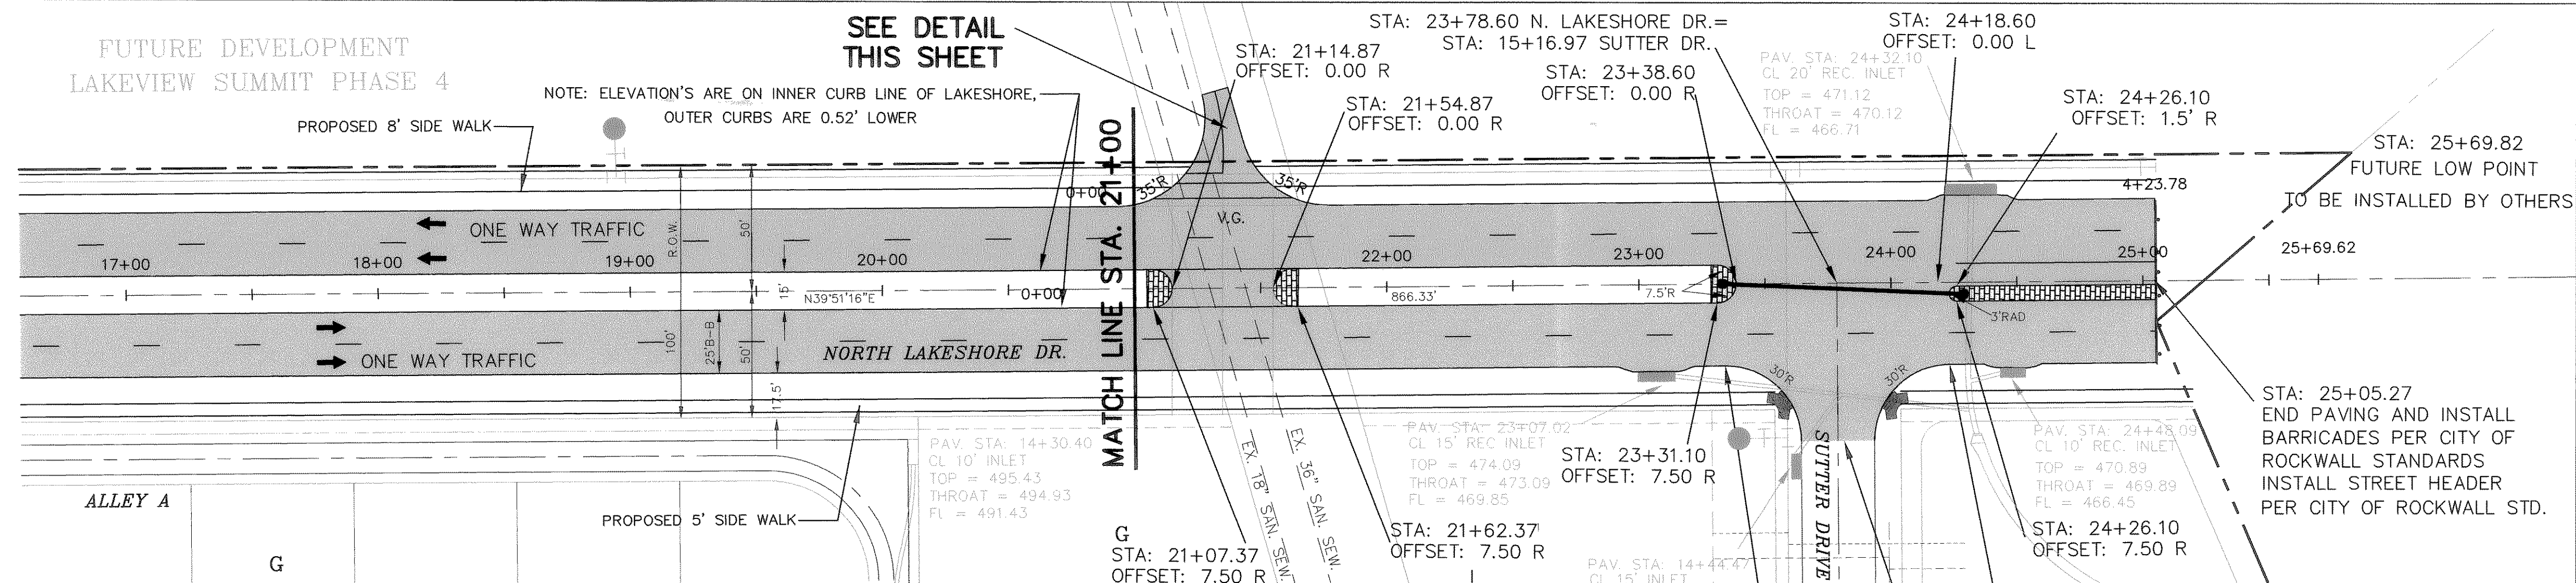

DETAIL
ROAD TO SEWER TREATMENT PLANT

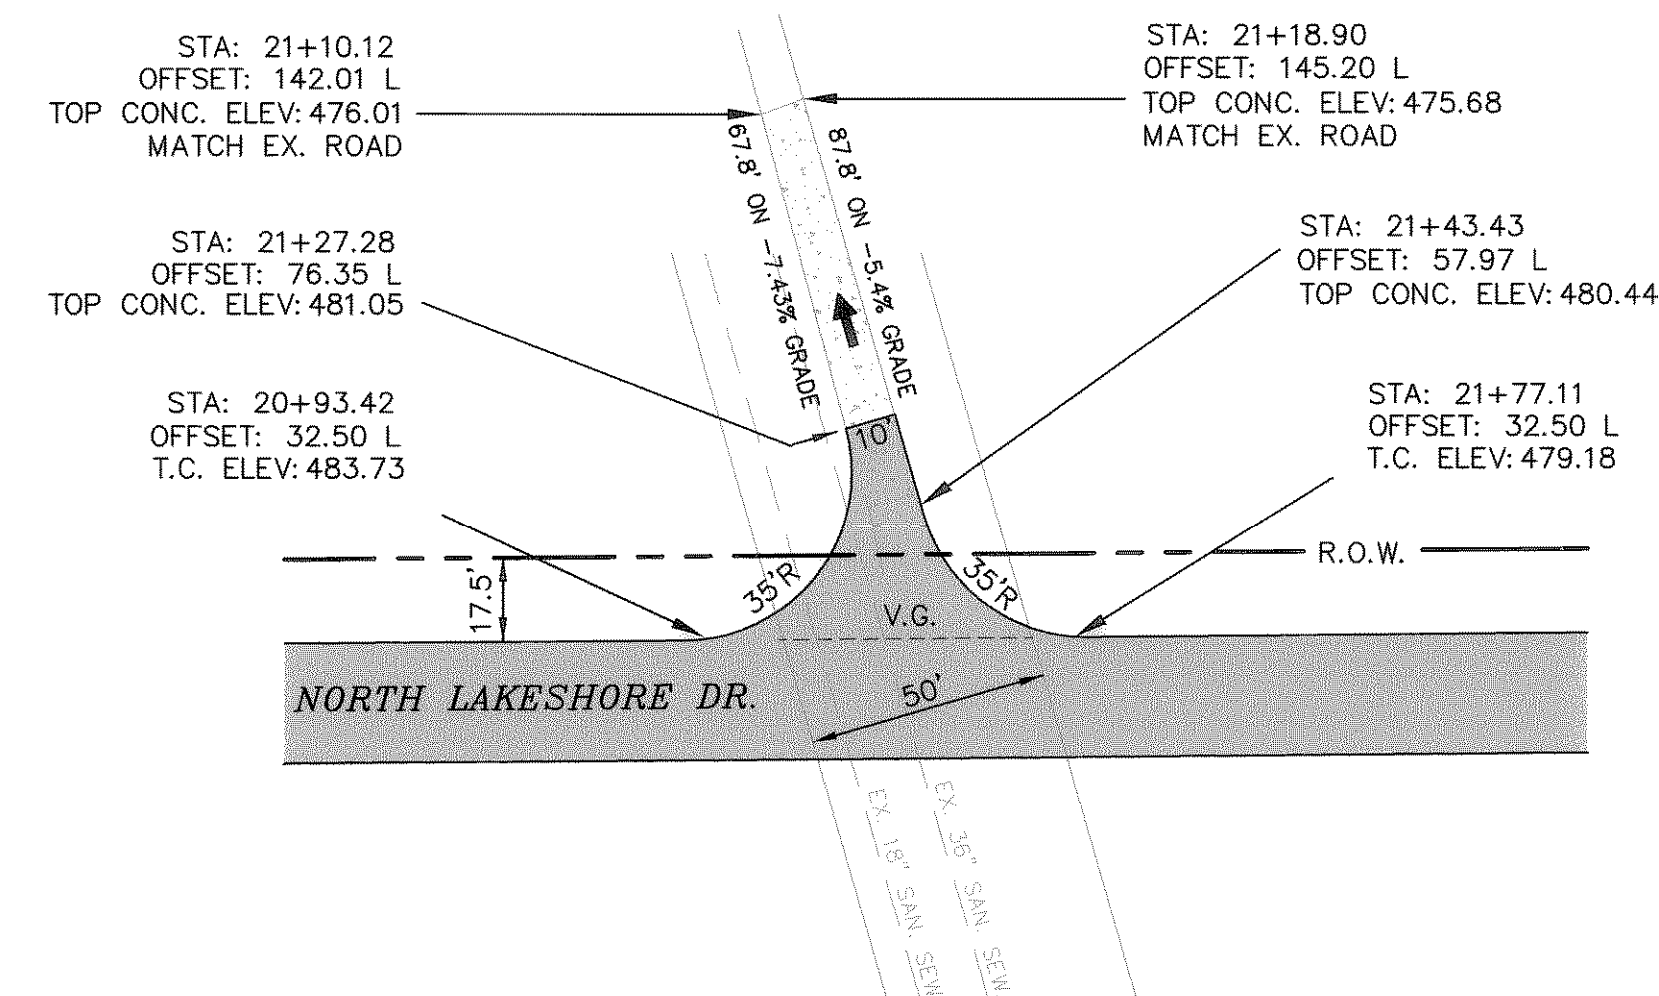

- NOTES:
1. SIDEWALK NOTE: PER BRAD GRIGGS WITH THE CITY OF ROCKWALL, AN EIGHT FOOT (8') SIDEWALK SHALL BE INSTALLED ALONG THE NORTH SIDE OF NORTH LAKESHORE DRIVE DURING THE CONSTRUCTION OF THE WESTBOUND LANE OF THAT DIVIDED ROADWAY.
 2. MEDIAN PAVERS SHALL BE CITY'S CHOSEN.
 3. INSTALL STREET LIGHT CONDUITS AND IRRIGATION SLEEVES AT ACROSS ROAD AND MEDIAN OPENINGS. THESE SHALL BE 4" SCH 40.
 4. SEE SHEET 9A FOR PAVEMENT MARKING DETAILS.

THE SEAL APPEARING ON THIS DOCUMENT WAS AUTHORIZED BY W.L. DOUPHRE II TEXAS P.E. NO. 60102 ON 1/1/00

DOUPHRE & ASSOCIATES, INC.
ENGINEERING - PROJECT MANAGEMENT - SURVEYING
2235 RIDGE RD., # 200 ROCKWALL, TEXAS 75087
PHONE: (972)771-9004 FAX: (972)771-9005

PAVING PLAN & PROFILE
N. LAKESHORE DRIVE STA: 21+00 TO 24+58
LAKEVIEW SUMMIT, PHASE 3
CITY OF ROCKWALL, ROCKWALL COUNTY, TEXAS

REVISION
W.L.D.
CHECKED
KEB.
DRAWN
10/02
DATE
9919-3PVI-A
PROJECT

REVISED TO CONFORM TO CONSTRUCTION RECORDS.
DATE: 1/1/04

9
OF
33