

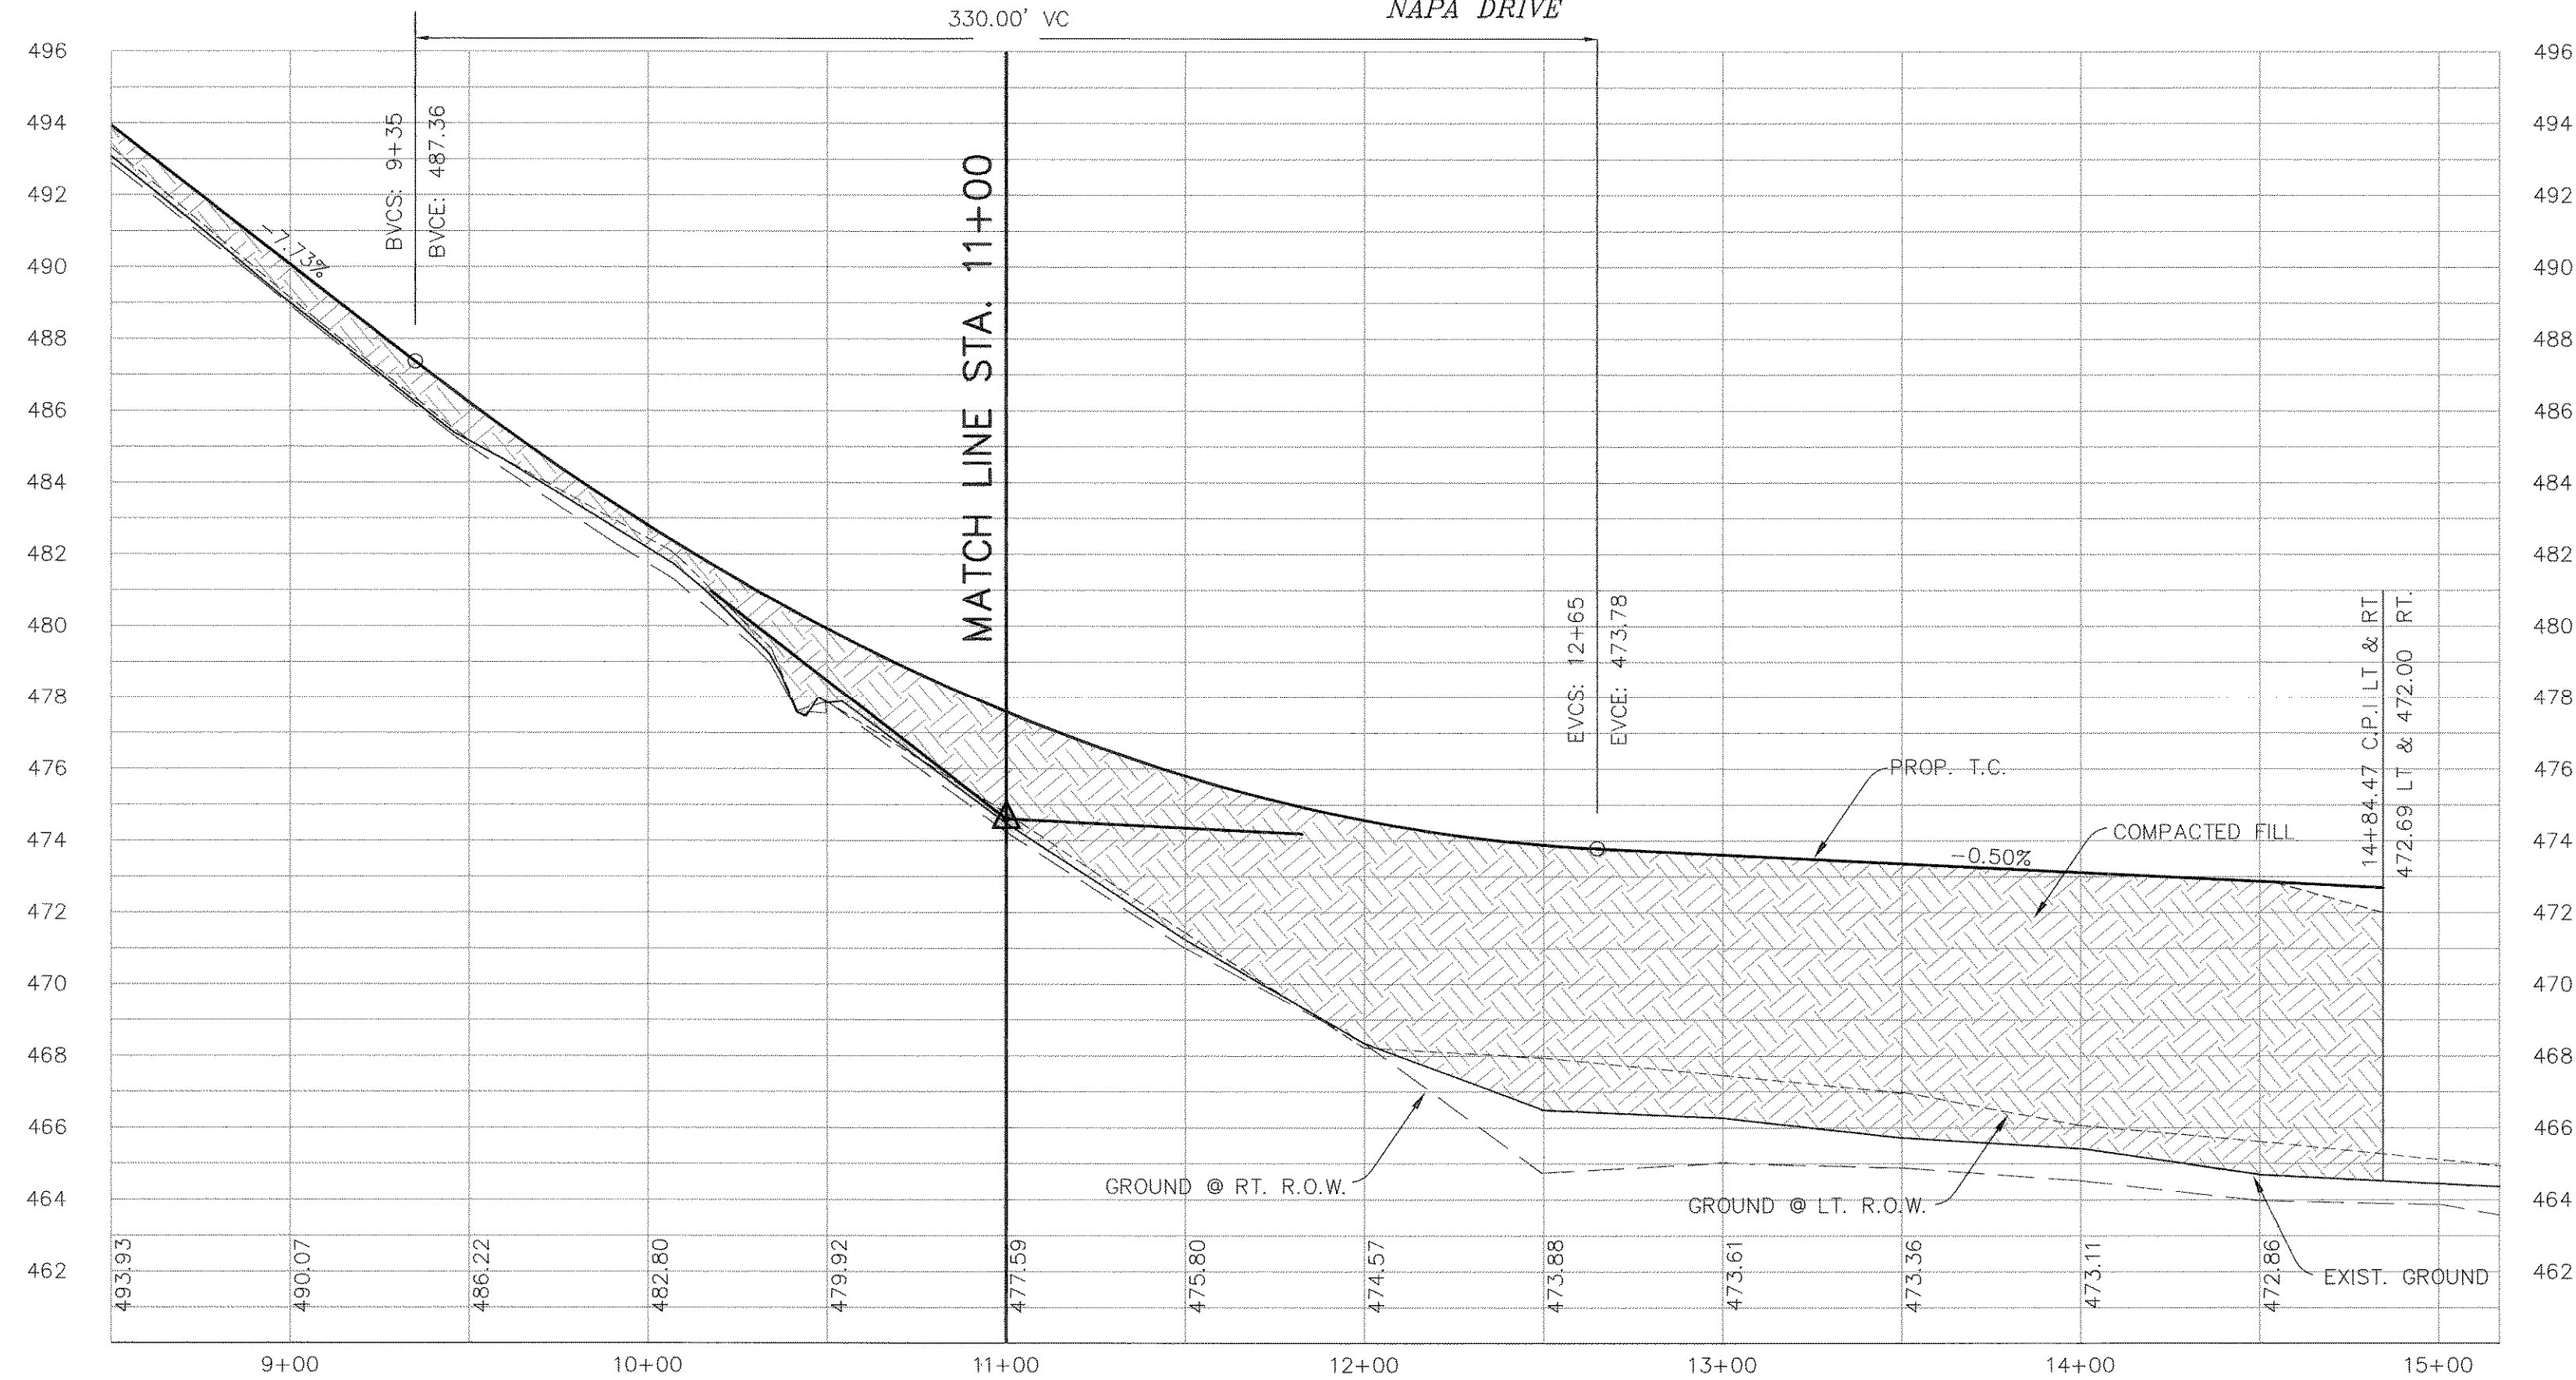


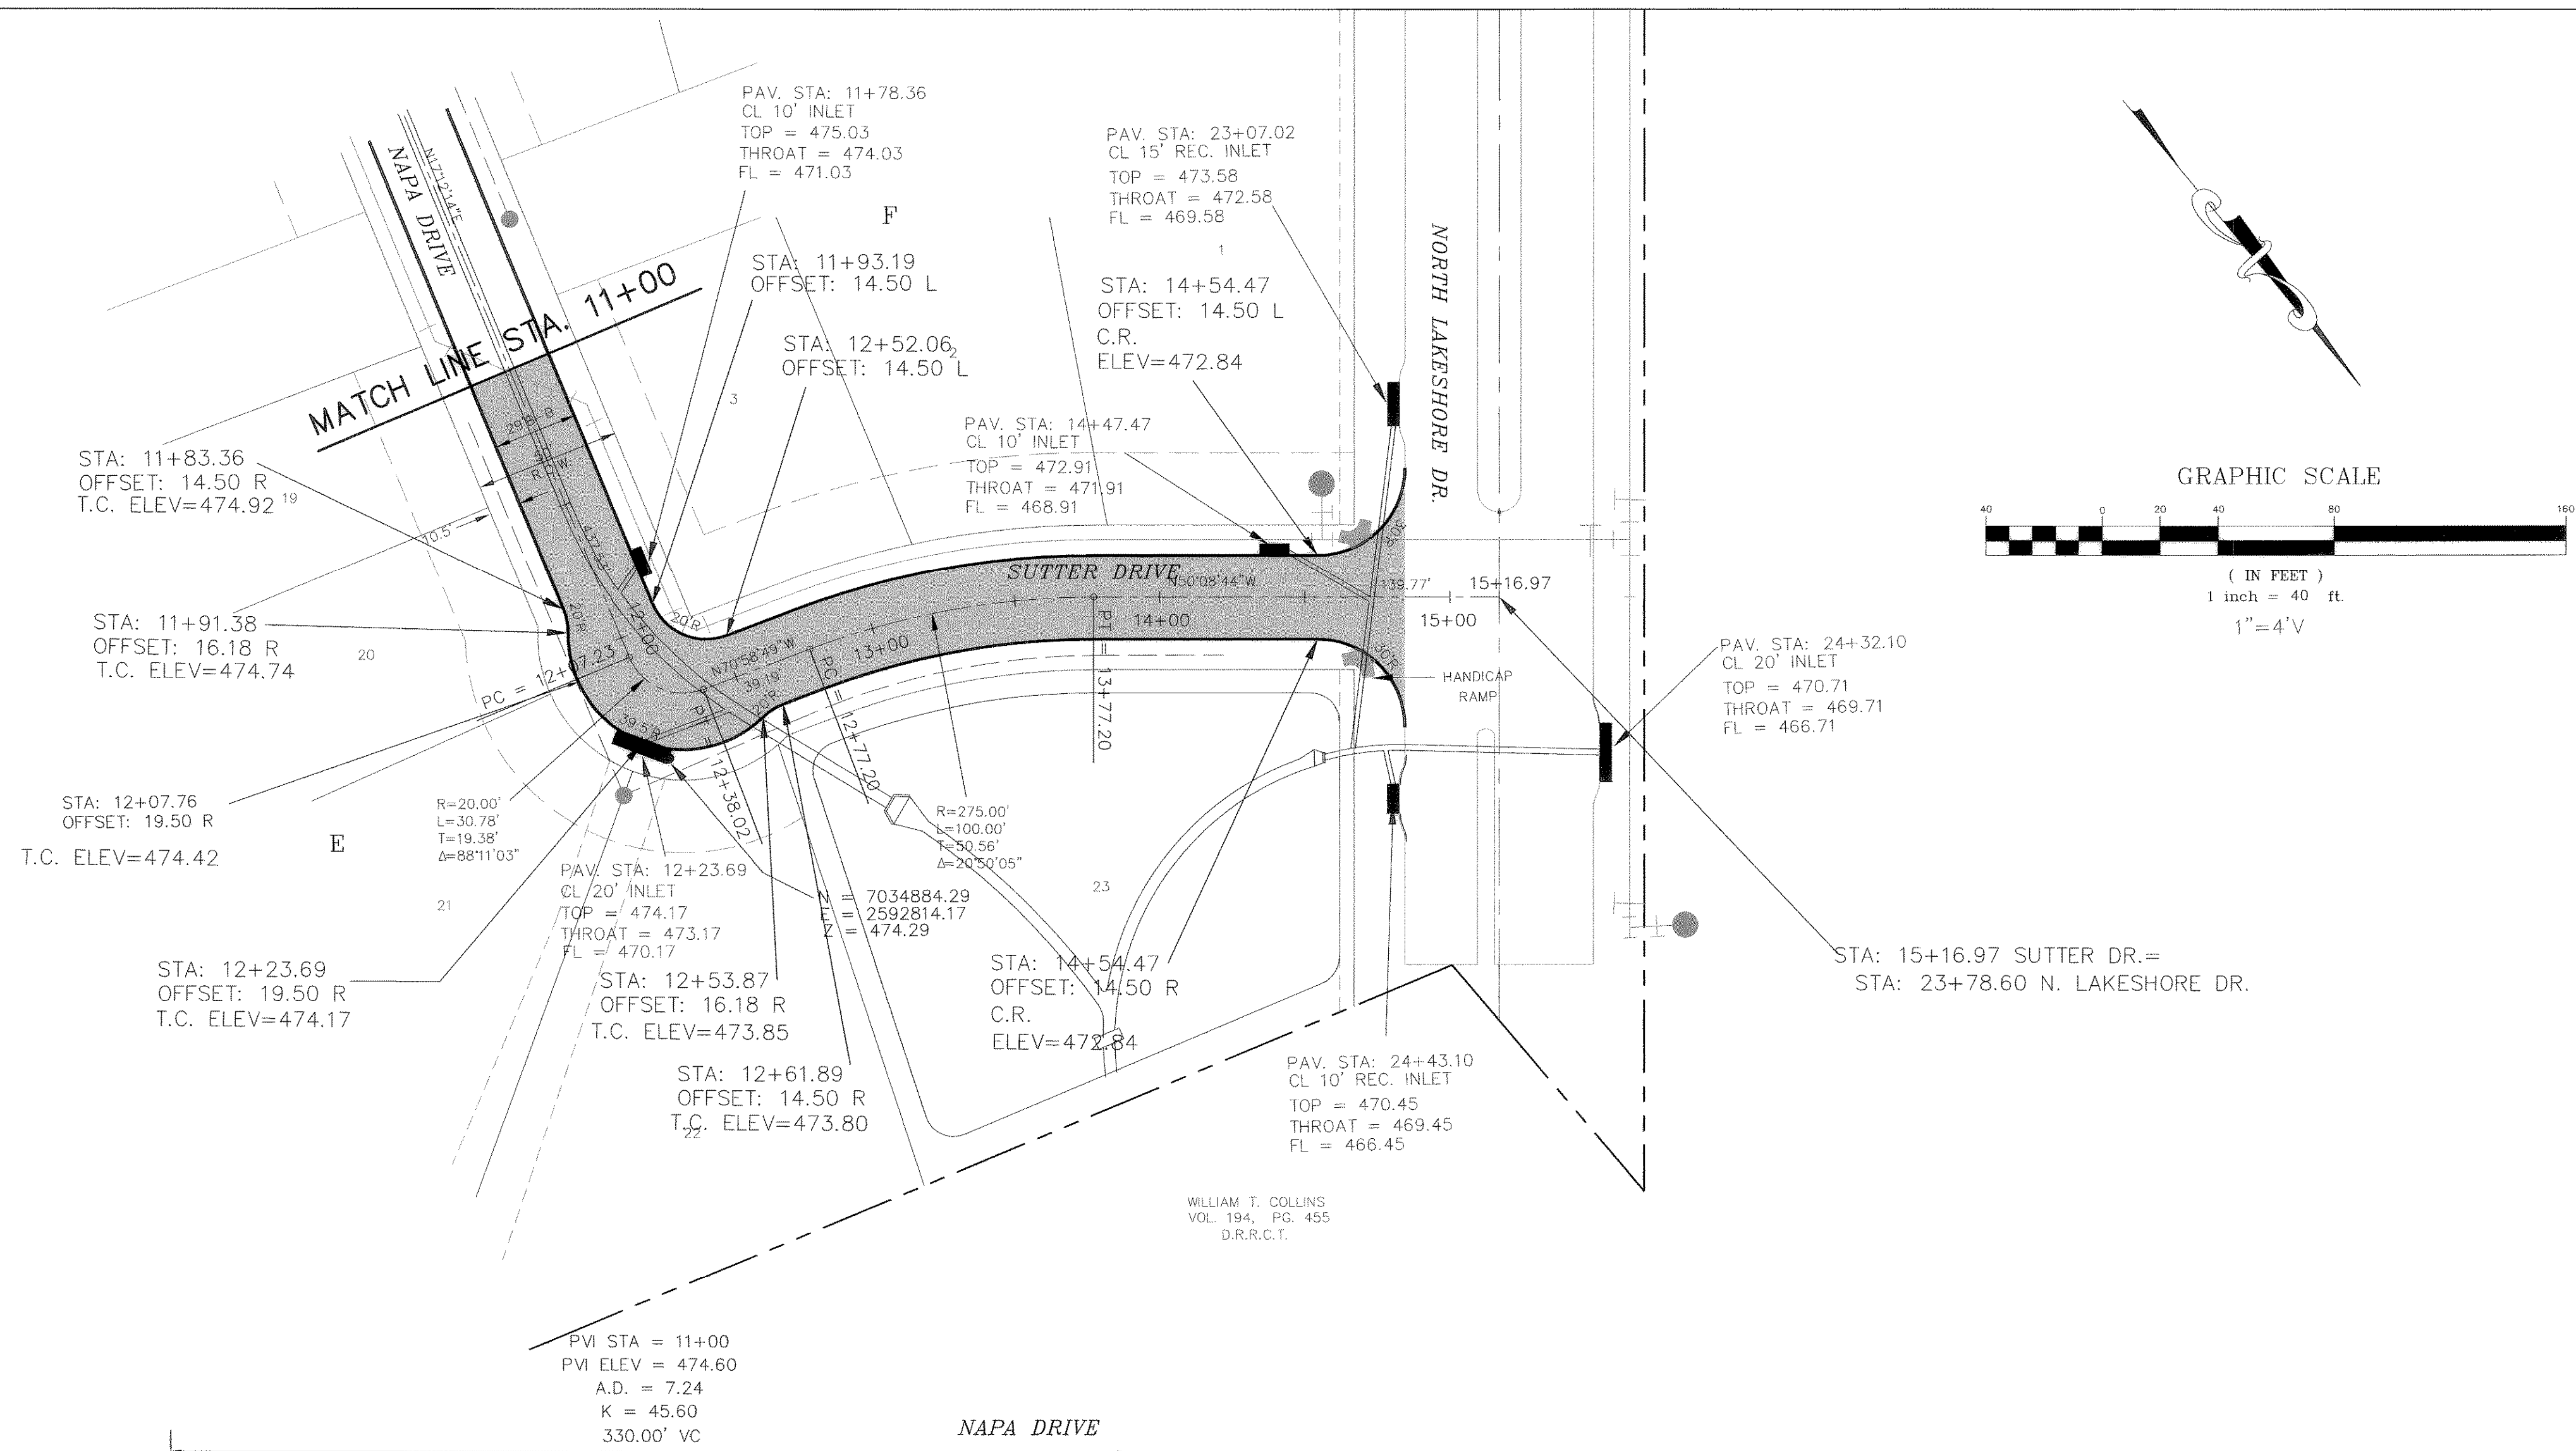

REVISED TO CONFORM TO CONSTRUCTION RECORDS.
DATE: 3/22/04

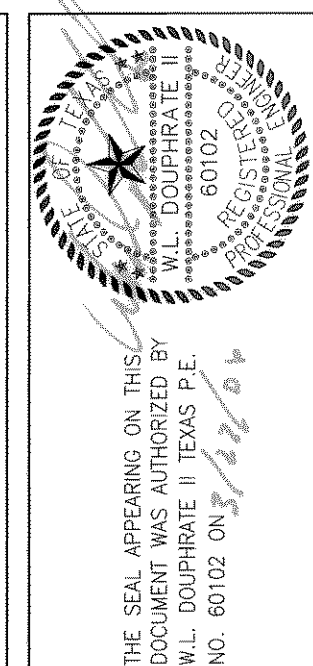

DOUPHRA
& ASSOCIATES, INC.
ENGINEERING - PROJECT MANAGEMENT - SURVEYING
2235 RIDGE RD., # 200 ROCKWALL, TEXAS 75087
PHONE: (972)771-9004 FAX: (972)771-9005

PAVING PLAN & PROFILE
NAPA DRIVE & SUTTER STA: 11+00 TO 15+16.97
LAKEVIEW SUMMIT, PHASE 3
CITY OF ROCKWALL, ROCKWALL COUNTY, TEXAS

REVISION
W.L.D.
CHECKED
KEB.
DRAWN
10/02
DATE
9919-3PV3
PROJECT
11
OF
33