
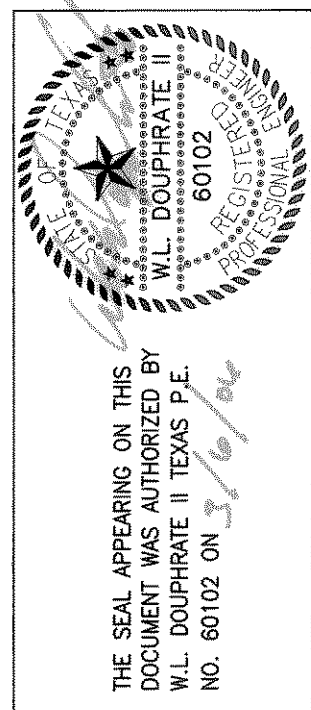
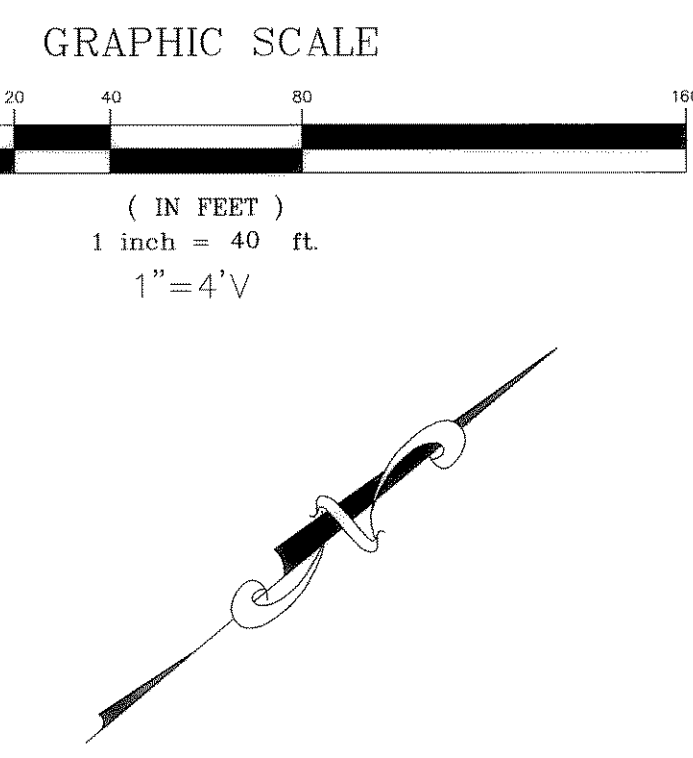


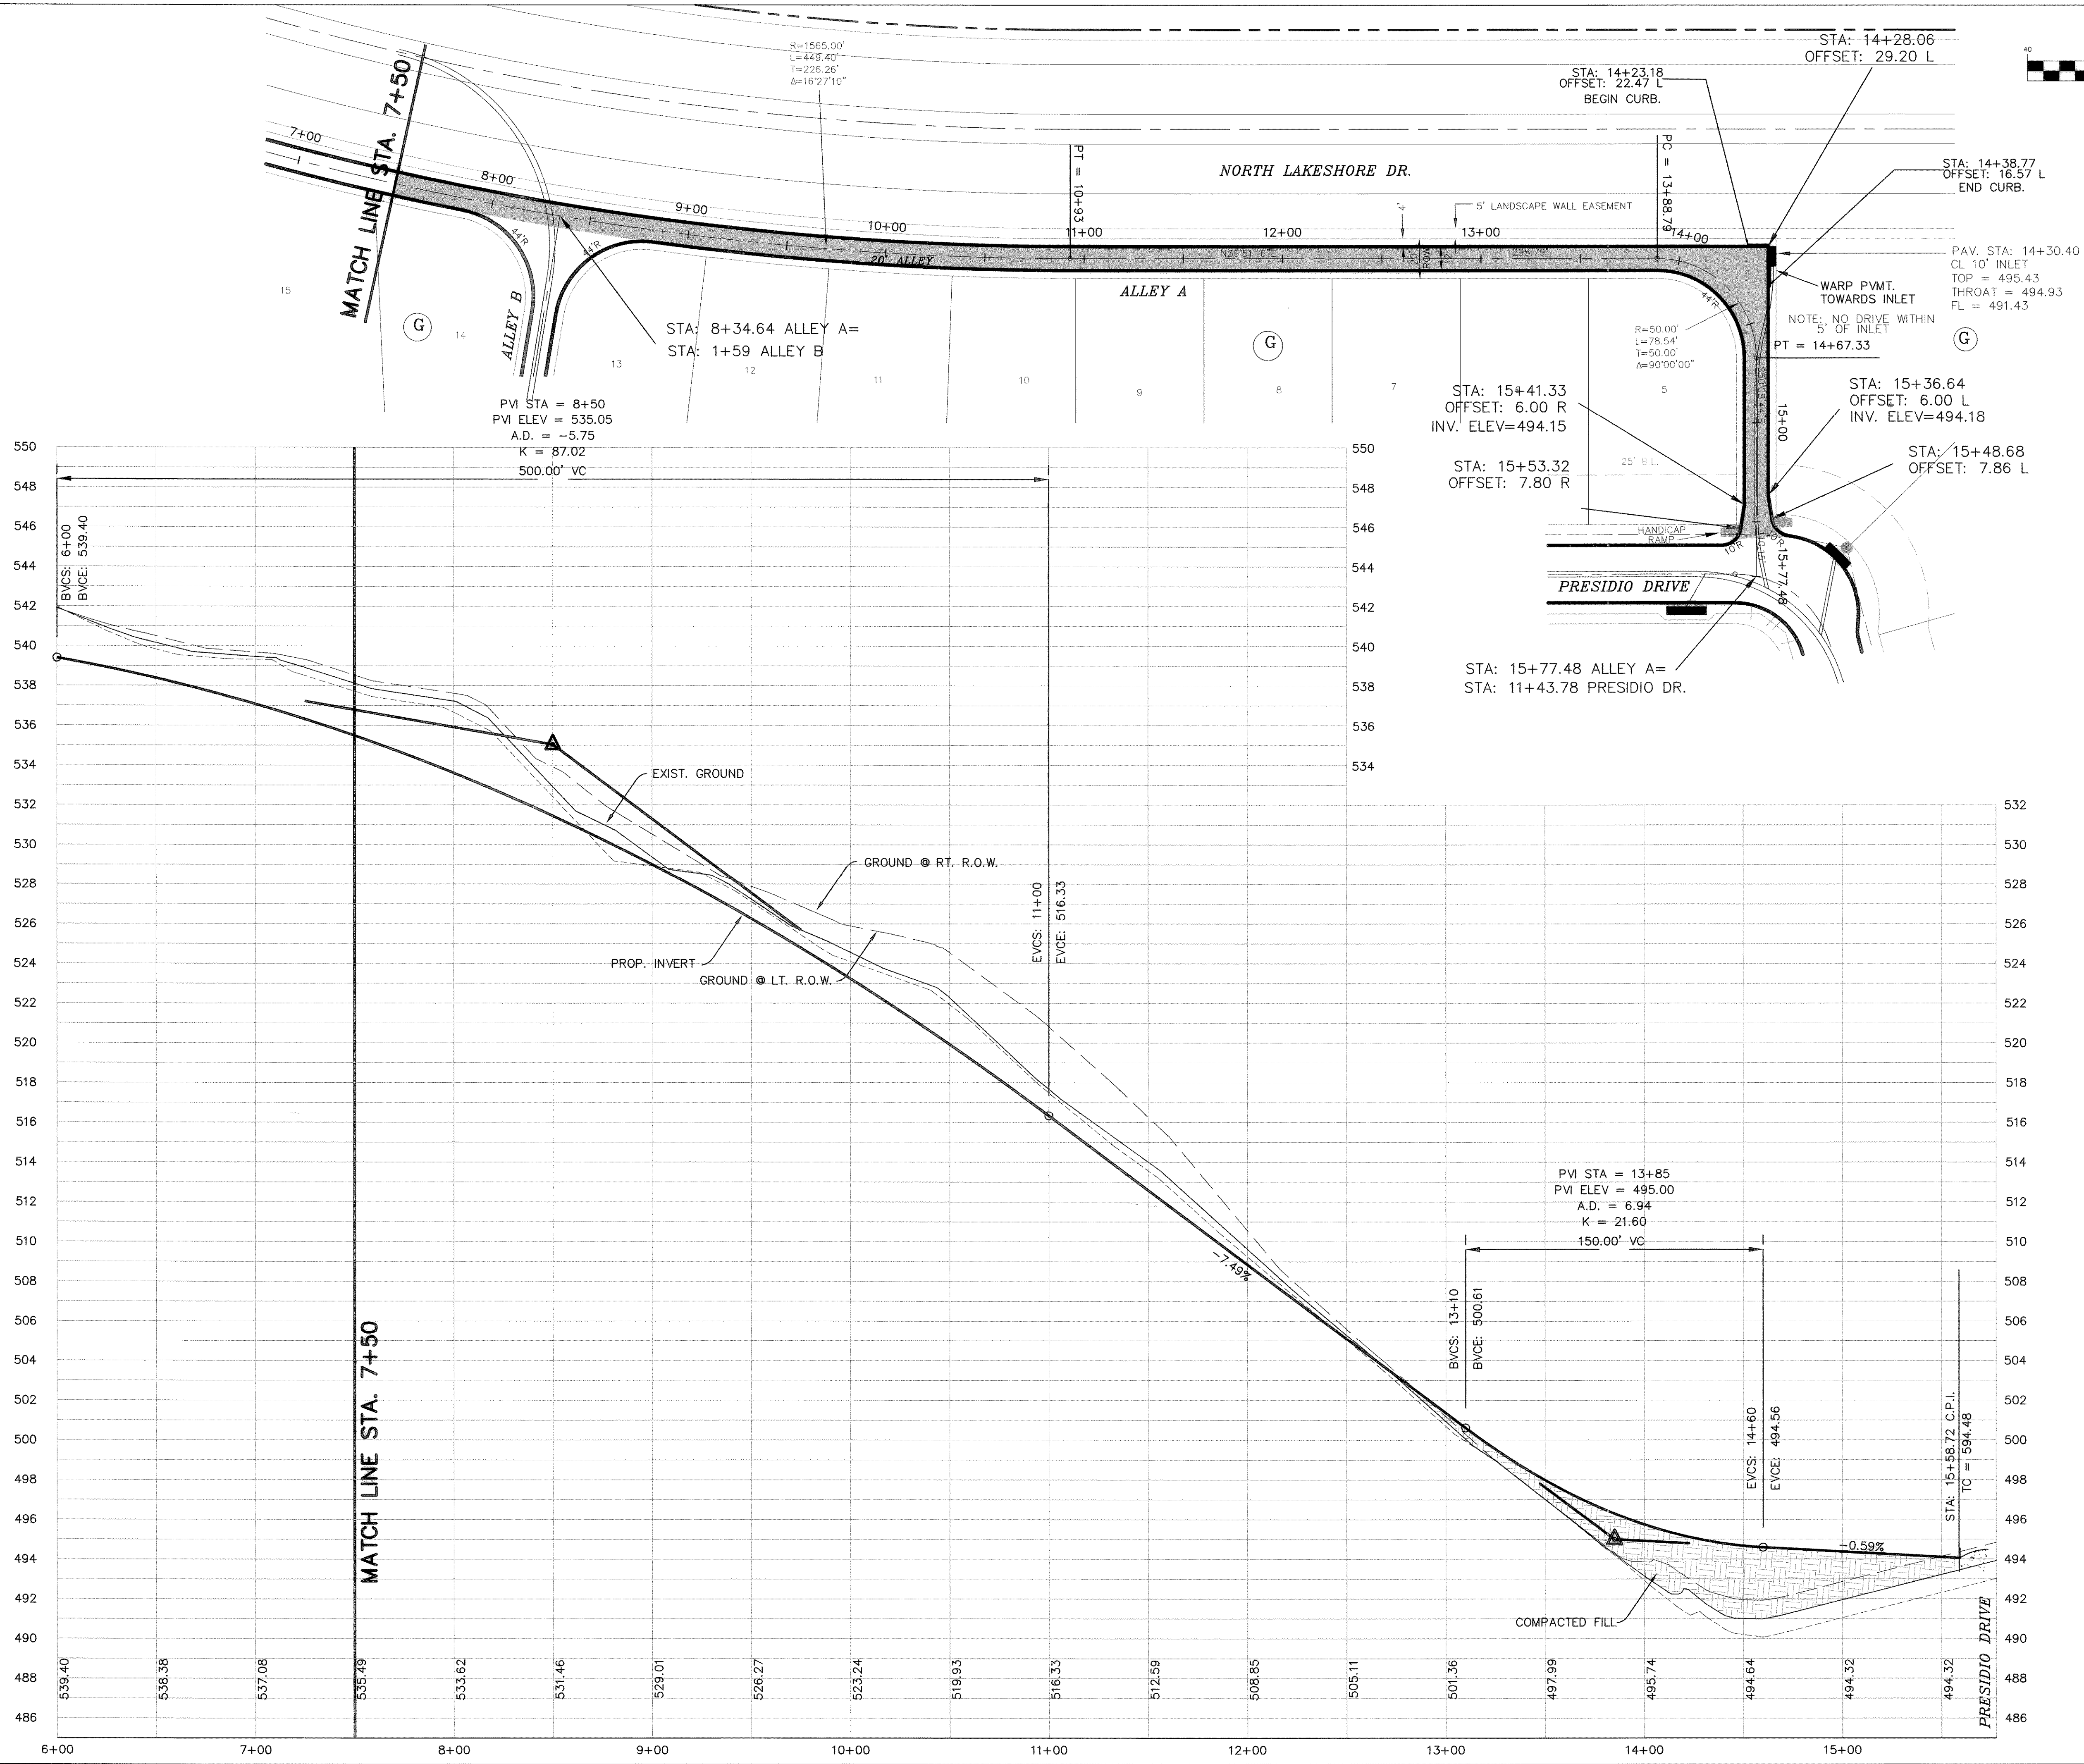

DOUPHRATE & ASSOCIATES, INC.
ENGINEERING • PROJECT MANAGEMENT • SURVEYING
2235 RIDGE RD. # 200 ROCKWALL, TEXAS 75087
PHONE: (972) 771-9004 FAX: (972) 771-9005

PAVING PLAN & PROFILE
ALLEY A STA: 7+50 TO 15+77.48
LAKEVIEW SUMMIT, PHASE 3
CITY OF ROCKWALL, ROCKWALL COUNTY, TEXAS

REVISION
W.L.D. CHECKED
K.E.B. DRAWN
10/02 DATE
9919-3PV8 PROJECT
16 OF 33

REVISED TO CONFORM TO CONSTRUCTION RECORDS.
W.L. Douphrate DATE: 3/16/04