
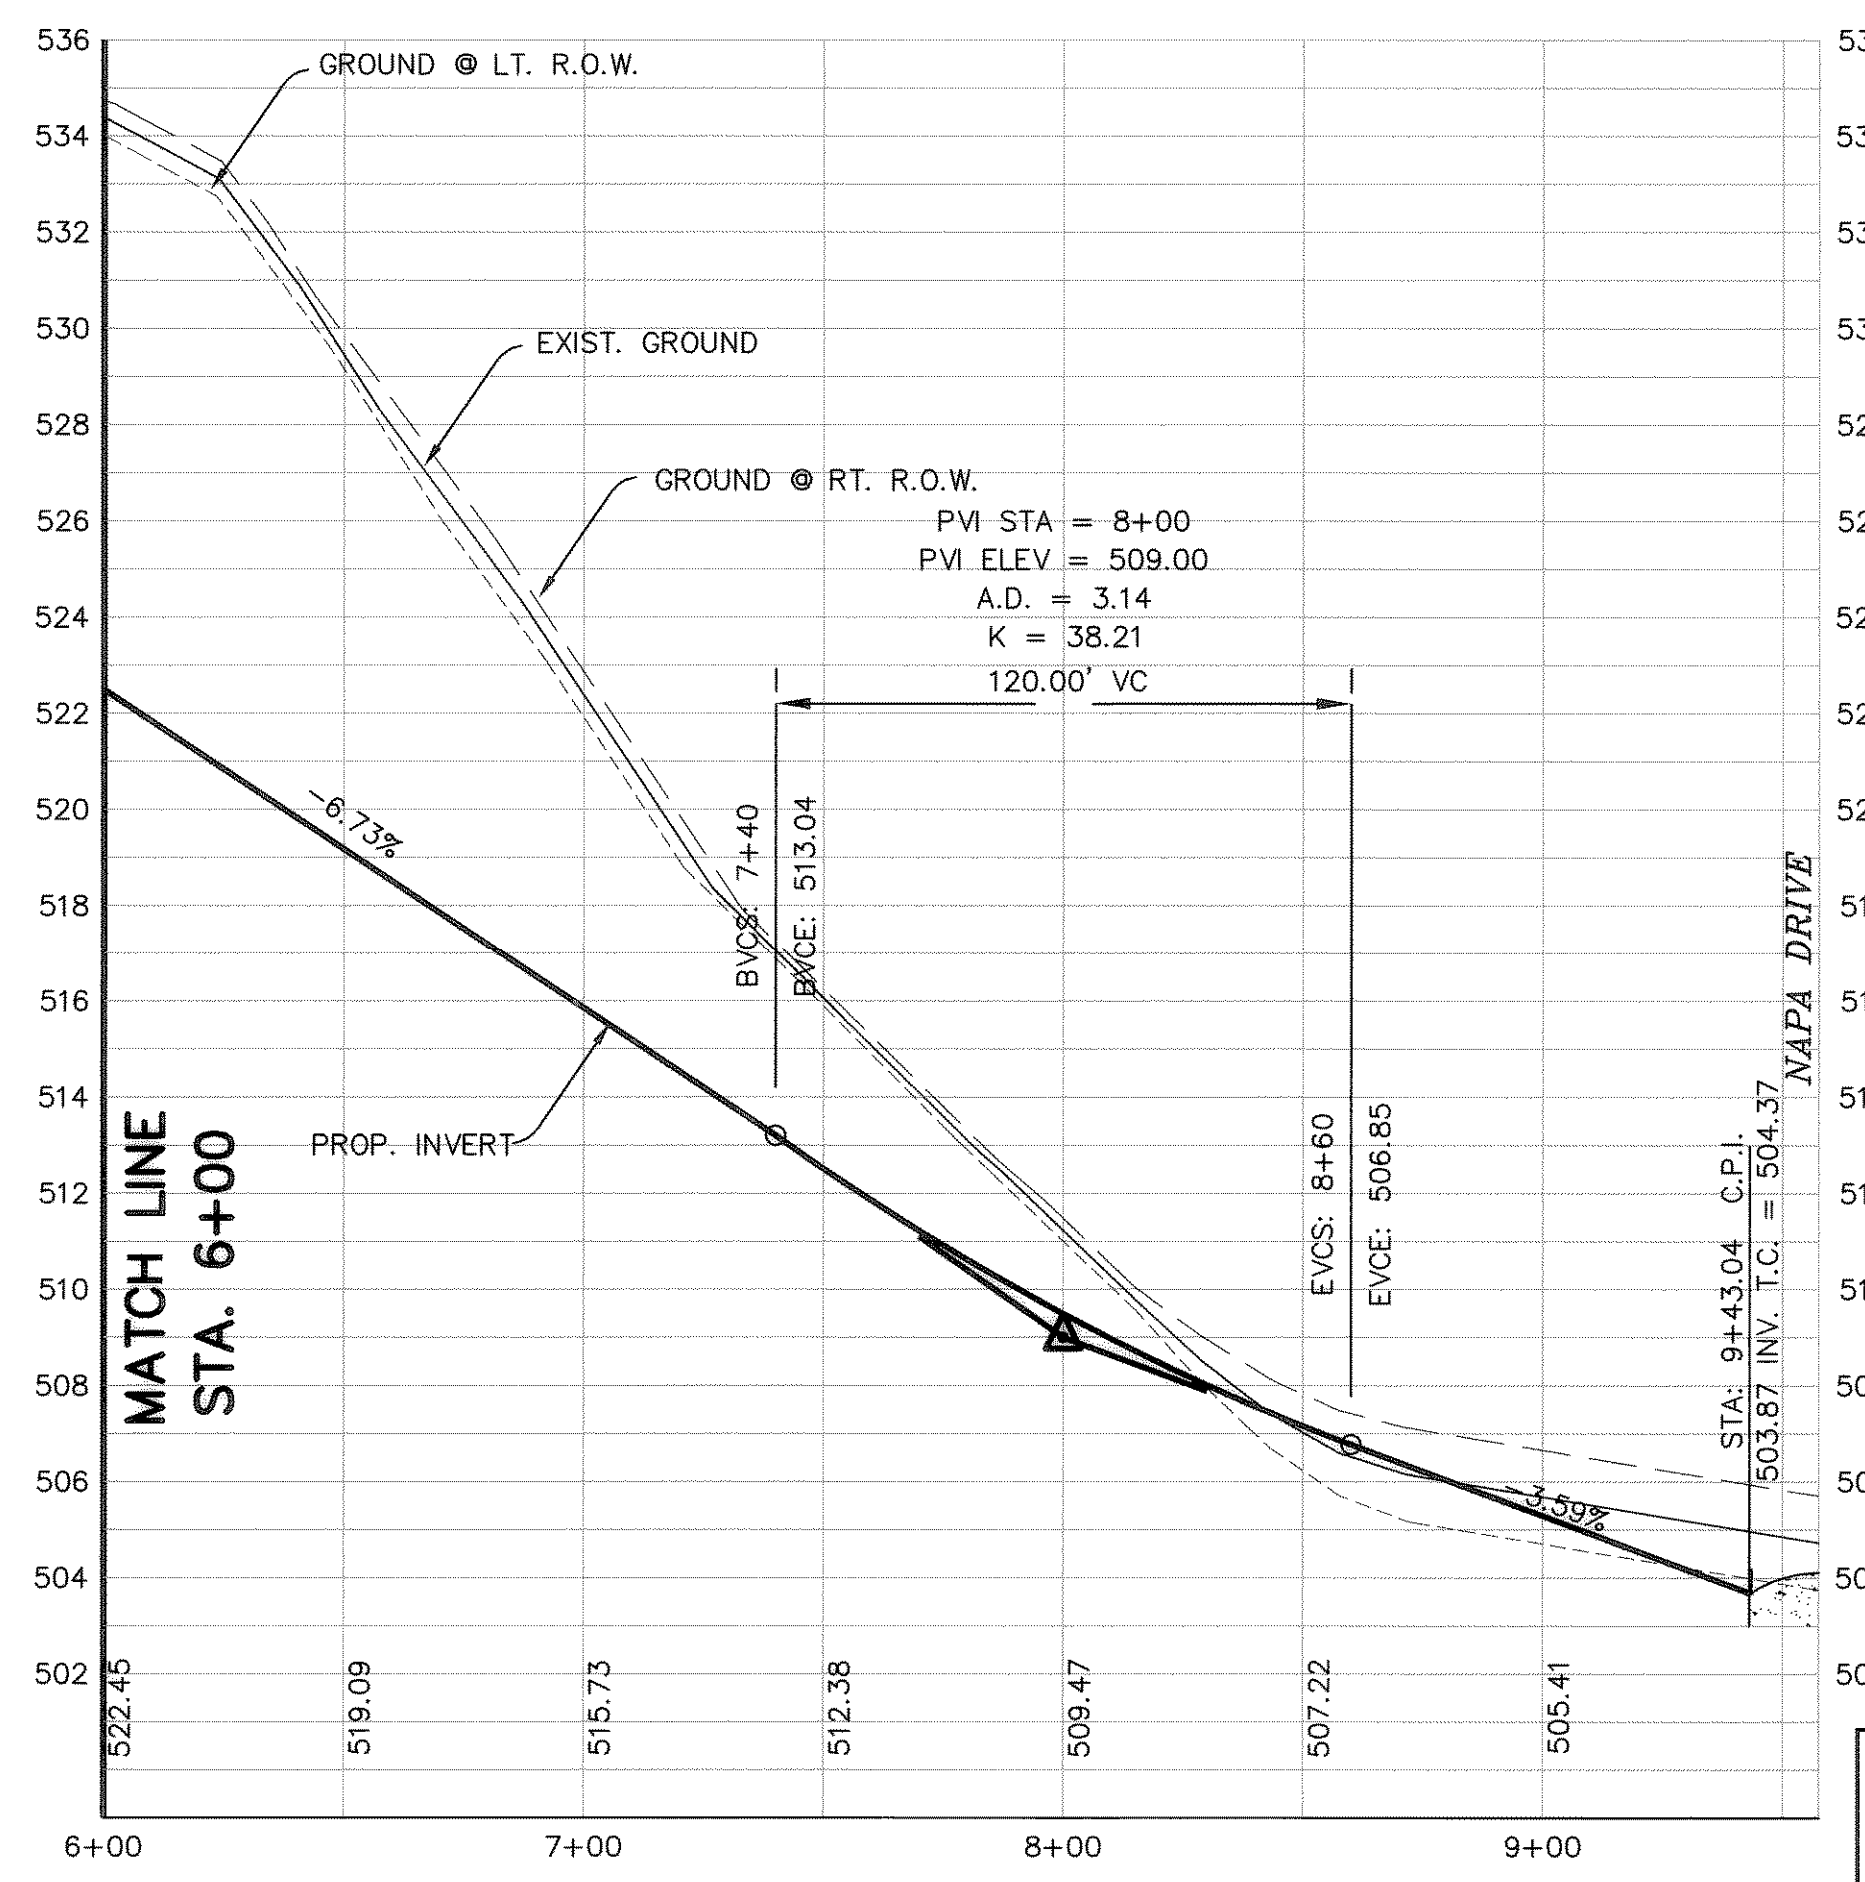
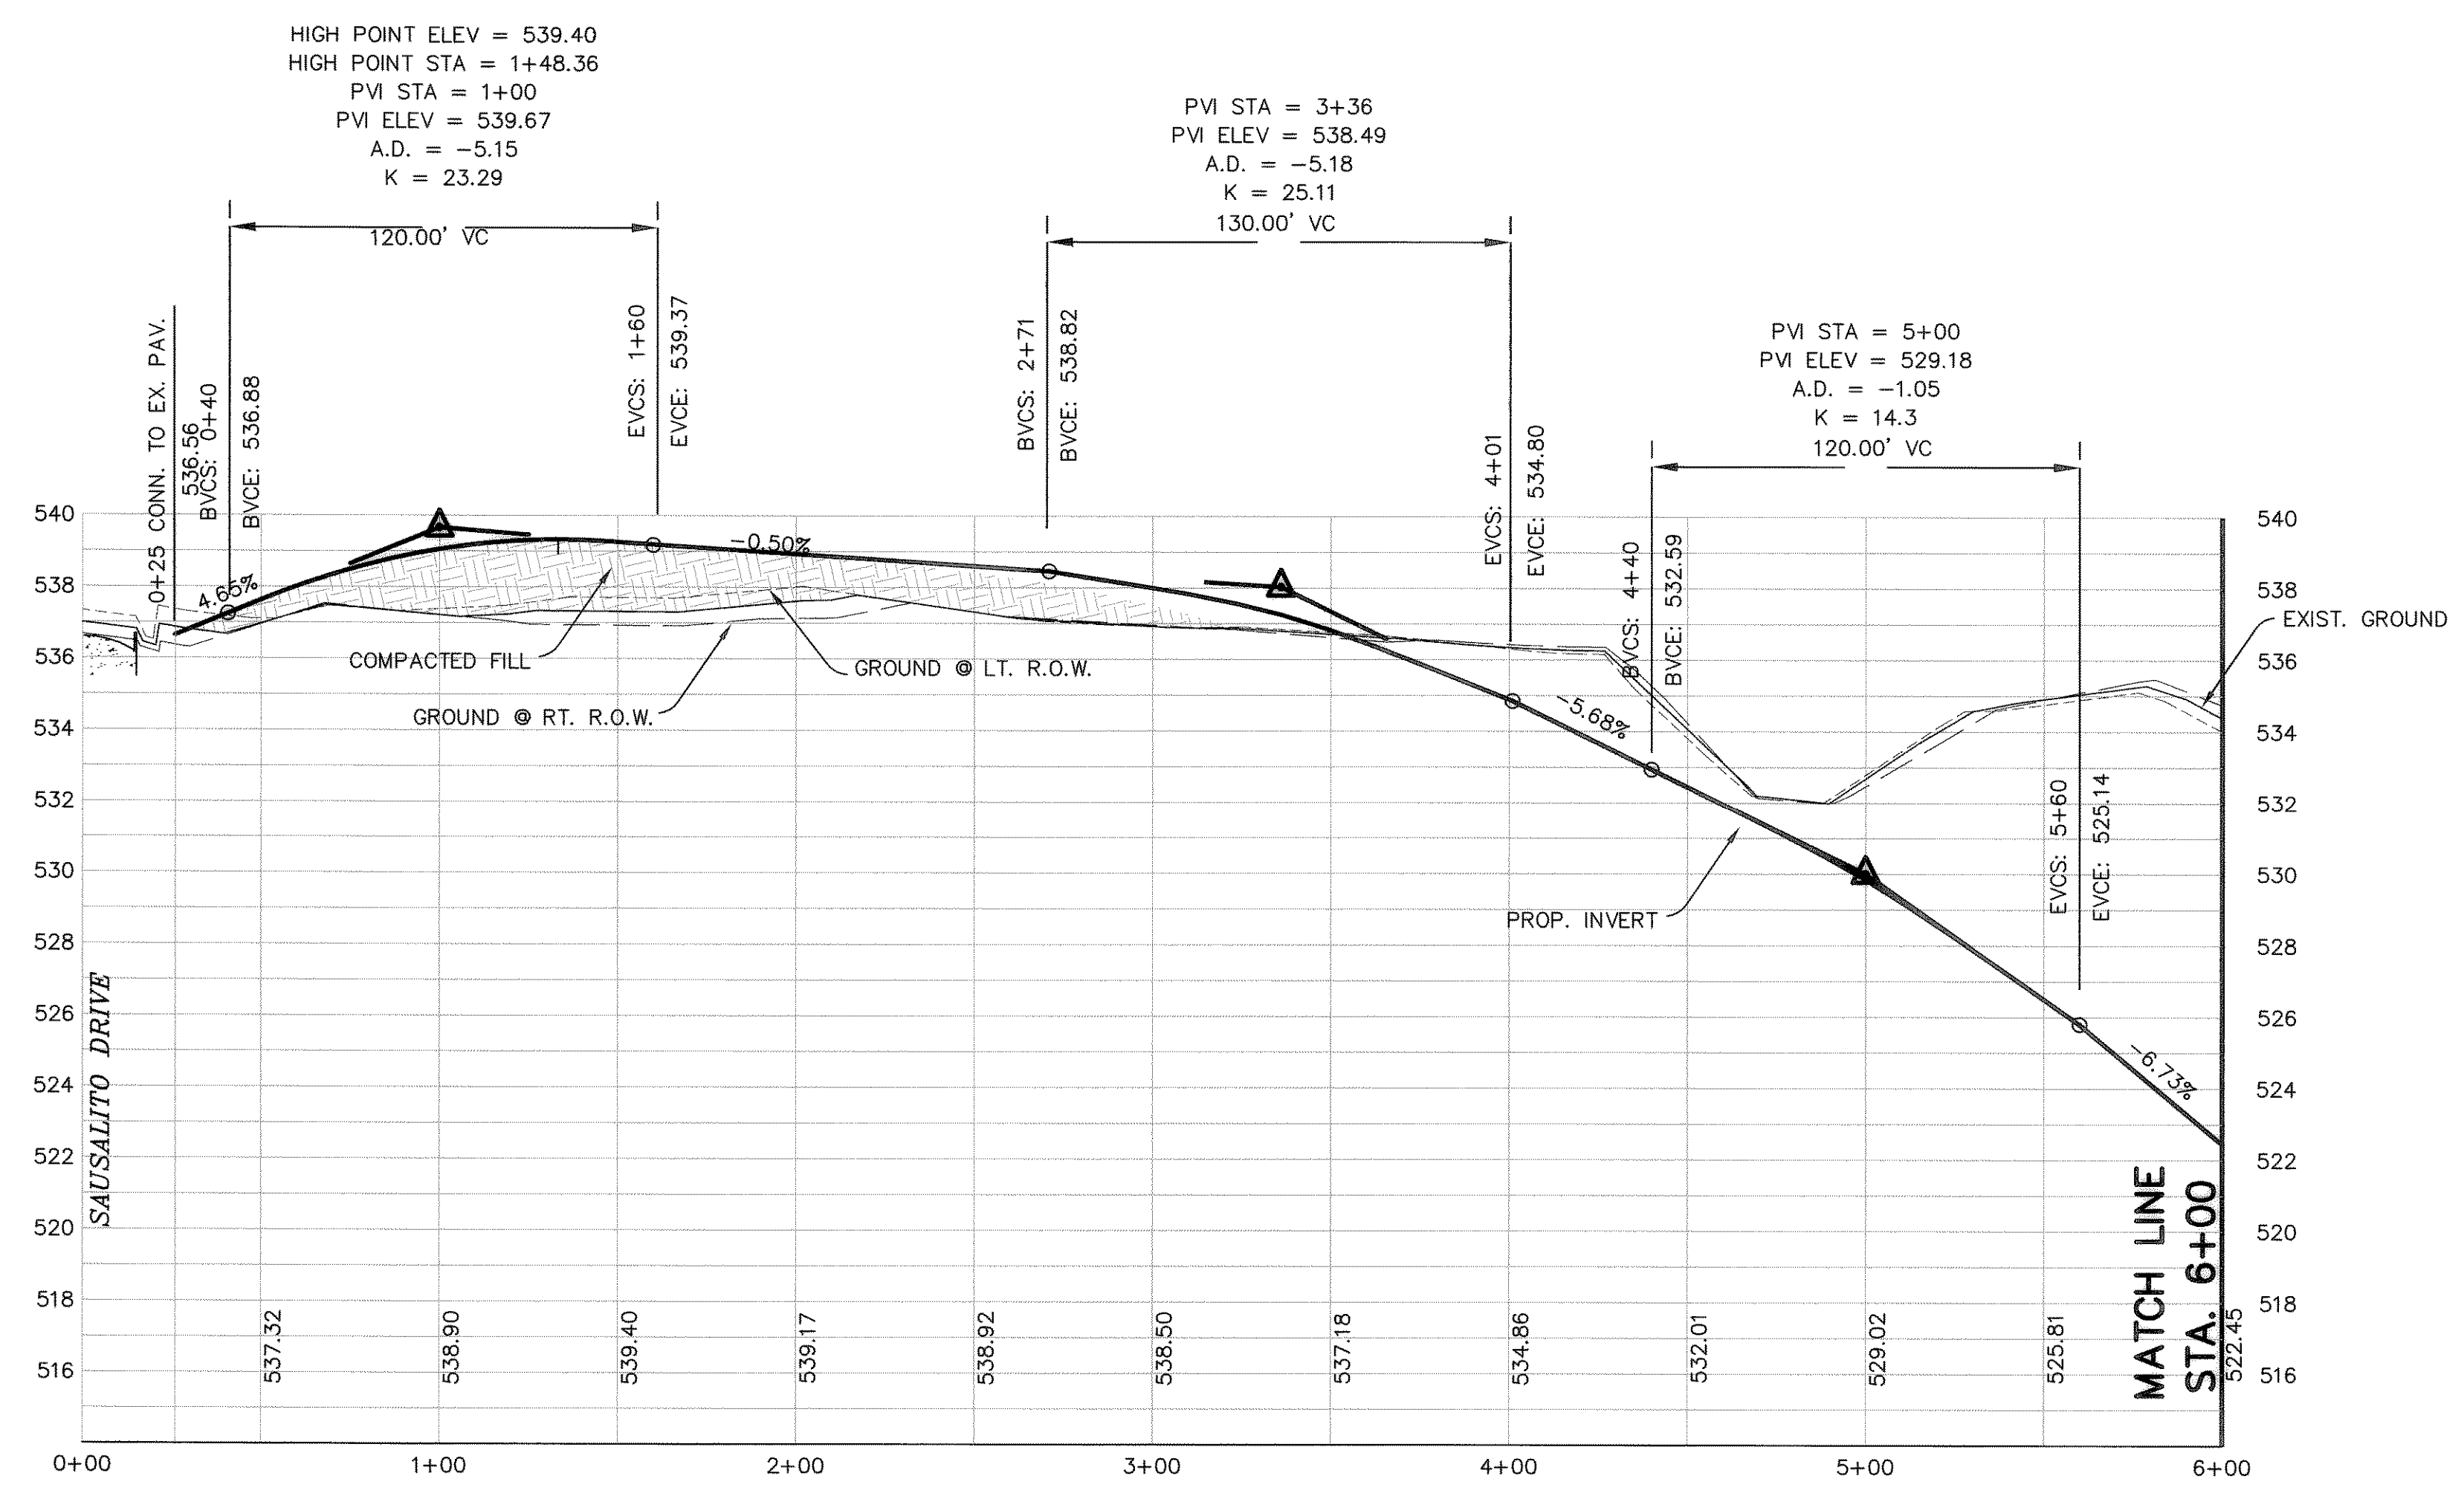


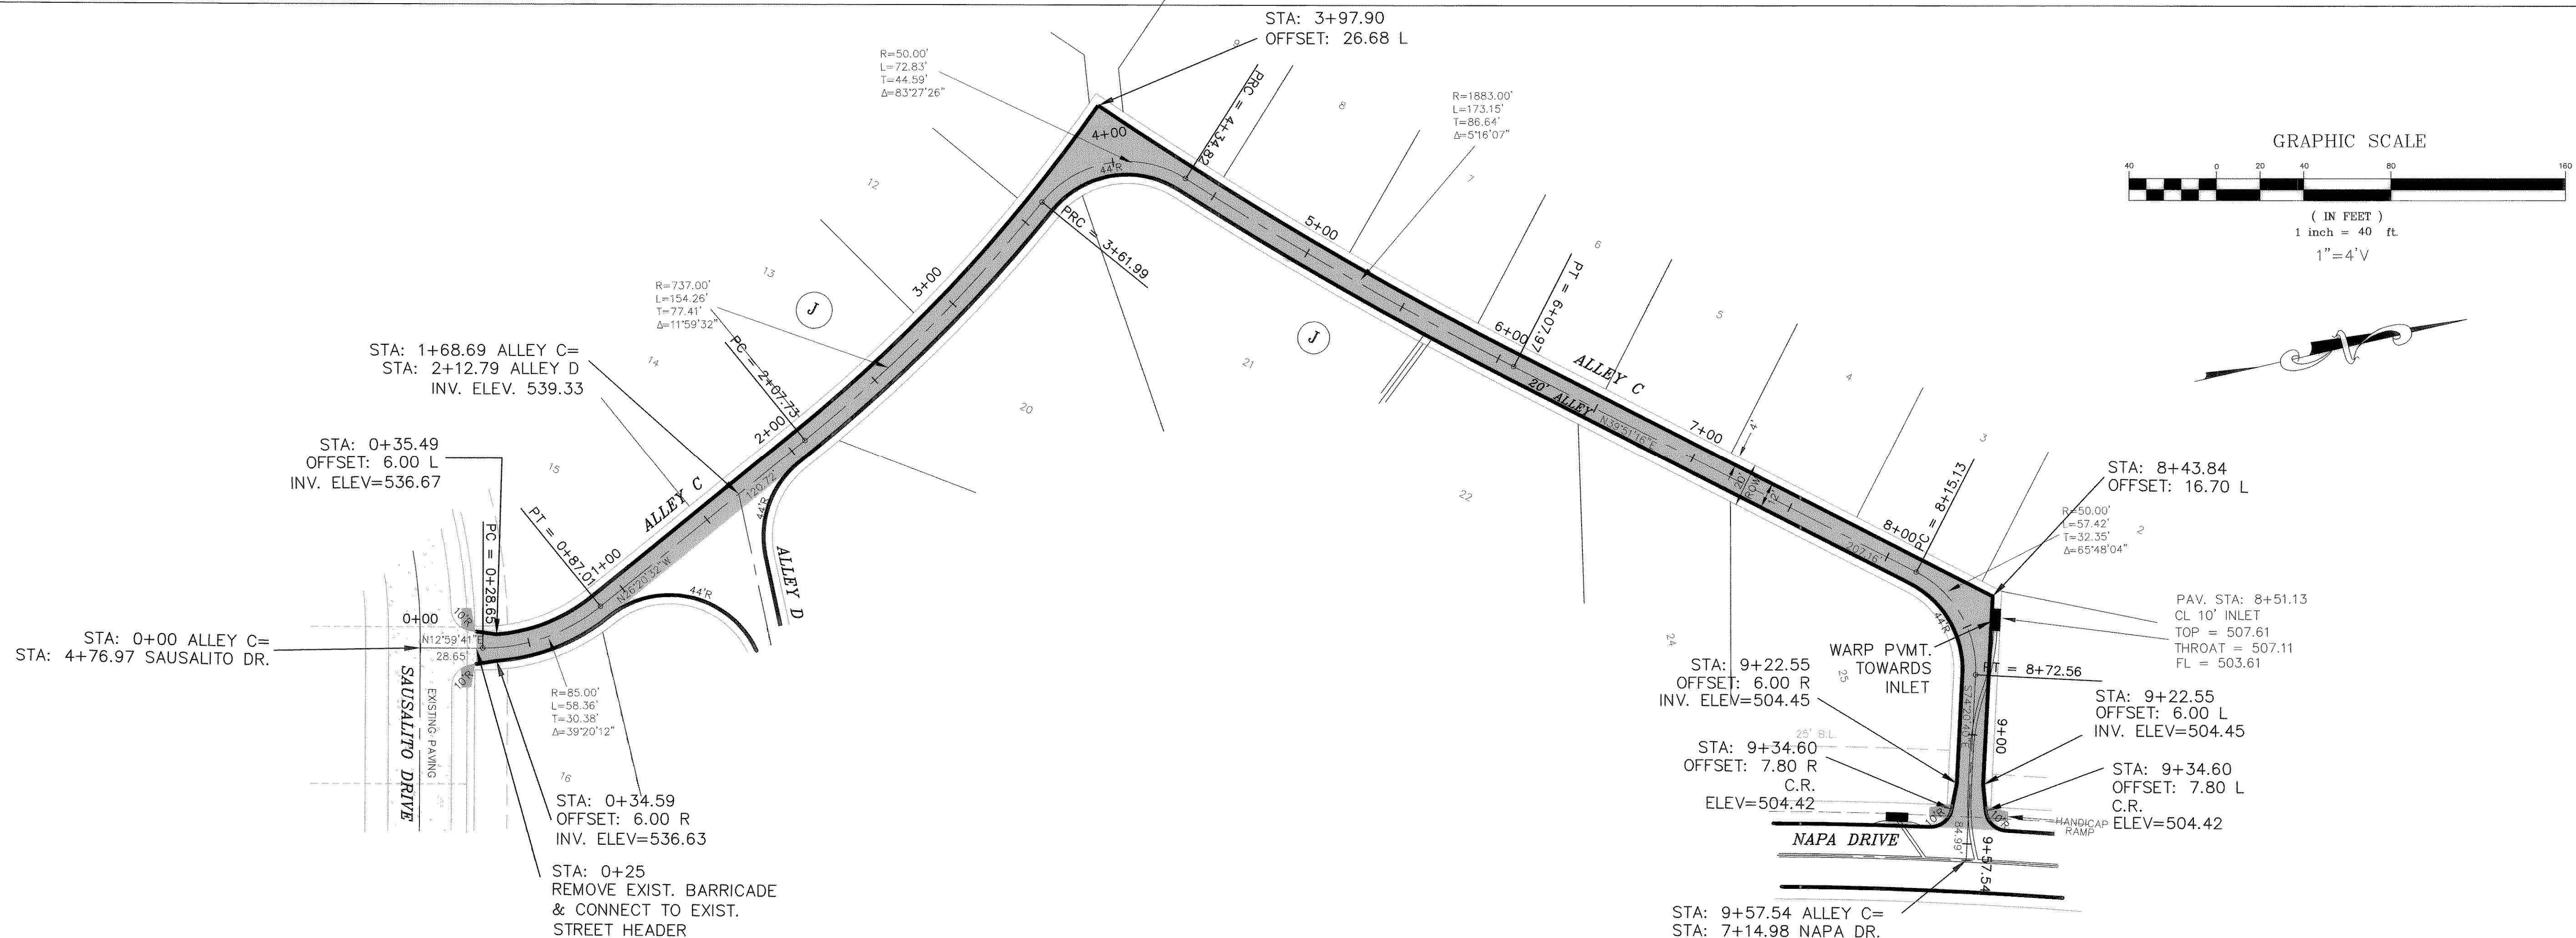

REVISED TO CONFORM TO CONSTRUCTION RECORDS.
 DATE: 2/16/04

DOUPHRAE & ASSOCIATES, INC.

ENGINEERING - PROJECT MANAGEMENT - SURVEYING

2235 RIDGE RD., # 200 ROCKWALL, TEXAS 75087

PHONE: (972)771-9004 FAX: (972)771-9005

PAVING PLAN & PROFILE

ALLEY C

LAKEVIEW SUMMIT, PHASE 3

CITY OF ROCKWALL, ROCKWALL COUNTY, TEXAS

REVISION	DATE
W.L.D. CHECKED	10/02
K.E.B. DRAWN	9919-3PVI0
PROJECT	

18 OF 33

DATE: 2/16/04