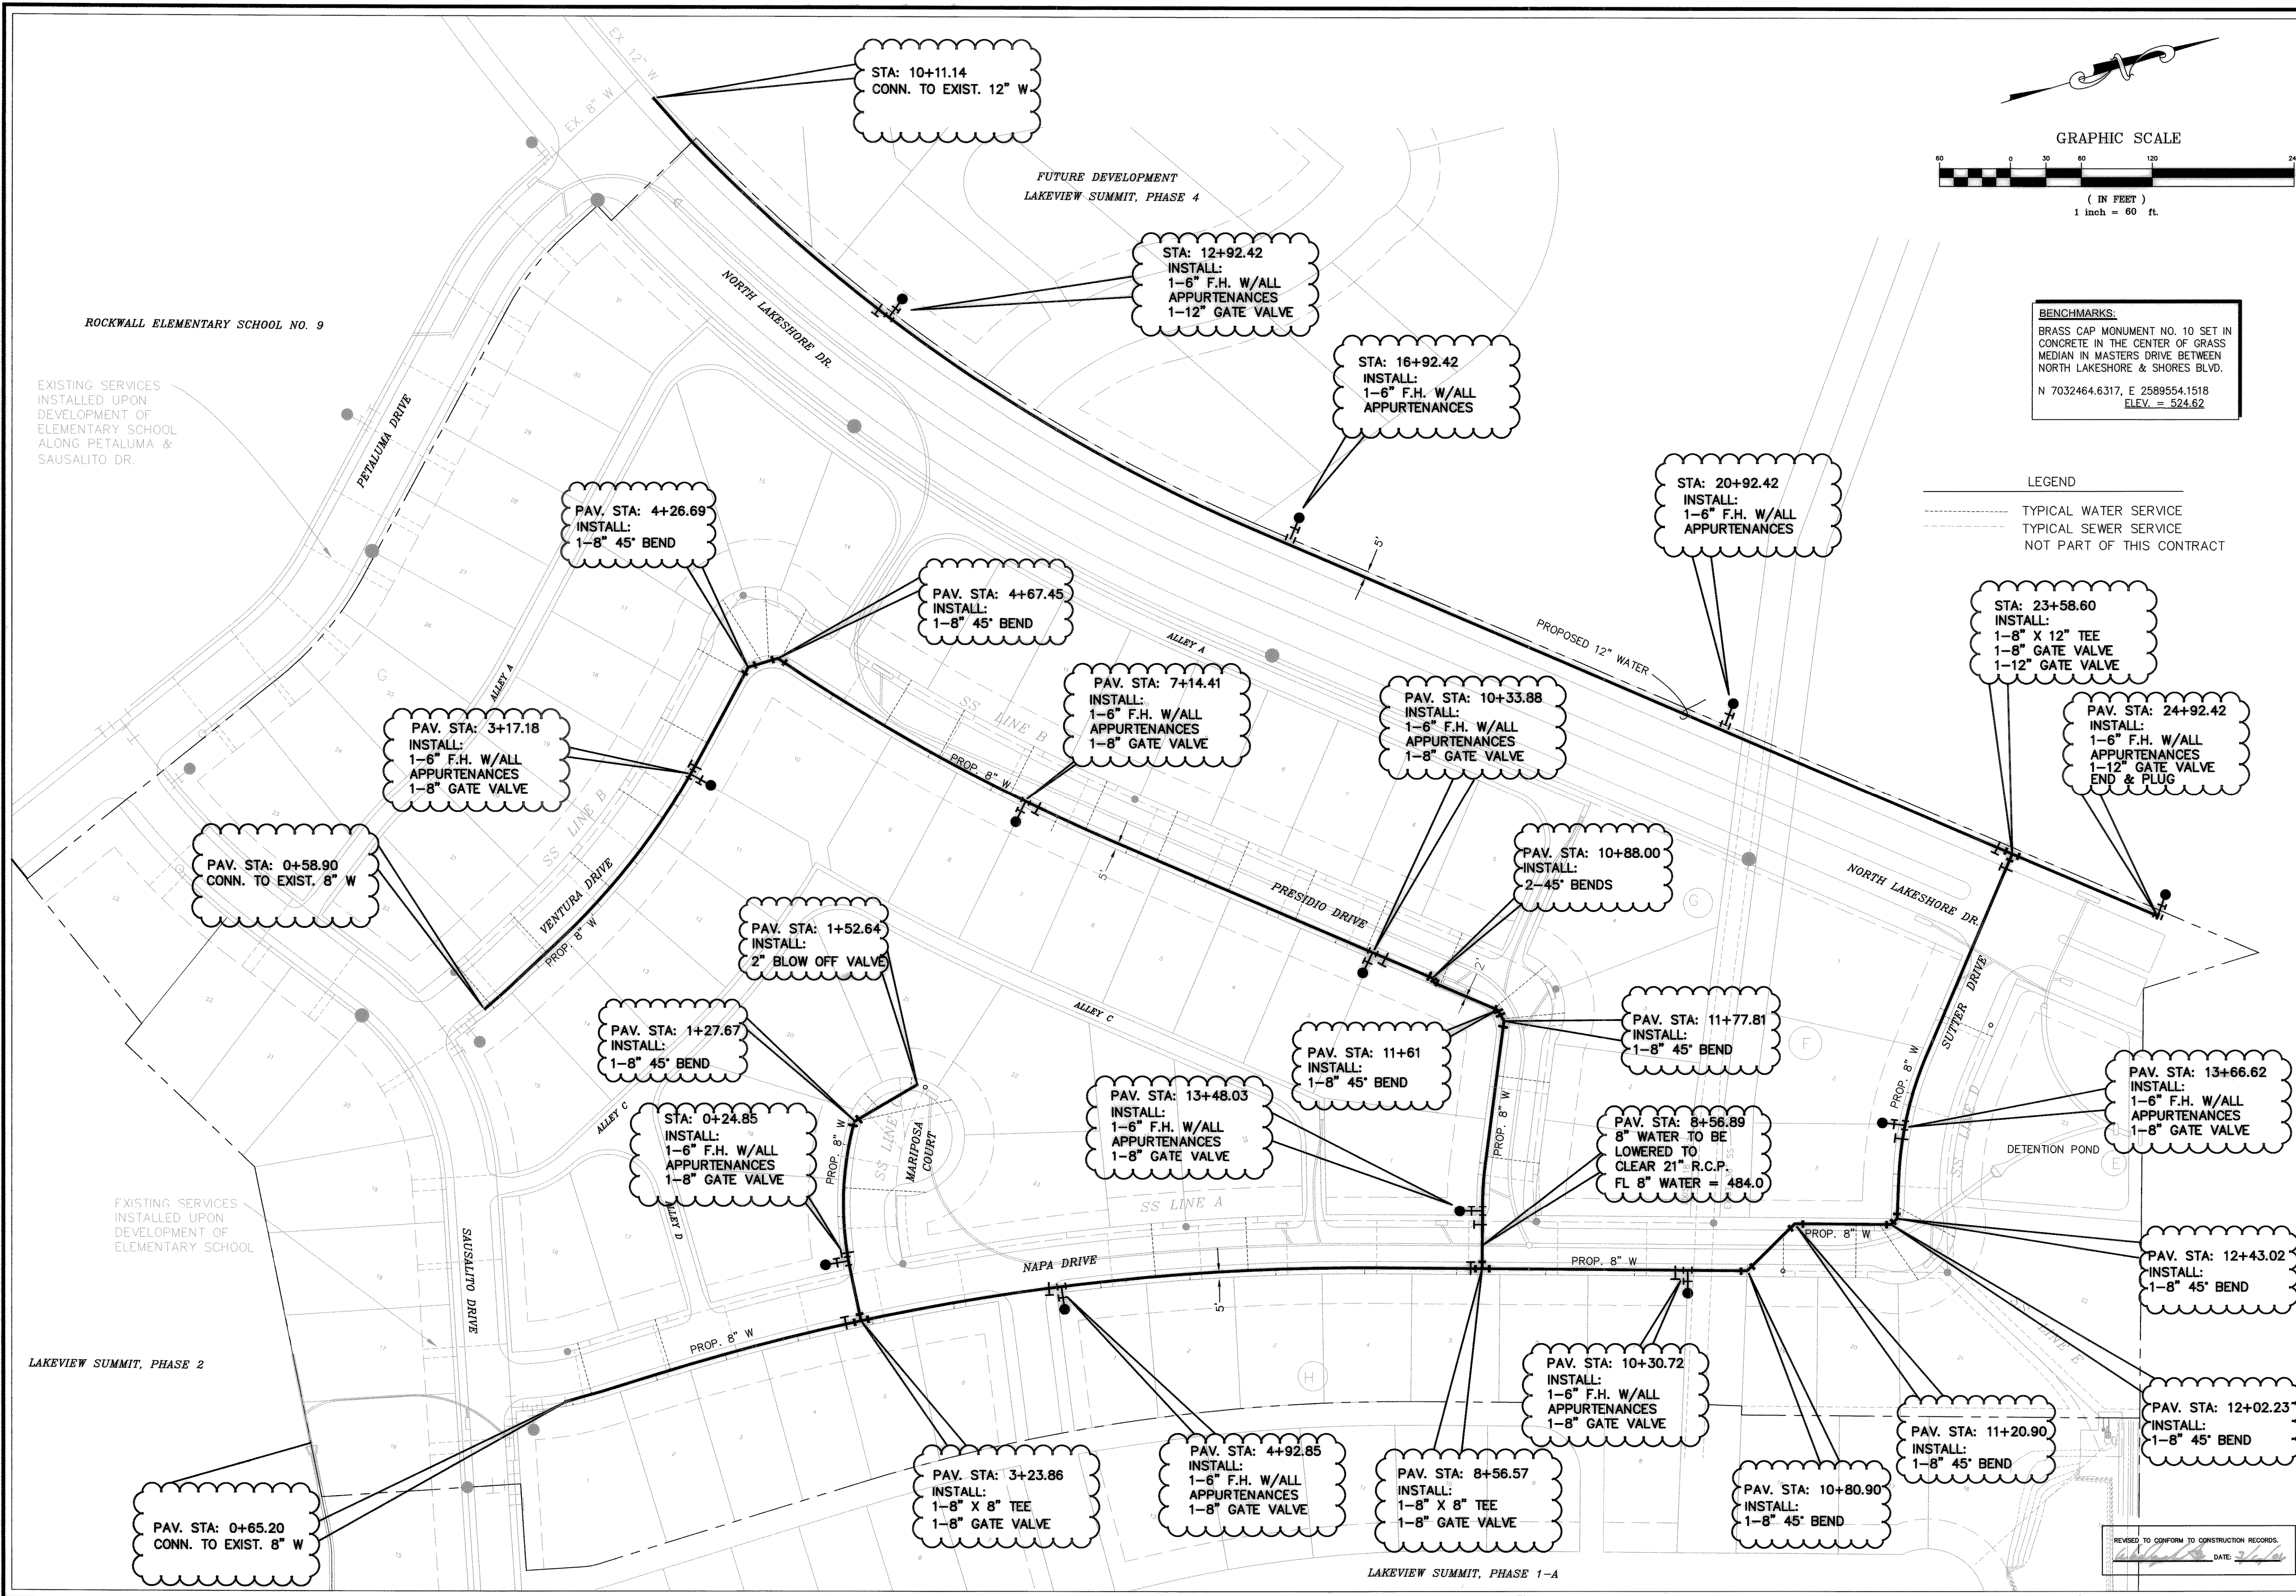


BENCHMARKS

BRASS CAP MONUMENT NO. 10 SET IN CONCRETE IN THE CENTER OF GRASS MEDIAN IN MASTERS DRIVE BETWEEN NORTH LAKESHORE & SHORES BLVD.


N 7032464.6317, E 2589554.1518
ELEV. = 524.62

LEGEND

--- TYPICAL WATER SERVICE

--- TYPICAL SEWER SERVICE

--- NOT PART OF THIS CONTRACT

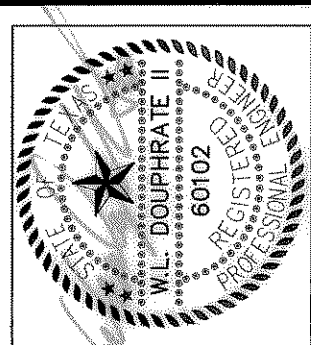

DOUPHRA
& ASSOCIATES, INC.

ENGINEERING - PROJECT MANAGEMENT - SURVEYING

2235 RIDGE RD., # 200 ROCKWALL, TEXAS 75087

PHONE: (972) 771-9004 FAX: (972) 771-9005

WATER PLAN

LAKEVIEW SUMMIT, PHASE 3

CITY OF ROCKWALL

ROCKWALL COUNTY, TEXAS

REVISION	W.L.D.
CHECKED	K.E.B.
DRAWN	10/02
DATE	9919-3WATER
PROJECT	

REVISED TO CONFORM TO CONSTRUCTION RECORDS.

DATE: 7/6/14