


DOUPHRA
 & ASSOCIATES, INC.
 ENGINEERING - PROJECT MANAGEMENT - SURVEYING
 2235 RIDGE RD., # 200 ROCKWALL, TEXAS 75087
 PHONE: (972)771-9004 FAX: (972)771-9005


SANITARY SEWER PLAN
 LAKEVIEW SUMMIT, PHASE 3
 CITY OF ROCKWALL
 ROCKWALL COUNTY, TEXAS

REVISION	
W.L.D.	CHECKED
K.E.B.	DRAWN
10/02	DATE
9919-3SEW	PROJECT
21	OF
33	

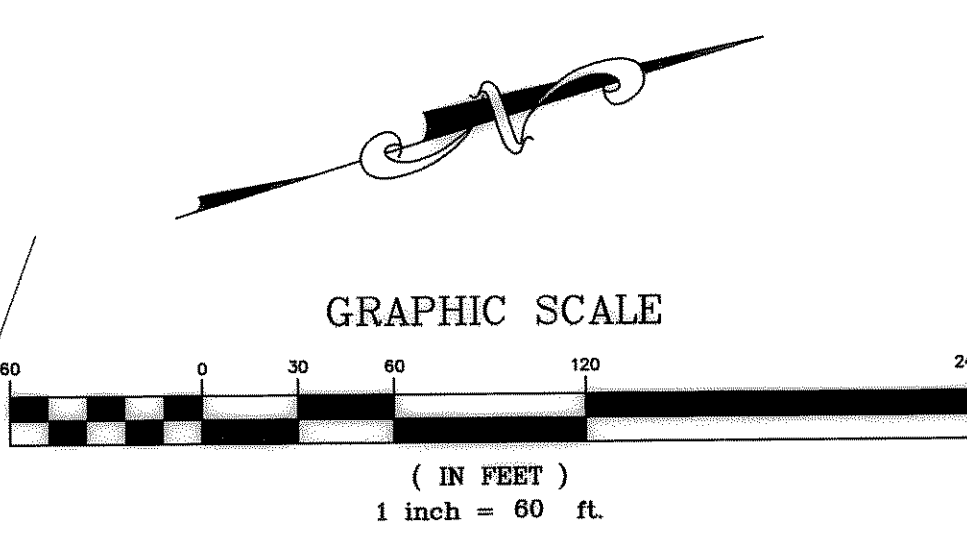

LEGEND
 --- TYPICAL WATER SERVICE
 - - - TYPICAL SEWER SERVICE

NOTES:
 - REPLACE FENCE, GRAVEL, ROAD,
 AND ANYTHING REMOVED OR
 DISTURBED DURING CONNECTION.

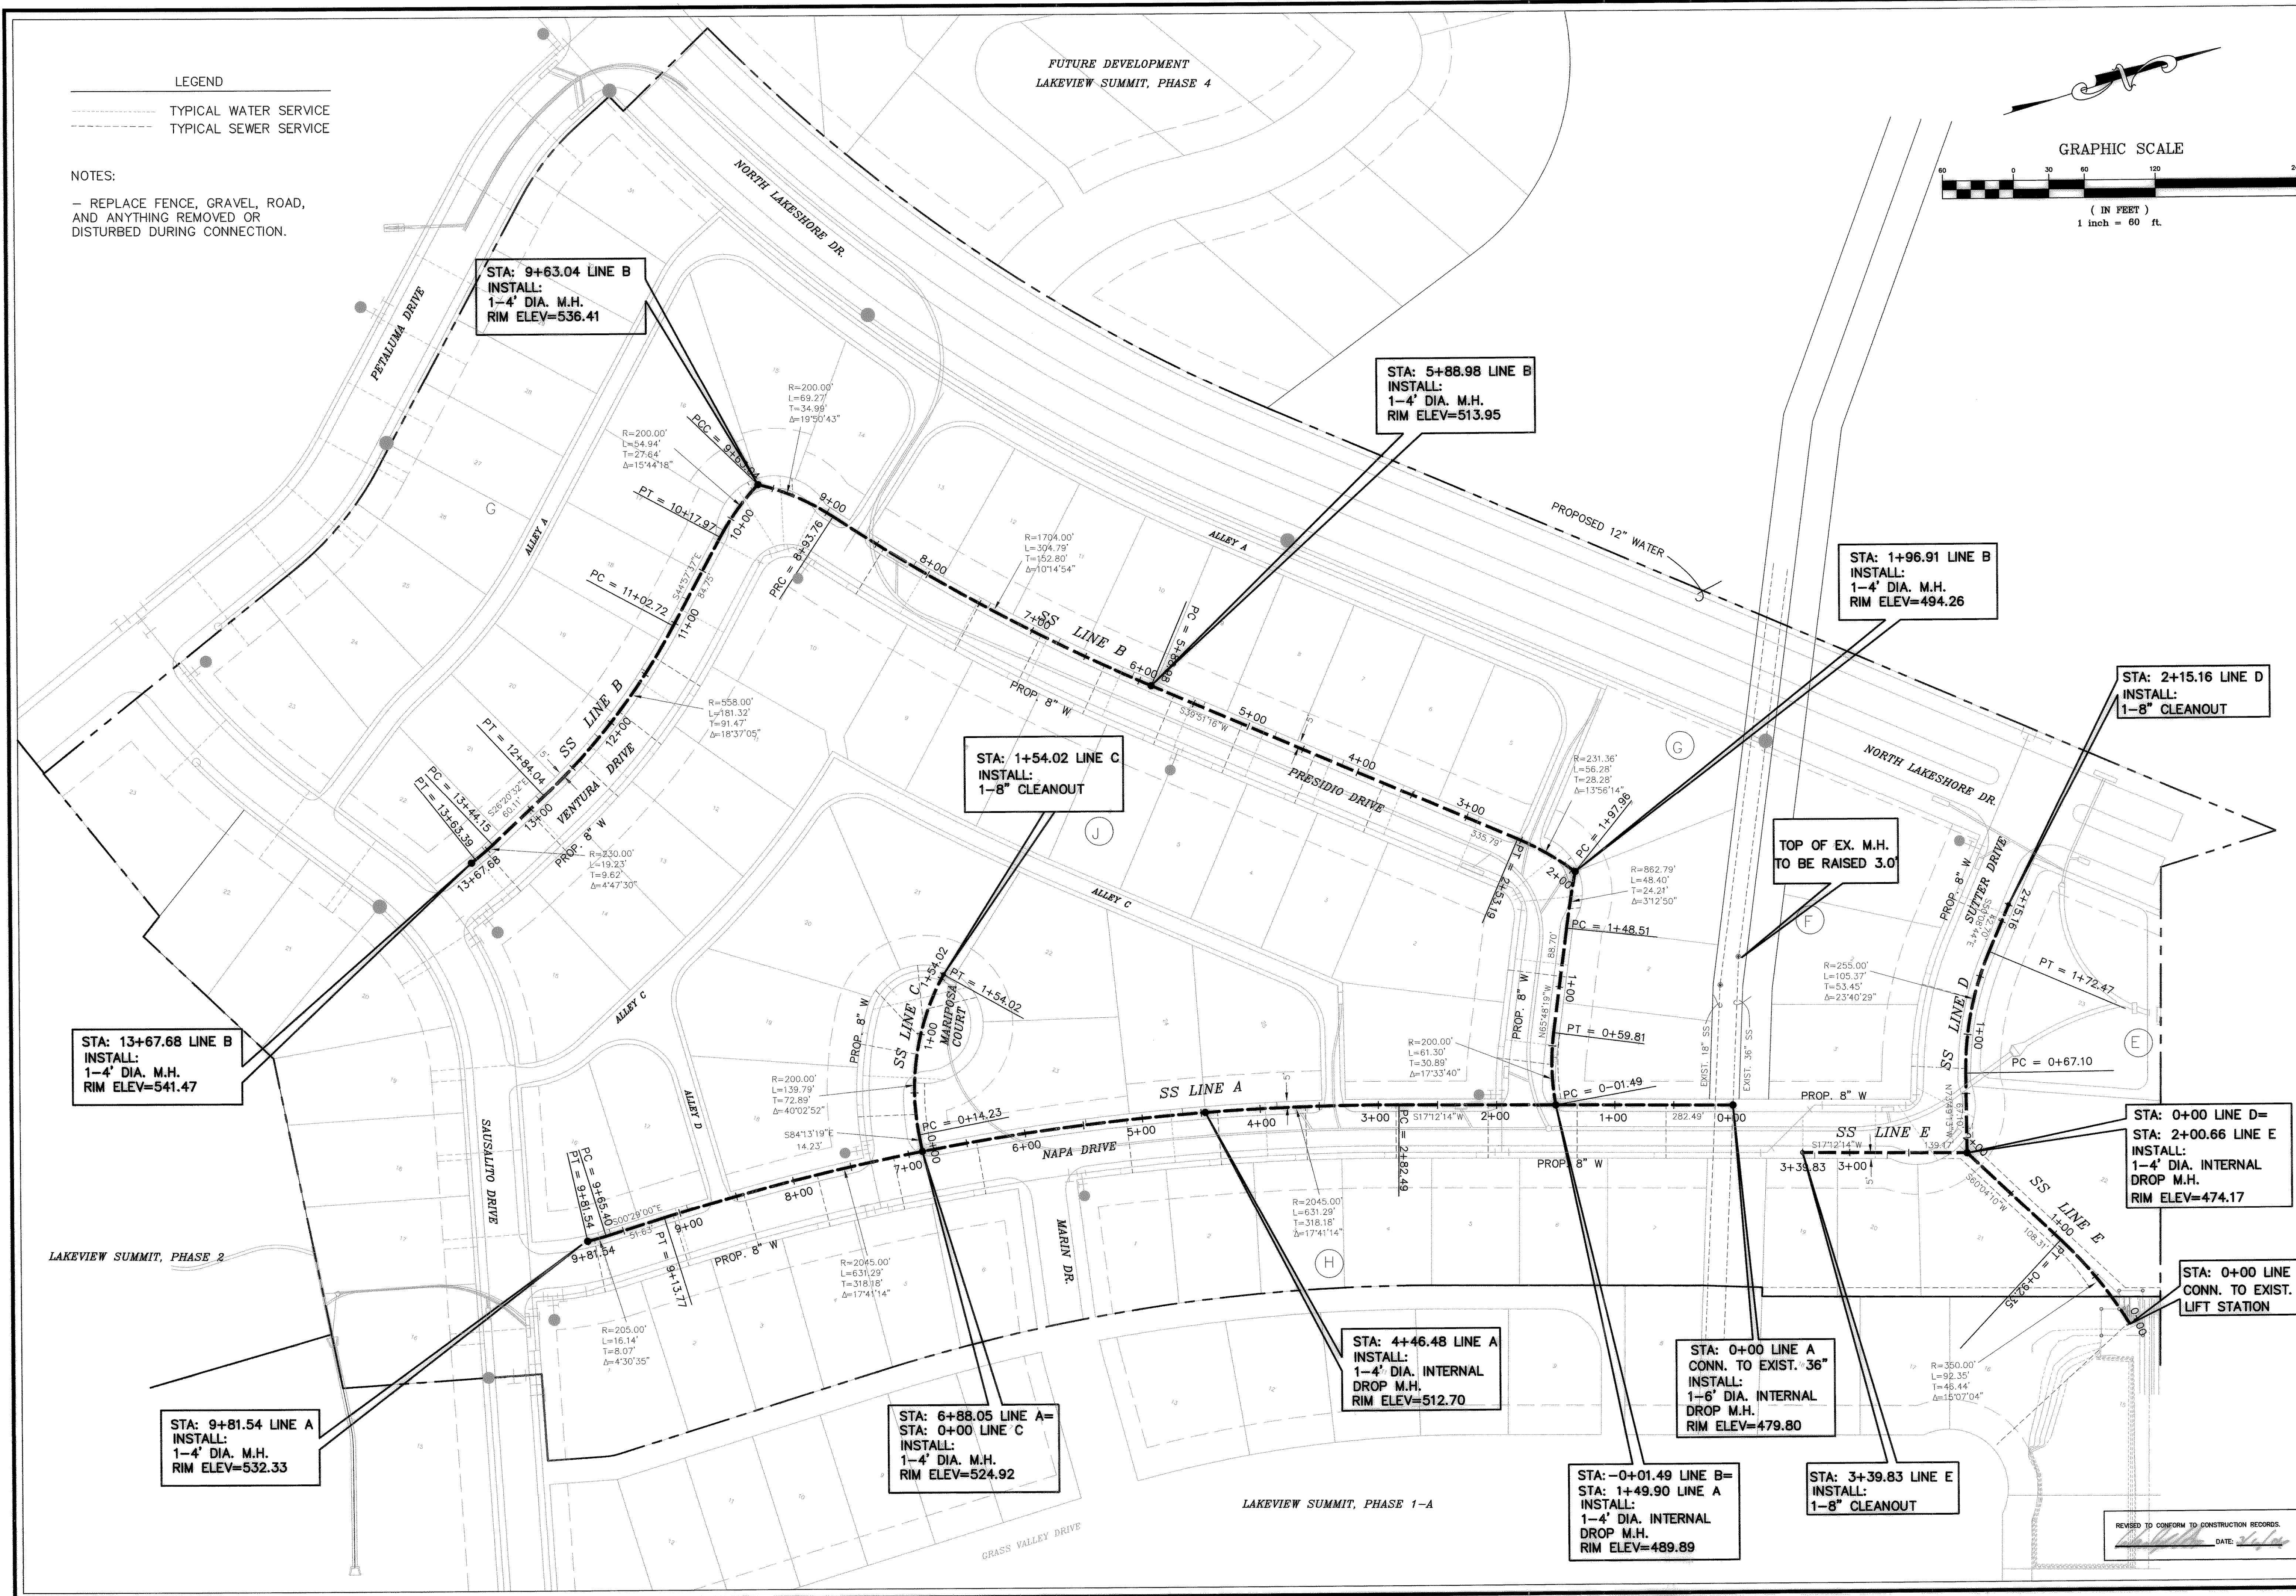

STA: 13+67.68 LINE B
 INSTALL:
 1-4" DIA. M.H.
 RIM ELEV=541.47

STA: 9+81.54 LINE A
 INSTALL:
 1-4" DIA. M.H.
 RIM ELEV=532.33

STA: 9+63.04 LINE B
 INSTALL:
 1-4" DIA. M.H.
 RIM ELEV=536.41

STA: 1+54.02 LINE C
 INSTALL:
 1-8" CLEANOUT

STA: 6+88.05 LINE A=
 STA: 0+00 LINE C
 INSTALL:
 1-4" DIA. M.H.
 RIM ELEV=524.92

STA: 4+46.48 LINE A
 INSTALL:
 1-4" DIA. INTERNAL
 DROP M.H.
 RIM ELEV=512.70

STA: -0+01.49 LINE B=
 STA: 1+49.90 LINE A
 INSTALL:
 1-4" DIA. INTERNAL
 DROP M.H.
 RIM ELEV=489.89

STA: 3+39.83 LINE E
 INSTALL:
 1-8" CLEANOUT

STA: 5+88.98 LINE B
 INSTALL:
 1-4" DIA. M.H.
 RIM ELEV=513.95

STA: 1+96.91 LINE B
 INSTALL:
 1-4" DIA. M.H.
 RIM ELEV=494.26

STA: 2+15.16 LINE D
 INSTALL:
 1-8" CLEANOUT

TOP OF EX. M.H.
 TO BE RAISED 3.0'

STA: 0+00 LINE D=
 STA: 2+00.66 LINE E
 INSTALL:
 1-4" DIA. INTERNAL
 DROP M.H.
 RIM ELEV=474.17

STA: 0+00 LINE E
 CONN. TO EXIST.
 LIFT STATION

REVISED TO CONFORM TO CONSTRUCTION RECORDS.
 DATE: 10/02

LAKEVIEW SUMMIT, PHASE 1-A