
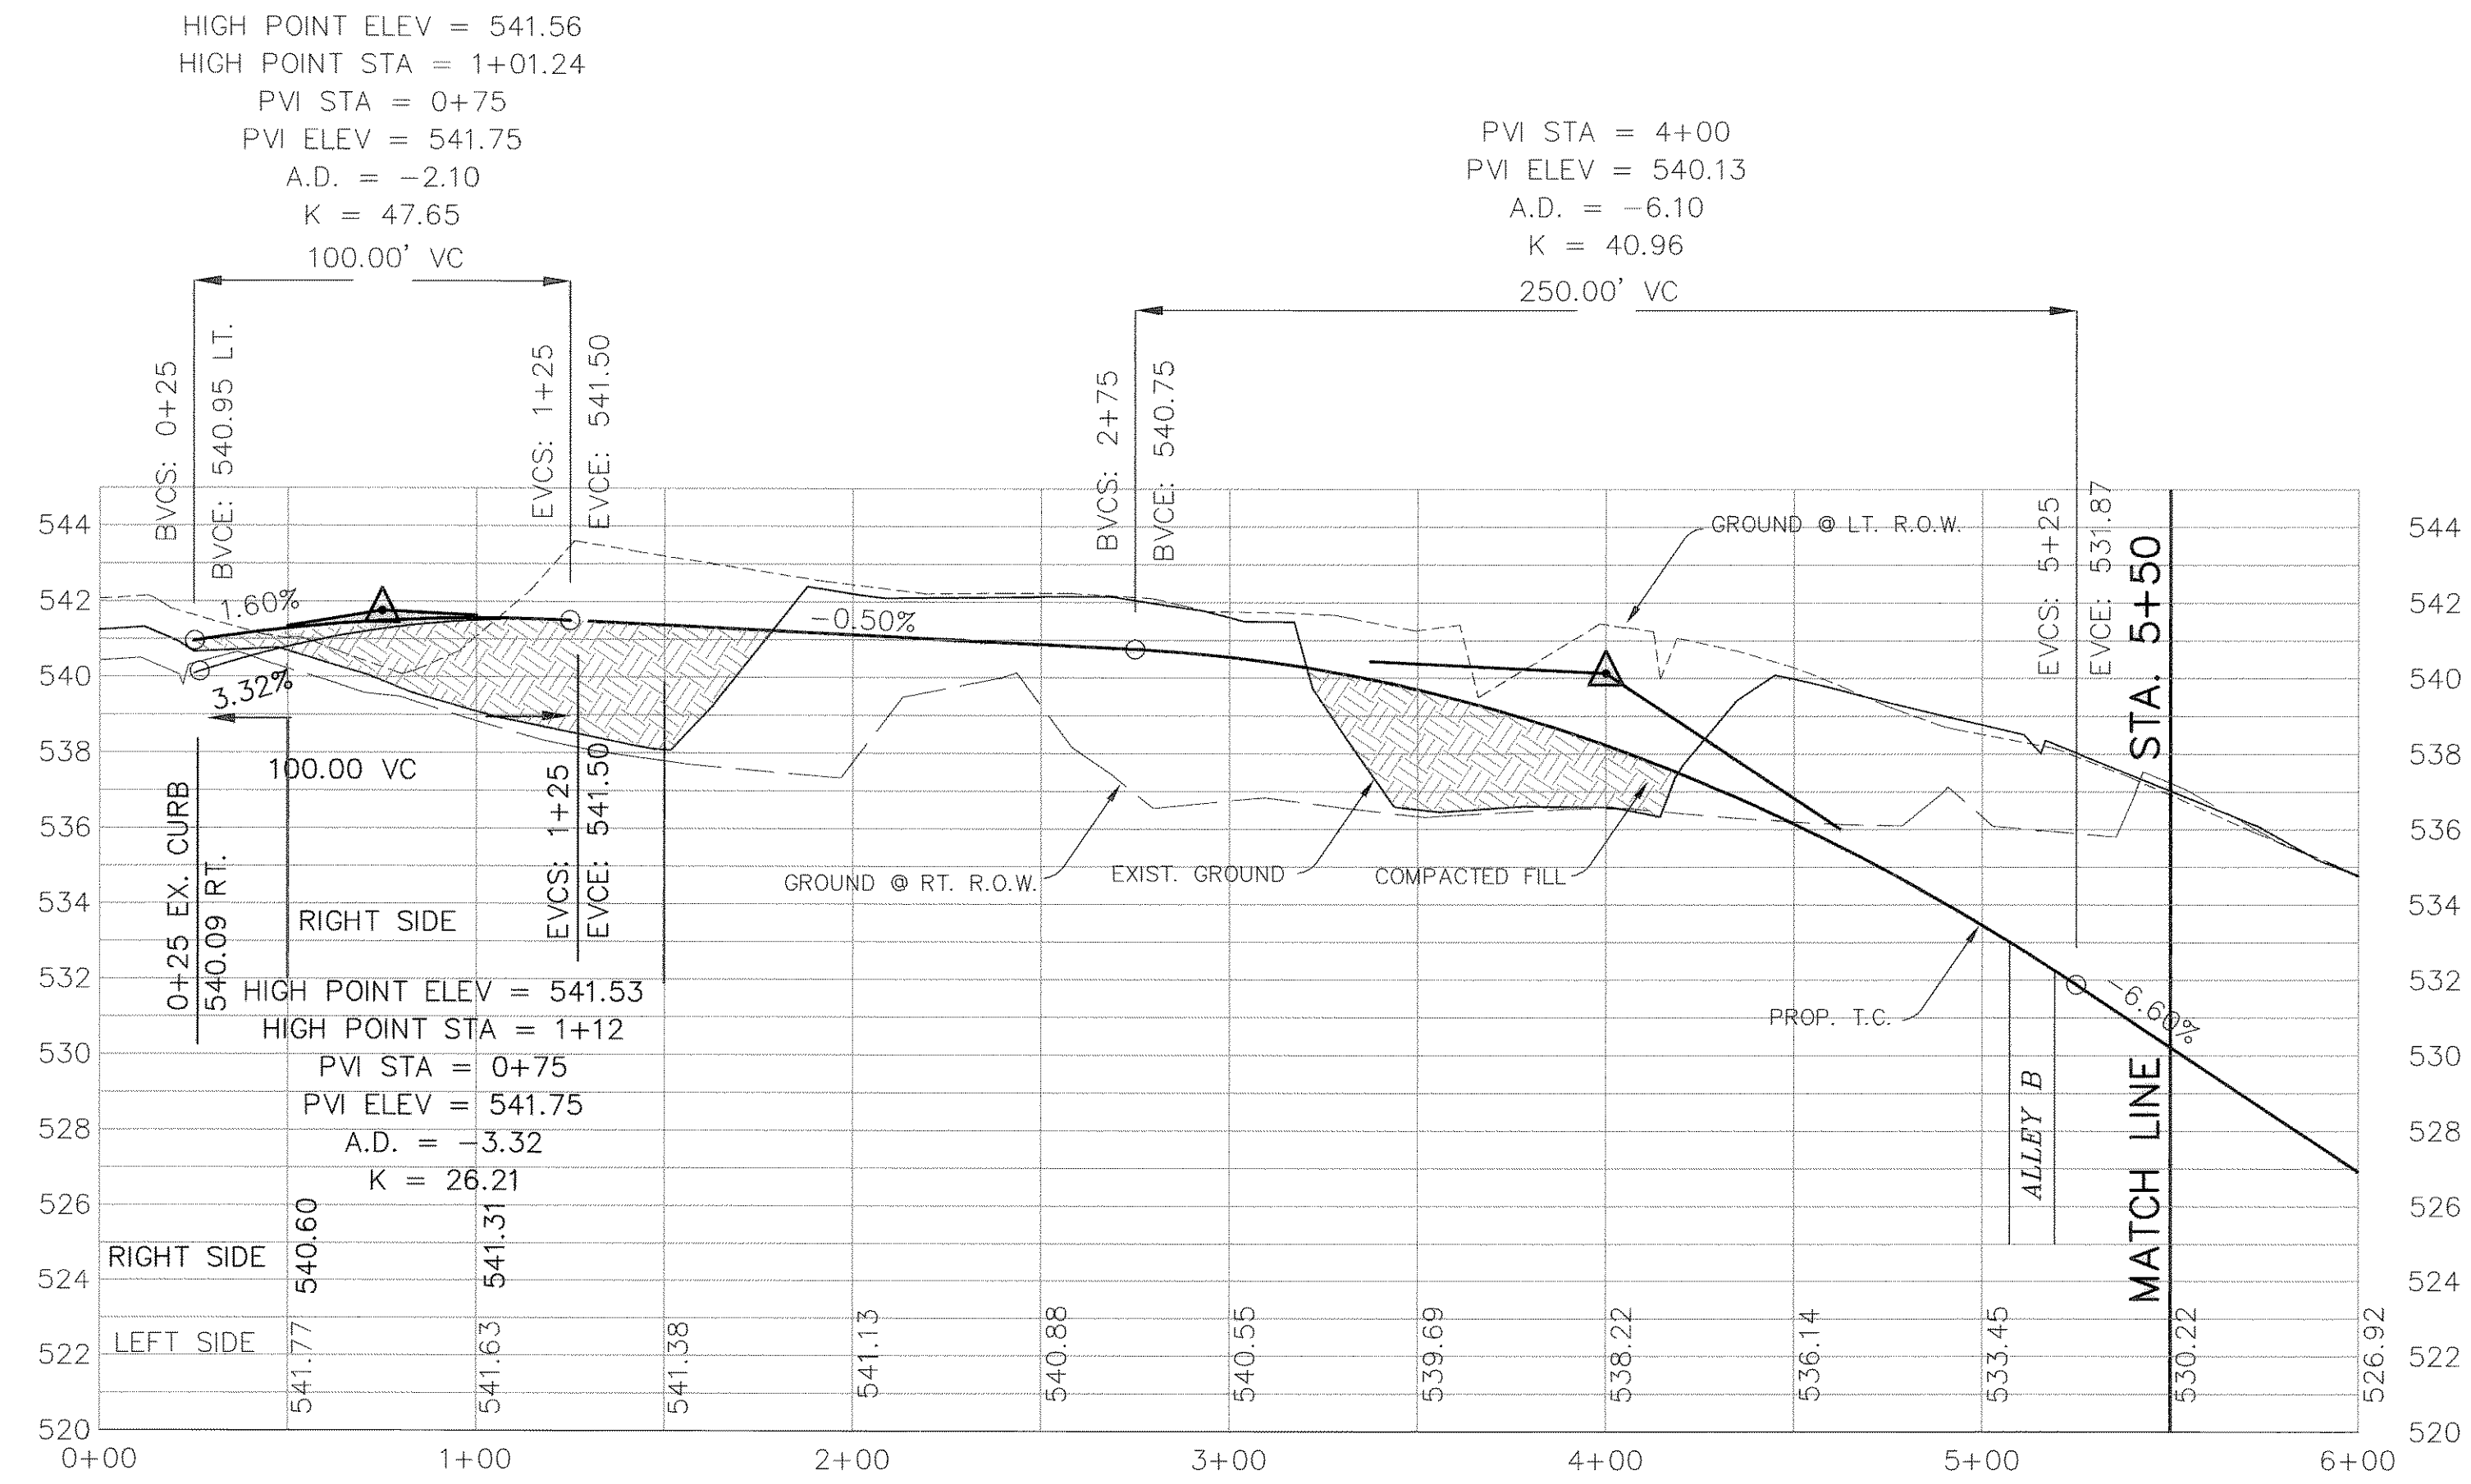
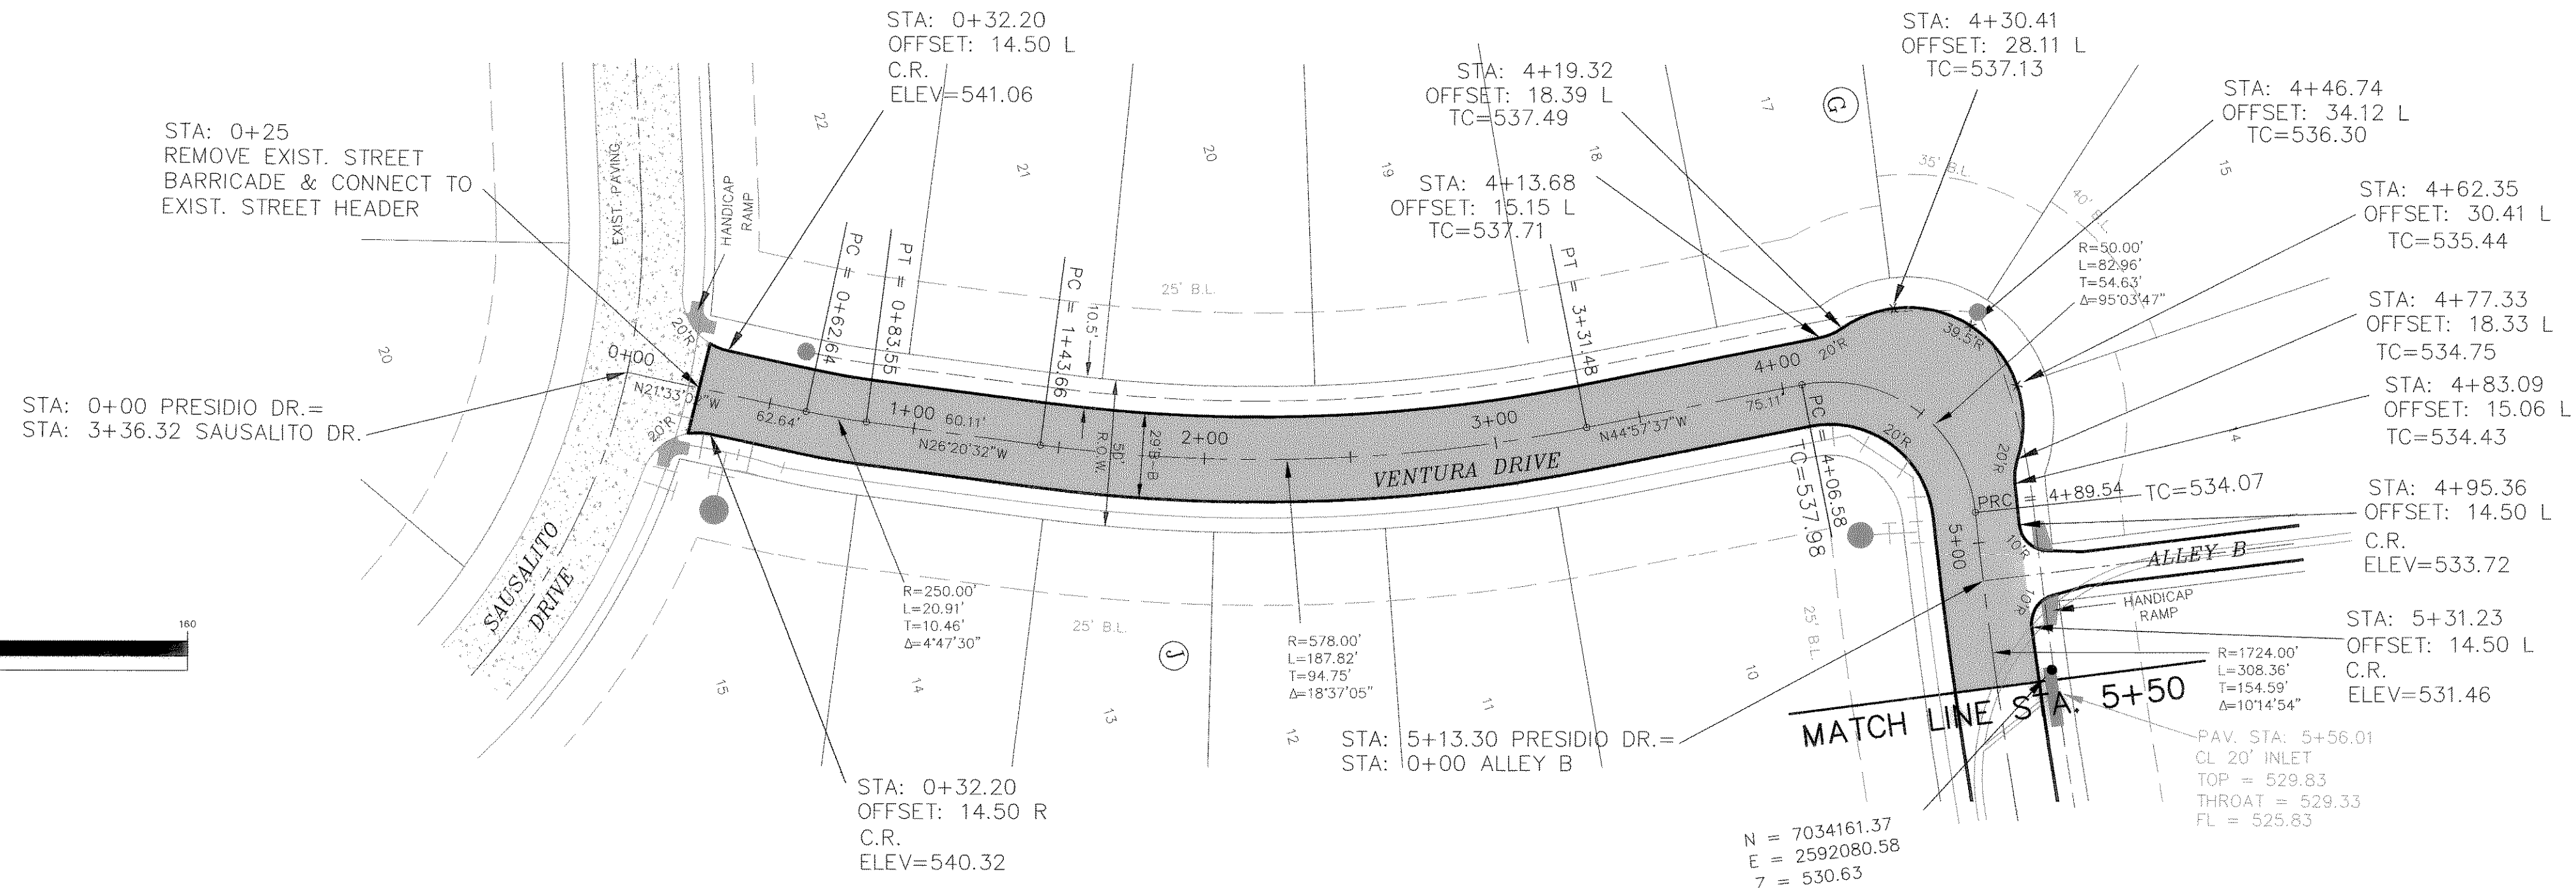


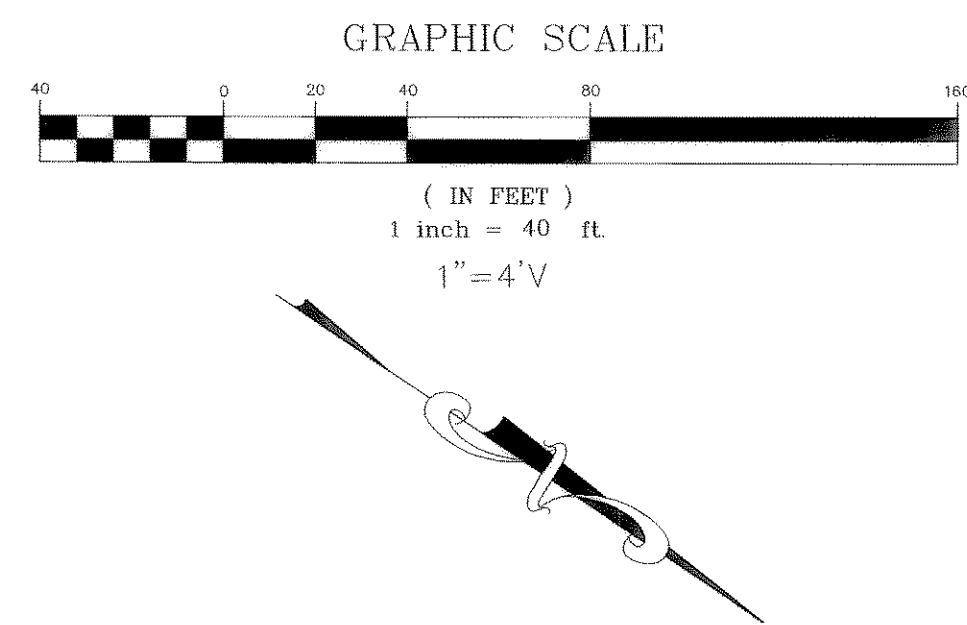

REVISED TO CONFORM TO CONSTRUCTION RECORDS.

[Signature] DATE: 2/22/04

THE SEAL APPEARING ON THIS DOCUMENT WAS AUTHORIZED BY THE BOARD OF ENGINEERS AND SURVEYORS OF THE STATE OF TEXAS, REGISTRATION NO. 60102 ON 4/27/06

DOUPHRE & ASSOCIATES, INC.

ENGINEERING - PROJECT MANAGEMENT - SURVEYING

2235 RIDGE RD., # 200 ROCKWALL, TEXAS 75087

PHONE: (972) 771-9004 FAX: (972) 771-9005

PAVING PLAN & PROFILE

VENTURA DRIVE STA: 0+00 TO 5+50

LAKEVIEW SUMMIT, PHASE 3

CITY OF ROCKWALL, ROCKWALL COUNTY, TEXAS

REVISION
W.L.D.
CHECKED
K.E.B.
DRAWN
10/02
DATE
9919-3PV4
PROJECT
12
OF
33