


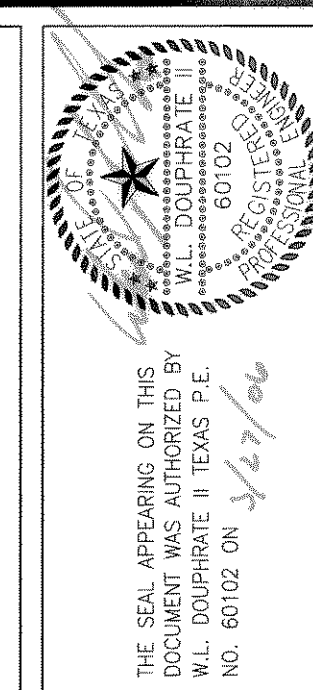

DOUPHRADE & ASSOCIATES, INC.
ENGINEERING - PROJECT MANAGEMENT - SURVEYING
2235 RIDGE RD., # 200 ROCKWALL, TEXAS 75087
PHONE: (972) 771-9004 FAX: (972) 771-9005

PAVING PLAN & PROFILE
PRESIDIO DRIVE STA: 5+50 TO 13+73.03
LAKEVIEW SUMMIT, PHASE 3
CITY OF ROCKWALL, ROCKWALL COUNTY, TEXAS

REVISION
W.L.D.
CHECKED
KEB
DRAWN
10/02
DATE
9919-3PV5
PROJECT
13 OF 33

REVISED TO CONFORM TO CONSTRUCTION RECORDS.
[Signature] DATE: 3/23/04

