

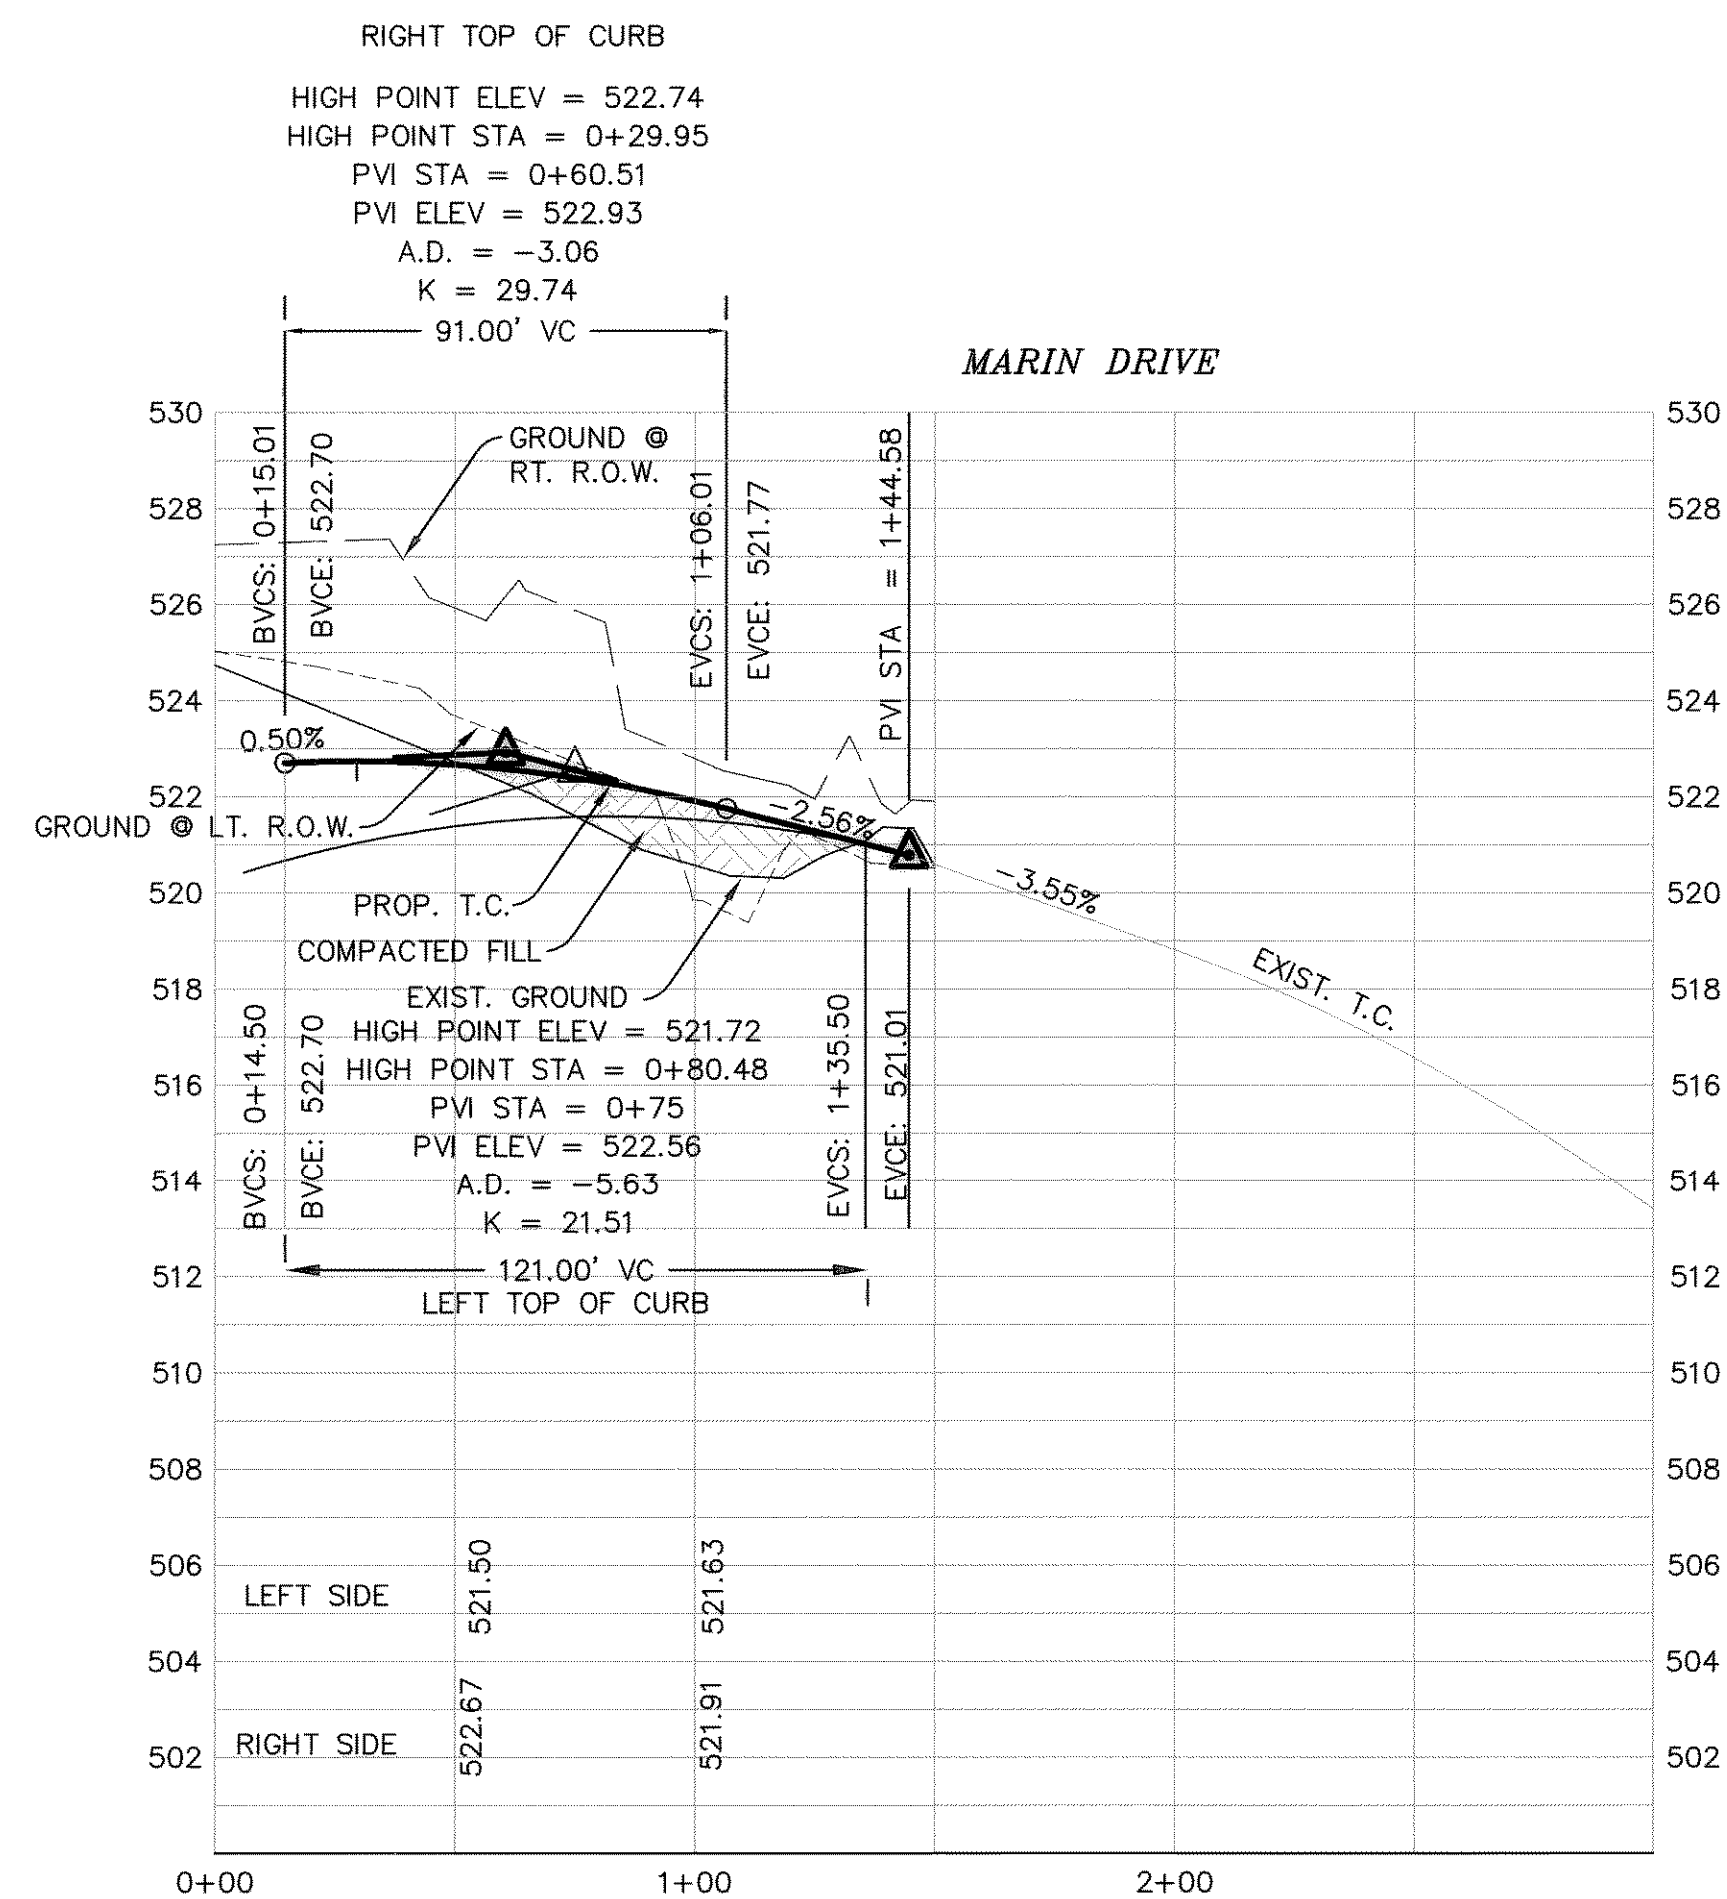
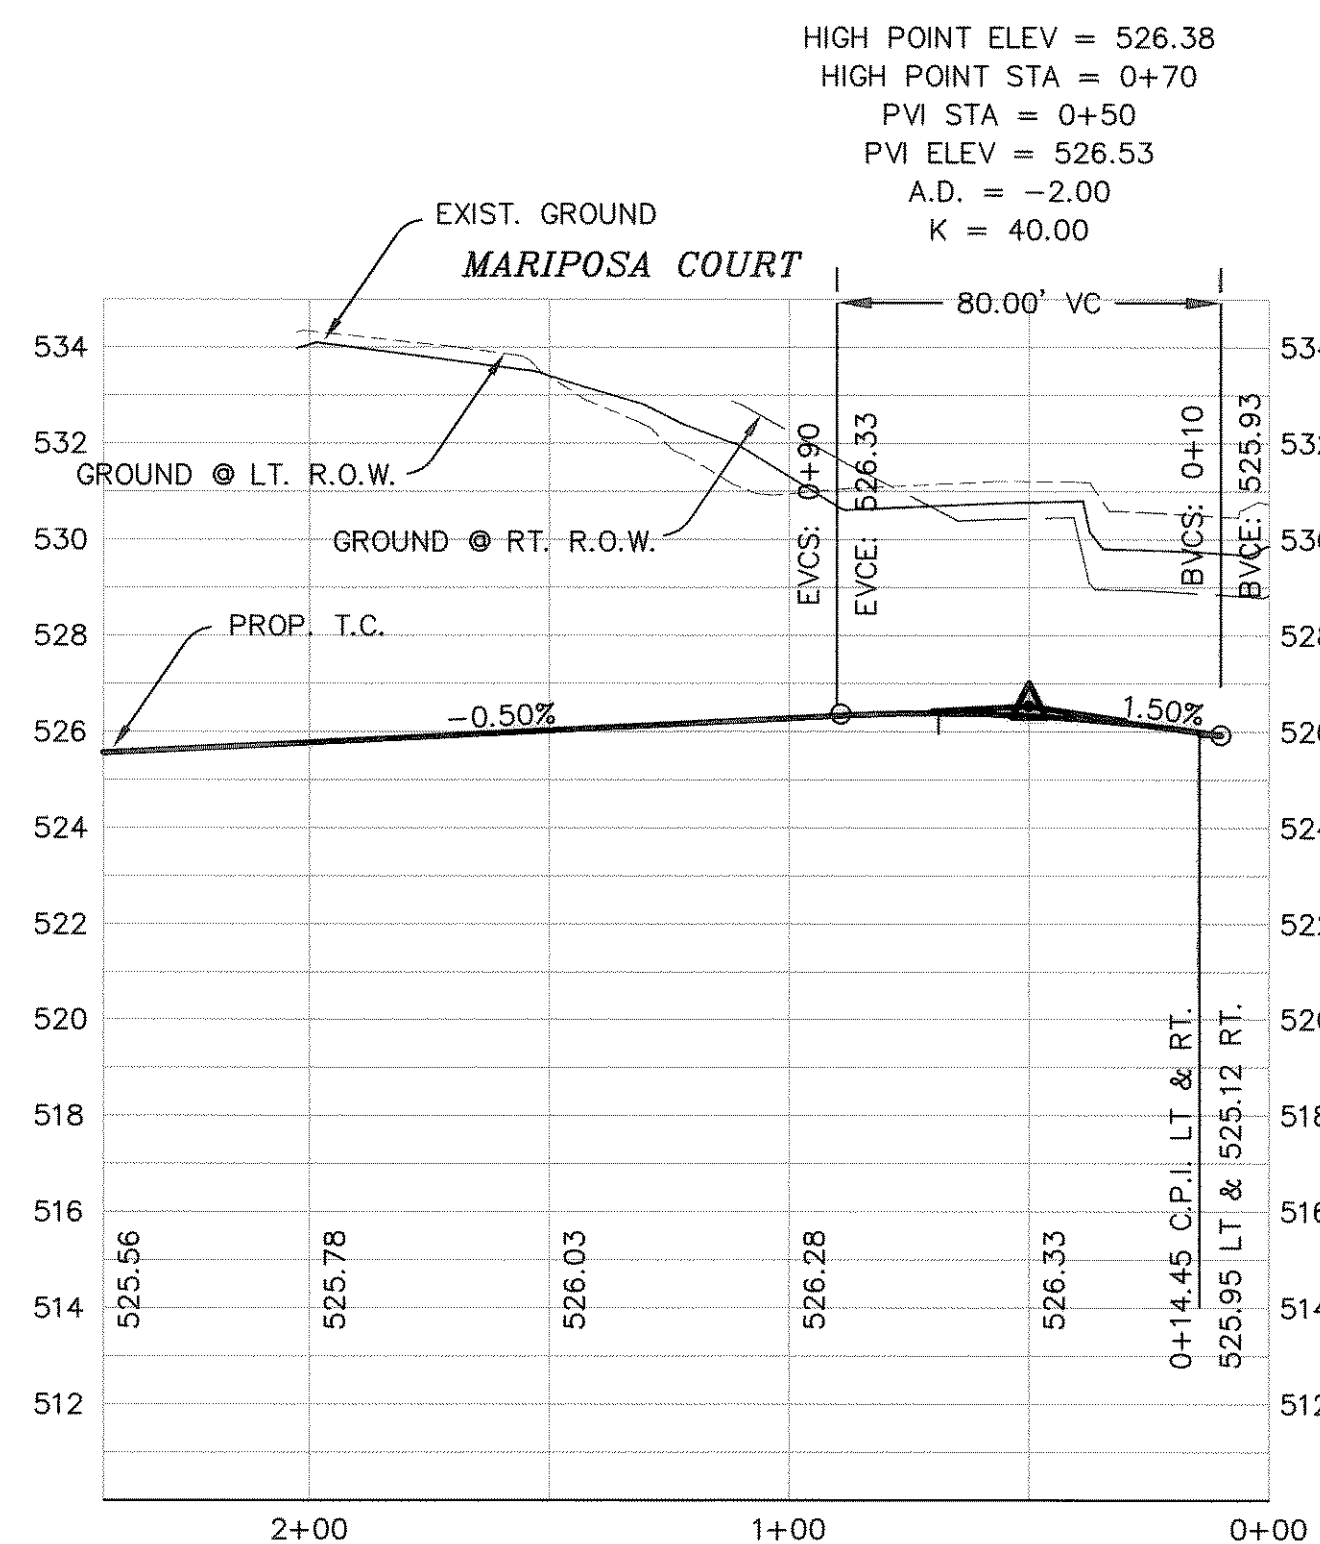
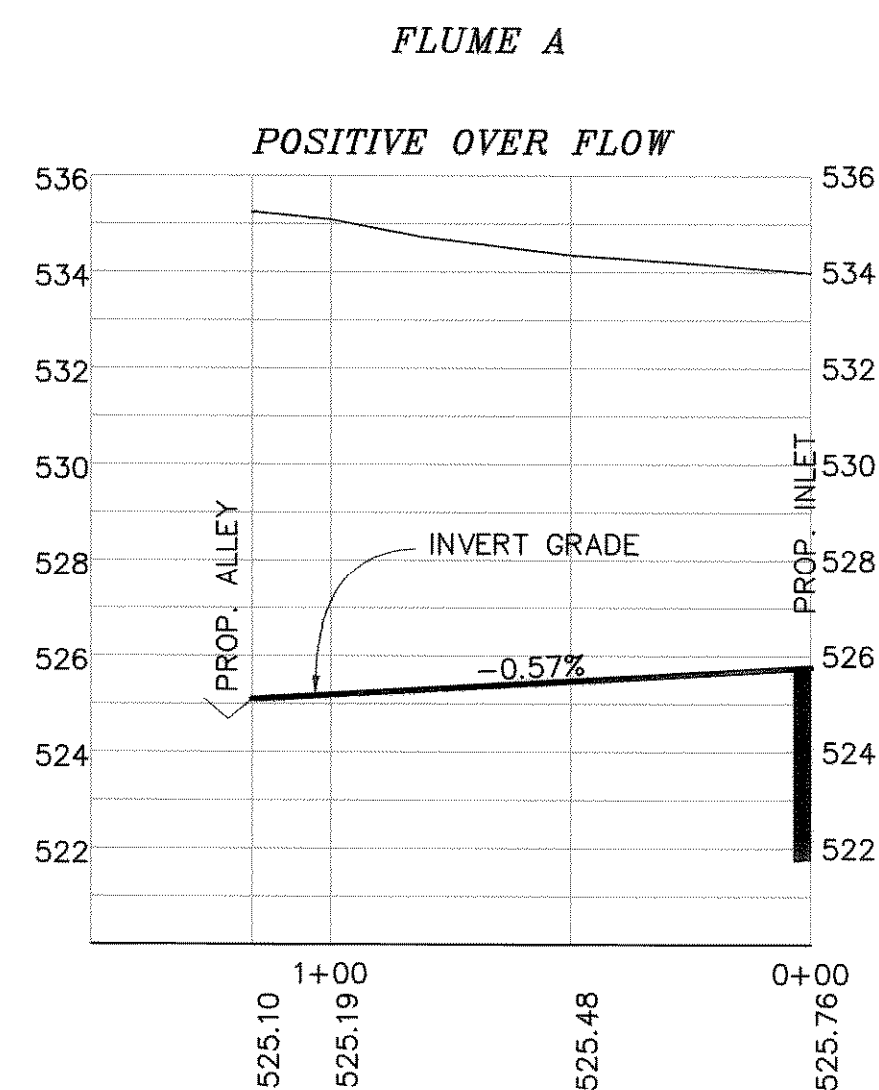
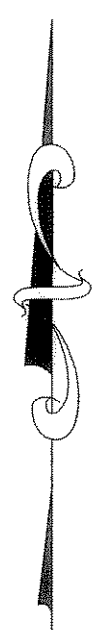
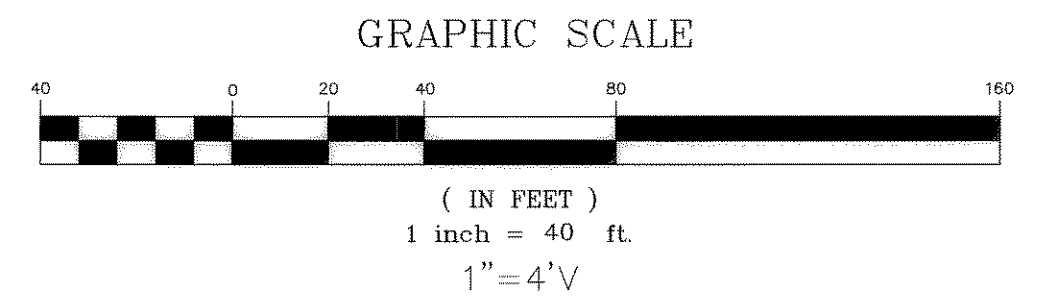


CURBED OVER FLOW FLUME

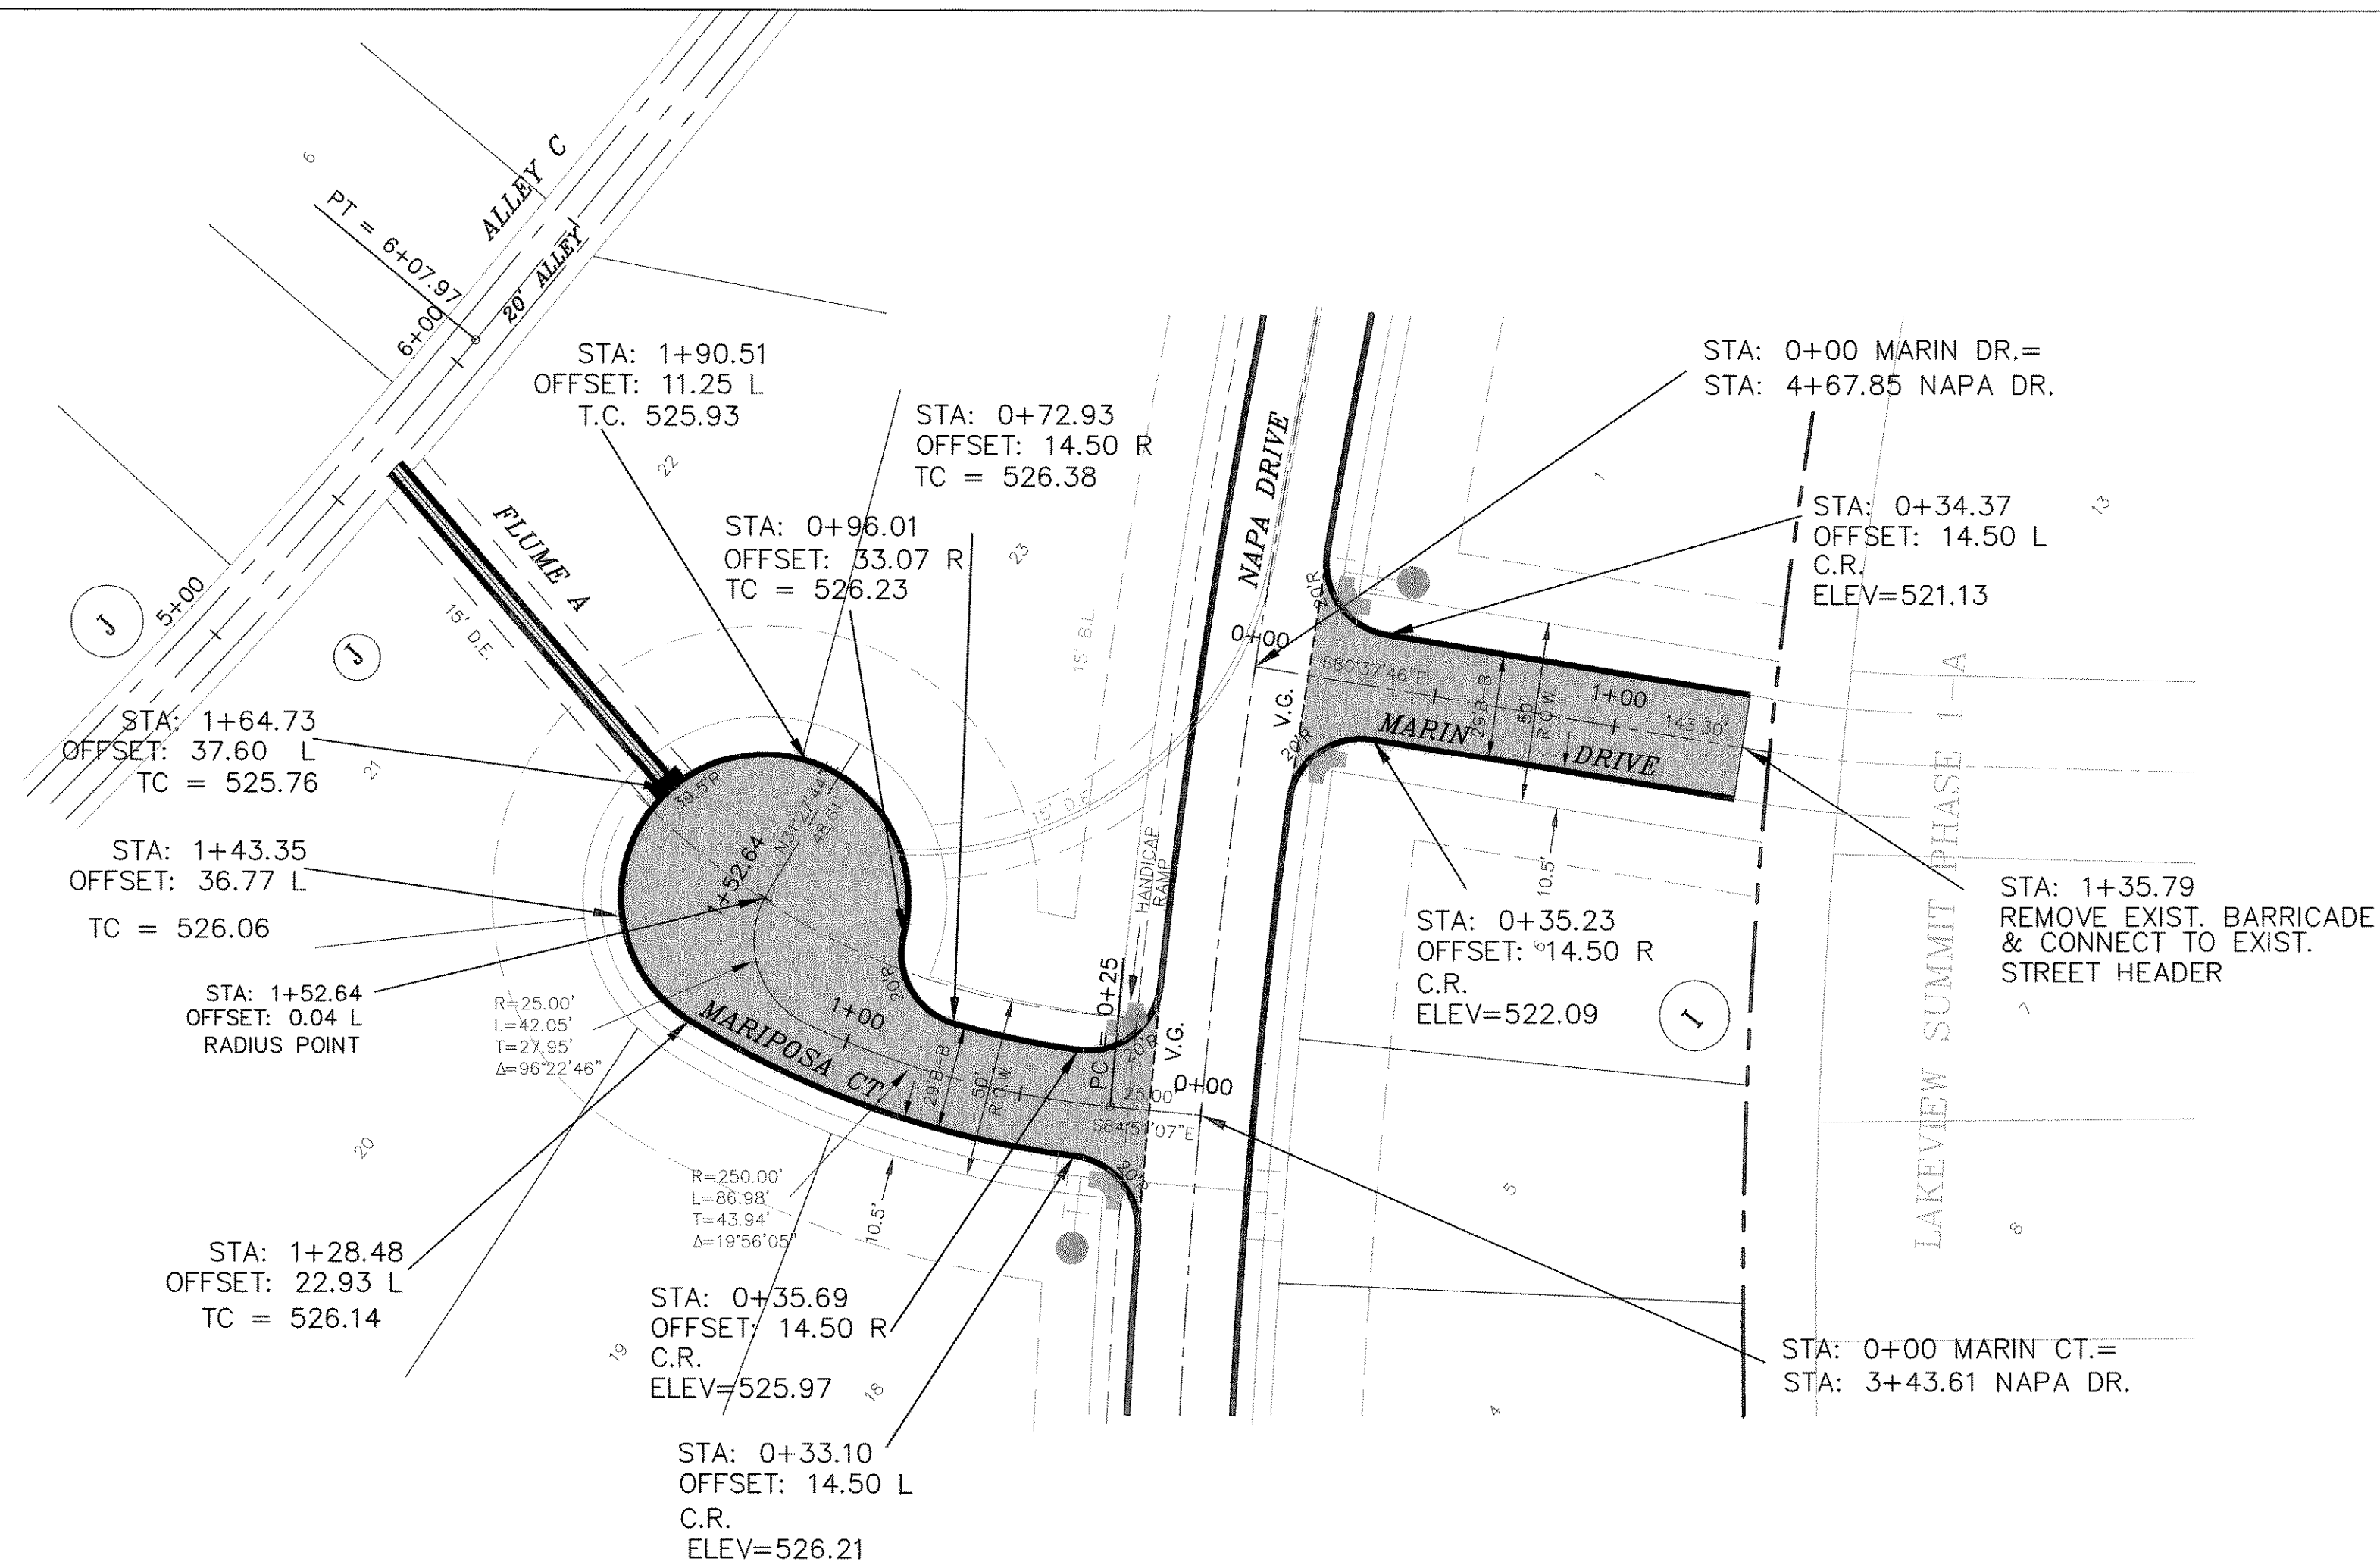

REVISED TO CONFORM TO CONSTRUCTION RECORDS.

DATE: 7/6/04

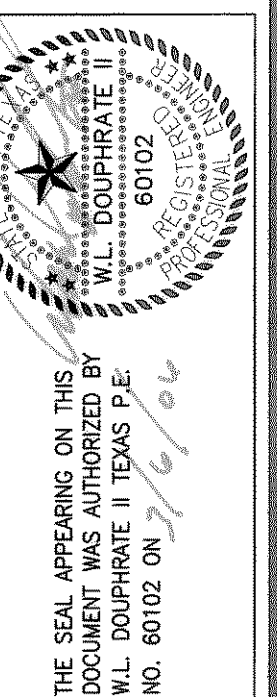

DOUPHRATE & ASSOCIATES, INC.
ENGINEERING - PROJECT MANAGEMENT - SURVEYING
2235 RIDGE RD., # 200 ROCKWALL, TEXAS 75087
PHONE: (972)771-9004 FAX: (972)771-9005

PAVING PLAN & PROFILE
MARIPOSA COURT & MARIN DRIVE
LAKEVIEW SUMMIT, PHASE 3
CITY OF ROCKWALL, ROCKWALL COUNTY, TEXAS

REVISION
W.L.D.
CHECKED
K.E.B.
DRAWN
10/02
DATE
9919-3PV6
PROJECT