

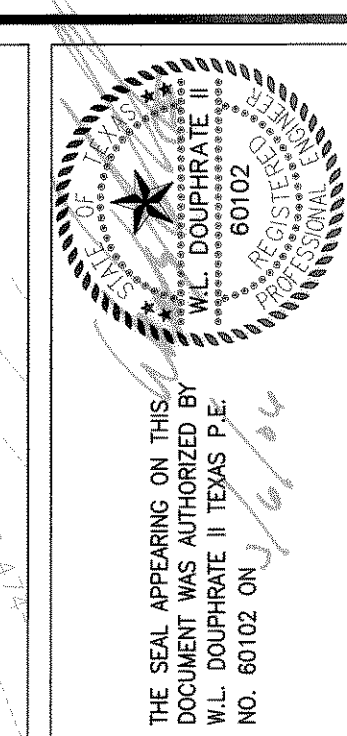


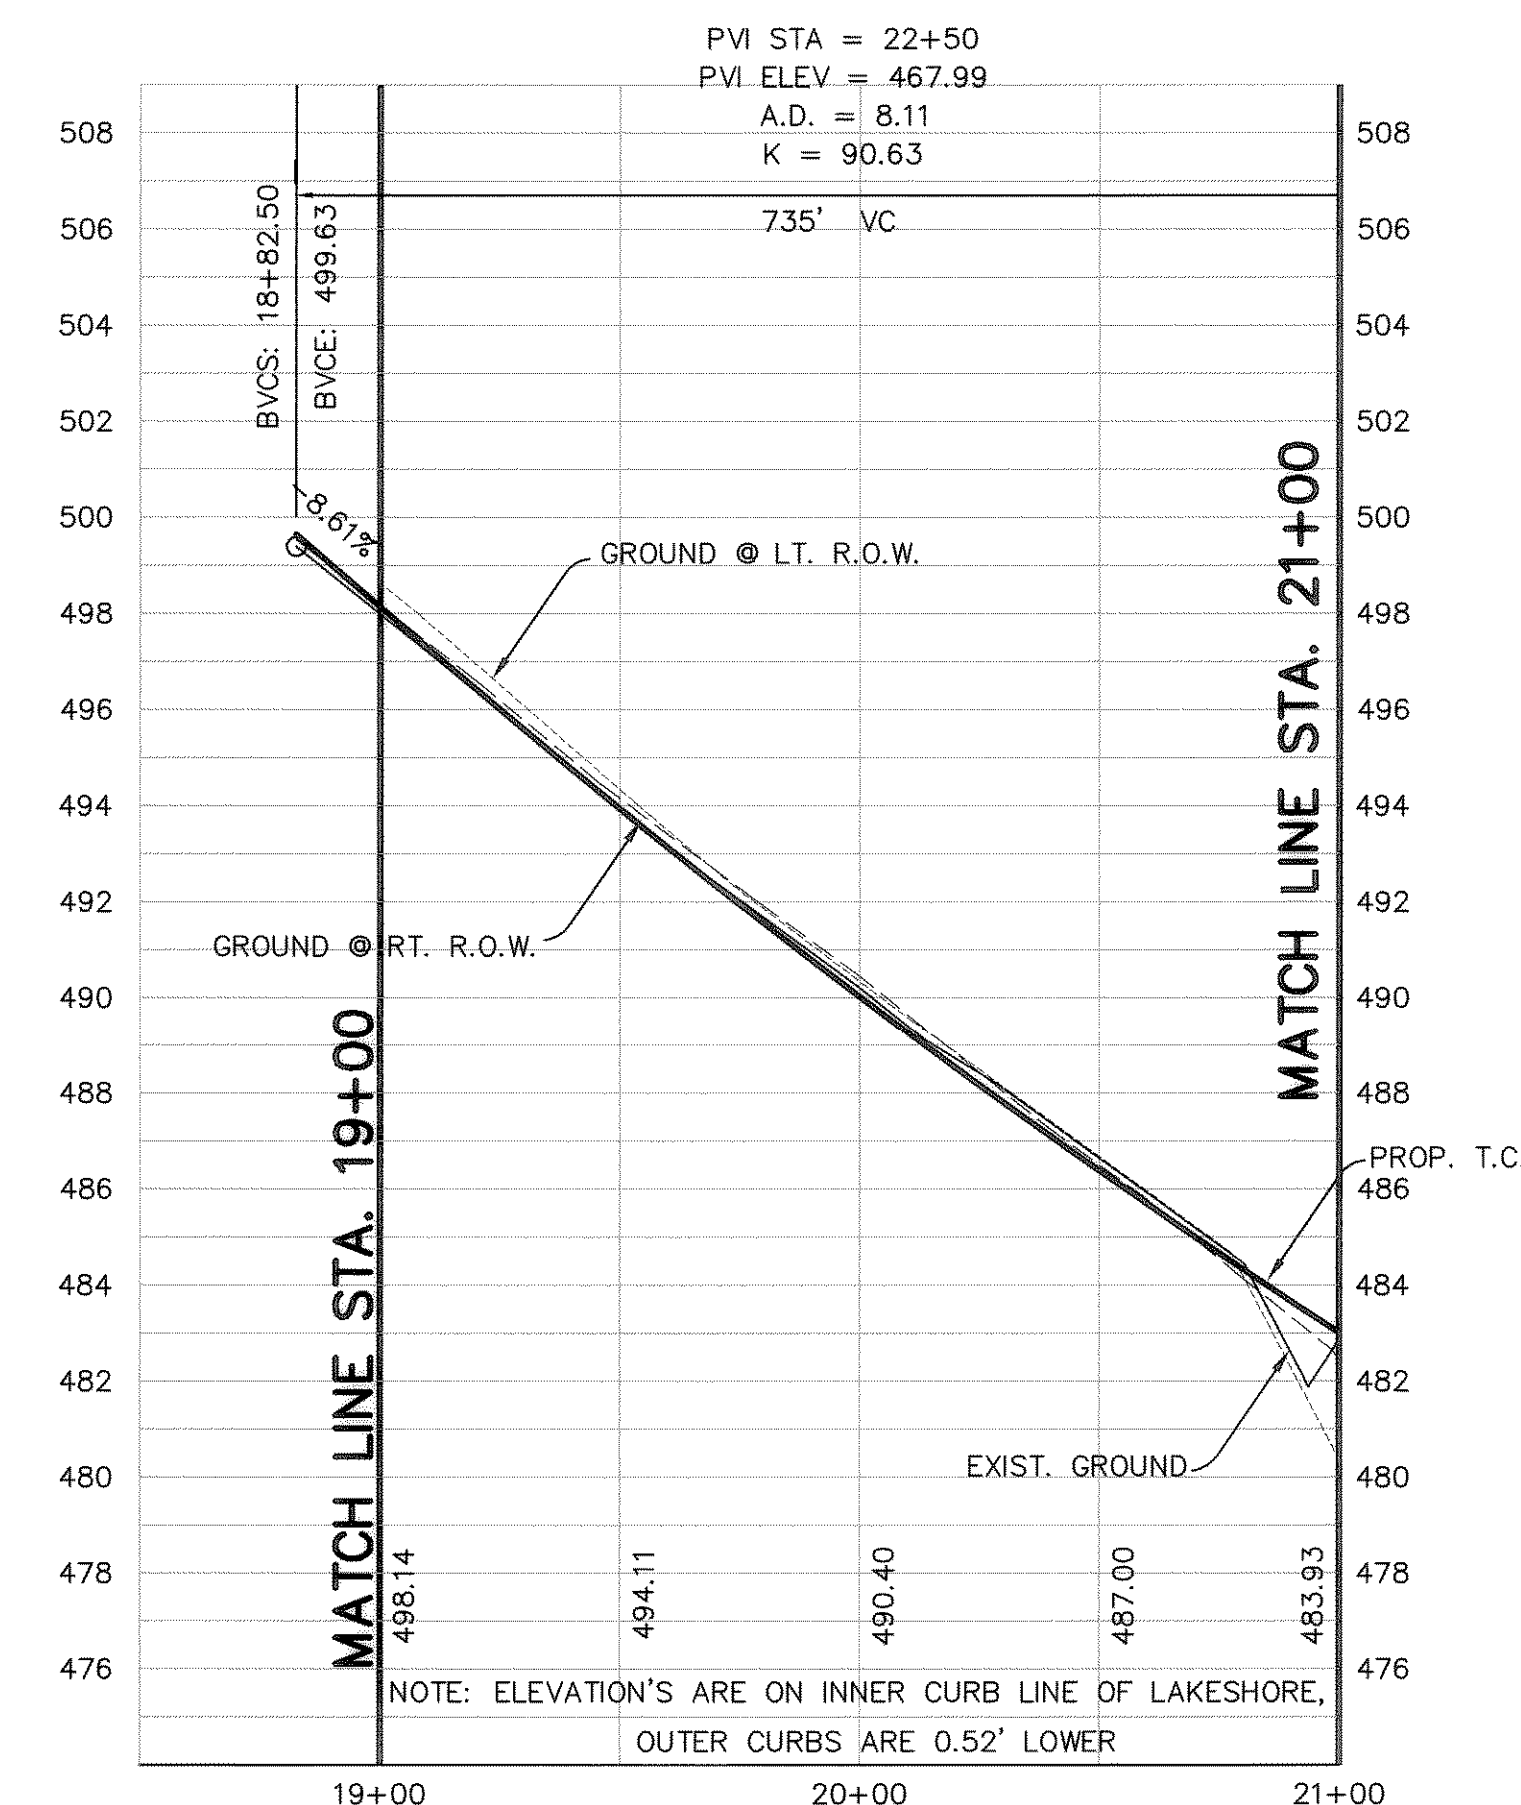

COUPHRADE  **& ASSOCIATES, INC.**
ENGINEERING • PROJECT MANAGEMENT • SURVEYING
2335 RIDGE RD., # 200 ROCKWALL, TEXAS 75087
PHONE: (972)771-9004 FAX: (972)771-9005

PAVING PLAN & PROFILE
N. LAKESHORE DRIVE STA: 10+64.56 TO 21+00
LAKEVIEW SUMMIT, PHASE 3
CITY OF ROCKWALL, ROCKWALL COUNTY, TEXAS

REVISION	
W.L.D.	
CHECKED	
K.E.B.	
DRAWN	
10/02	
DATE	
9919-3PV1	
PROJECT	
8	
OF	
33	

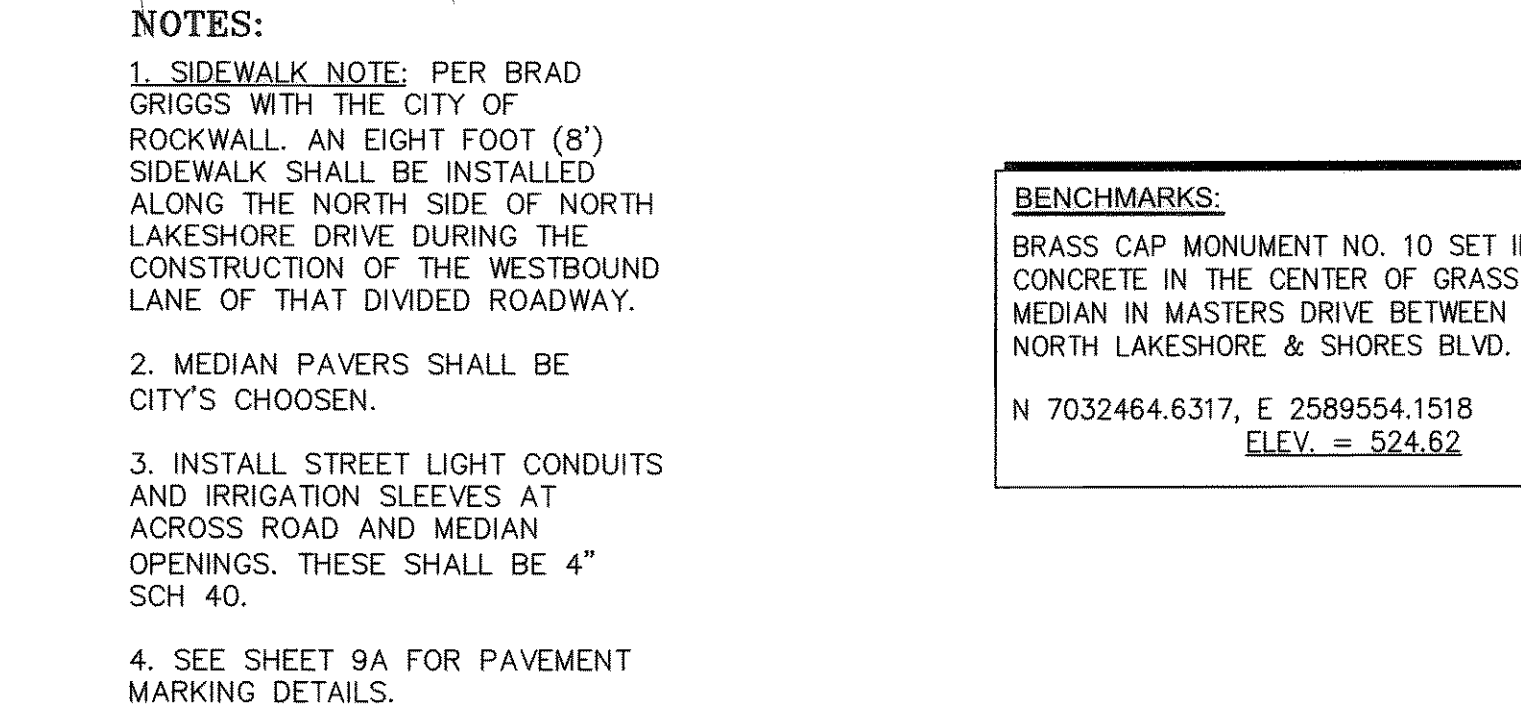

REVISED TO CONFORM TO CONSTRUCTION RECORDS.

W. J. [Signature] DATE: 7/6/04