

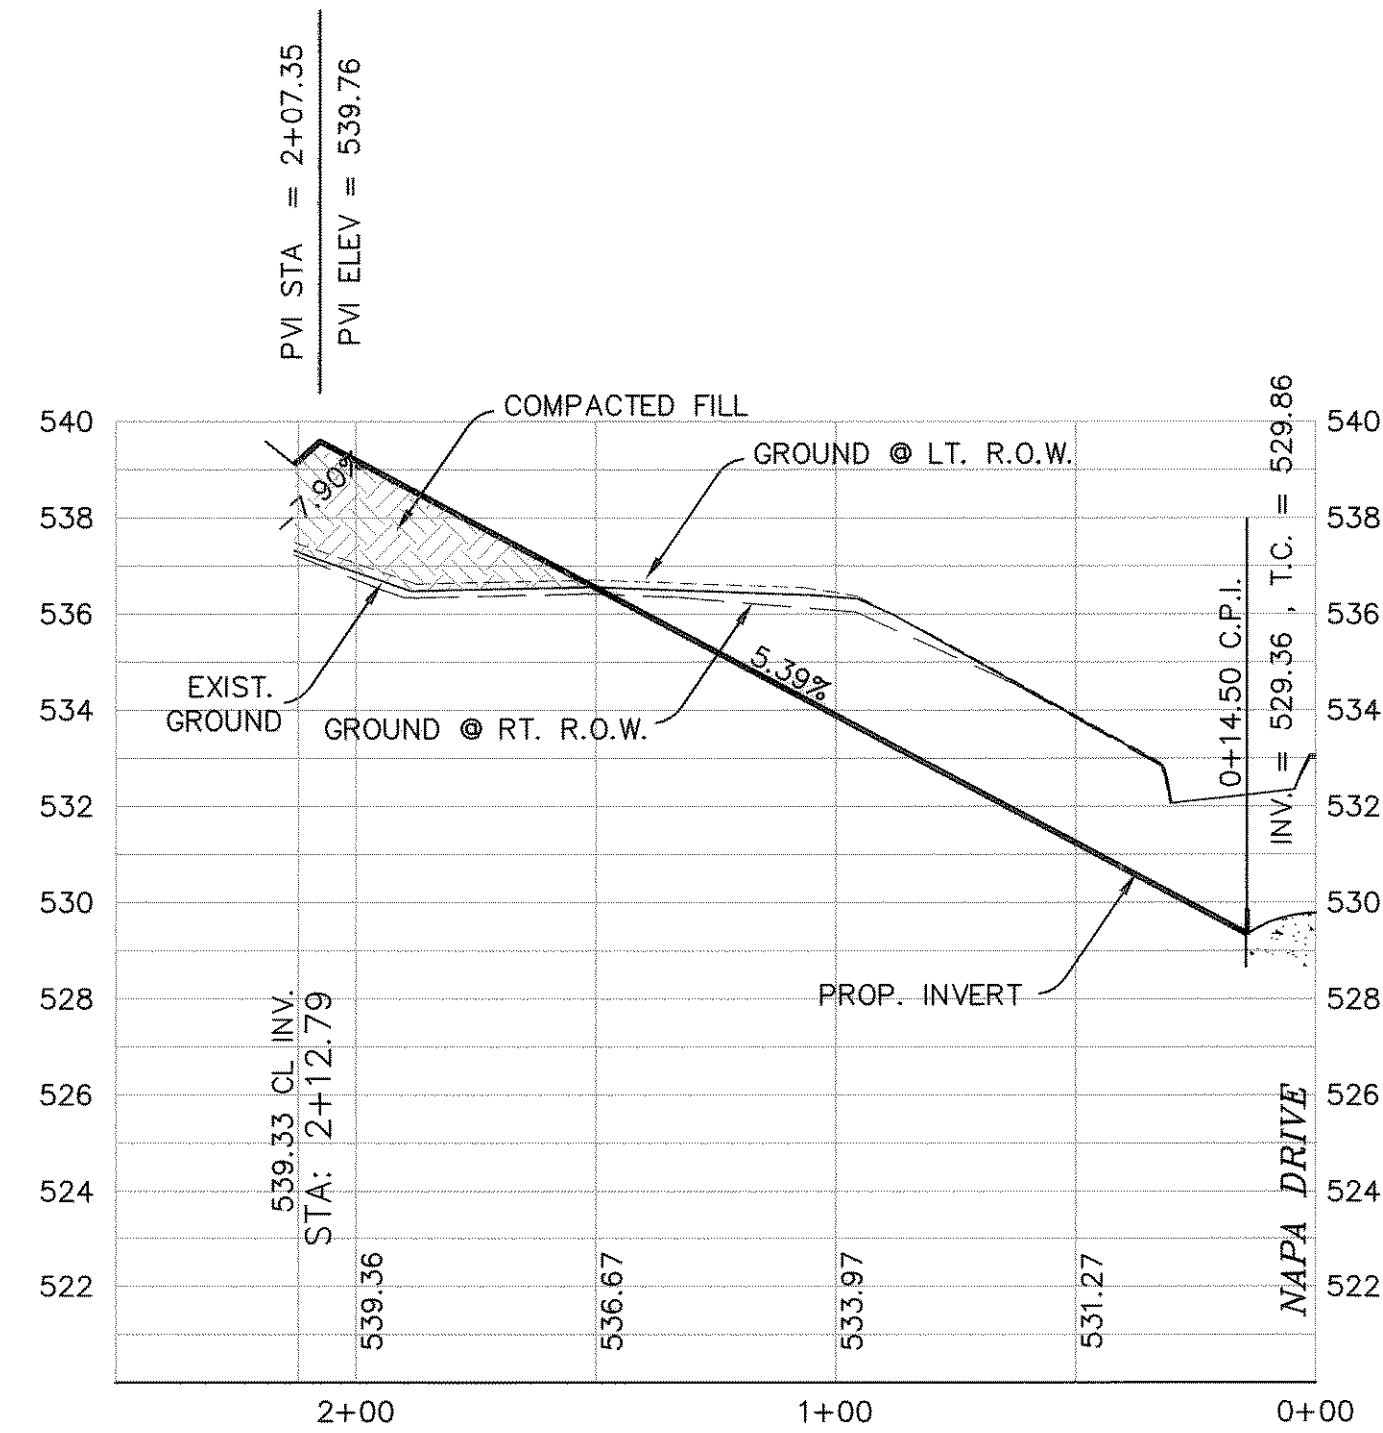
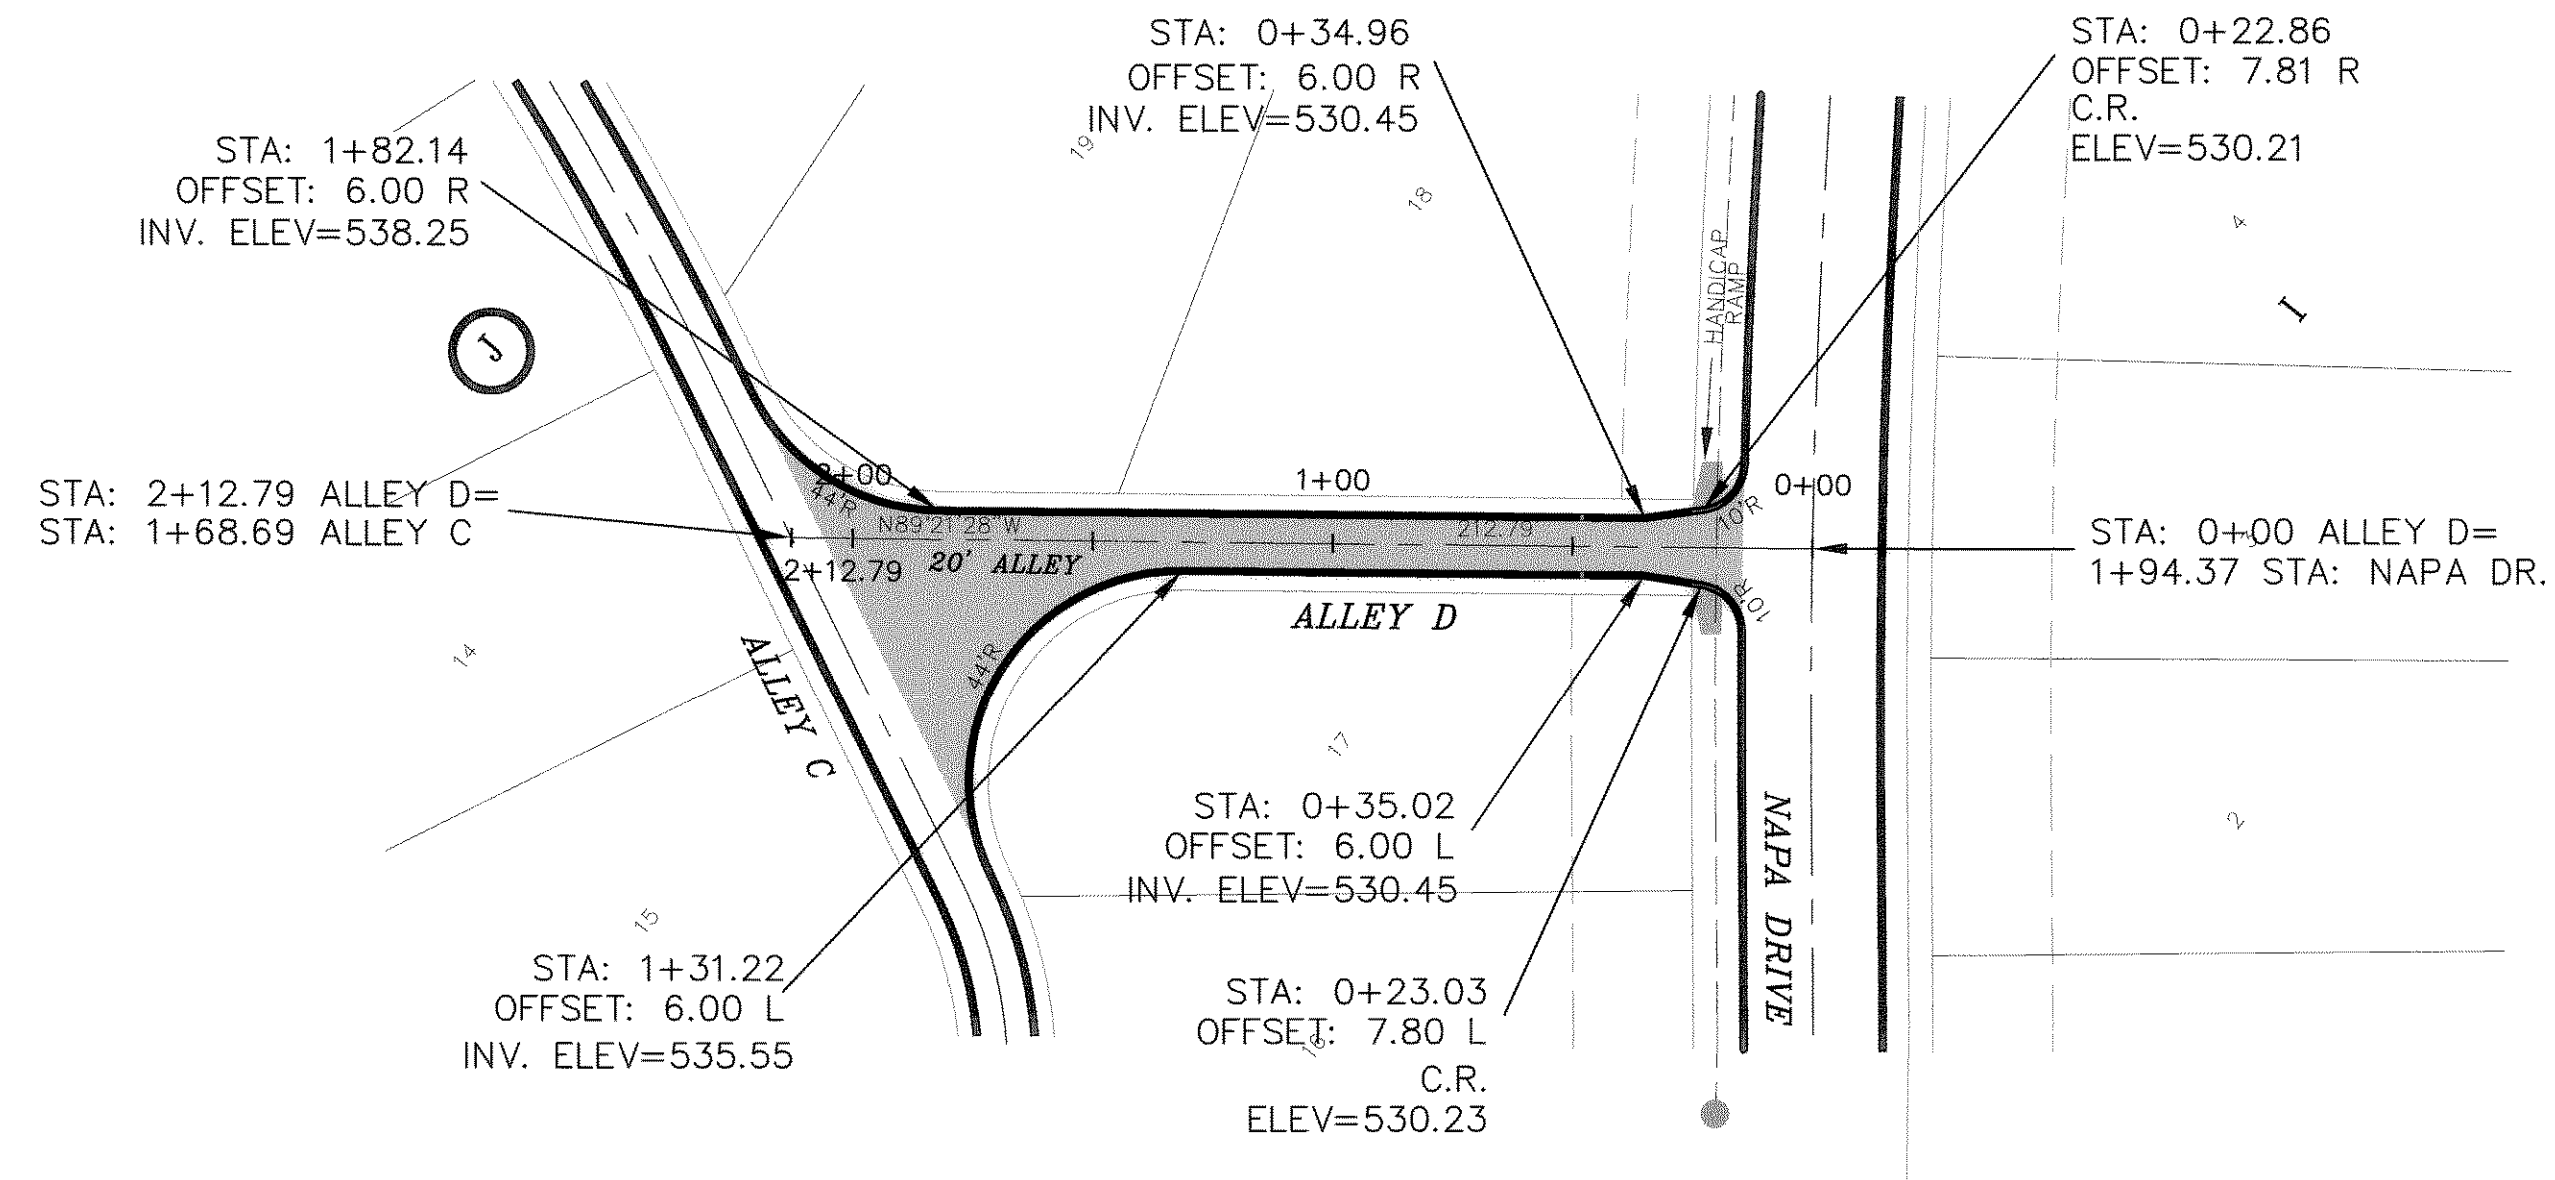


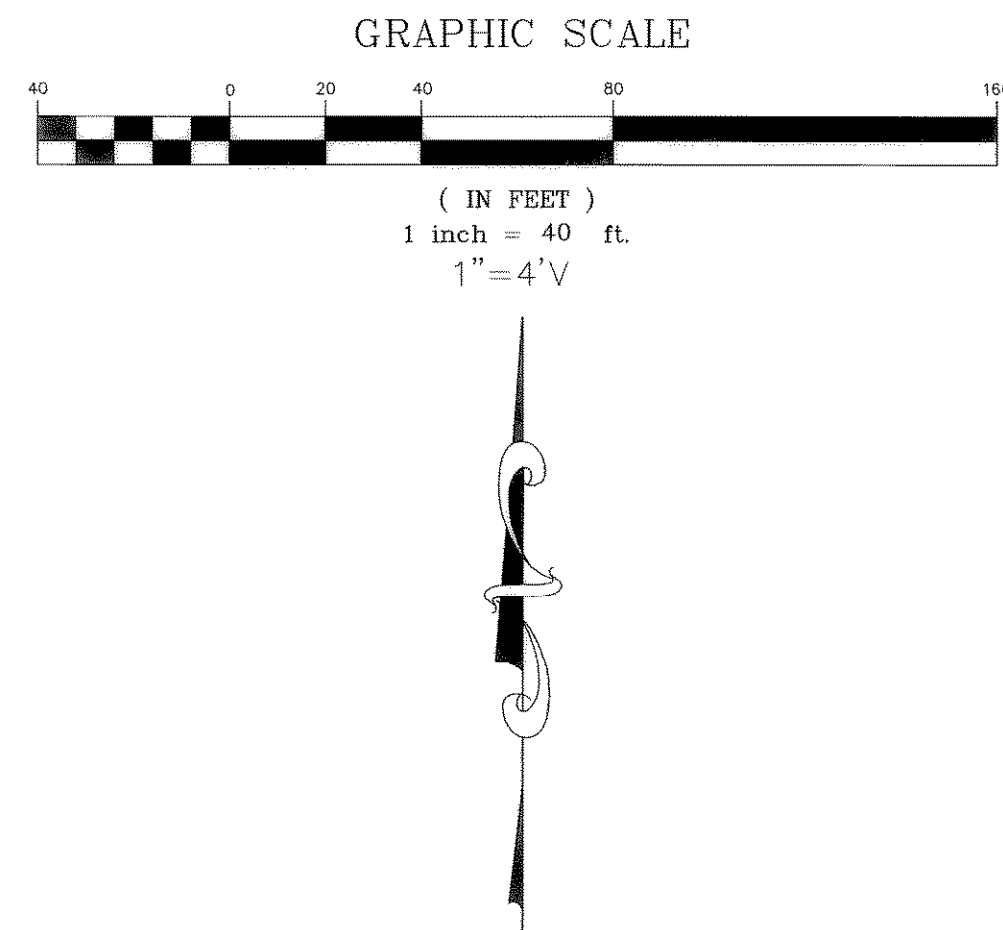

REVISED TO CONFORM TO CONSTRUCTION RECORDS.

[Signature] DATE: *2/6/04*

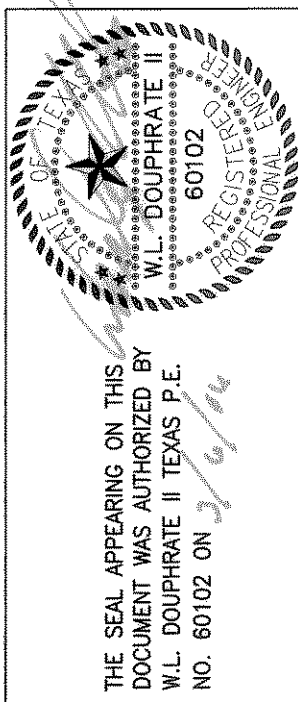

DOUPHRATE & ASSOCIATES, INC.

ENGINEERING - PROJECT MANAGEMENT - SURVEYING

2235 RIDGE RD., # 200 ROCKWALL, TEXAS 75087

PHONE: (972)771-9004 FAX: (972)771-9005

PAVING PLAN & PROFILE

ALLEY D

LAKEVIEW SUMMIT, PHASE 3

CITY OF ROCKWALL, ROCKWALL COUNTY, TEXAS

REVISION
W.L.D.
CHECKED
K.E.B.
DRAWN
10/02
DATE
9919-3PV11
PROJECT
19
OF
33