



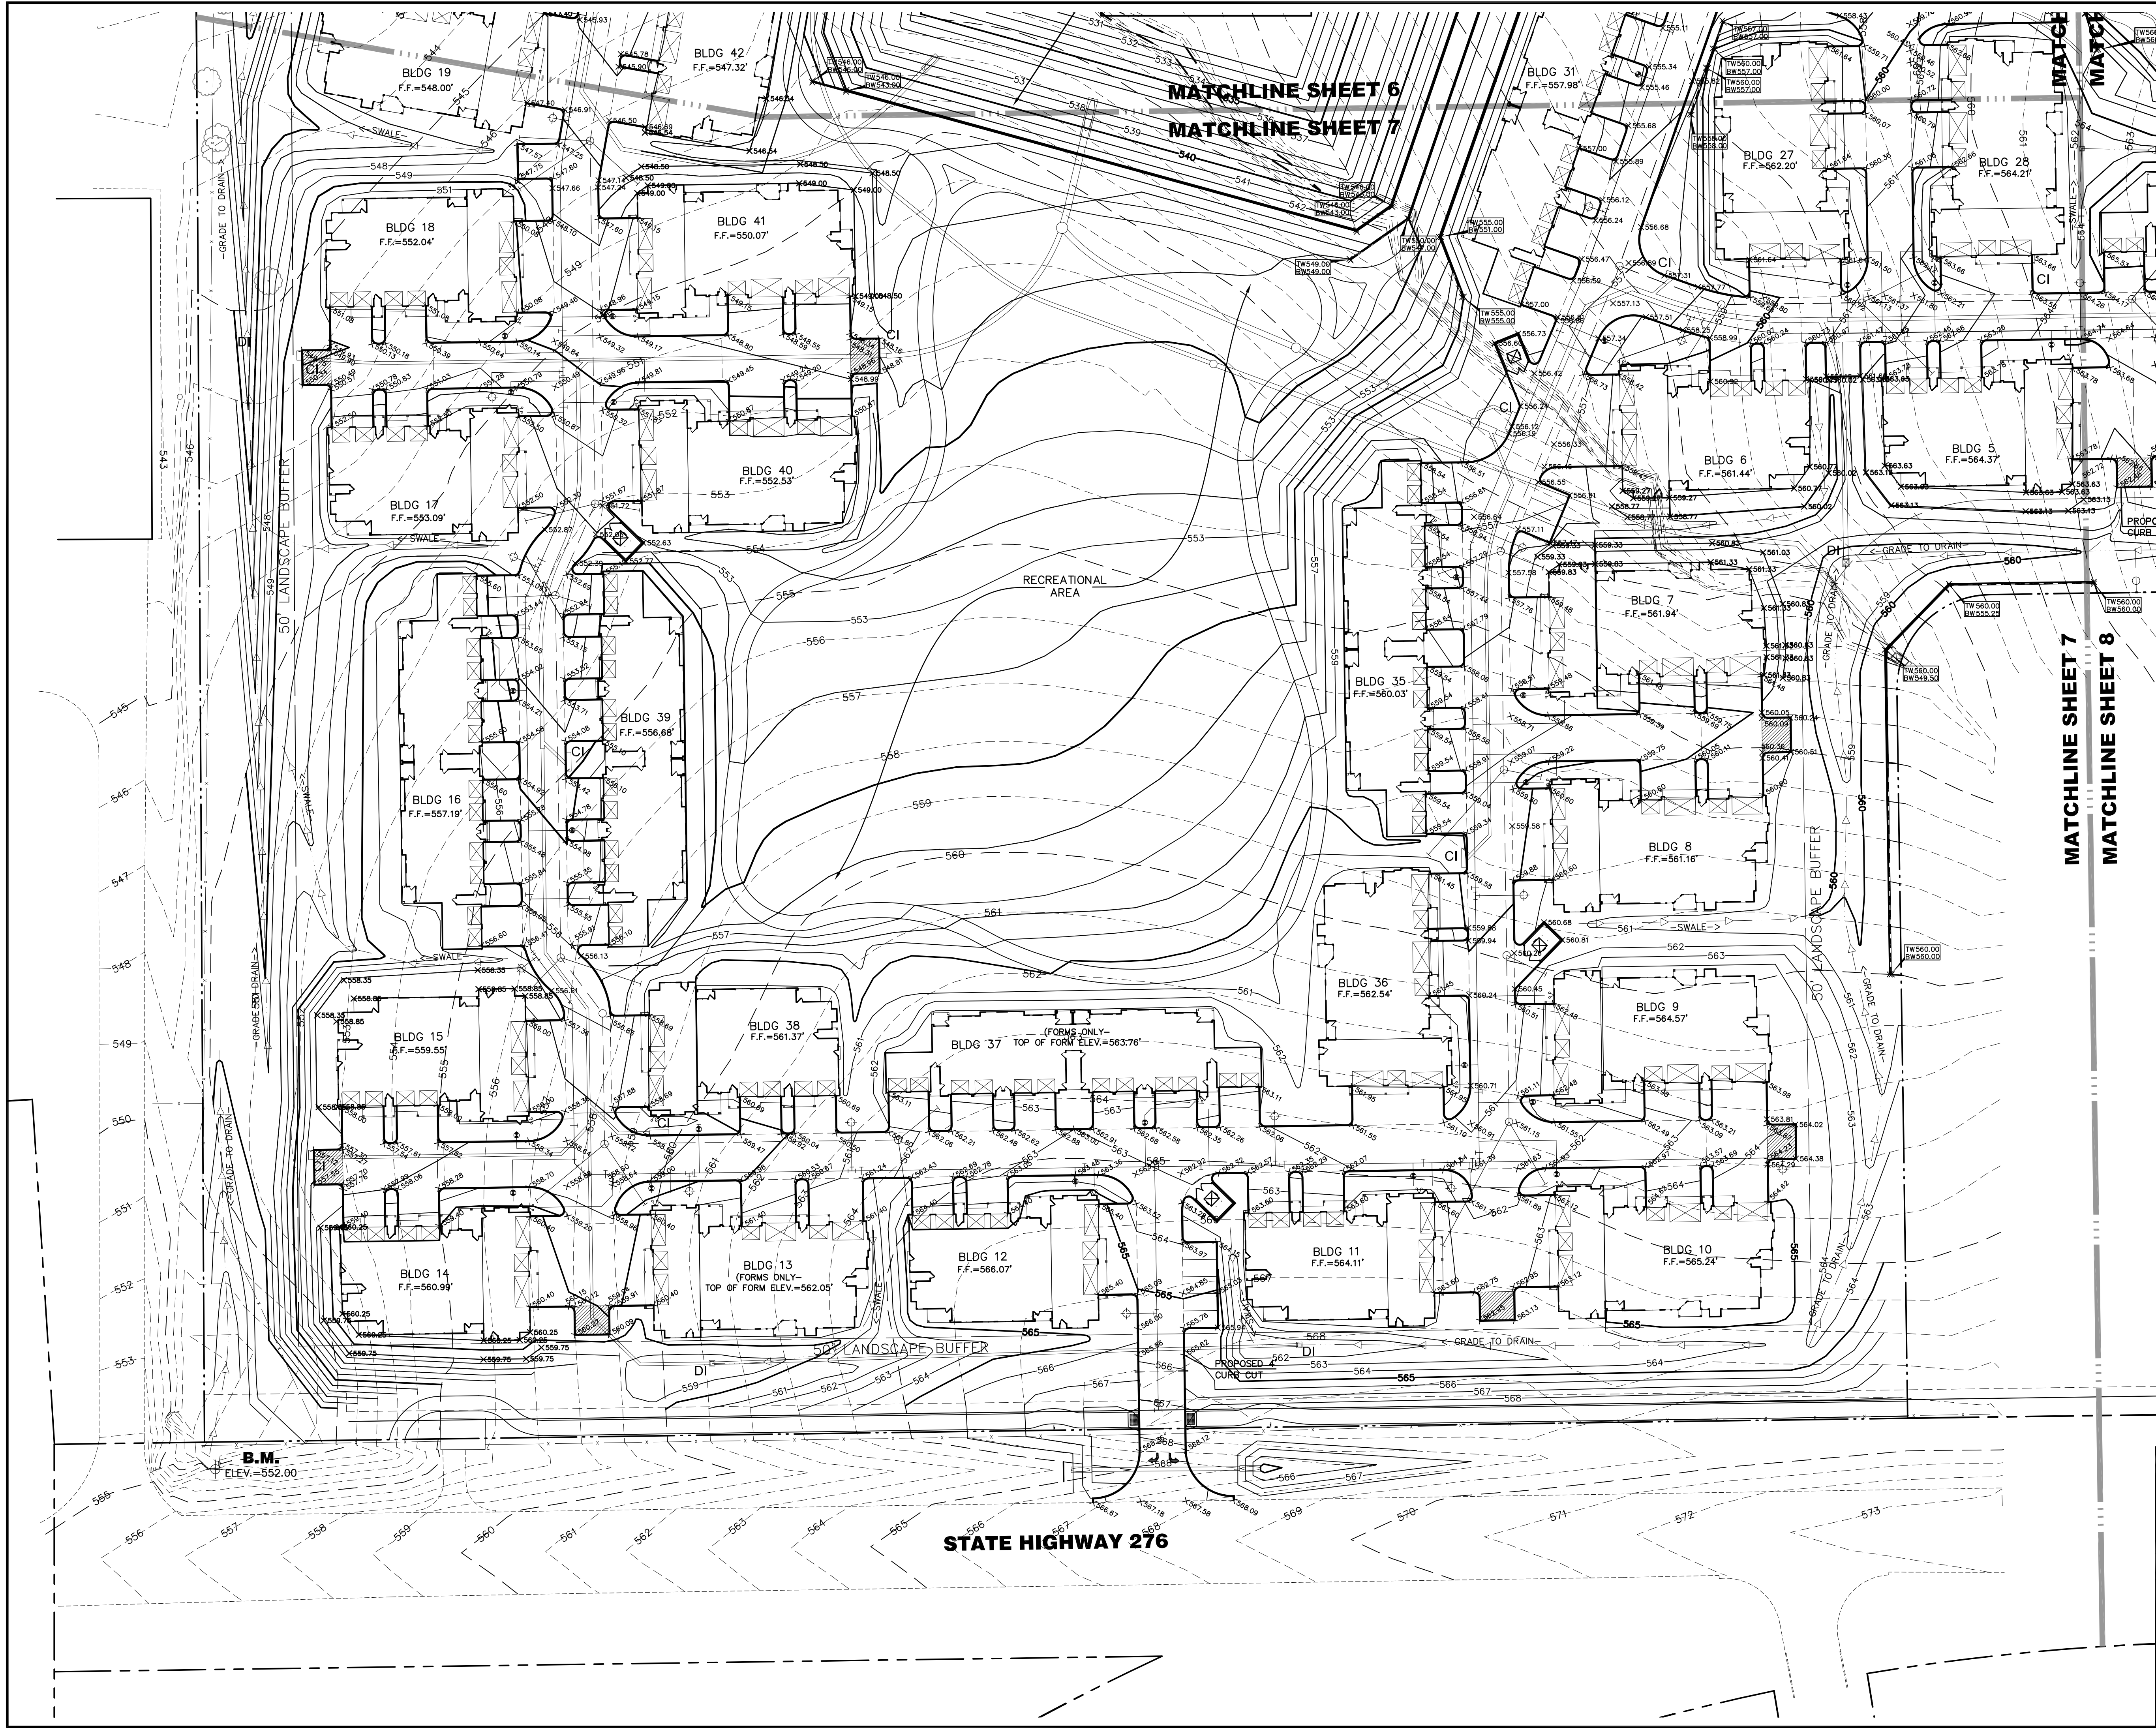

TOCS
1-800-245-4545
tdticket@1-call.com

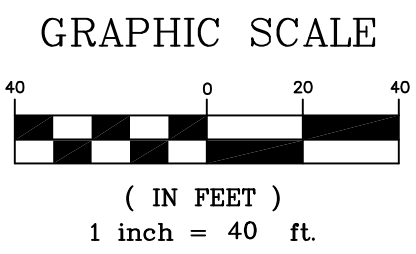

LEGEND	
---	EXISTING MINOR CONTOUR
---	EXISTING MAJOR CONTOUR
---	PROPOSED MINOR CONTOUR
---	PROPOSED MAJOR CONTOUR
X 535.00	PROPOSED TP (U.N.O.)
FFE 548.06	PROPOSED FINISH FLOOR ELEVATION
CI	PROPOSED CURB INLET
DI	PROPOSED DROP INLET
---	PROPOSED STORM SEWER

ALL SPOT GRADE SHOWN ARE TOP OF PAVEMENT UNLESS NOTED OTHERWISE.

RECORD DRAWING
RECORD INFORMATION PROVIDED BY
CONASTER CONSTRUCTION, FORT WORTH, TEXAS
ELEVATION VERIFICATION PERFORMED BY
SURVEY CONSULTANTS, INC., PLANO, TEXAS

- NOTES:
1. PRIOR TO ACCEPTANCE, THE WALL ENGINEER WILL NEED TO SUBMIT A SIGNED AND SEALED LETTER STATING THAT THE WALL WAS INSPECTED DURING CONSTRUCTION AND AFTER AND IS BUILT PER DESIGN.
 2. NO PART OF THE WALL (TIE BLOCKS, FOOTINGS, ETC.) CAN BE IN A EASEMENT, RIGHT-OF-WAY, OR OFFSITE.
 3. REFER TO SHEET 10 FOR DETAILED DETENTION POND GRADING.

REV.	DATE	REMARKS					BY
GRADING PLAN							
MANSIONS FAMILY							
CITY of ROCKWALL, TEXAS							
		RKM Consulting Engineers, Inc. 7616 LBJ Freeway, Suite 530 Dallas, Texas 75251 Copyright © 2009 RKM Consulting Engineers, Inc.			phone (214) 432-8070 fax (214) 432-8069 Form No. P-7237		
CHECKED	DESIGN	DRAWN	JOB	DATE	SCALE	SHEET	
RKM	JRY	JRY	1026-005	05/27/09	1"=40'	7 OF 33	