


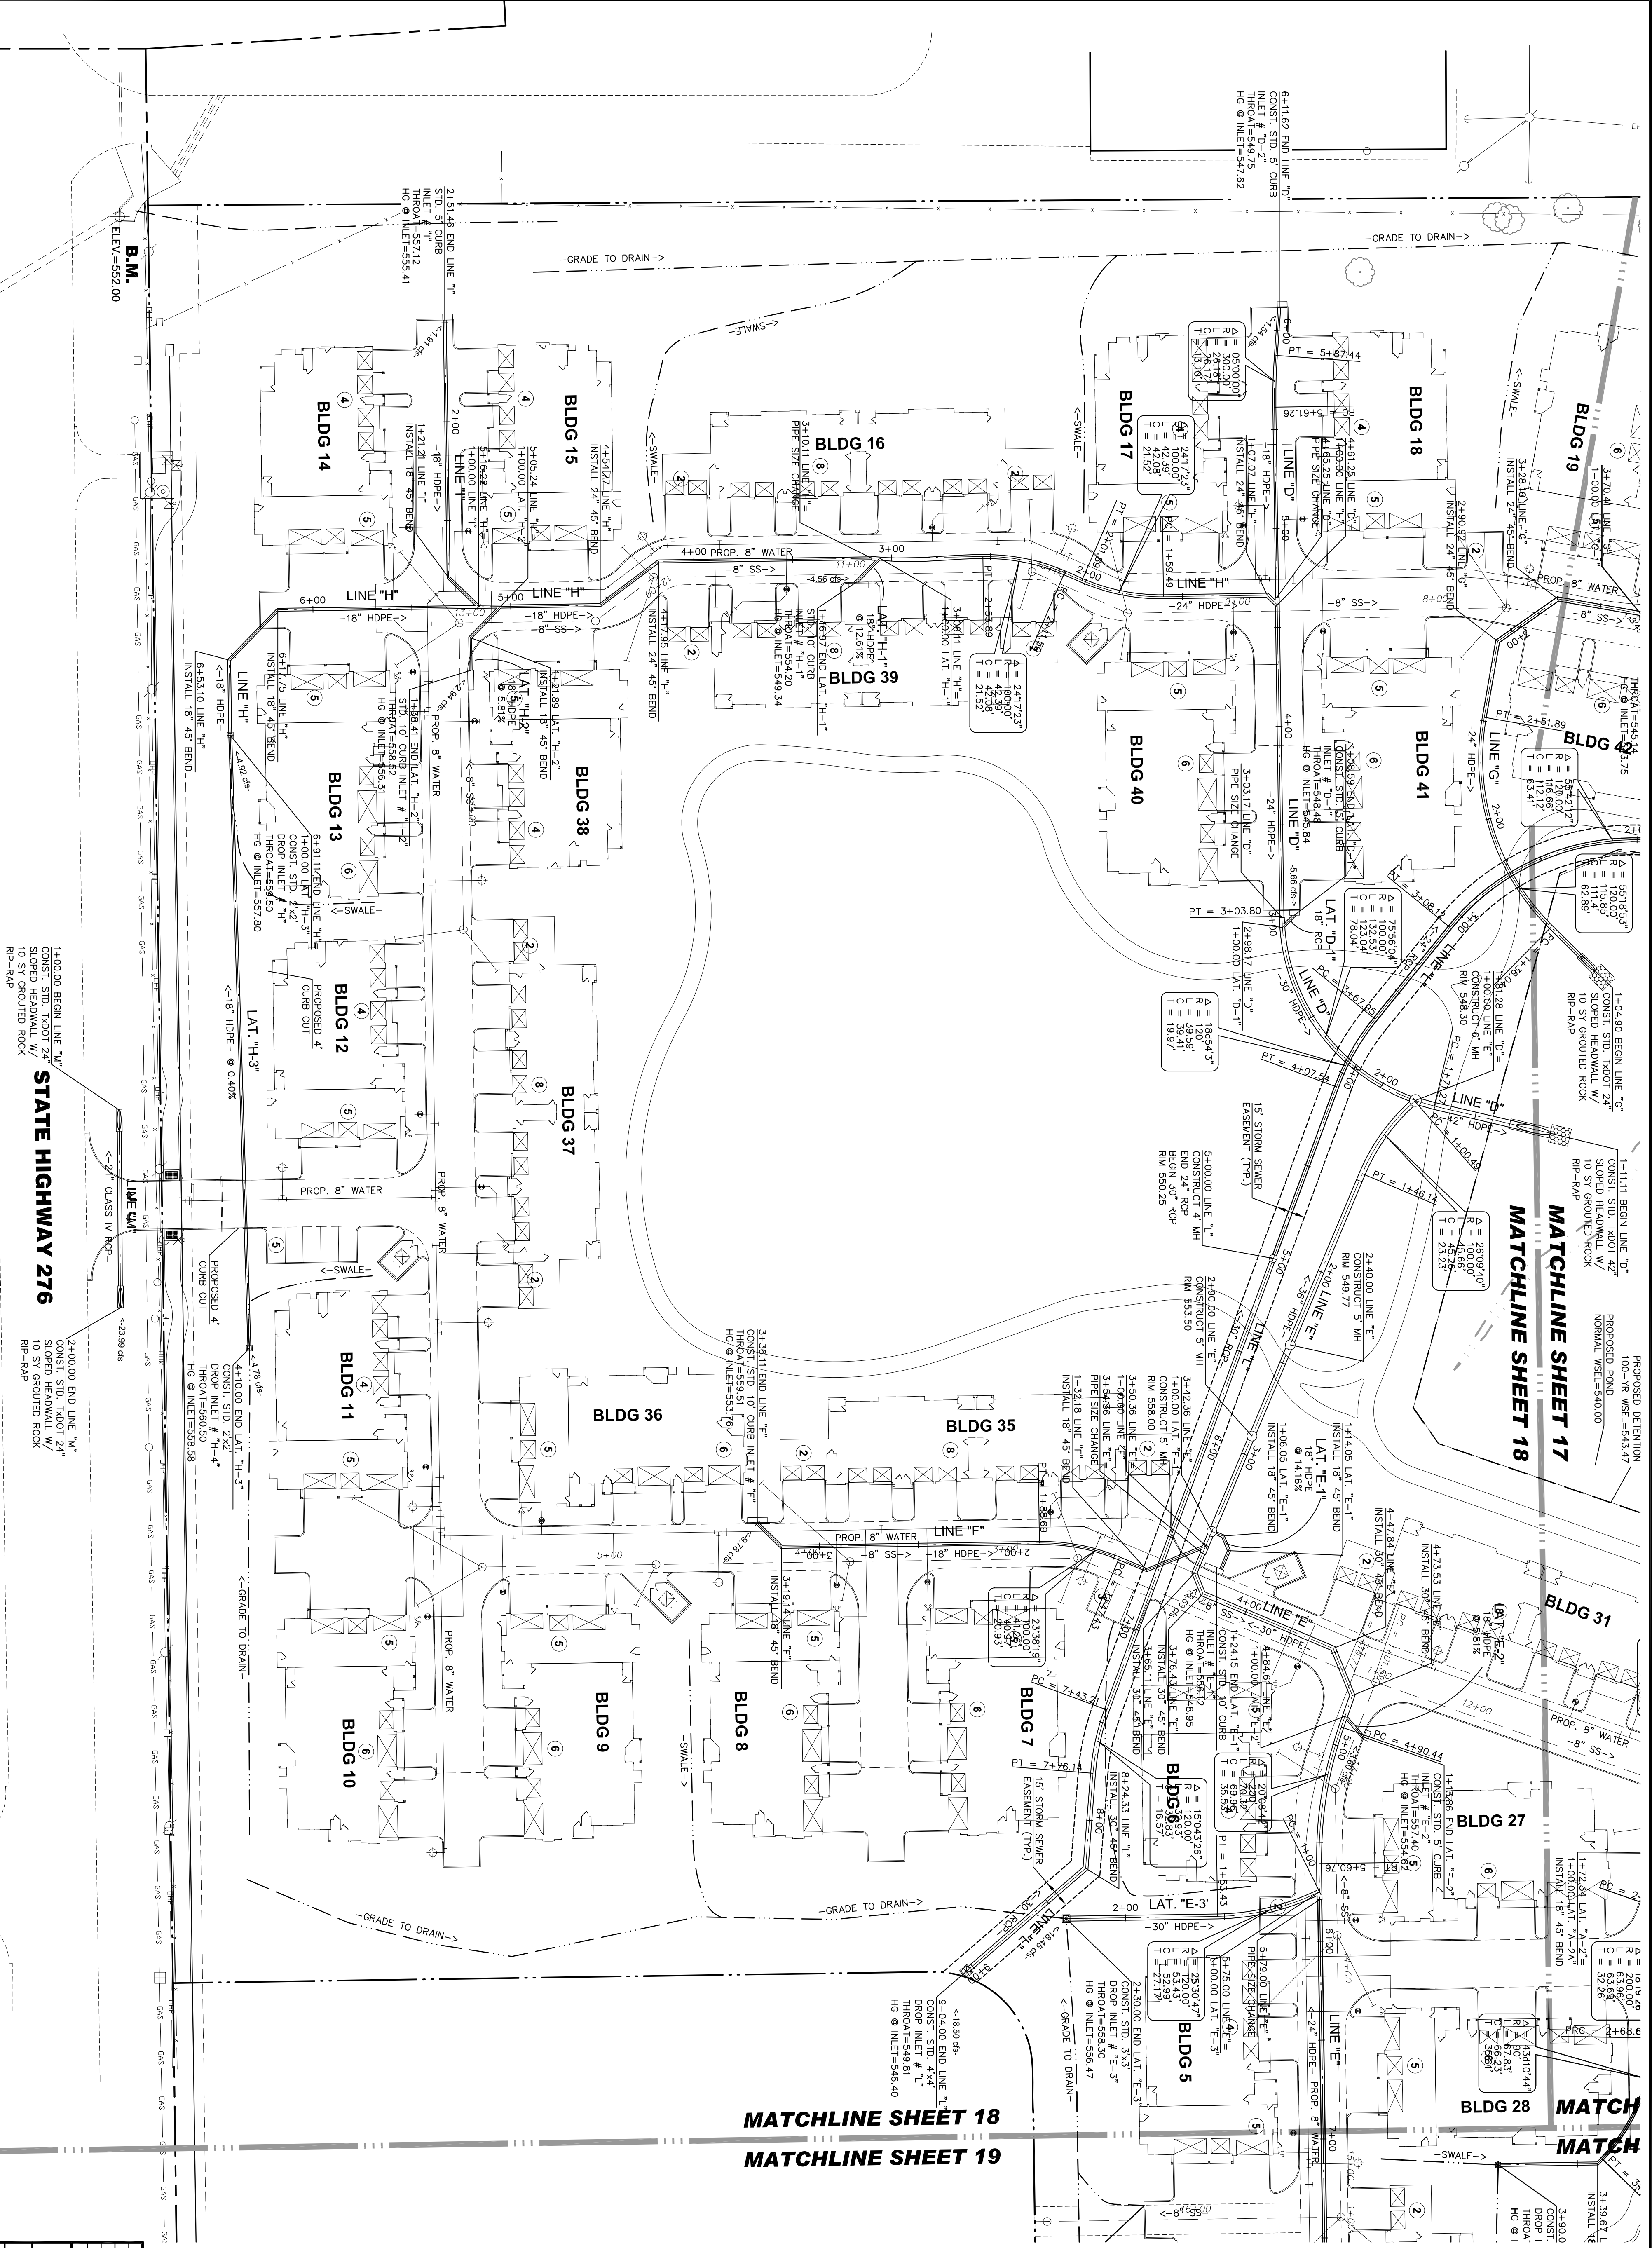

GRAPHIC SCALE

(IN FEET)

1 inch = 40 ft.

TOCS

1-800-245-4545

tolcs@tcs-1.com

RECORD DRAWING
RECORD INFORMATION PROVIDED BY
CONASTER CONSTRUCTION, FORT WORTH, TEXAS
ELEVATION VERIFICATION PERFORMED BY
SURVEY CONSULTANTS, INC., PLANO, TEXAS

REV.	DATE	REMARKS	BY

STORM SEWER PLAN						
MANSIONS FAMILY						
CITY OF ROCKWALL, TEXAS						
RKM Consulting Engineers, Inc.						
7616 LBJ Freeway, Suite 530						
Dallas, Texas 75261						
phone (214) 432-8070						
fax (214) 432-8069						
www.rkmce.com						
CHECKED	DESIGN	DRAWN	JOB	DATE	SCALE	SHEET
RKM	JRY	JRY	1026-005	05/27/09	1"=40'	18
OF 33						