

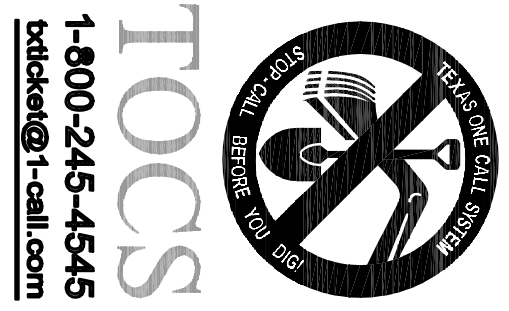
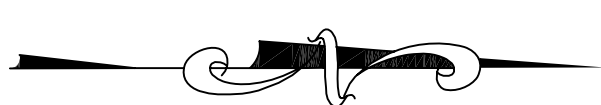


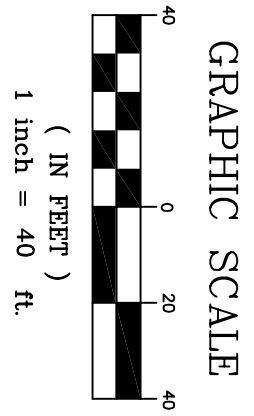

MANSIONS FAMILY - ROCKWALL, RKMCE PROJECT # 1026-005

RECORD DRAWING
RECORD INFORMATION PROVIDED BY
CONASTER CONSTRUCTION, FORT WORTH, TEXAS
ELEVATION VERIFICATION PERFORMED BY
SURVEY CONSULTANTS, INC., PLANO, TEXAS

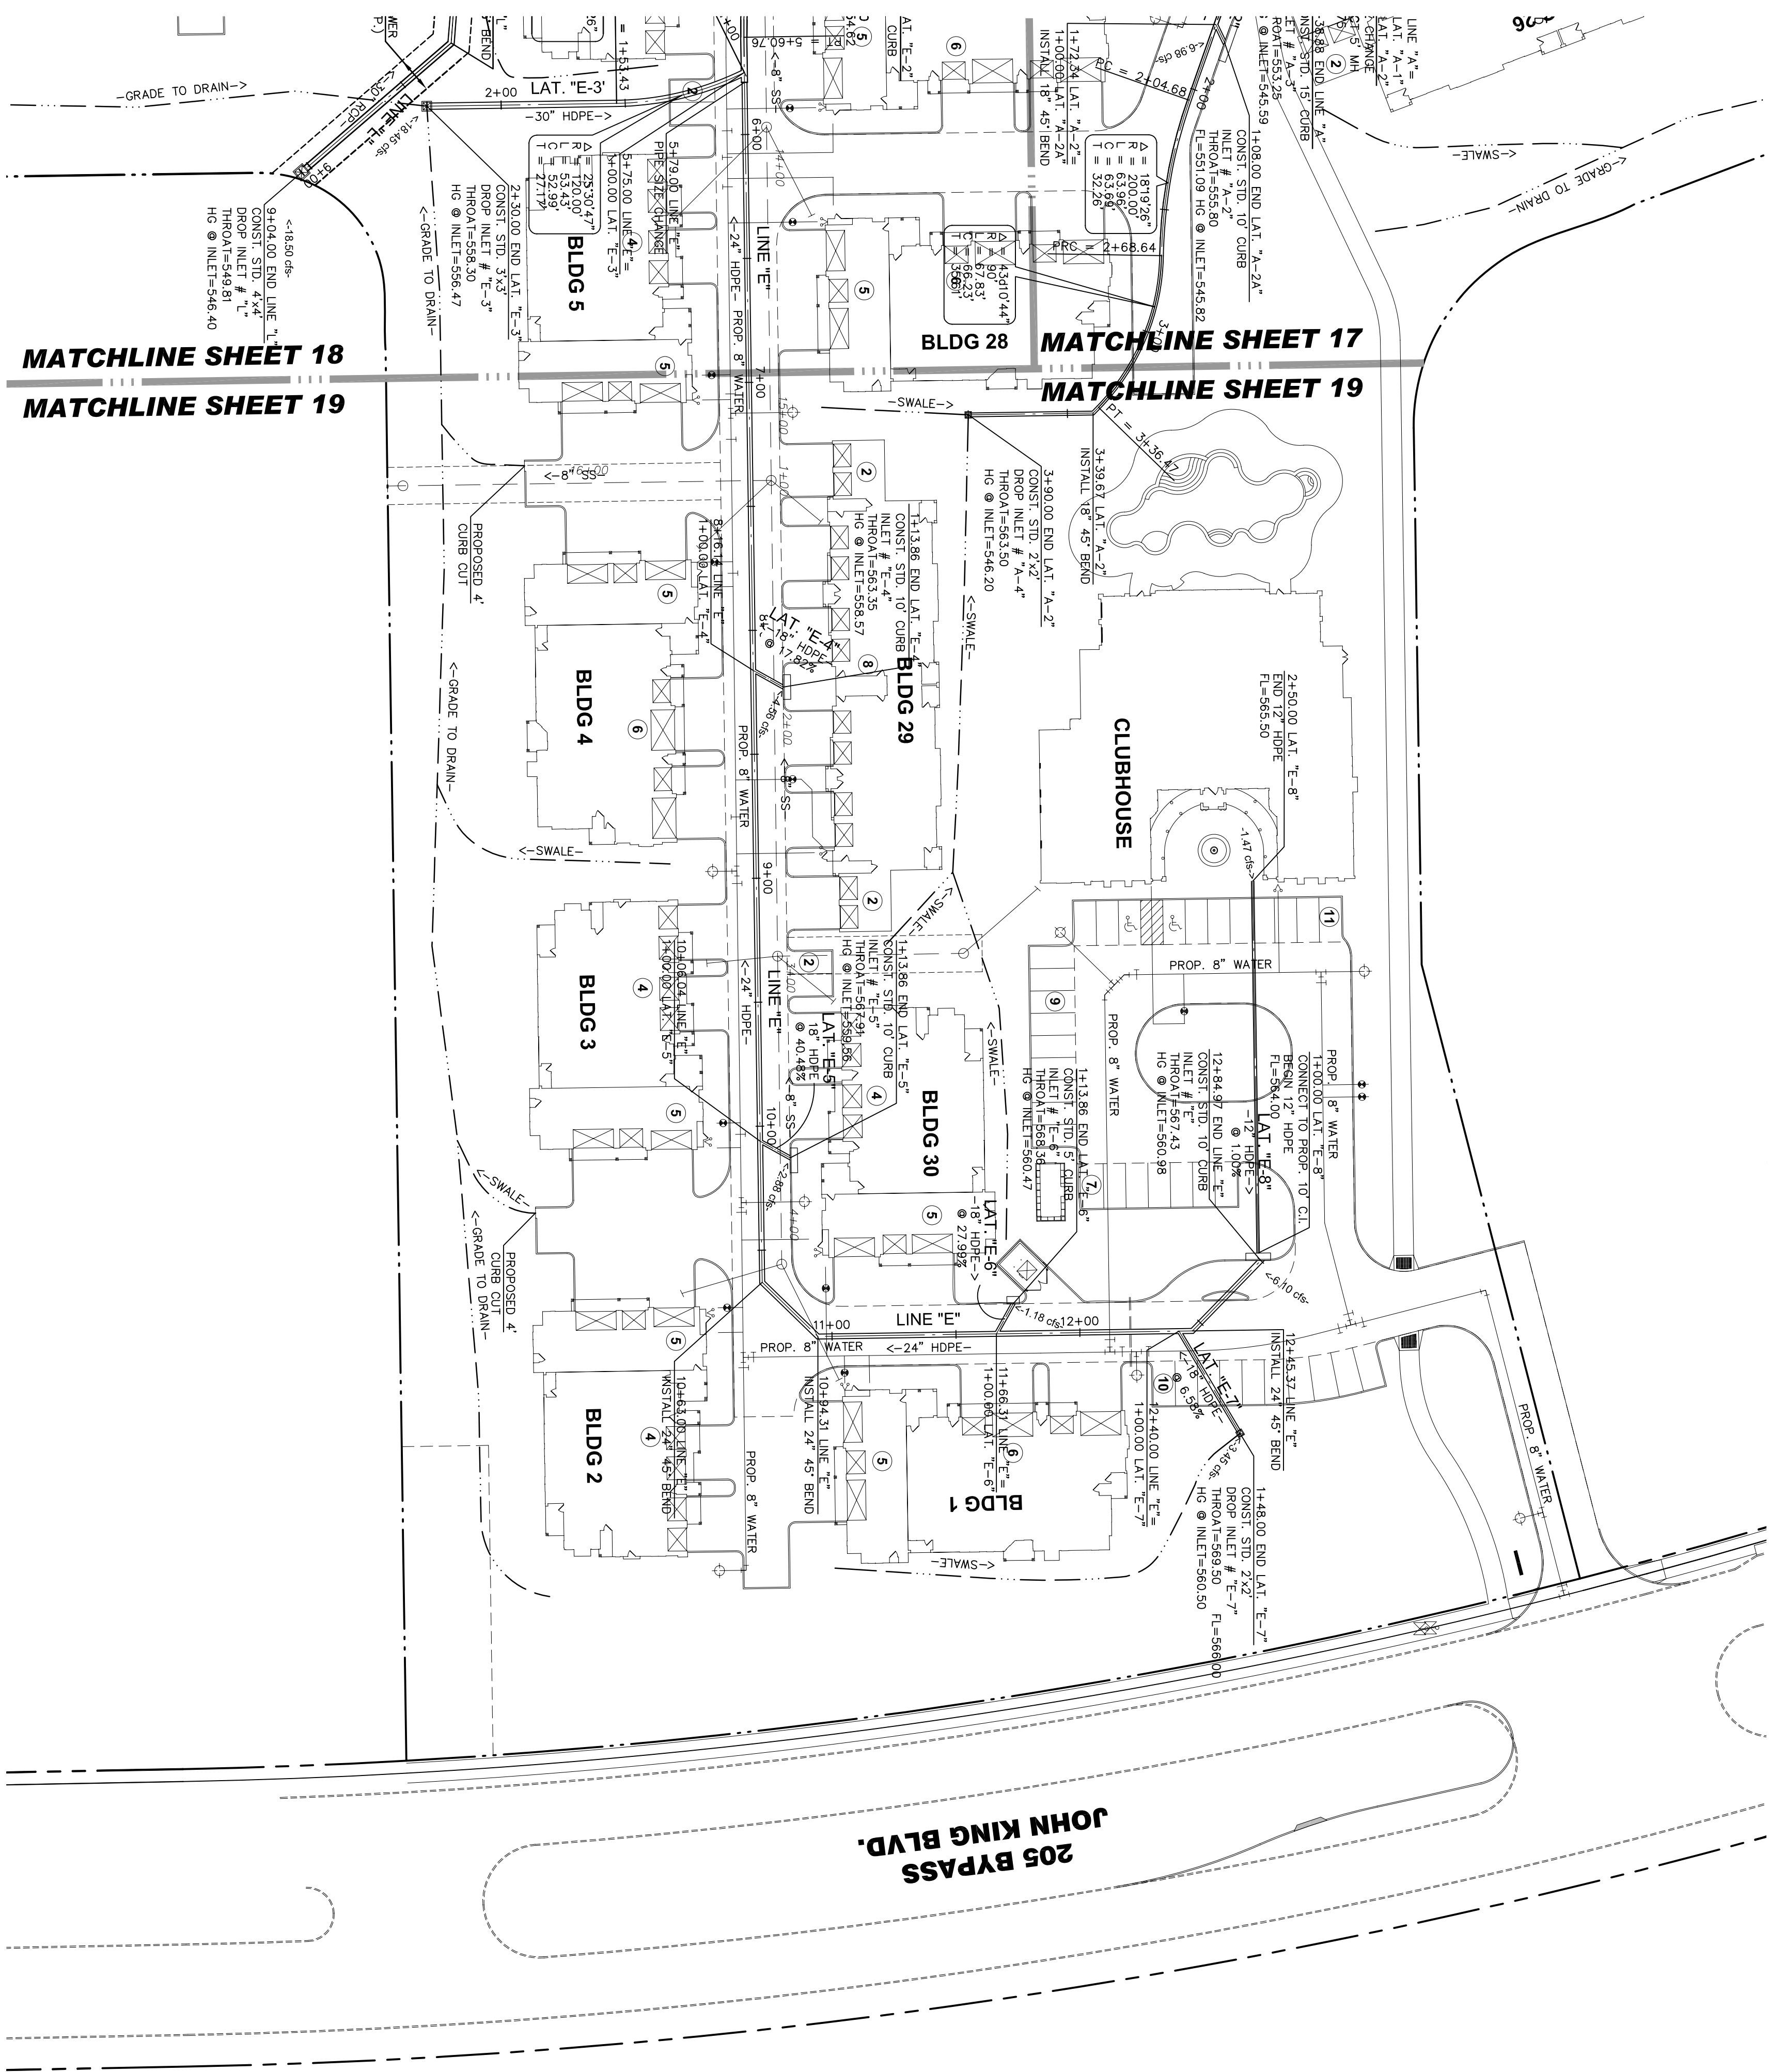

REV.	DATE	REMARKS	BY

STORM SEWER PLAN

MANSIONS FAMILY
CITY of ROCKWALL, TEXAS

RKM Consulting Engineers, Inc.
7616 LBJ Freeway, Suite 530
Dallas, Texas 75251
Copyright © 2009 RKM Consulting Engineers, Inc.

phone (214) 432-8070
fax (214) 432-8069
Firm No. F-7237