

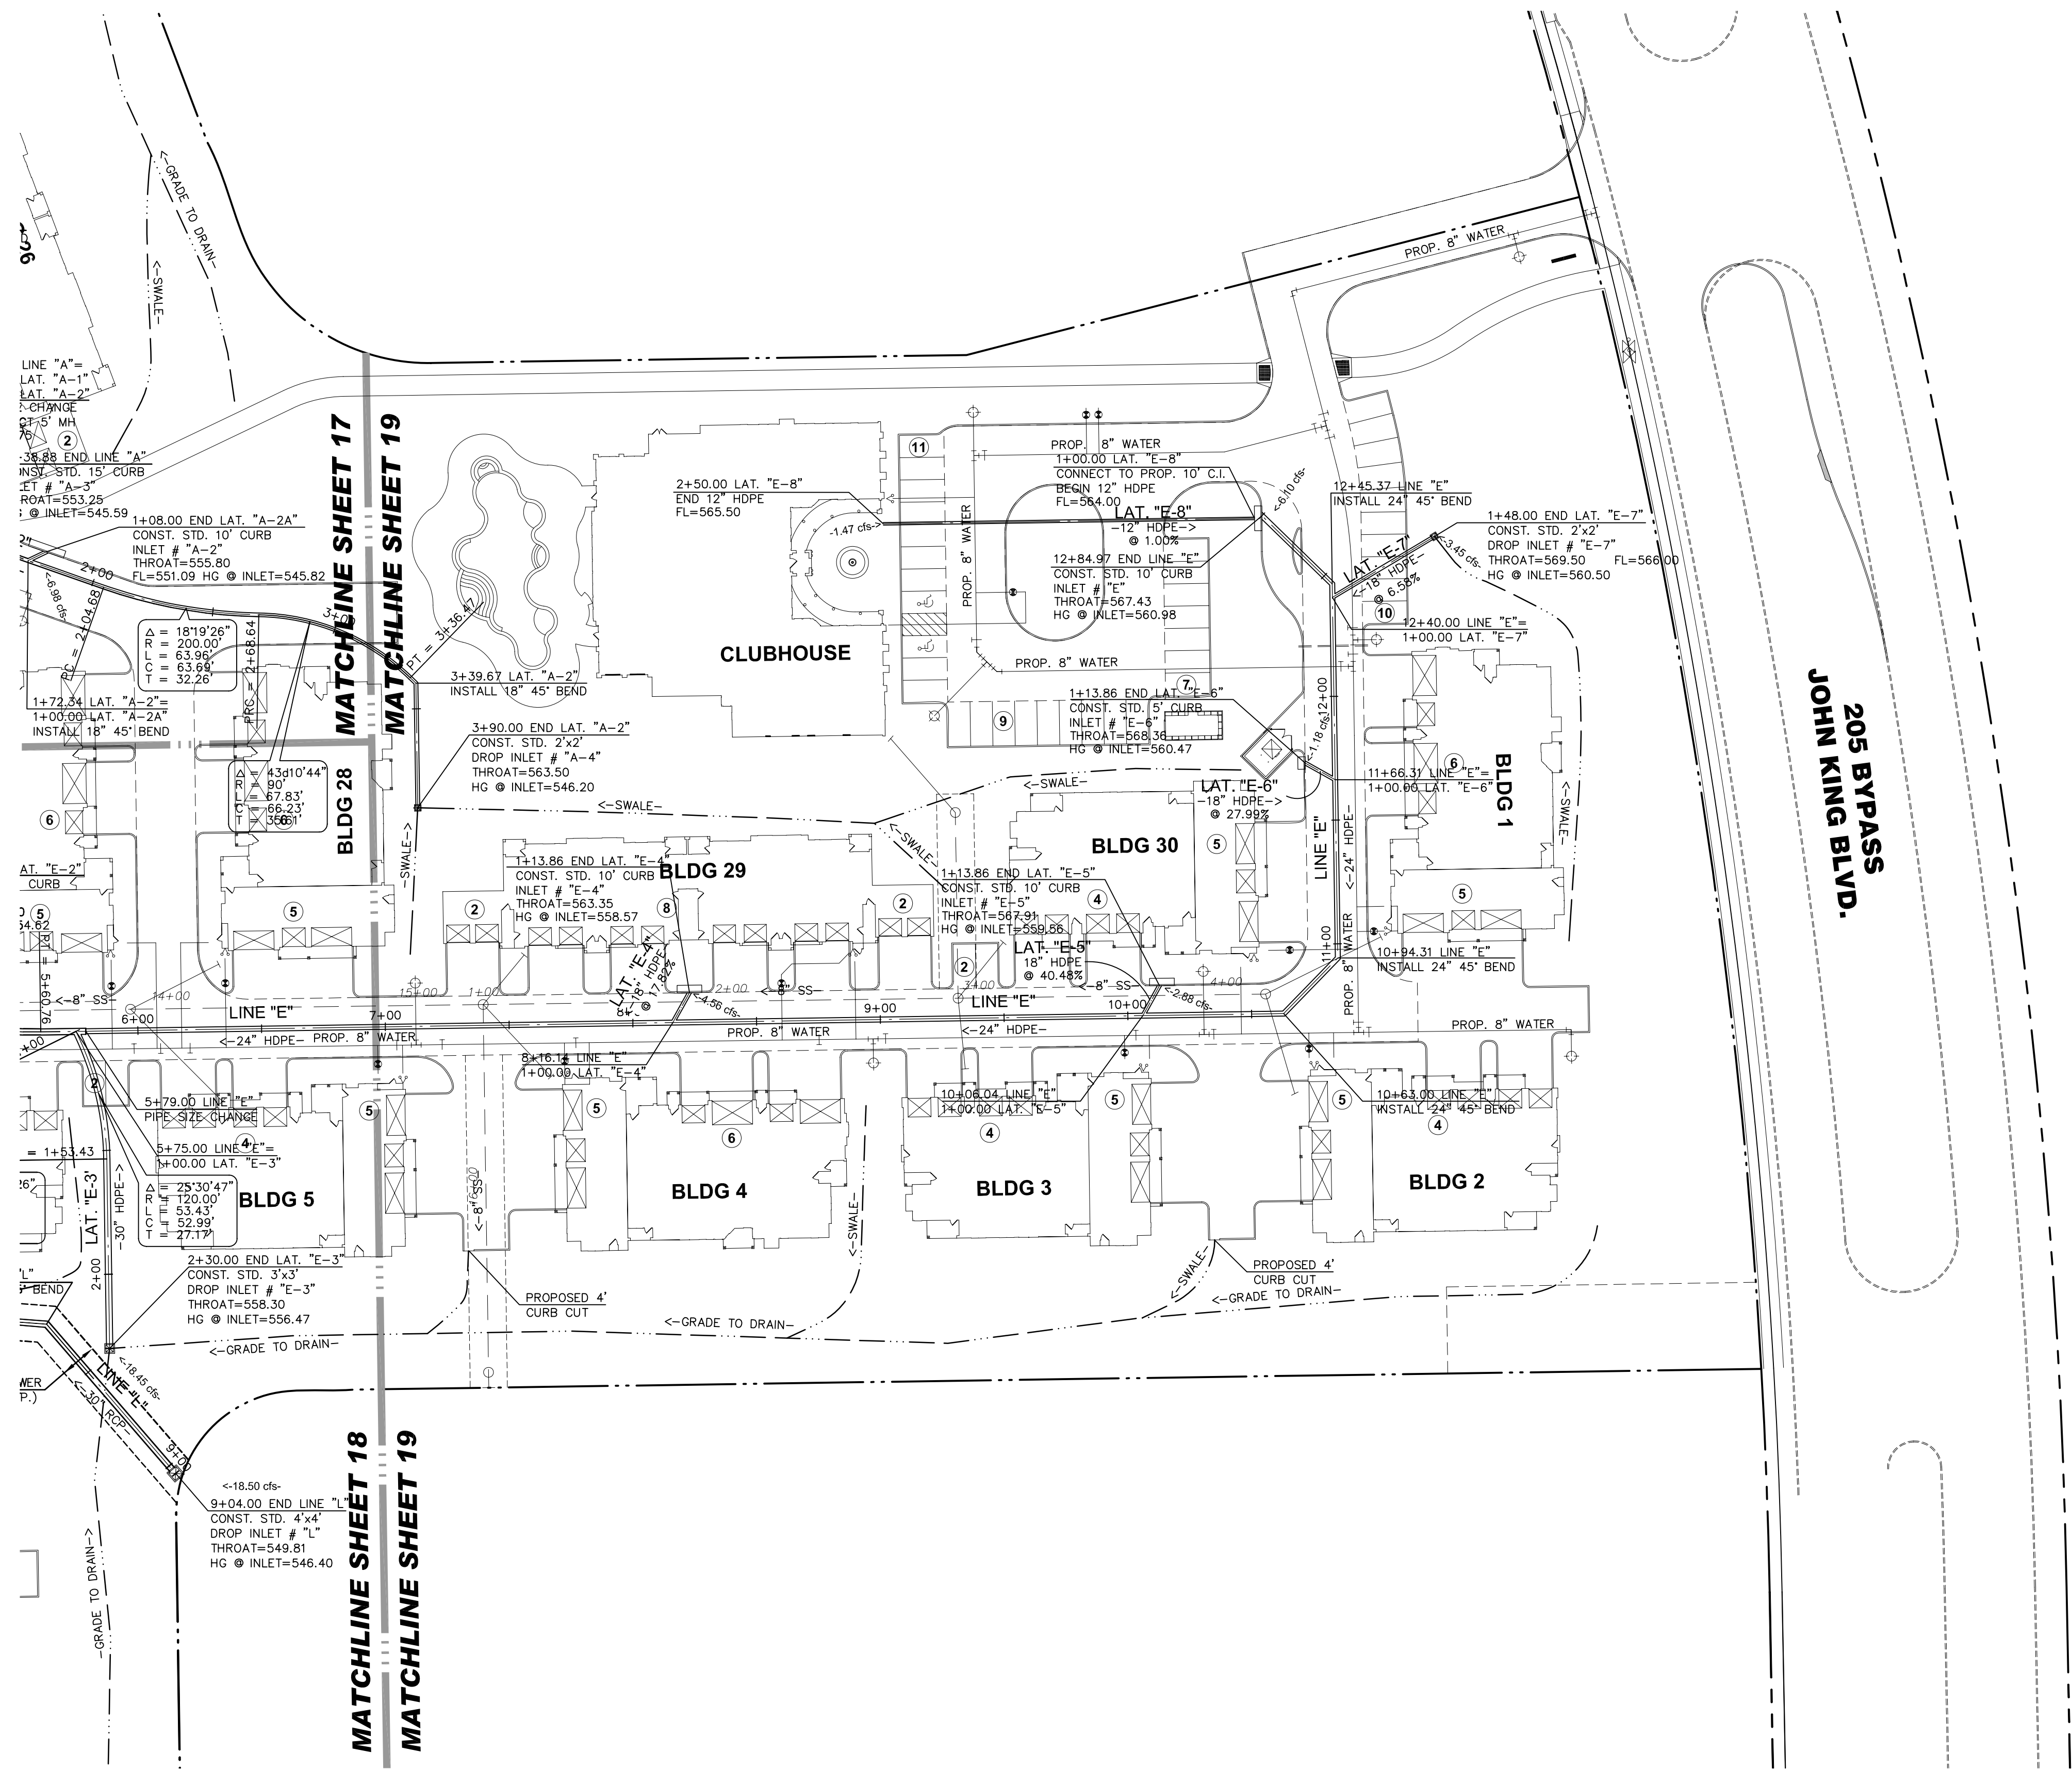


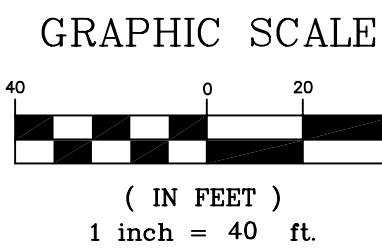

RECORD DRAWING
RECORD INFORMATION PROVIDED BY
CONASTER CONSTRUCTION, FORT WORTH, TEXAS
ELEVATION VERIFICATION PERFORMED BY
SURVEY CONSULTANTS, INC., PLANO, TEXAS

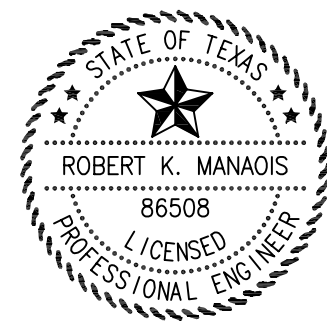

REV.	DATE	REMARKS	BY
STORM SEWER PLAN			
MANSIONS FAMILY			
CITY of ROCKWALL, TEXAS			
RKM RKM Consulting Engineers, Inc. 7616 LBJ Freeway, Suite 530 Dallas, Texas 75251 Copyright © 2008 RKM Consulting Engineers, Inc.			
CHECKED	DESIGN	DRAWN	JOB
RKM	JRY	JRY	1026-005
DATE	SCALE	SHEET	
05/27/09	1"=40'	19	OF 33