



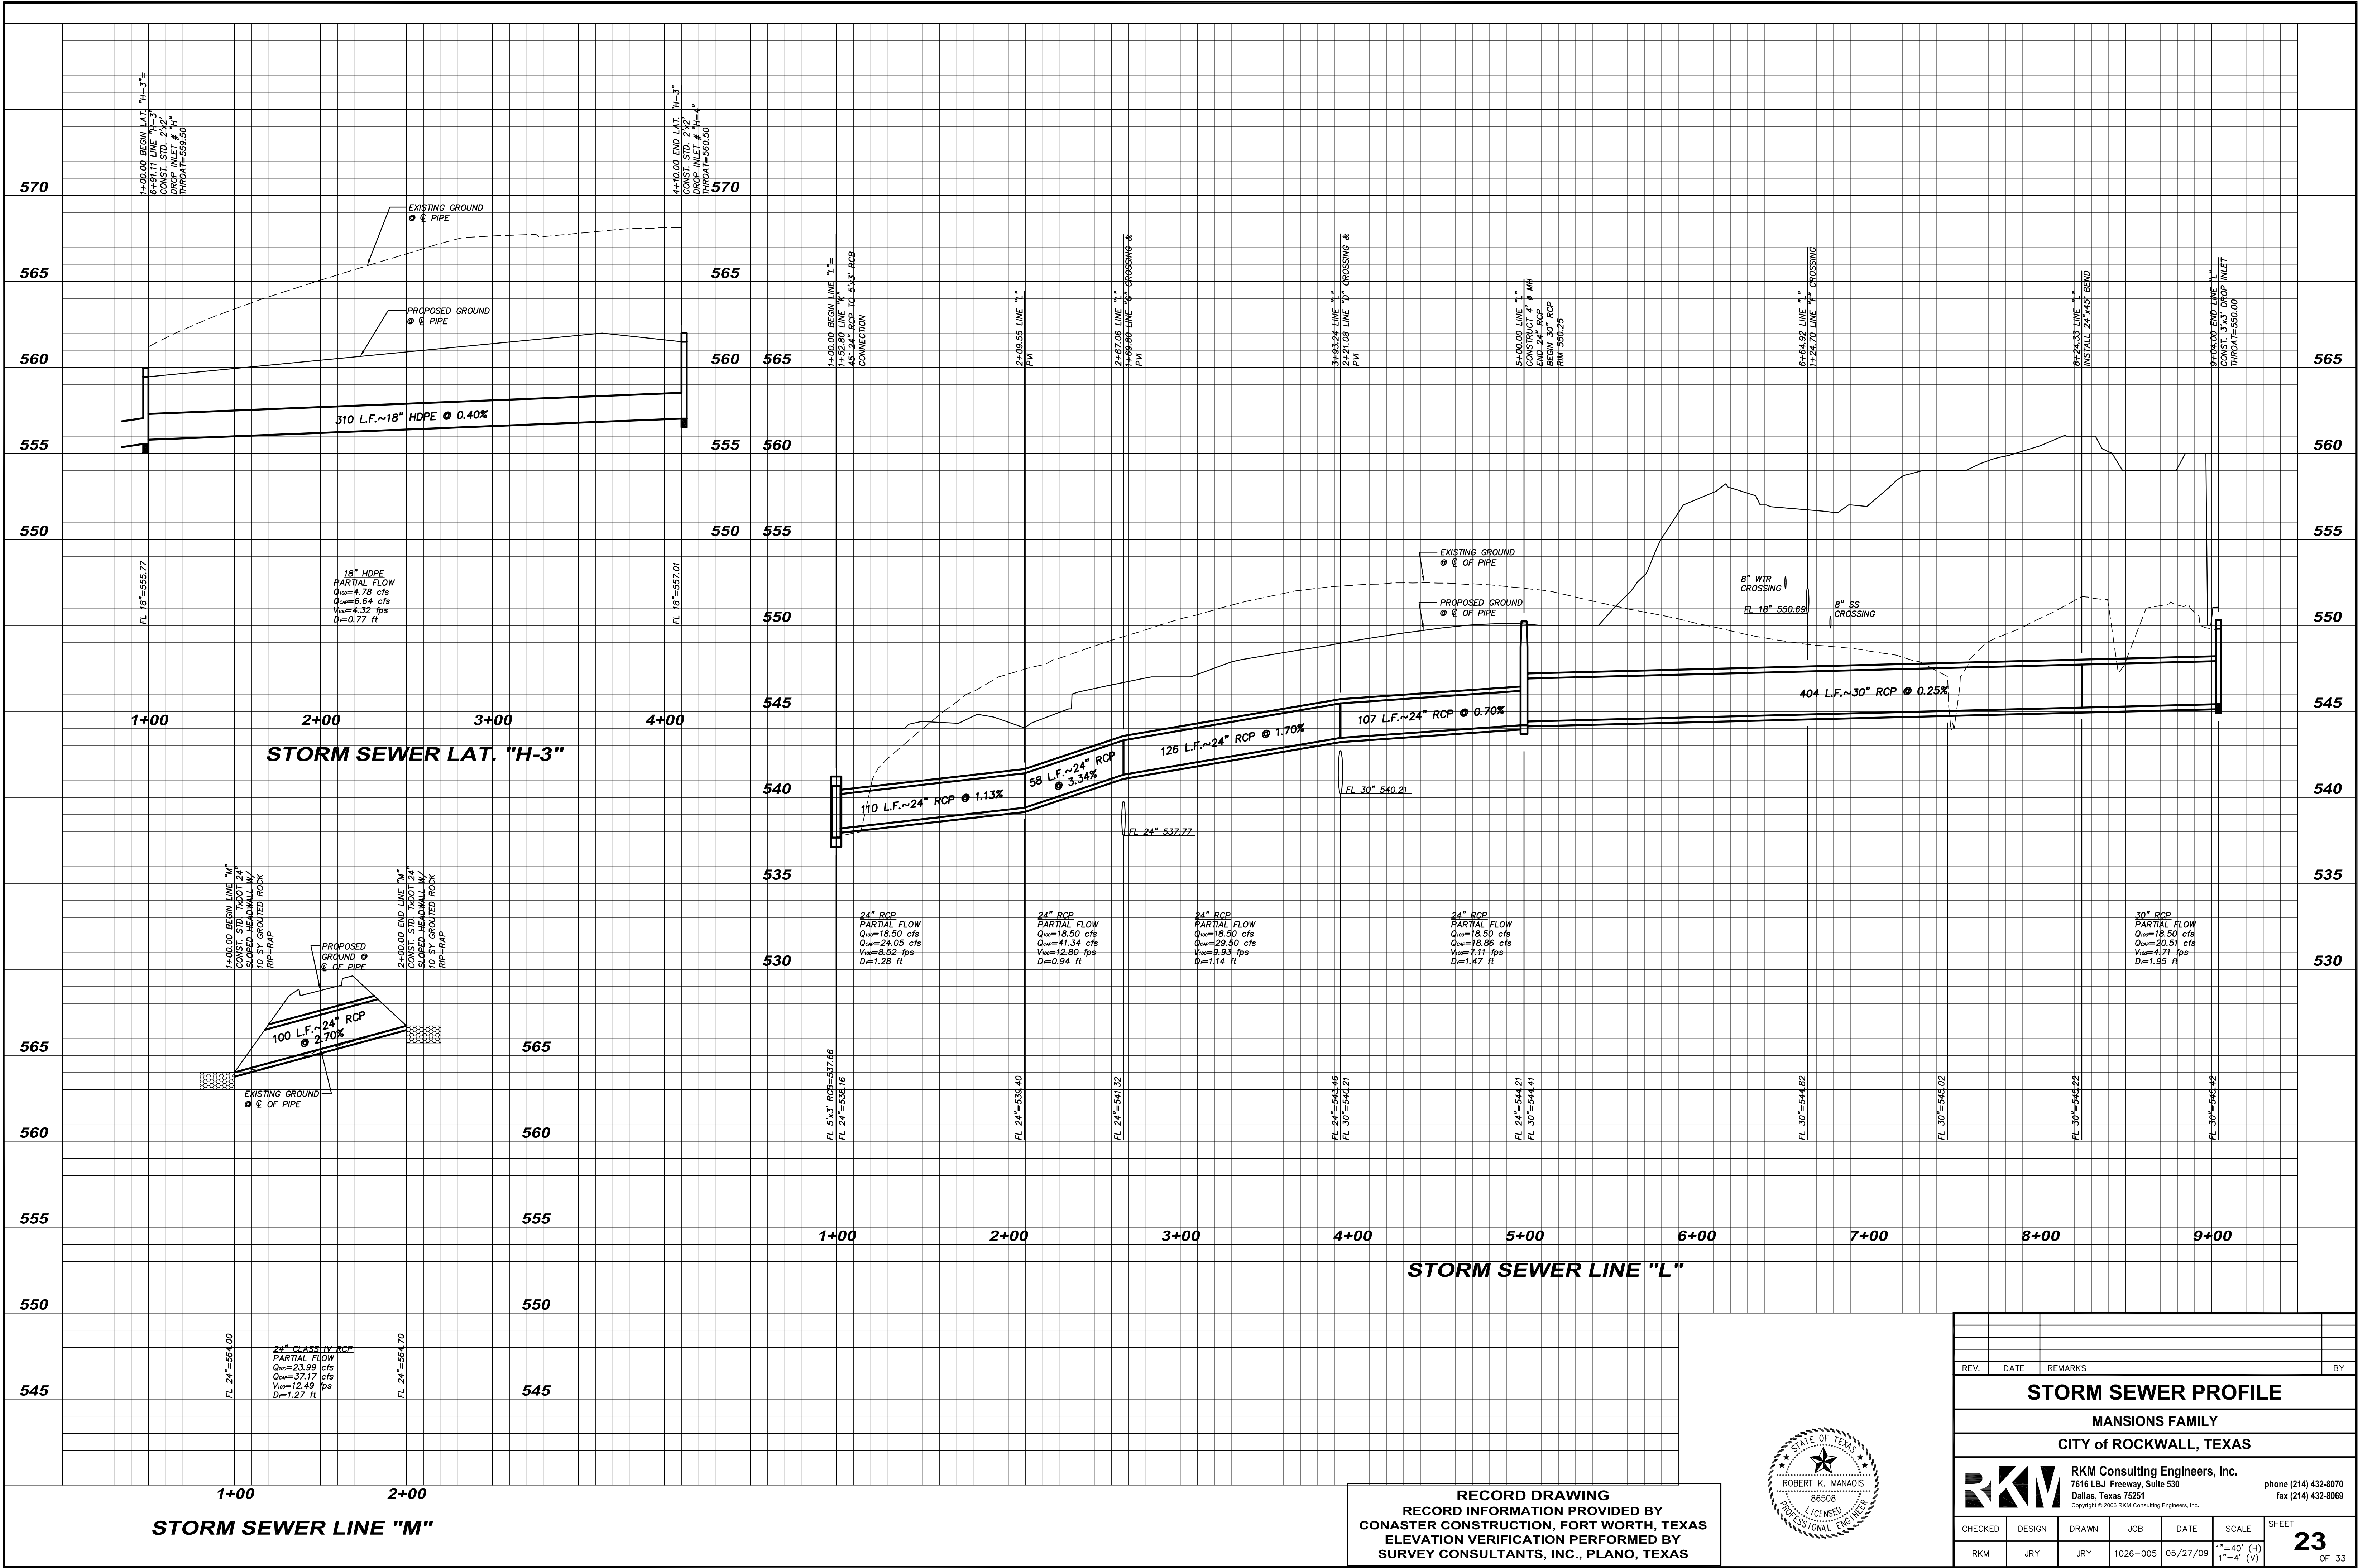

MANSIONS FAMILY - ROCKWALL, RMCE PROJECT # 1026-005

RECORD DRAWING
RECORD INFORMATION PROVIDED BY
CONASTER CONSTRUCTION, FORT WORTH, TEXAS
ELEVATION VERIFICATION PERFORMED BY
SURVEY CONSULTANTS, INC., PLANO, TEXAS

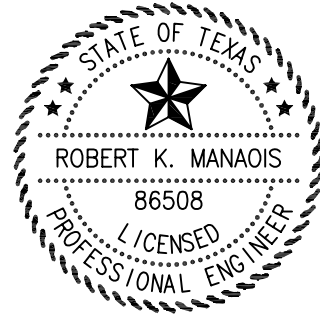

REV.		DATE	REMARKS	BY
STORM SEWER PROFILE				
MANSIONS FAMILY				
CITY of ROCKWALL, TEXAS				
RKM		RKM Consulting Engineers, Inc.		phone (214) 432-8070
		7616 LBJ Freeway, Suite 530		Dallas, Texas 75251
		Copyright © 2008 RKM Consulting Engineers, Inc.		fax (214) 432-8069
CHECKED	DESIGN	DRAWN	JOB	DATE
RKM	JRY	JRY	1026-005	05/27/09
SCALE		SHEET		
1"=40' (H) 1"=4' (V)		23		OF 33