

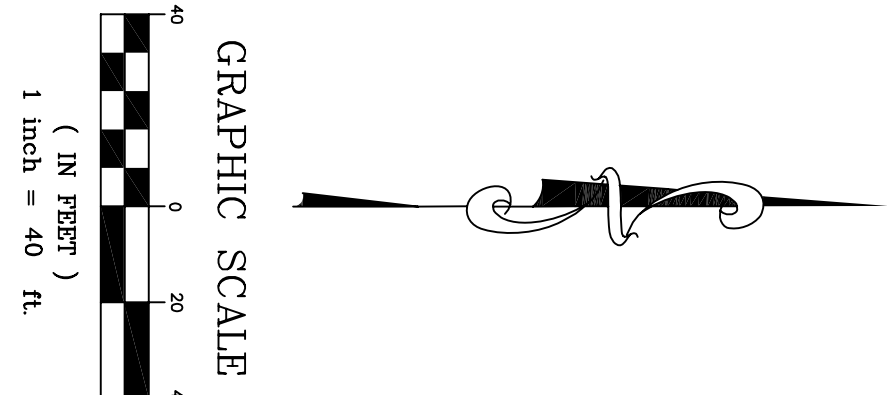


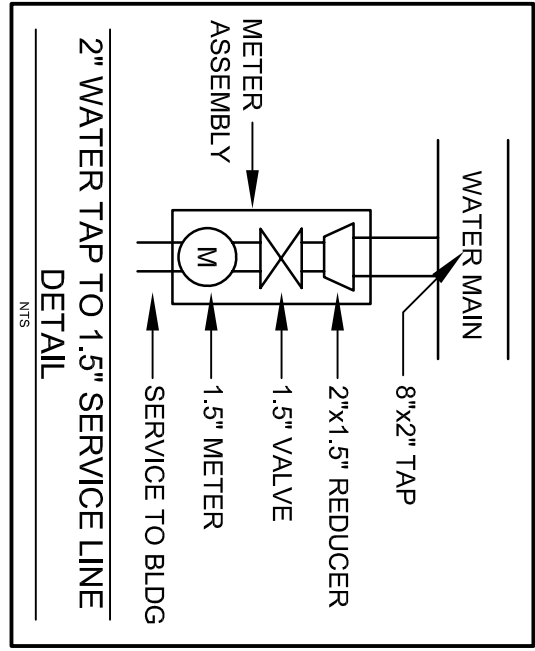


TOCS
1-800-245-4545
tocsinc@1-call.com

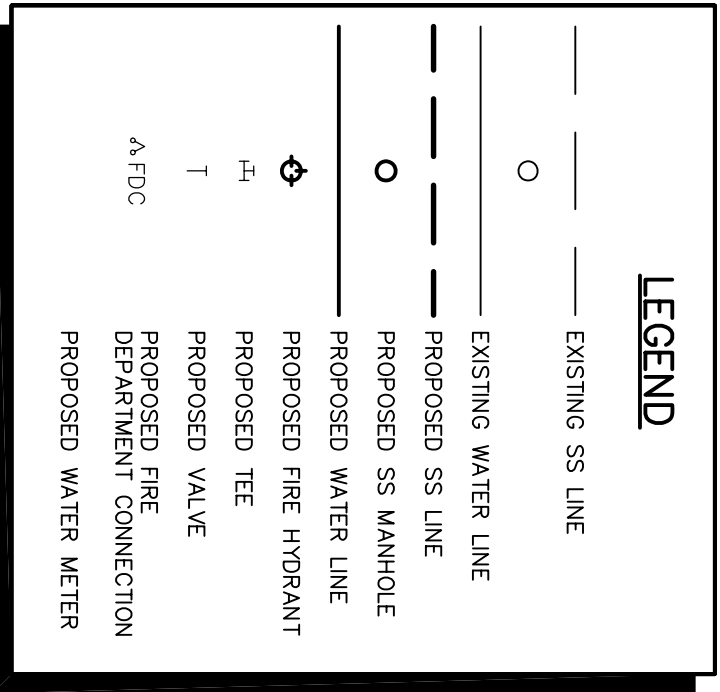

WATER METER TABLE													
I.D.	TYPE	TAP SIZE	METER SIZE	NO.	FIRE	SAN. SEWER	I.D.	TYPE	TAP SIZE	METER SIZE	NO.	FIRE	SAN. SEWER
64	DOMESTIC	1"	1"	1	4"	1-6"							
11	IRRIGATION	2"	2"	1	N/A	N/A	12	IRRIGATION	2"	2"	1	N/A	N/A
1	DOMESTIC	2"	1.5"	1	4"	1-6"	22	DOMESTIC	2"	1.5"	1	4"	1-6"
2	DOMESTIC	2"	1.5"	1	4"	1-6"	23	DOMESTIC	2"	1.5"	1	4"	1-6"
3	DOMESTIC	2"	1.5"	1	4"	1-6"	24	DOMESTIC	2"	1.5"	1	4"	1-6"
4	DOMESTIC	2"	1.5"	1	4"	1-6"	25	DOMESTIC	2"	1.5"	1	4"	1-6"
5	DOMESTIC	2"	1.5"	1	4"	1-6"	26	DOMESTIC	2"	1.5"	1	4"	1-6"
6	DOMESTIC	2"	1.5"	1	4"	1-6"	27	DOMESTIC	2"	1.5"	1	4"	1-6"
7	DOMESTIC	2"	1.5"	1	4"	1-6"	28	DOMESTIC	2"	1.5"	1	4"	1-6"
8	DOMESTIC	2"	1.5"	1	4"	1-6"	29	DOMESTIC	2"	1.5"	1	4"	1-6"
9	DOMESTIC	2"	1.5"	1	4"	1-6"	30	DOMESTIC	2"	1.5"	1	4"	1-6"
10	DOMESTIC	2"	1.5"	1	4"	1-6"	31	DOMESTIC	2"	1.5"	1	4"	1-6"
11	DOMESTIC	2"	1.5"	1	4"	1-6"	32	DOMESTIC	2"	1.5"	1	4"	1-6"
12	DOMESTIC	2"	1.5"	1	4"	1-6"	33	DOMESTIC	2"	1.5"	1	4"	1-6"
13	DOMESTIC	2"	1.5"	1	4"	1-6"	34	DOMESTIC	2"	1.5"	1	4"	1-6"
14	DOMESTIC	2"	1.5"	1	4"	1-6"	35	DOMESTIC	2"	1.5"	1	4"	1-6"
15	DOMESTIC	2"	1.5"	1	4"	1-6"	36	DOMESTIC	2"	1.5"	1	4"	1-6"
16	DOMESTIC	2"	1.5"	1	4"	1-6"	37	DOMESTIC	2"	1.5"	1	4"	1-6"
17	DOMESTIC	2"	1.5"	1	4"	1-6"	38	DOMESTIC	2"	1.5"	1	4"	1-6"
18	DOMESTIC	2"	1.5"	1	4"	1-6"	39	DOMESTIC	2"	1.5"	1	4"	1-6"
19	DOMESTIC	2"	1.5"	1	4"	1-6"	40	DOMESTIC	2"	1.5"	1	4"	1-6"
20	DOMESTIC	2"	1.5"	1	4"	1-6"	41	DOMESTIC	2"	1.5"	1	4"	1-6"
21	DOMESTIC	2"	1.5"	1	4"	1-6"	42	DOMESTIC	2"	1.5"	1	4"	1-6"

- NOTES:**
1. FIRE LINE SHALL HAVE MIN. 10' SEPARATION FROM ANY UTILITY (DOMESTIC WATER SERVICE, SANITARY SEWER SERVICE, ETC).
 2. FIRE HYDRANT NEXT TO PARKING AND/OR STRUCTURE MUST HAVE 5' CLEARANCE.
 3. ALL FIRE HYDRANTS SHOWN ON THESE PLANS ARE WITHIN MIN. 10X15 EASEMENTS.
 4. REFER TO SHEET 26 FOR WATER METER TABLE.
 5. SANITARY SEWER LINES "D" AND "E" ARE PUBLIC LINES. ALL OTHER PROPOSED SANITARY SEWER LINES ON THIS PROJECT ARE CONSIDERED PRIVATE.
 6. ALL SANITARY SEWER MANHOLES TO BE SEALED.
 7. CONTRACTOR TO ADJUST PROPOSED MANHOLE RIM ELEVATION TO MATCH PROPOSED FINISHED GRADE.
- 1** 1-8"x2" TEE
1-2" VALVE (SQUARE NUT)
EXTEND 2" SERVICE PAST FIRELANE
INSTAL 1 2"x1-1/2" REDUCER
EXTEND 1 1/2" SERVICE LINE TO
VALVE BOX
INSTAL 1 1-1/2" WATER METER
1-4" FIRE LINE (CLASS 200 DRI 4
OR GREATER)
1-4" VALVE
1-8" VALVE BETWEEN
DOMESTIC AND FIRE LINE

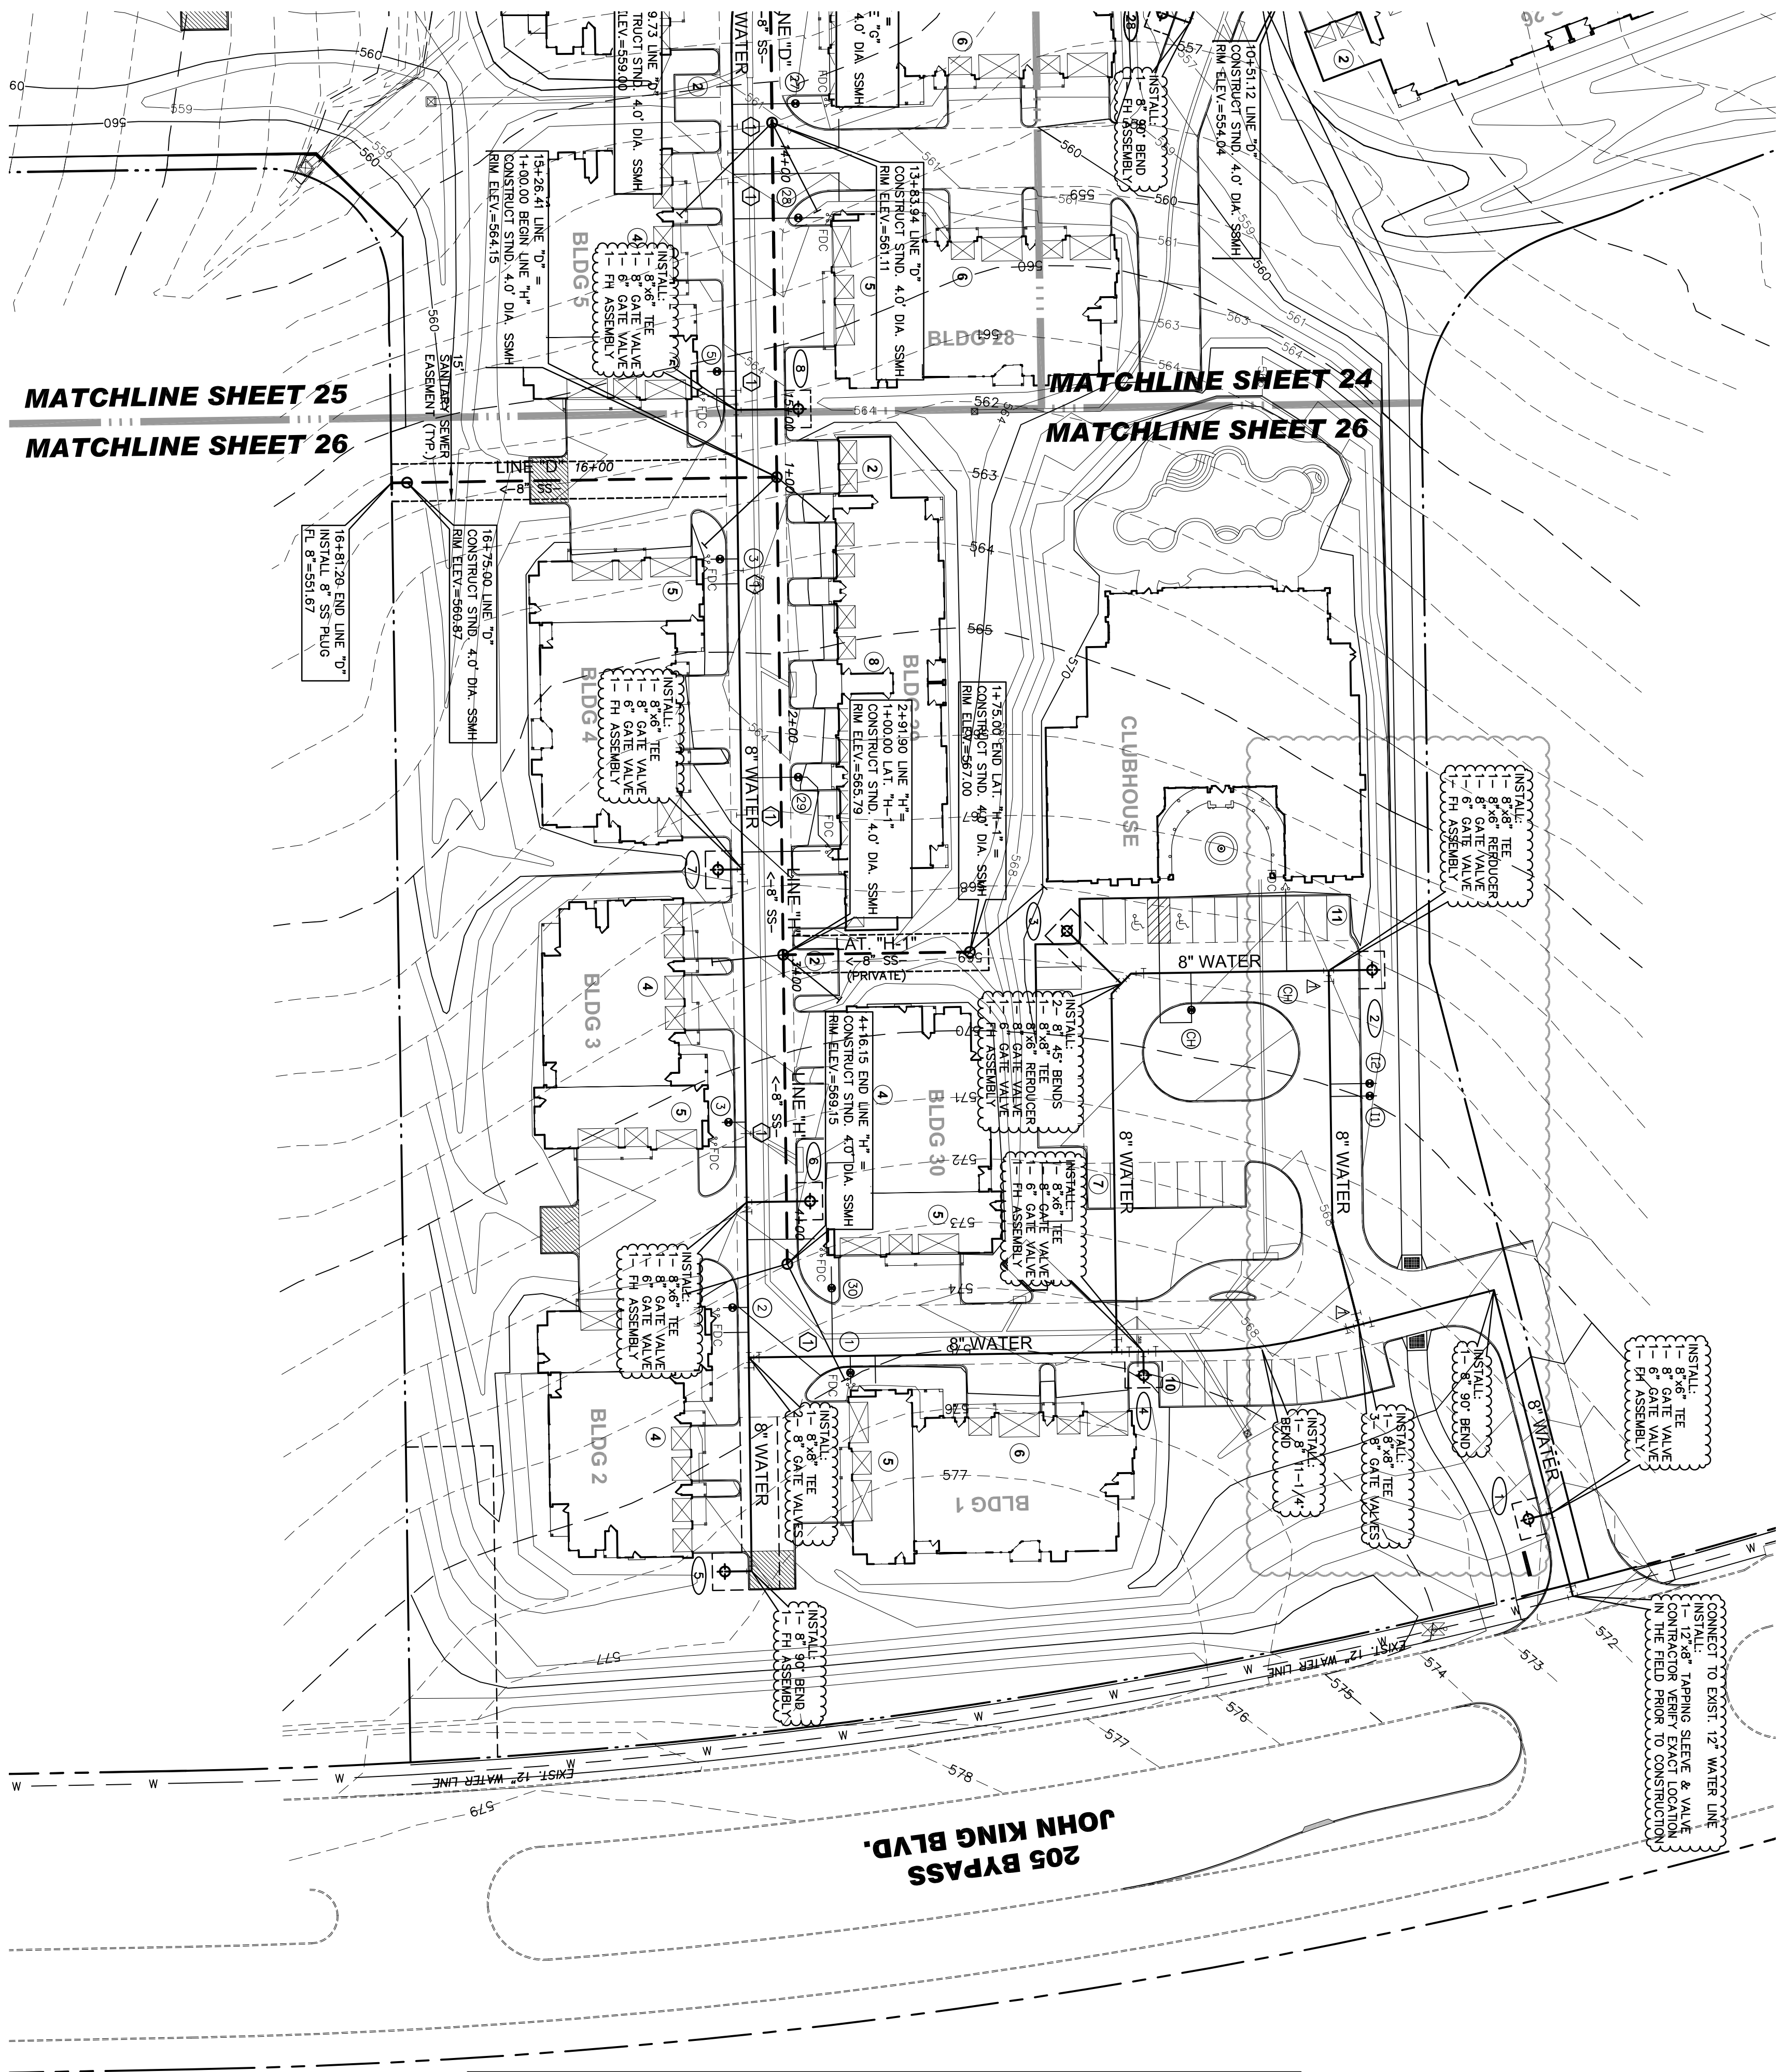

RECORD DRAWING
RECORD INFORMATION PROVIDED BY
CONASTER CONSTRUCTION, FORT WORTH, TEXAS
ELEVATION VERIFICATION PERFORMED BY
SURVEY CONSULTANTS, INC., PLANO, TEXAS

RKM
RKM Consulting Engineers, Inc.
7616 LBJ Freeway, Suite 500
Dallas, Texas 75261
phone (214) 434-8070
fax (214) 434-8069
www.rkme.com

CHECKED DESIGN JRY
DRAWN JRY
JOB 1026-005
DATE 05/27/09
SCALE 1"=40'
SHEET 26 OF 33