



SANITARY SEWER LINE "F"

SANITARY SEWER LINE "G"

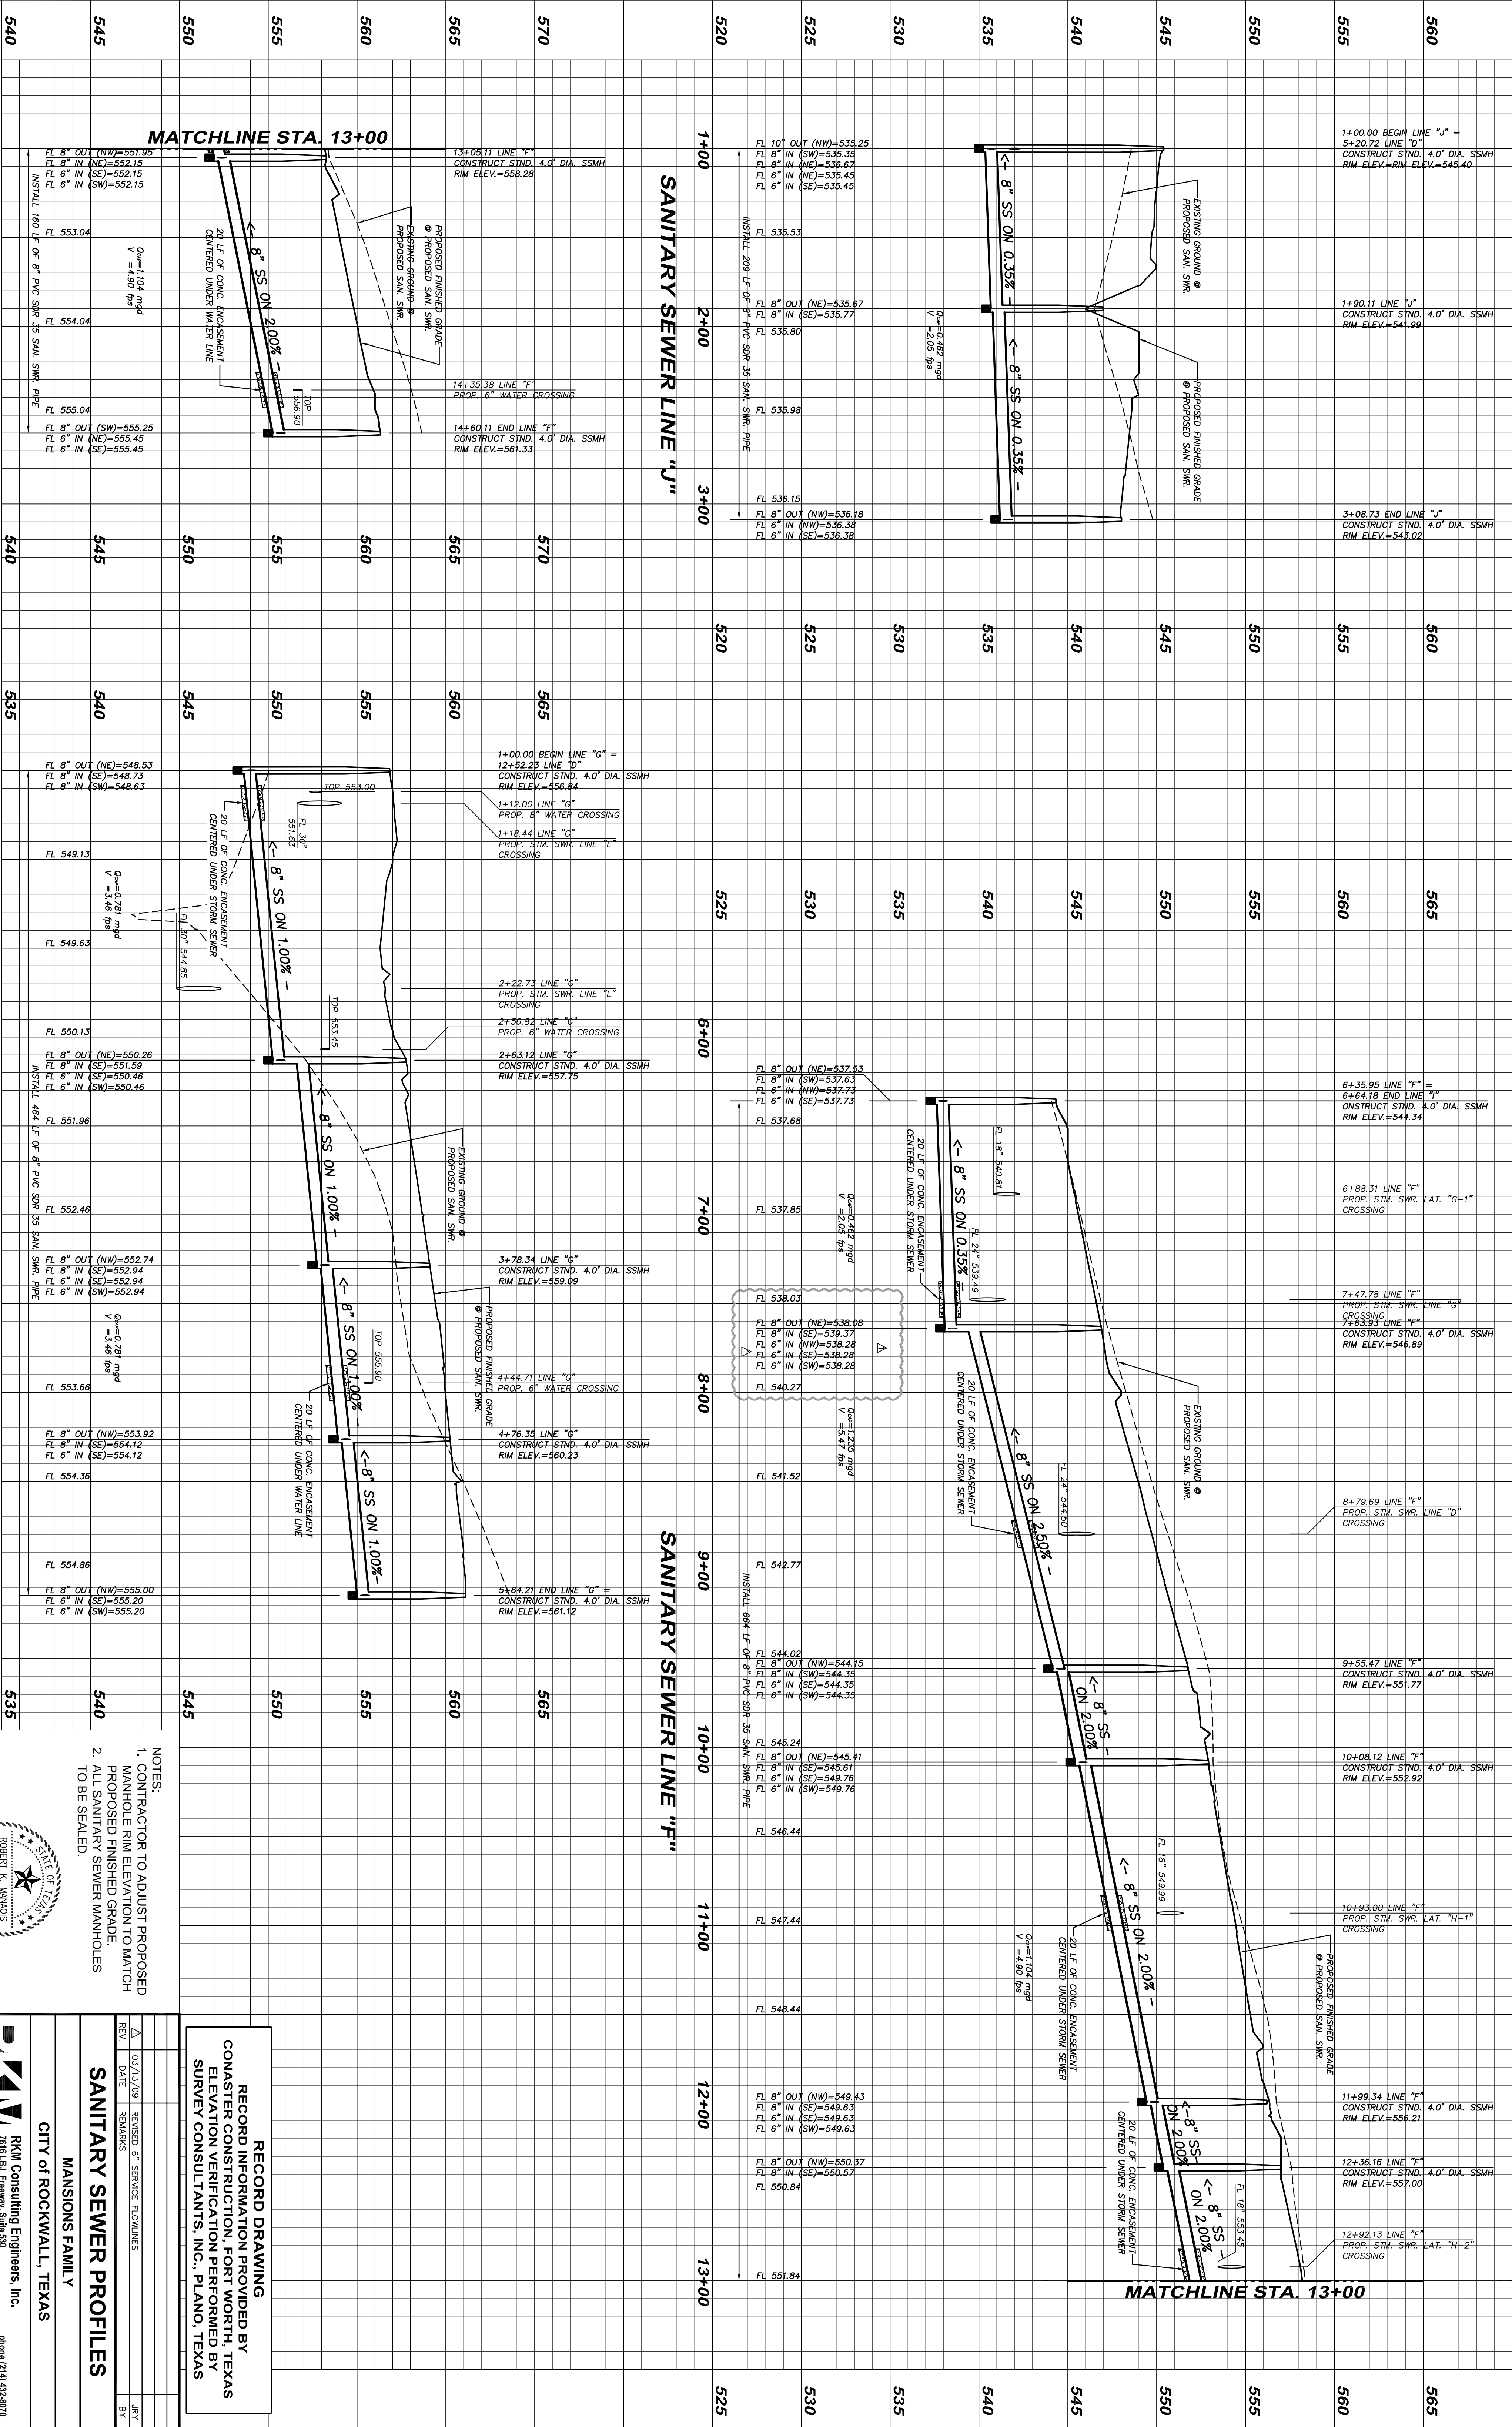

NOTES:
1. CONTRACTOR TO ADJUST PROPOSED MANHOLE RIM ELEVATION TO MATCH PROPOSED FINISHED GRADE.
2. ALL SANITARY SEWER MANHOLES TO BE SEALED.

RECORD DRAWING
RECORD INFORMATION PROVIDED BY
CONASTER CONSTRUCTION, FORT WORTH, TEXAS
ELEVATION VERIFICATION PERFORMED BY
SURVEY CONSULTANTS, INC., PLANO, TEXAS

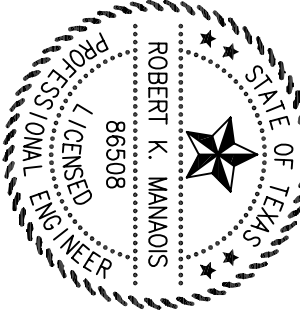

RKM
Robert K. Manolis
7616 LBJ Freeway, Suite 500
Dallas, Texas 75241
phone (214) 432-8070
fax (214) 432-8069
www.rkmce.com

RECORD INFORMATION PROVIDED BY
CONASTER CONSTRUCTION, FORT WORTH, TEXAS
ELEVATION VERIFICATION PERFORMED BY
SURVEY CONSULTANTS, INC., PLANO, TEXAS

RECORD DRAWING
RECORD INFORMATION PROVIDED BY
CONASTER CONSTRUCTION, FORT WORTH, TEXAS
ELEVATION VERIFICATION PERFORMED BY
SURVEY CONSULTANTS, INC., PLANO, TEXAS

REVISIONS
REV. DATE BY
1. 02/13/09 REVISED 6" SERVICE FLOWLINES
2. 05/27/09 1"=40' (H)
3. 05/27/09 1"=40' (V)

CITY OF ROCKWALL, TEXAS
MANSIONS FAMILY
RKM Consulting Engineers, Inc.
7616 LBJ Freeway, Suite 500
Dallas, Texas 75241
phone (214) 432-8070
fax (214) 432-8069
www.rkmce.com

CHECKED DESIGN DRAWN DATE SCALE SHEET
JRY JRY 1026-005 05/27/09 1"=40' (H) 28 OF 33