

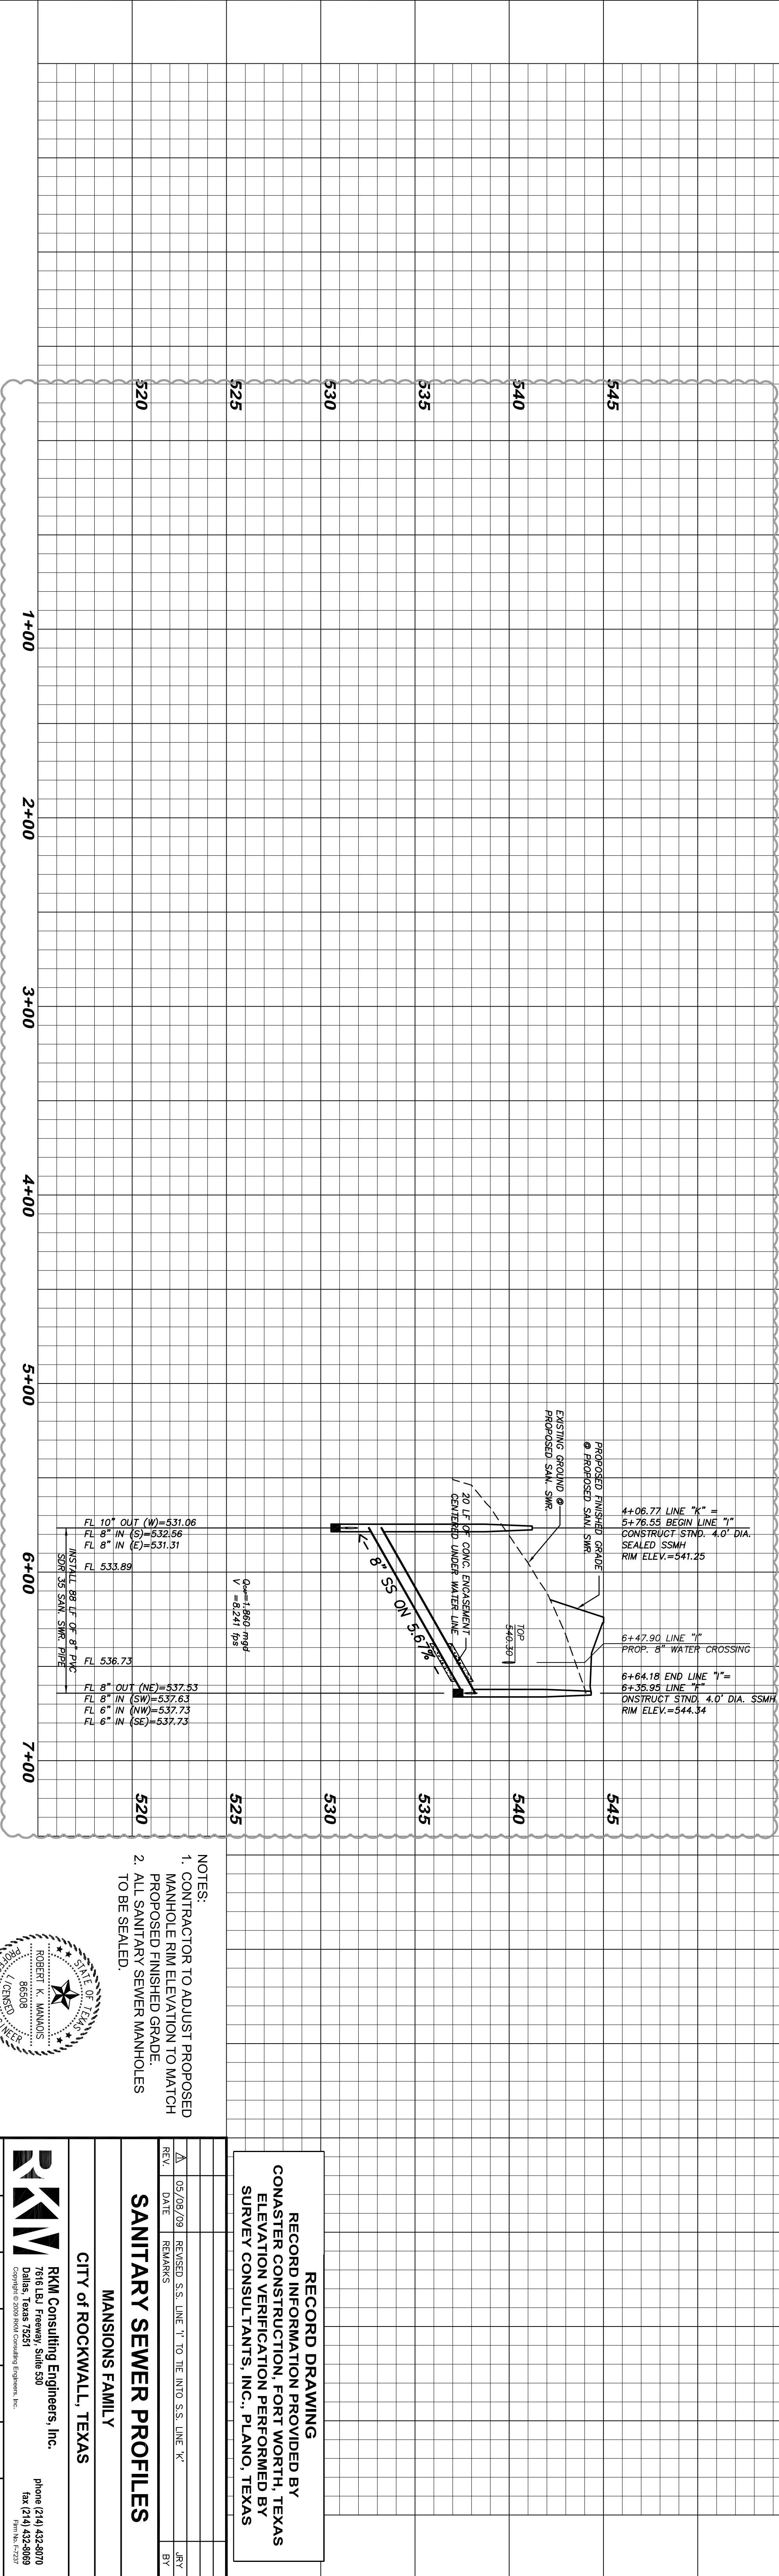
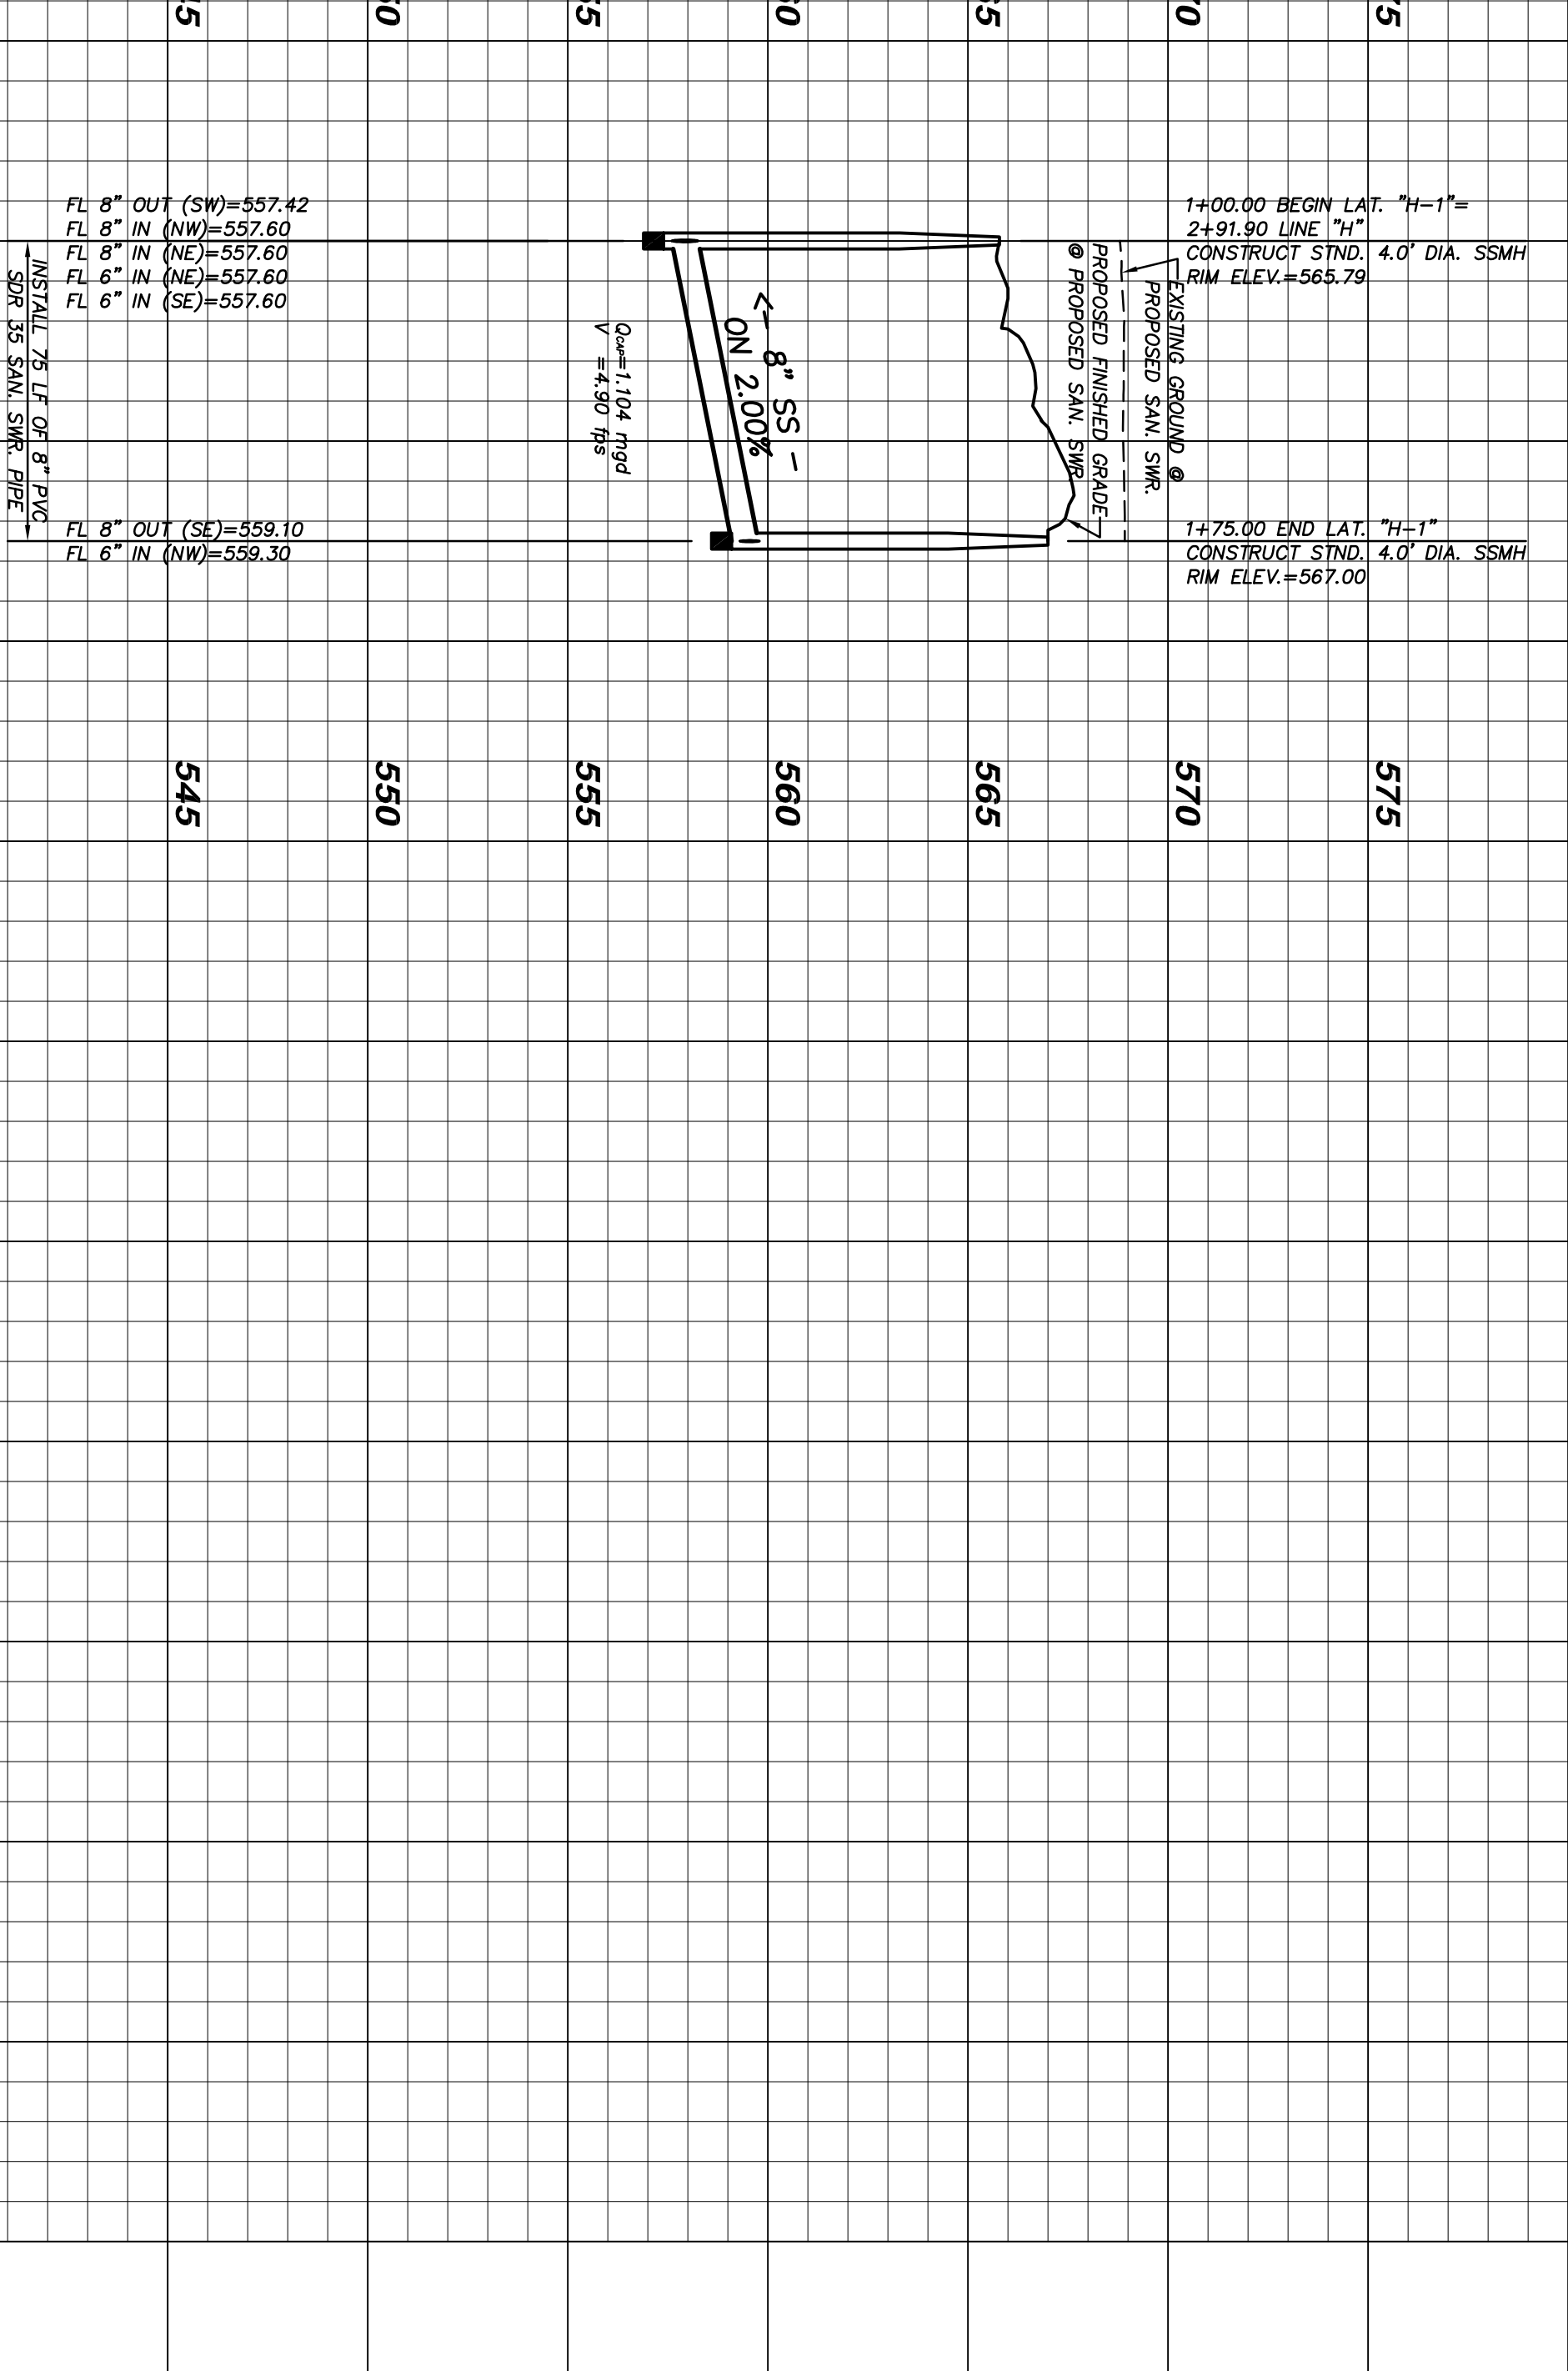


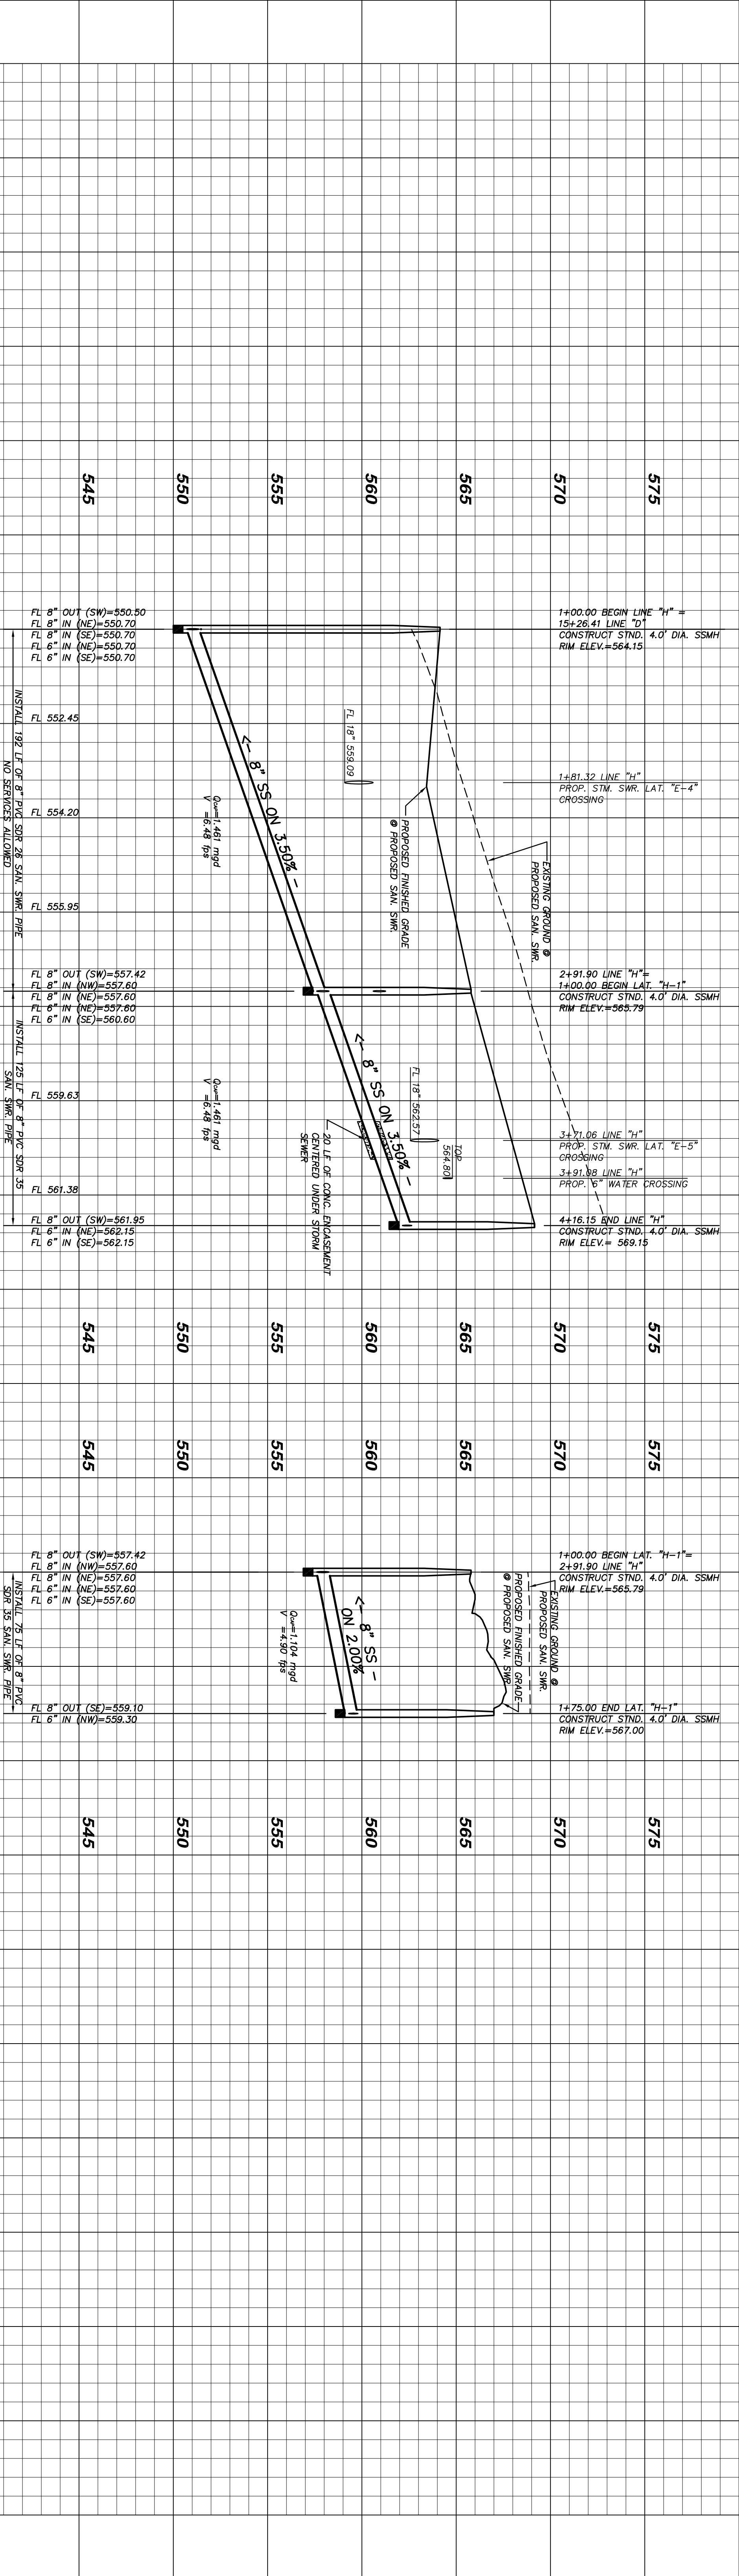

- NOTES:
1. CONTRACTOR TO ADJUST PROPOSED MANHOLE RIM ELEVATION TO MATCH PROPOSED FINISHED GRADE.
 2. ALL SANITARY SEWER MANHOLES TO BE SEALED.

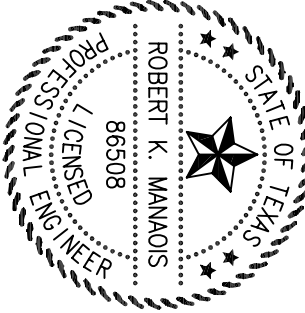

RECORD DRAWING

RECORD INFORMATION PROVIDED BY
CONASTER CONSTRUCTION, FORT WORTH, TEXAS
ELEVATION VERIFICATION PERFORMED BY
SURVEY CONSULTANTS, INC., PLANO, TEXAS

DATE	05/09/09	REVISION	S.S. LINE "I" TO THE INTO S.S. LINE "K"
REV	DATE	REMARKS	BY
1	05/09/09	DESIGN	JRY
2	05/27/09	DRAWN	JRY
3	05/27/09	CHECKED	RKM

CITY of ROCKWALL, TEXAS

RKM Consulting Engineers, Inc.

7616 LBJ Freeway, Suite 500
Dallas, Texas 75261
86508

phone (214) 432-8070
fax (214) 432-8069
www.rkmce.com

MANSON'S FAMILY

SANITARY SEWER PROFILES

CHECKED

DESIGN

JRY

DATE

05/27/09

SCALE

1"=40' (H)
1"=4' (V)

SHEET

29

OF 33