
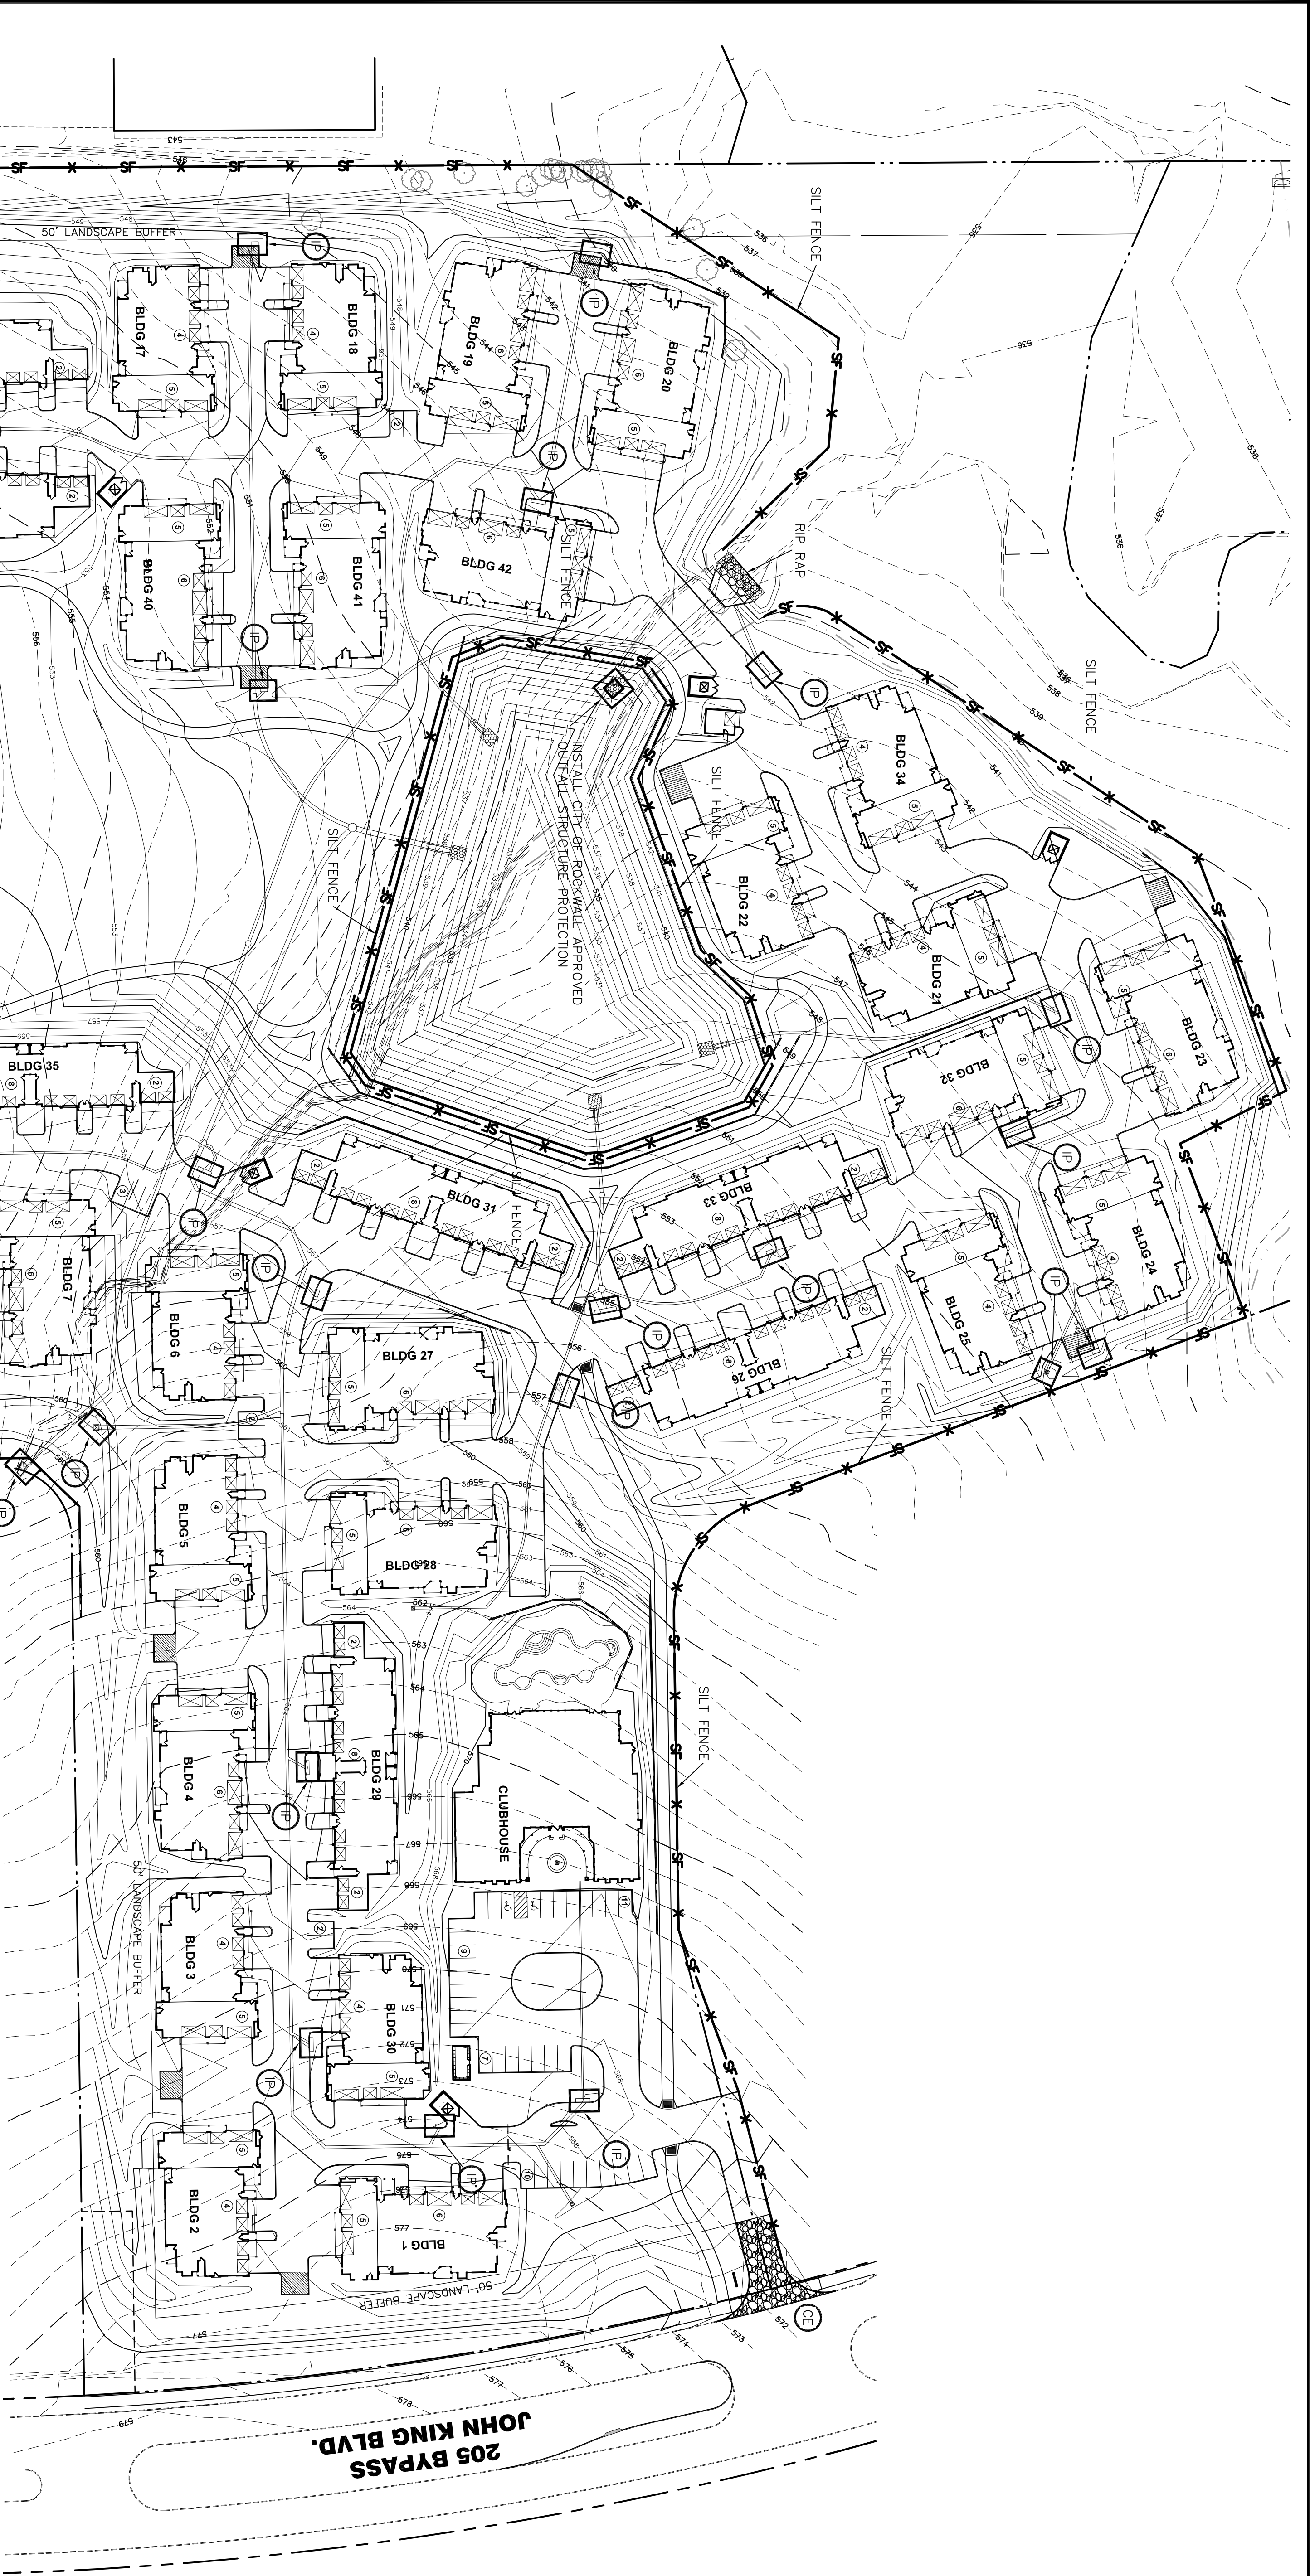
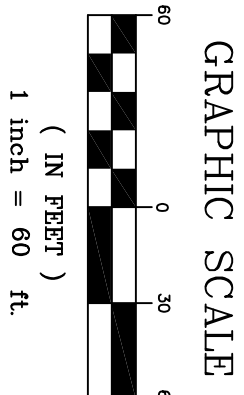


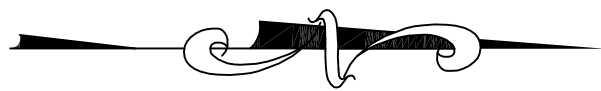

LEGEND

IP INLET PROTECTION DEVICE (SEE DETAIL SHEET)

SF SILT FENCING (SEE DETAIL SHEET)

CE CONSTRUCTION ENTRANCE (SEE DETAIL SHEET)

TOTAL SITE AREA: 32.65 AC

TOTAL IMPACTED AREA: 28.93 AC

RECORD DRAWING

RECORD INFORMATION PROVIDED BY
CONASTER CONSTRUCTION, FORT WORTH, TEXAS
ELEVATION VERIFICATION PERFORMED BY
SURVEY CONSULTANTS, INC., PLANO, TEXAS

REV.	DATE	REMARKS	BY

MANSON'S FAMILY
CITY OF ROCKWALL, TEXAS

RKM Consulting Engineers, Inc.
7616 LBJ Freeway, Suite 500
Dallas, Texas 75261
phone (214) 432-8070
fax (214) 432-8069
www.rkmce.com



CHECKED	DESIGN	DRAWN	JOB	DATE	SCALE	SHEET
RKM	JRY	JRY	1026-005	05/27/09	1"=60'	30 OF 33