


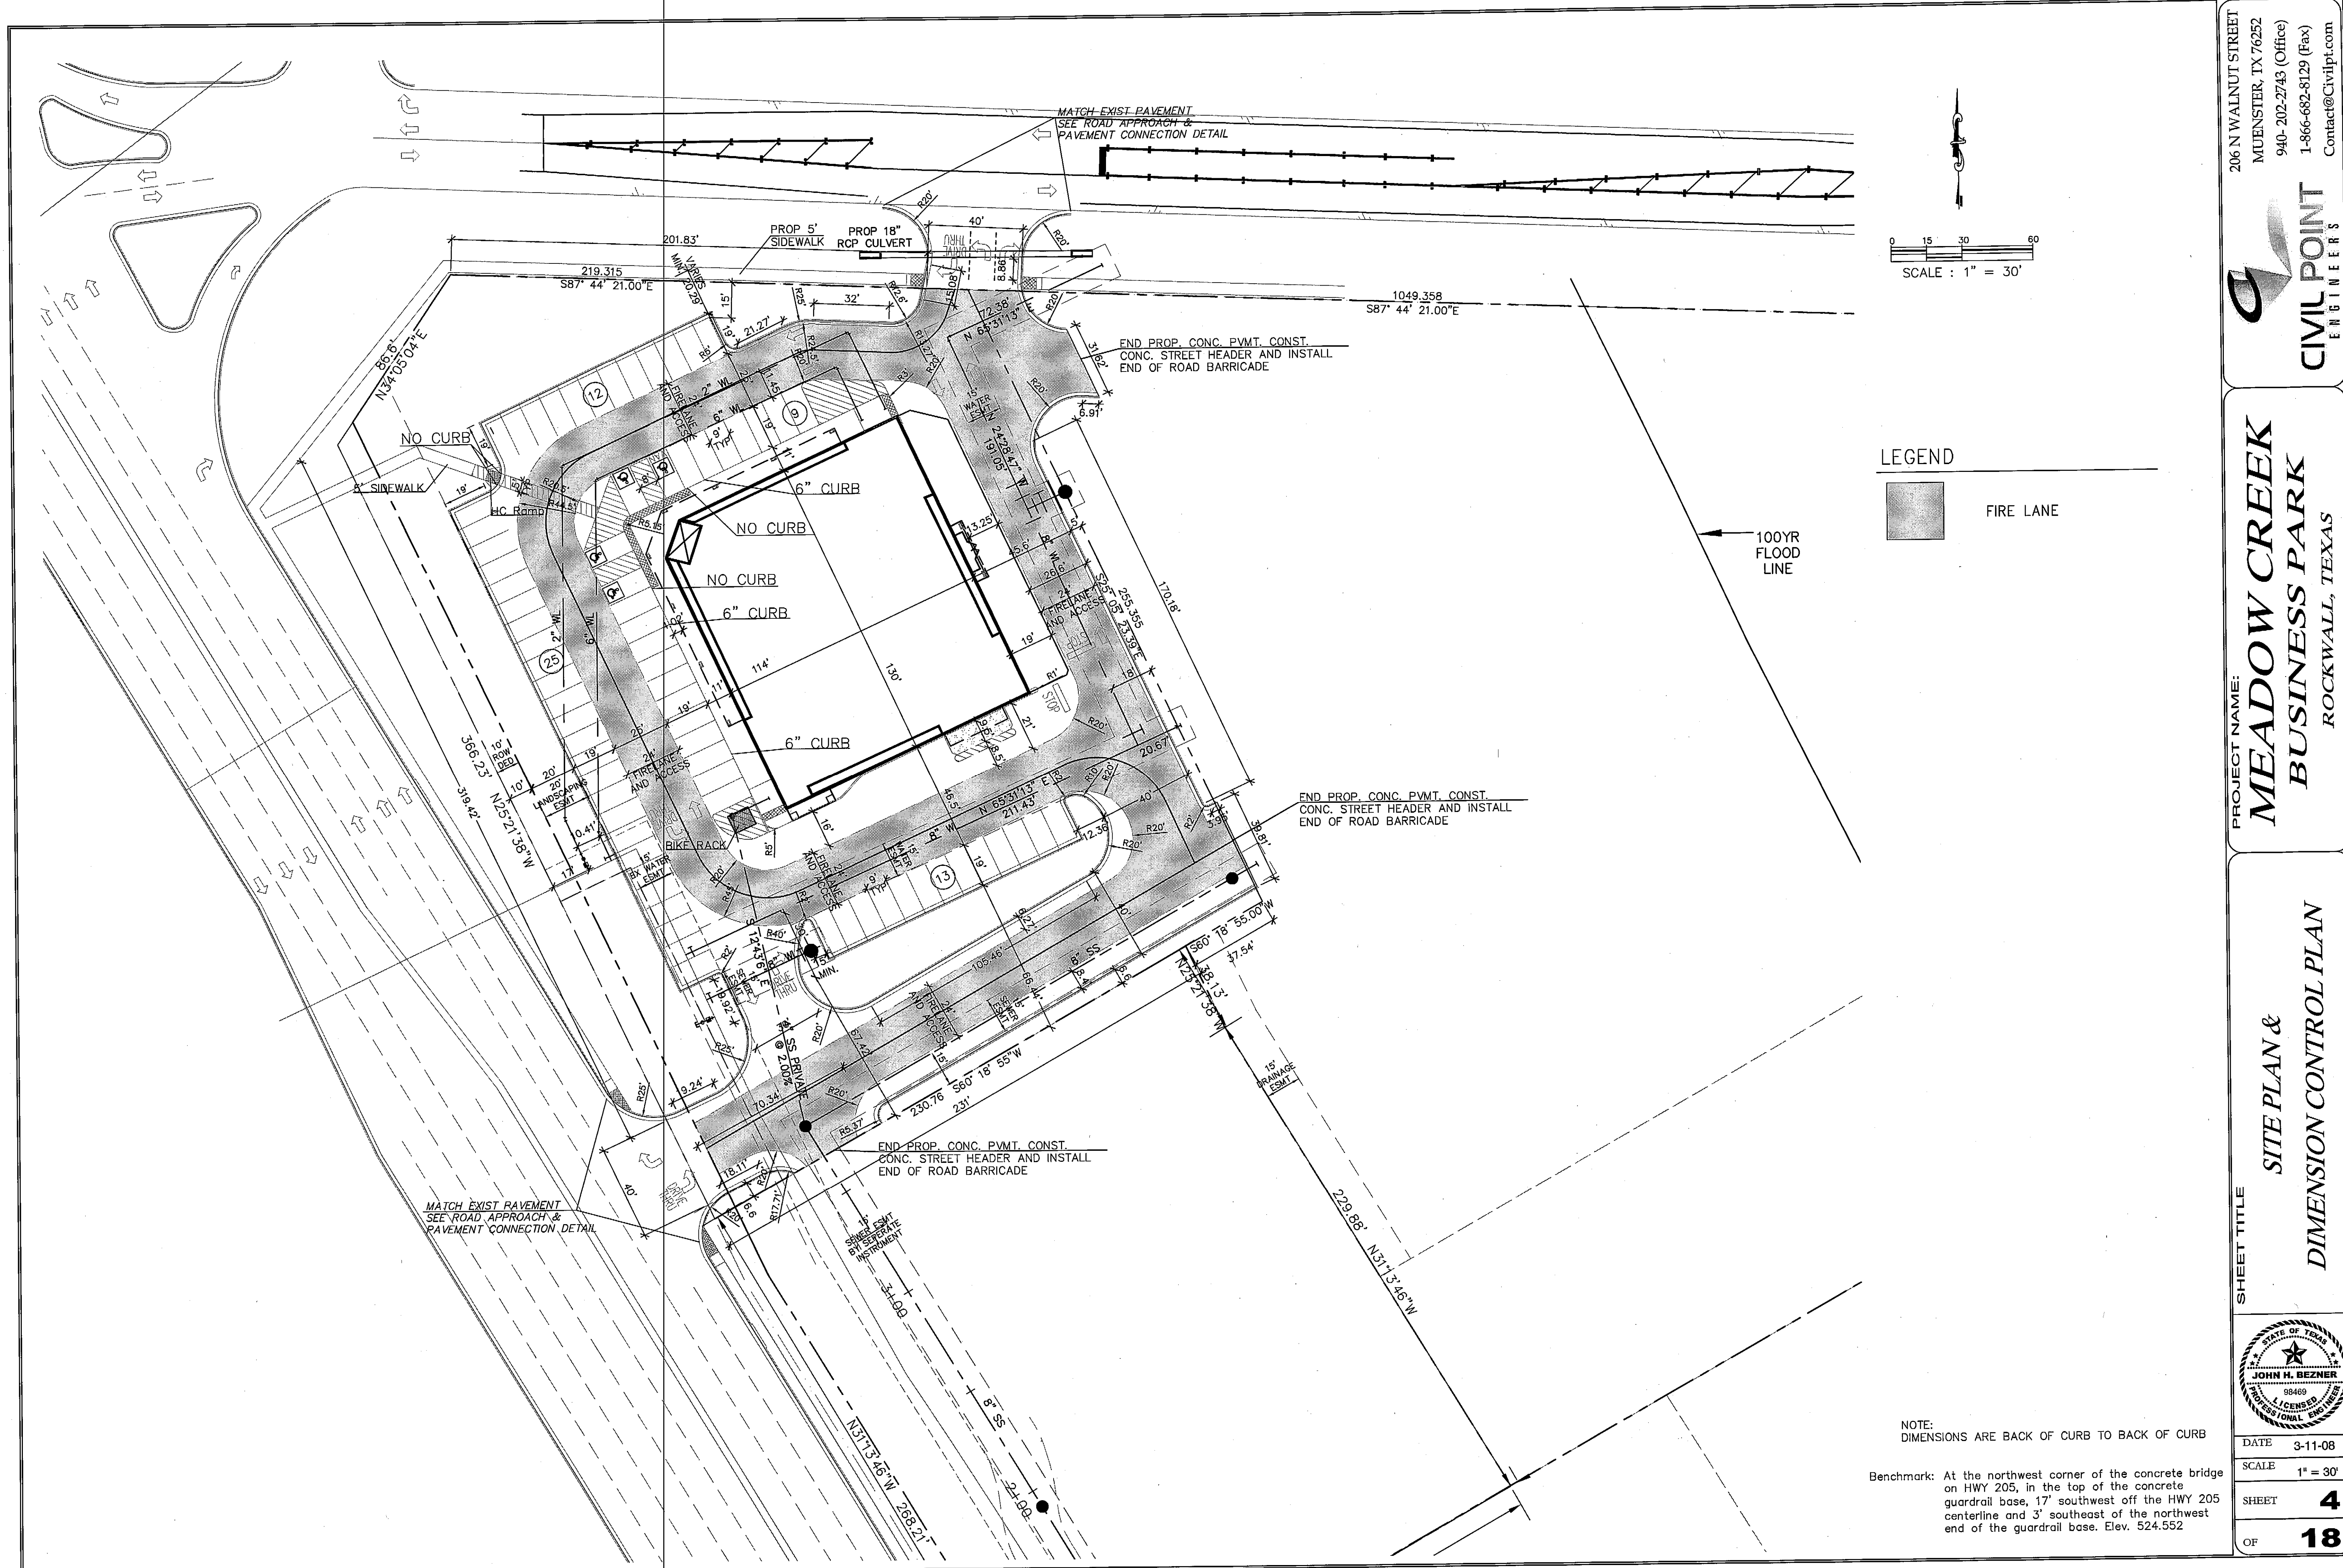

NOTE:
DIMENSIONS ARE BACK OF CURB TO BACK OF CURB


Benchmark: At the northwest corner of the concrete bridge on HWY 205, in the top of the concrete guardrail base, 17' southwest off the HWY 205 centerline and 3' southeast of the northwest end of the guardrail base. Elev. 524.552

206 N WALNUT STREET
MUEENSTER, TX 76252
940-202-2743 (Office)
1-866-682-8129 (Fax)
Contact@Civilpt.com

**CIVIL POINT**
ENGINEERS

PROJECT NAME:
**MEADOW CREEK
BUSINESS PARK**
ROCKWALL, TEXAS

SHEET TITLE
SITE PLAN &
DIMENSION CONTROL PLAN

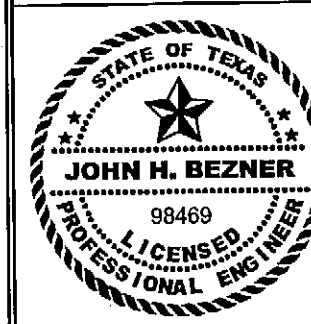

DATE 3-11-08
SCALE 1" = 30'
SHEET **4**
OF **18**