



CHANNEL CROSS-SECTION A-A

NTS

NOTE:
SEE CHANNEL CROSS SECTIONS ON SHEET 11

Benchmark: At the northwest corner of the concrete bridge on HWY 205, in the top of the concrete guardrail base, 17' southwest off the HWY 205 centerline and 3' southeast of the northwest end of the guardrail base. Elev. 524.552


PROJECT NAME:

**MEADOW CREEK
BUSINESS PARK**

ROCKWALL, TEXAS

SHEET TITLE

GRADING PLAN

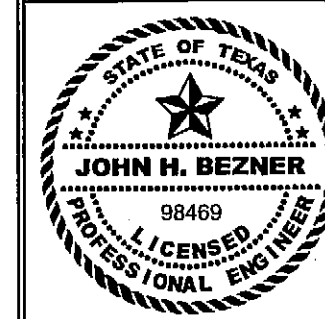

DATE 3-11-08

SCALE 1" = 30'

SHEET 7

OF 18

206 N WALNUT STREET
MUNSTER, TX 76252
940-202-2743 (Office)
1-866-682-8129 (Fax)
Contact@Civiltpt.com

**CIVIL POINT
ENGINEERS**