


TYPE I C

TYPE II A

— TYPE II AA

NOTE: 2" HMAC OVERLAY ON
ENTIRE SECTION OF PAVING
THAT WILL BE RESTRIPED

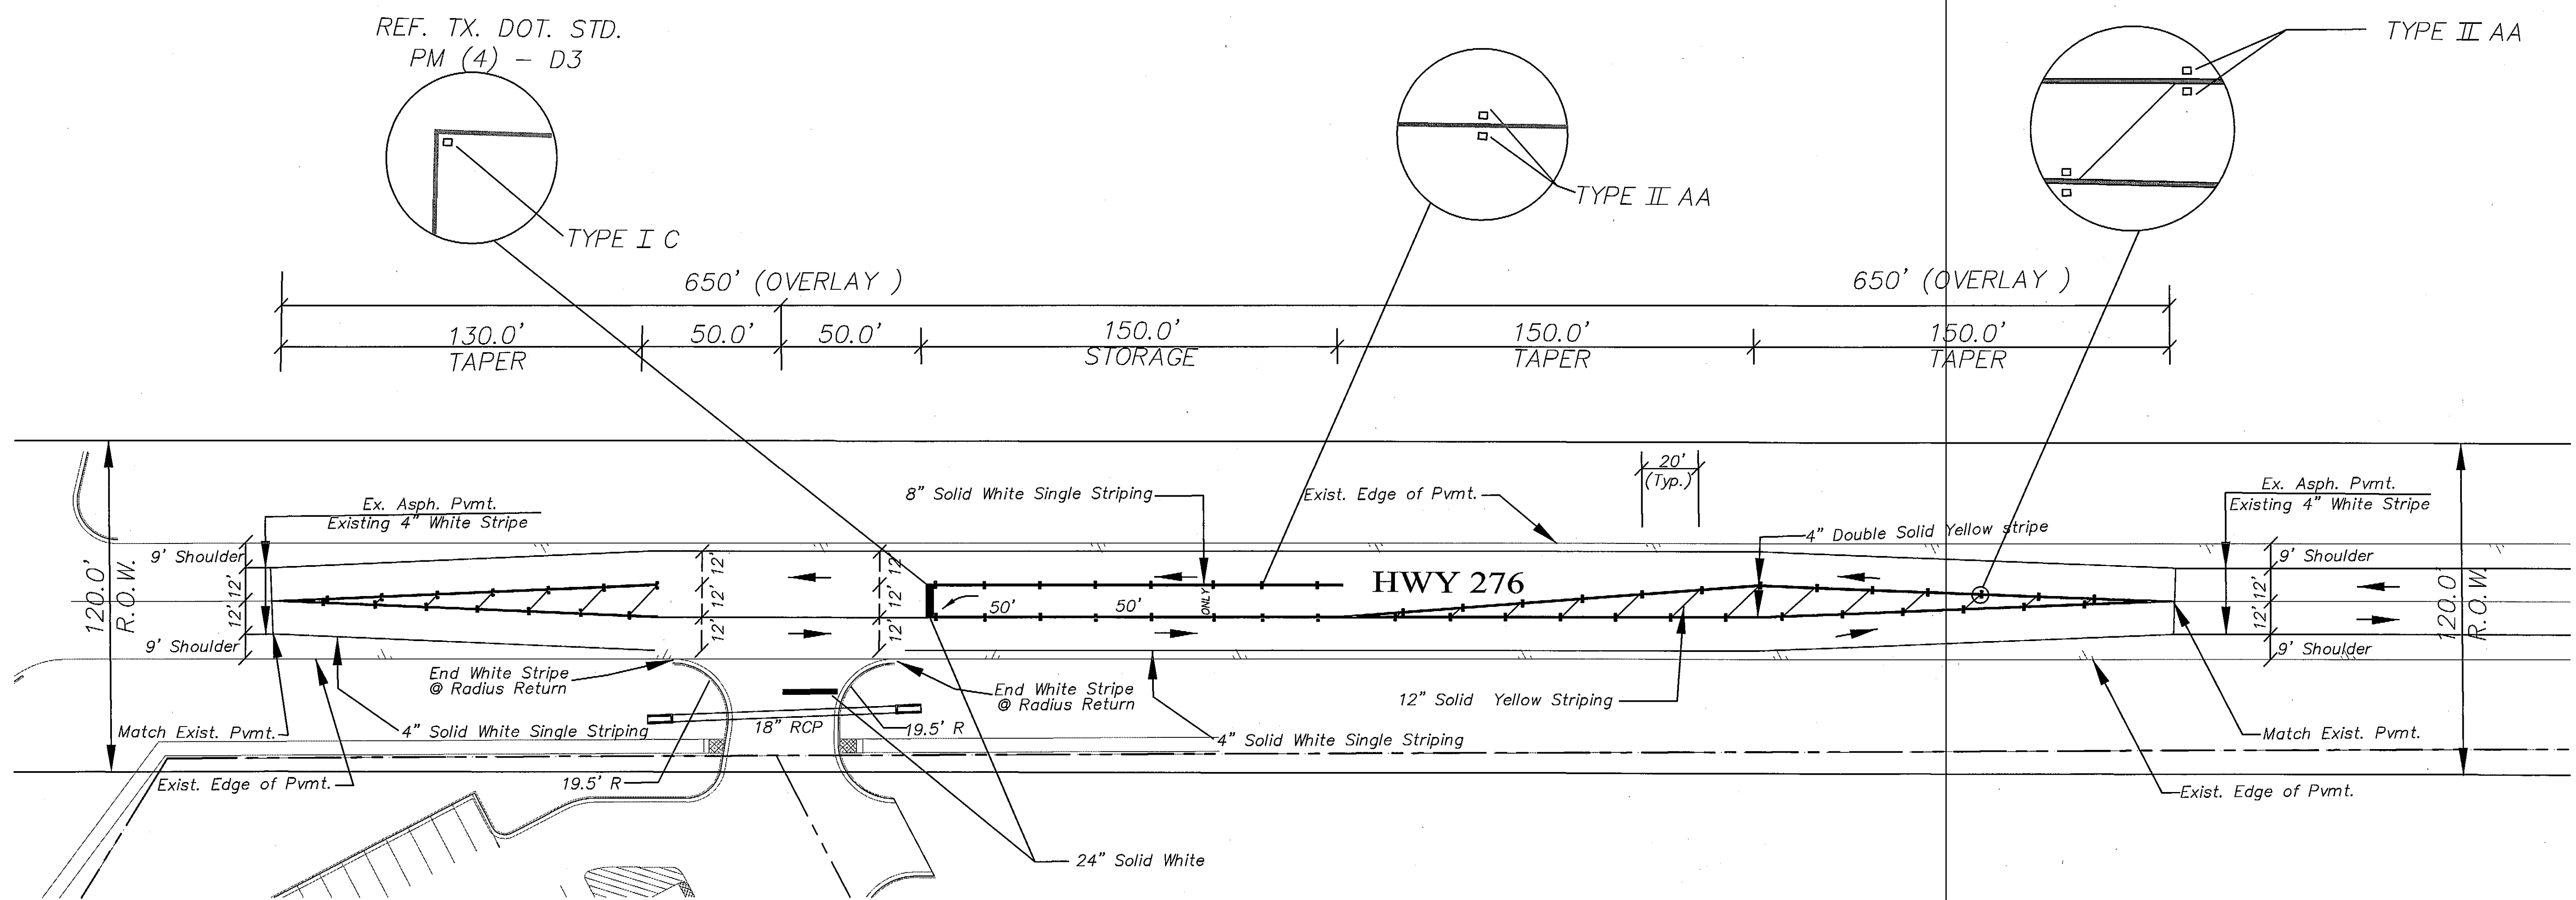

Benchmark: At the northwest corner of the concrete bridge on HWY 205, in the top of the concrete guardrail base, 17' southwest off the HWY 205 centerline and 3' southeast of the northwest end of the guardrail base. Elev. 524.552

		206 N WALNUT STREET MUEENSTER, TX 76252 940- 202-2743 (Office) 1-866-682-8129 (Fax) Contact@Civilpt.com	
PROJECT NAME: MEADOW CREEK BUSINESS PARK ROCKWALL, TEXAS			
SHEET TITLE HWY 276 TURN LANE PLAN			
			
DATE	3-11-08		
SCALE	1" = 30'		
SHEET	13		
OF	18		