FOR


MEADOWCREK

ESTATES

CITY OF ROCKWALL, TEXAS

GENERAL NOTES

- All street and alleys intersections and connections shall be built by the developer.
- Excavation from streets to be deposited in low areas to allow proper drainage, except existing creek.
- All existing ditches, except as noted on drainage plans, are to be filled to conform to surrounding terrain.
- 4. It will be the responsibilty of the developer and/ or the contractor to protect and maintain to proper line and grade all public utilities, manholes, cleanouts, valve boxes, fire hydrants, etc. during the construction of this project, prior to and after placing permanent pavement.
- 5. All materials and workmanship shall conform to the City Standards and Specifications.

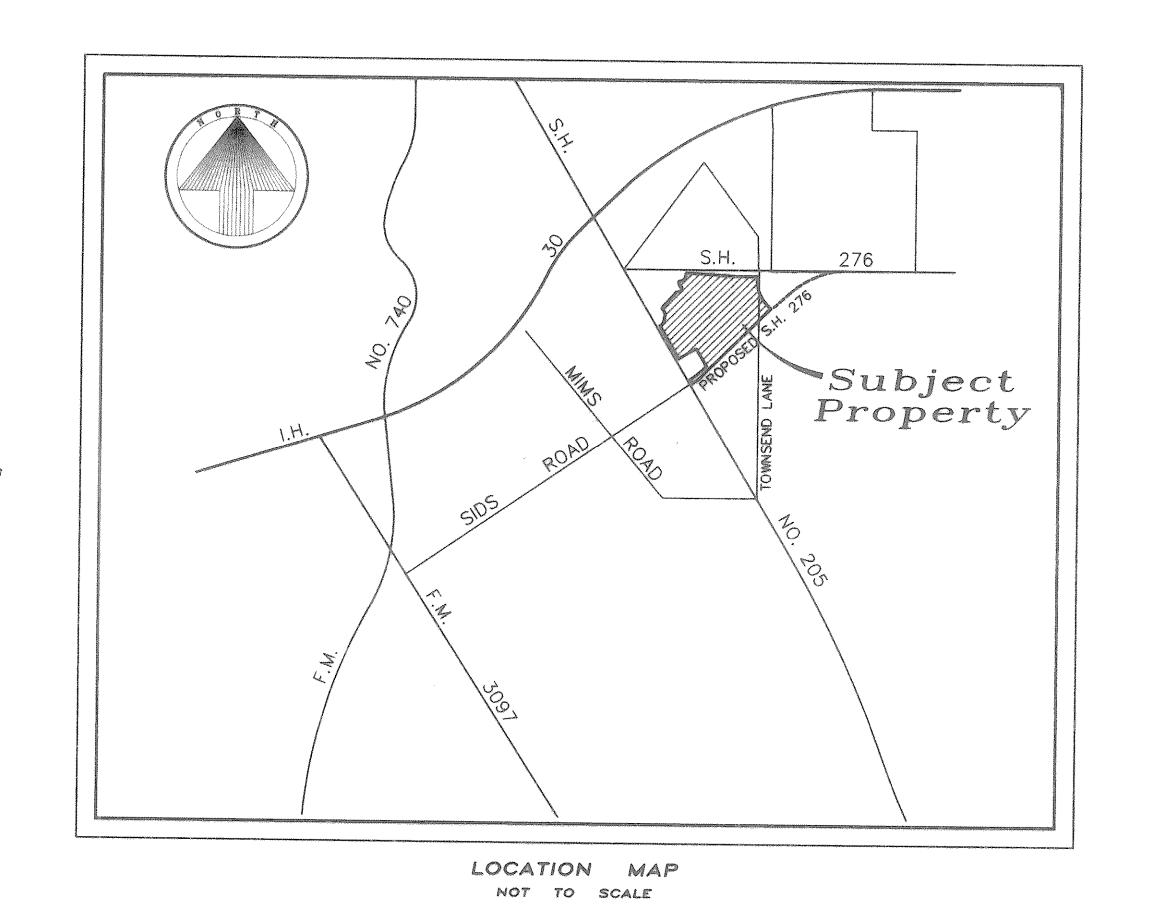

INDEX

Sheet No.	Description	
1-3 4-12 13-14 15 15B 16 17-22	Final Plat Paving Plans Alley Profiles Drainage Area Map Offsite Drainage Area Map Inlet Calculation Chart Storm Sewer Plans	*
24-25 26 27-29 30A-30B	Water & Sewer Plan Sanitary Sewer Profiles Stormwater Pollution Prevention Lot Grading Plans Traffic Control Plans	Plan


PREPARED FOR

2800 Surveyor Boulevard ~ Carrollton, Texas 75006



TIPTON ENGINEERING,

Broadway Blvd. ~ Suite C ~ Garland, Texas 75043

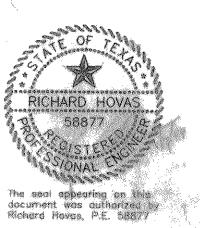

AS BUILT PLANS