
FOR

MEADOWCREEK ESTATES PHASE IV

TEXAS CITY OF ROCKWALL,

- 3. All existing ditches, except as noted on drainage plans,
- 4. It will be the responsibilty of the developer and/ or the contractor to protect and maintain to proper line and grade all public utilities, manholes, cleanouts, valve boxes, fire hydrants, etc. during the construction of this project, prior to and after placing permanent pavement.
- 5. All materials and workmanship shall conform to the City Standards and Specifications.
- 6. Fill shall be compacted with sheepsfoot roller.

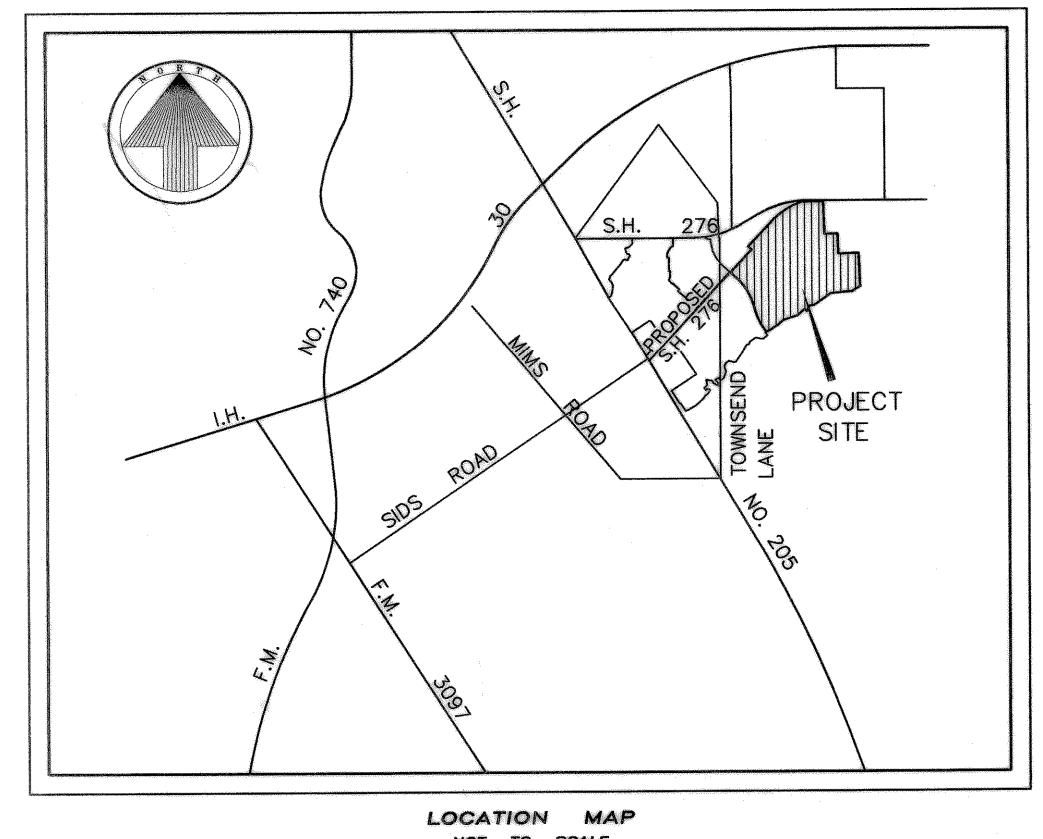

NOT TO SCALE

INDEX

Sheet No.	Description	
1-3	Final Plat	٠
4-17	Paving Plans	
18-20	Alley Profiles	
21	Drainage Area Map	;
22	Inlet Calculation Chart	1
23-27	Storm Sewer Plans	:
28	Water & Sanitary Sewer Plan	
29A-29B	Sanitary Sewer Profiles	
30	Stormwater Pollution Prevention	Plan
31-34	Lot Grading Plans	
35	Traffic Control Plans	

AS BUILT PLANS 03/28/2002

The alignment and grade were set on the ground for construction per the plans. The engineer did not verify alignment or grades after construction. We are not aware of any changes or revisions to these plans during construction except as noted.

PREPARED FOR

2800 Surveyor Boulevard ~ Carrollton, Texas 75006 (972) 417-3562



TIPTON

ENGINEERING,

INC.

Suite C ~ Garland, Texas 75043 (972) 226-2967 Broadway Blvd. ~

