


CONSTRUCTION PLANS FOR  
NORTHGATE

40 RESIDENTIAL LOT SUBDIVISION  
AN ADDITION TO THE CITY OF ROCKWALL  
ROCKWALL COUNTY, TEXAS  
63.514 ACRES

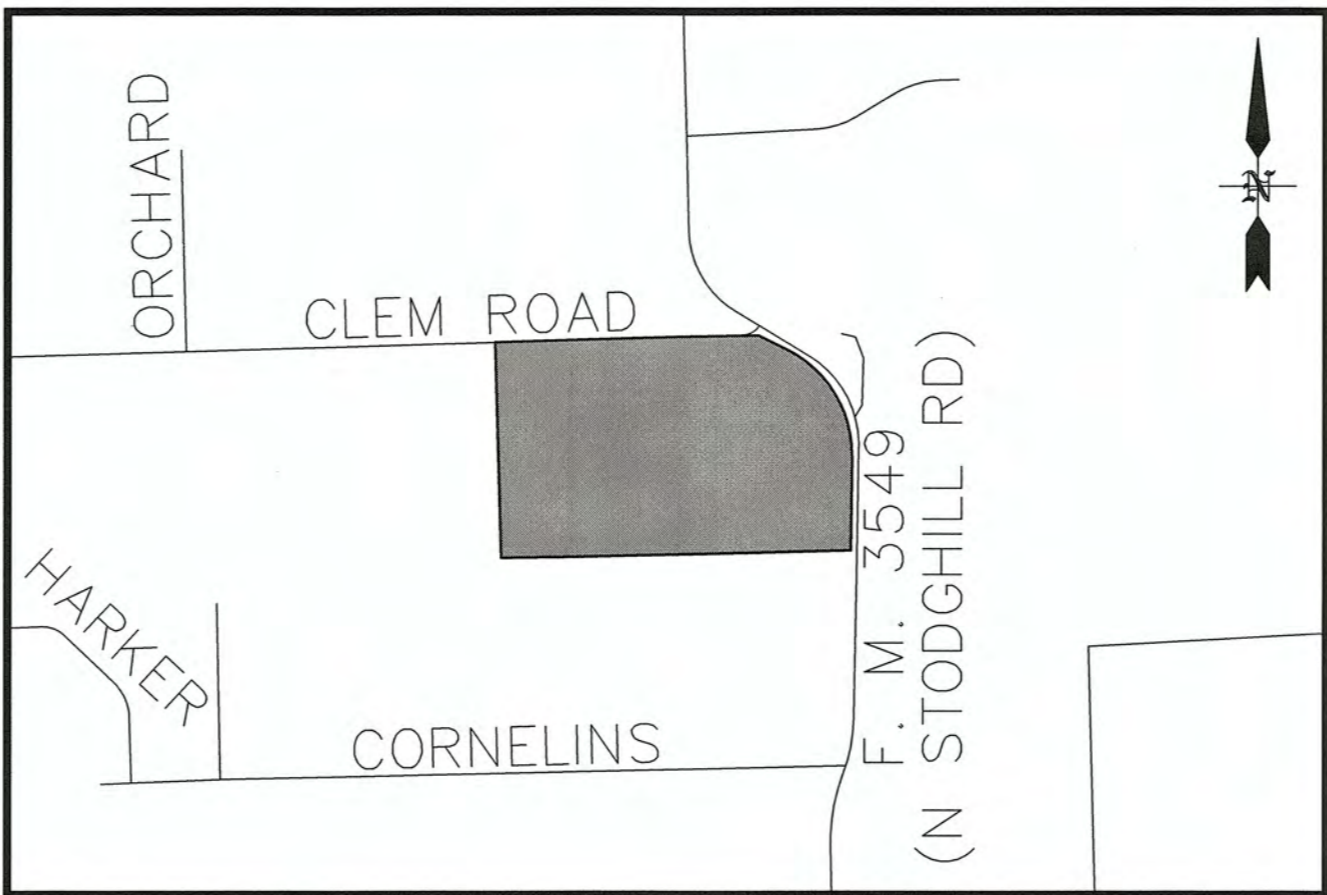

VICINITY MAP  
NOT TO SCALE

Sheet List Table	
Sheet Number	Sheet Title
1	COVER SHEET
2	FINAL PLAT 1
3	FINAL PLAT 2
4	FINAL PLAT 3
5	GENERAL NOTES 1
6	GENERAL NOTES 2
7	PAVING PLAN – SANDERSON LANE
8	PAVING PLAN – BOYETT LANE
9	PAVING PLAN – TAUBER COURT
10	PAVING PLAN – CLEM ROAD
11	TRAFFIC CONTROL PLAN – CLEM ROAD
12	DETOUR PLAN
13	GRADING PLAN KEY MAP
14	GRADING PLAN 1
15	GRADING PLAN 2
16	GRADING PLAN 3
17	GRADING PLAN 4
18	DRAINAGE AREA EXISTING
19	DRAINAGE AREA PROPOSED
20	DETENTION POND 1
21	DETENTION POND 2
22	DETENTION POND 3
23	OVERALL STORM PLAN
24	STORM PLAN – DITCH A
25	STORM PLAN – DITCH B
26	STORM PLAN – DITCH C
27	STORM PLAN – DITCH D 0+00 – 12+50
28	STORM PLAN – DITCH D 12+50 – END
29	DRAINAGE CALCULATIONS
30	WATER PLAN
31	STREET LIGHT AND SIGNAGE PLAN
32	EROSION CONTROL PLAN
33	EROSION CONTROL DETAILS
34	PAVING DETAILS 1
35	PAVING DETAILS 2
36	WATER DETAILS 1
37	WATER DETAILS 2
38	STORM DETAILS 1
39	STORM DETAILS 2
40	DETENTION POND DETAILS
LS	LANDSCAPE PLANS & DETAILS

PROBABLE CONSTRUCTION DATE: JUNE 2020

ISSUED FOR CONSTRUCTION

6/1/2020

NORTHGATE  
THE CITY OF ROCKWALL, ROCKWALL COUNTY, TEXAS

SHEET  
1  
OF  
40

CONTACT INFORMATION:

Mayor: Jlm Pruitt  
Rockwall Engineer and Public Works:  
Amy Williams, P.E. (972) 771-7746  
City Manager:  
Rick Crowley (972) 771-7700

\*ALL RESPONSIBILITY FOR ADEQUACY OF DESIGN REMAINS WITH THE DESIGN ENGINEER. THE CITY OF ROCKWALL, IN REVIEWING AND RELEASING PLANS FOR CONSTRUCTION, ASSUMES NO RESPONSIBILITY FOR ADEQUACY OR ACCURACY OF DESIGN.

CAUTION! EXISTING UTILITIES

CONTRACTOR SHOULD CALL 1-800-DIG-TESS PRIOR TO BEGINNING ANY CONSTRUCTION ACTIVITIES FOR EXISTING UTILITY LOCATIONS. EXISTING UTILITIES AND UNDERGROUND FACILITIES INDICATED ON THESE PLANS HAVE BEEN LOCATED FROM REFERENCE INFORMATION. IT IS THE RESPONSIBILITY OF THE CONTRACTOR TO VERIFY BOTH HORIZONTALLY AND VERTICALLY THE LOCATION OF ALL EXISTING UTILITIES AND UNDERGROUND FACILITIES PRIOR TO CONSTRUCTION AND TO TAKE NECESSARY PRECAUTIONS IN ORDER TO PROTECT ALL FACILITIES ENCOUNTERED. THE CONTRACTOR SHALL PRESERVE AND PROTECT ALL EXISTING UTILITIES FROM DAMAGE DURING CONSTRUCTION.

BM-1: "PK"Nail on the south side of Clem Road, approximately 2275' west of the centerline intersection of Clem Road and FM 3549  
Elev.: 559.07'

BM-2: "PK"Nail in Clem Road, approximately 175' west of the centerline intersection of Clem Road and FM 3549  
Elev.: 584.83'

OWNER  
NORTHGATE ROCKWALL LD, L.P.  
1189 WATERS EDGE DRIVE  
ROCKWALL, TX 75087  
DEVELOPER  
NORTHGATE ROCKWALL LD, L.P.  
1189 WATERS EDGE DRIVE  
ROCKWALL, TX 75087



ENGINEERING / PROJECT MANAGEMENT /  
CONSTRUCTION SERVICES - FIRM REG. #F-001145  
201 WINDCO CIR, STE 200, WYLIE, TX 75098  
972-941-8400 FAX: 972-941-8401 WWW.ECDLP.COM

RECORD DRAWINGS

To the best of our knowledge Engineering Concepts & Design, L.P., hereby states that this plan is As-Built. This information provided is based on surveying at the site and information provided by the contractor.

*Ryan C. King*  
RYAN C. KING

*1/27/2021*  
DATE

REVISIONS:

1/25/2021 COMBINED LOTS A19 & A20  
1/26/2021 2-1" IRRIGATION METERS

DATE:


6/1/2020

PROJECT NO.: 08838

DWG FILE NAME: 08838 CV.DWG

THIS DOCUMENT IS RELEASED FOR THE PURPOSE OF CONSTRUCTION. THE SEAL APPEARING ON THIS DOCUMENT WAS AUTHORIZED BY RYAN C. KING, P.E. 123635



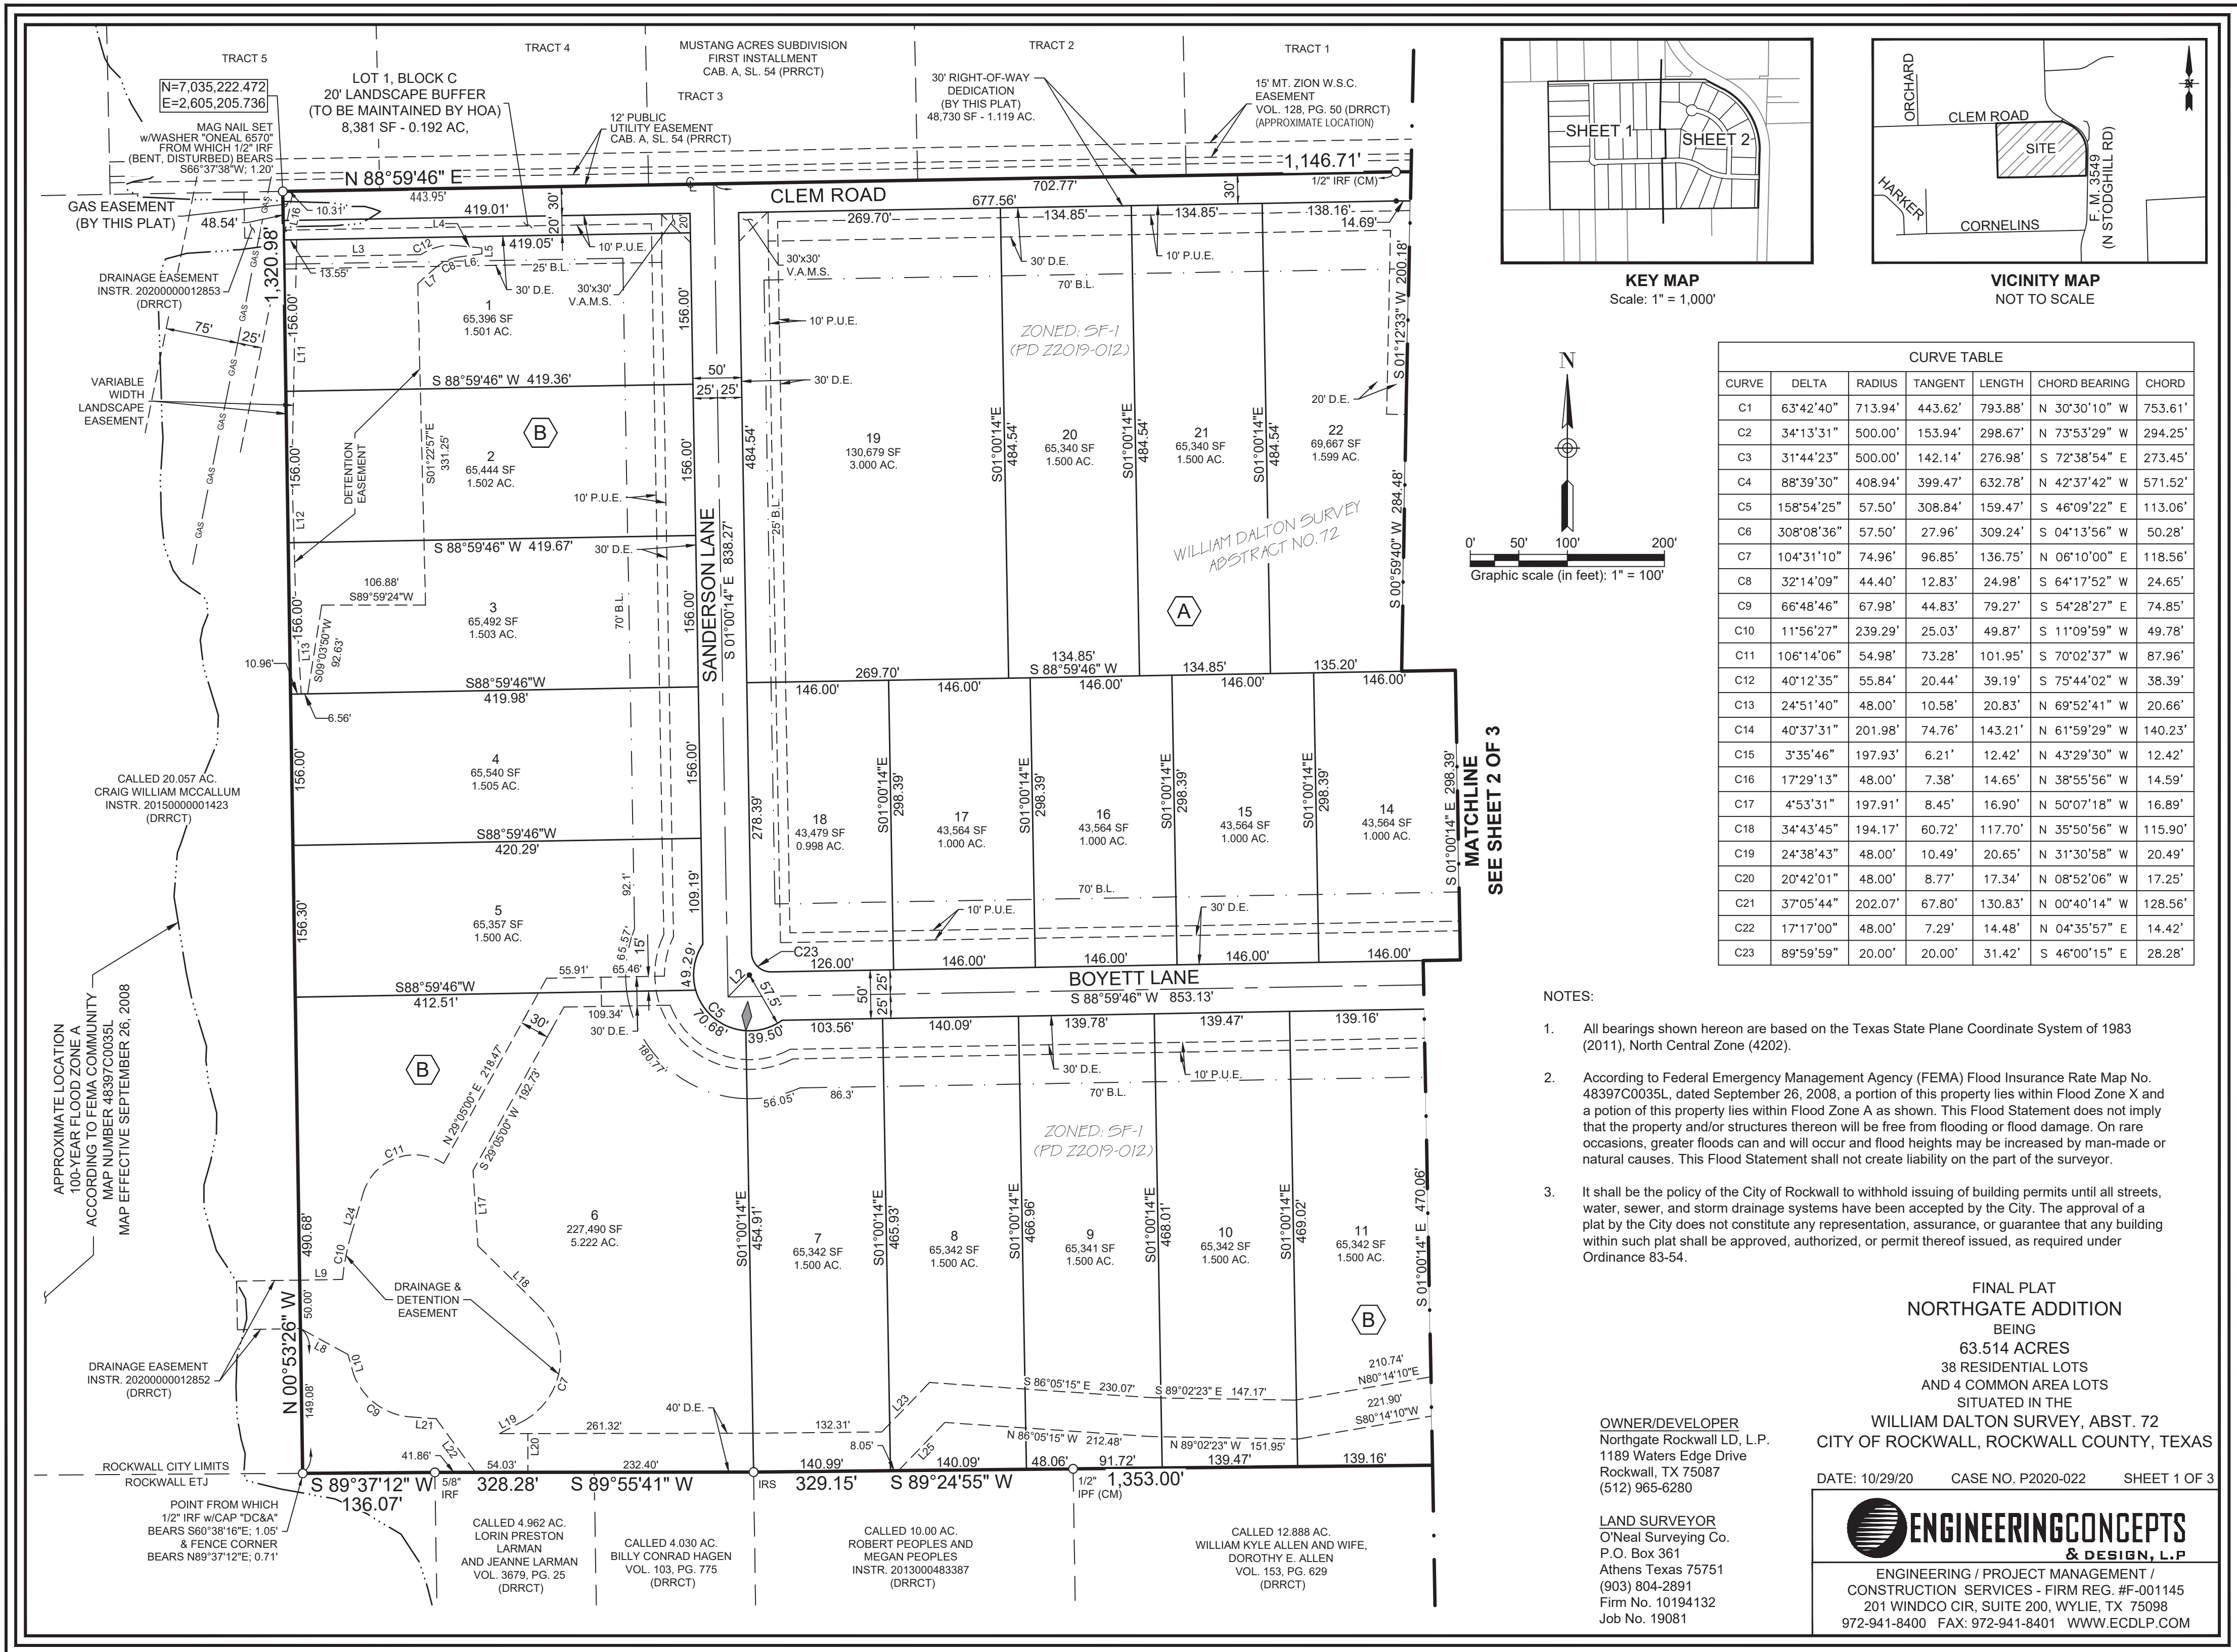



OWNER'S CERTIFICATION [Public Dedication]

STATE OF TEXAS §  
COUNTY OF ROCKWALL §

WHEREAS NORTHGATE ROCKWALL LD, L.P. AND REBECCA AIRHEART, BEING THE OWNERS OF A TRACT OF LAND IN THE COUNTY OF ROCKWALL, STATE OF TEXAS, SAID TRACT BEING DESCRIBED AS FOLLOWS:

**BEING** 63.514 ACRES OF LAND LOCATED IN THE WILLIAM DALTON SURVEY, ABSTRACT NUMBER 72, ROCKWALL COUNTY, TEXAS, BEING ALL OF THAT CERTAIN CALLED 62.517 ACRE TRACT AS DESCRIBED TO NORTHGATE ROCKWALL, LD, L.P., BY DEED RECORDED IN INSTRUMENT 2019000022936, DEED RECORDS, ROCKWALL COUNTY, TEXAS (D.R.R.C.T.) AND ALL OF THAT CERTAIN CALLED 1.00 ACRE TRACT AS DESCRIBED TO REBECCA AIRHEART BY DEED RECORDED IN INSTRUMENT NUMBER 20200000003814 (D.R.R.C.T.), AND BEING MORE PARTICULARLY DESCRIBED BY METES AND BOUNDS AS FOLLOWS:

**BEGINNING** AT A FENCE CORNER FOUND IN THE WEST LINE OF FARM-TO-MARKET ROAD 3549 (100' RIGHT-OF-WAY) AT THE SOUTHEAST CORNER OF THE ABOVE-MENTIONED 62.517 ACRE TRACT;

**THENCE** SOUTH 89 DEGREES 25 MINUTES 31 SECONDS WEST, AT A DISTANCE OF 484.49 FEET PASS 3.62 FEET RIGHT OF A 5/8" IRON PIPE FOUND AND CONTINUING FOR A TOTAL DISTANCE OF 1353.00 FEET WITH THE SOUTH LINE OF SAID 62.517 ACRE TRACT TO A 1/2" IRON PIPE FOUND AT THE NORTHWEST CORNER OF THE WILLIAM KYLE ALLEN ET UX 12.888 ACRE TRACT AS DESCRIBED IN VOLUME 153, PAGE 629, (D.R.R.C.T.) AND THE NORTHEAST CORNER OF THE ROBERT PEOPLES AND MEGAN PEOPLES 10.00 ACRE TRACT AS DESCRIBED IN INSTRUMENT NUMBER 2013000483387, (D.R.R.C.T.);

**THENCE** SOUTH 89 DEGREES 24 MINUTES 55 SECONDS WEST, A DISTANCE OF 329.15 FEET WITH THE SOUTH LINE OF SAID 62.517 ACRE TRACT TO A 1/2" IRON ROD WITH RED CAP STAMPED "ONEAL 6570" SET AT THE NORTHWEST CORNER OF THE ABOVE-MENTIONED 10.00 ACRE TRACT AND THE NORTHEAST CORNER OF THE BILLY CONRAD HAGEN 4.030 ACRE TRACT AS DESCRIBED IN VOLUME 103, PAGE 775, (D.R.R.C.T.);

**THENCE** SOUTH 89 DEGREES 55 MINUTES 41 SECONDS WEST, A DISTANCE OF 328.28 FEET WITH THE SOUTH LINE OF SAID 62.517 ACRE TRACT, SAME BEING THE COMMON NORTH LINE OF THE ABOVE-MENTIONED 4.030 ACRE TRACT AND THE LORIN PRESTON LARMAN AND JEANNE LARMAN 4.962 ACRE TRACT AS DESCRIBED IN VOLUME 3679, PAGE 25, (D.R.R.C.T.) TO A 5/8" IRON ROD FOUND AT THE NORTHWEST CORNER OF THE JUST MENTIONED 4.962 ACRE TRACT;

**THENCE** SOUTH 89 DEGREES 37 MINUTES 12 SECONDS WEST, A DISTANCE OF 136.07 FEET TO THE SOUTHWEST CORNER OF SAID 62.517 ACRE TRACT, SAME BEING THE COMMON SOUTHEAST CORNER OF THE CRAIG WILLIAM MCCALLUM 20.057 ACRE TRACT AS DESCRIBED IN INSTRUMENT NUMBER 20150000001423, (D.R.R.C.T.), FROM WHICH A 1/2" IRON ROD WITH CAP STAMPED "DC&A" BEARS SOUTH 60 DEGRES 38 MINUTES 16 SECONDS EAST, A DISTANCE OF 1.05 FEET AND A FENCE CORNER BEARS NORTH 89 DEGREES 37 MINUTES 12 SECONDS EAST, A DISTANCE OF 0.71 FEET;

**THENCE** NORTH 00 DEGREES 53 MINUTES 26 SECONDS WEST, A DISTANCE OF 1320.98 FEET TO A MAG NAIL WITH WASHER STAMPED "ONEAL 6570" SET IN THE APPROXIMATE CENTERLINE OF CLEM ROAD (NO RECORD FOUND BY SURVEYOR) AT THE NORTHWEST CORNER OF SAID 62.517 ACRE TRACT AND THE NORTHEAST CORNER OF THE ABOVE-MENTIONED 20.057 ACRE TRACT;

**THENCE** NORTH 88 DEGREES 59 MINUTES 46 SECONDS EAST, A DISTANCE OF 1146.71 FEET WITH THE APPROXIMATE CENTERLINE OF CLEM ROAD AND THE NORTH LINE OF SAID 62.517 ACRE TRACT TO A 1/2" IRON ROD FOUND AT AN EXTERIOR CORNER OF SAID 62.517 ACRE TRACT AND THE NORTHWEST CORNER OF SAID 1.00 ACRE AIRHEART TRACT;;

**THENCE** NORTH 89 DEGREES 46 MINUTES 05 SECONDS EAST, A DISTANCE OF 208.94 FEET WITH THE APPROXIMATE CENTERLINE OF CLEM ROAD AND THE NORTH LINE OF SAID 1.00 ACRE TRACT TO A MAG NAIL WITH WASHER STAMPED "ONEAL 6570" SET AT THE NORTHEAST CORNER OF SAID 1.00 ACRE TRACT AND AN EXTERIOR CORNER OF SAID 62.517 ACRE TRACT;

**THENCE** NORTH 89 DEGREES 44 MINUTES 43 SECONDS EAST, A DISTANCE OF 261.79 FEET WITH THE NORTH LINE OF SAID 62.517 ACRE TRACT TO A CONCRETE MONUMENT FOUND IN THE SOUTHWEST LINE OF FARM-TO-MARKET ROAD 3549;

**THENCE** SOUTH 62 DEGREES 32 MINUTES 57 SECONDS EAST, A DISTANCE OF 205.29 FEET WITH THE SOUTHWEST LINE OF FARM-TO-MARKET ROAD 3549 AND THE COMMON NORTHEAST LINE OF SAID 62.517 ACRE TRACT, TO A BROKEN CONCRETE MONUMENT FOUND AT THE BEGINNING OF A CURVE TO THE RIGHT HAVING A DELTA ANGLE OF 063 DEGREES 42 MINUTES 40 SECONDS, A RADIUS OF 713.94 FEET AND A LONG CHORD THAT BEARS SOUTH 30 DEGREES 30 MINUTES 10 SECONDS EAST FOR A DISTANCE OF 753.61 FEET;

**THENCE** SOUTHEASTERLY WITH SAID CURVE TO THE RIGHT AND THE SOUTHWEST LINE OF FARM-TO-MARKET ROAD 3549 AND THE COMMON NORTHEAST LINE OF SAID 62.517 ACRE TRACT, AN ARC LENGTH OF 793.88 FEET TO A BROKEN CONCRETE MONUMENT FOUND;

**THENCE** SOUTH 01 DEGREES 28 MINUTES 55 SECONDS WEST, WITH THE WEST LINE OF FARM-TO-MARKET ROAD 3549 AND THE COMMON EAST LINE OF SAID 62.517 ACRE TRACT, A DISTANCE OF 580.93 FEET TO THE **POINT OF BEGINNING** AND CONTAINING 63.514 ACRES OF LAND, MORE OR LESS.

NOW, THEREFORE, KNOW ALL MEN BY THESE PRESENTS:

STATE OF TEXAS §  
COUNTY OF ROCKWALL §

NORTHGATE ROCKWALL LD, L.P. AND REBECCA AIRHEART, the undersigned owner of the land shown on this plat, and designated herein as the **NORTHGATE ADDITION** subdivision to the City of Rockwall, Texas, and whose names are subscribed hereto, hereby dedicate to the use of the public forever all streets, alleys, parks, water courses, drains, easements and public places thereon shown on the purpose and consideration therein expressed. W further certify that all other parties who have a mortgage or lien interest in the **NORTHGATE ADDITION** subdivision have been notified and signed this plat. We understand and do hereby reserve the easement strips shown on this plat for the purposes stated and for the mutual use and accommodation of all utilities desiring to use or using same. We also understand the following:

1. No buildings shall be constructed or placed upon, over, or across the utility easements as described herein.
2. Any public utility shall have the right to remove and keep removed all or part of any buildings, fences, trees, shrubs, or other growths or improvements which in any way endanger or interfere with construction, maintenance or efficiency of their respective system on any of these easement strips; and any public utility shall at all times have the right of ingress or egress to, from and upon the said easement strips for purpose of construction, reconstruction, inspecting, patrolling, maintaining, and either adding to or removing all or part of their respective system without the necessity of, at any time, procuring the permission of anyone.
3. The City of Rockwall will not be responsible for any claims of any nature resulting from or occasioned by the establishment of grade of streets in the subdivision.
4. The developer and subdivision engineer shall bear total responsibility for storm drain improvements.
5. The developer shall be responsible for the necessary facilities to provide drainage patterns and drainage controls such that properties within the drainage area are not adversely affected by storm drainage from the development. No house dwelling unit, or other structure shall be constructed on any lot in this addition by the owner or any other person until the developer and/or owner has complied with all requirements of the Subdivision Regulations of the City of Rockwall regarding improvements with respect to the entire block on the street or streets on which property abuts, including the actual installation of streets with the required base and paving, curb and gutter, water and sewer, drainage structures, storm structures, storm sewers, and alleys, all according to the specifications of the City of Rockwall; or Until an escrow deposit, sufficient to pay for the cost of such improvements, as determined by the city's engineer and/or city administrator, computed on a private commercial rate basis, has been made with the city secretary, accompanied by an agreement signed by the developer and/or owner, authorizing the city to make such improvements at prevailing private commercial rates, or have the same made by a contractor and pay for the same out of the escrow deposit, should the developer and/or owner fail or refuse to install the required improvements within the time stated in such written agreement, but in no case shall the City be obligated to make such improvements itself. Such deposit may be used by the owner and/or developer as progress payments as the work progresses in making such improvements by making certified requisitions to the city secretary, supported by evidence of work done; or Until the developer and/or owner files a corporate surety bond with the city secretary in a sum equal to the cost of such improvements for the designated area, guaranteeing the installation thereof within the time stated in the bond, which time shall be fixed by the city council of the City of Rockwall.
7. The property owner(s)/HOA shall be responsible for all maintenance, repairs, and reconstruction of drainage and detention easements, open spaces, common areas and landscape buffers.
8. The HOA shall be responsible for all care and maintenance of any decorative sign poles installed. The HOA must maintain, repair, and replace all non-standard street and regulatory sign poles and fixtures or other approved non-standard items.

I (we) further acknowledge that the dedications and/or exaction's made herein are proportional to the impact of the Subdivision upon the public services required in order that the development will comport with the present and future growth needs of the City; I (we), my (our) successors and assigns hereby waive any claim, damage, or cause of action that I (we) may have as a result of the dedication of exactions made herein.

NORTHGATE ROCKWALL LD, L.P. (OWNER)

BY: Michael Ryan Joyce

REBECCA AIRHEART (OWNER)

STATE OF TEXAS §  
COUNTY OF ROCKWALL §

Before me, the undersigned authority, on this day personally appeared Michael Ryan Joyce, known to me to be the person whose name is subscribed to the foregoing instrument, and acknowledged to me that he executed the same for the purpose and consideration therein stated.

Given upon my hand and seal of office this \_\_\_\_ day of \_\_\_\_\_, 2020.

Notary Public in and for the State of Texas  
My Commission Expires:

STATE OF TEXAS §  
COUNTY OF ROCKWALL §

Before me, the undersigned authority, on this day personally appeared Rebecca Airheart, known to me to be the person whose name is subscribed to the foregoing instrument, and acknowledged to me that she executed the same for the purpose and consideration therein stated.

Given upon my hand and seal of office this \_\_\_\_ day of \_\_\_\_\_, 2020.

Notary Public in and for the State of Texas  
My Commission Expires:

SURVEYOR'S CERTIFICATE

NOW, THEREFORE KNOW ALL MEN BY THESE PRESENTS:

THAT I, Daniel Chase O'Neal, do hereby certify that I prepared this plat from an actual and accurate survey of the land, and that the corner monuments shown thereon were properly placed under my personal supervision.



Daniel Chase O'Neal  
Registered Professional Land Surveyor  
State of Texas No. 6570

STANDARD CITY SIGNATURE BLOCK

Planning & Zoning Commission, Chairman

Date

APPROVED:

I hereby certify that the above and foregoing plat of an addition to the City of Rockwall, Texas, was approved by the City Council of the City of Rockwall on the \_\_\_\_ day of \_\_\_\_\_, 2020.

This approval shall be invalid unless the approved plat for such addition is recorded in the office of the County Clerk of Rockwall, County, Texas, within one hundred eighty (180) days from said date of final approval.

WITNESS OUR HANDS, this \_\_\_\_ day of \_\_\_\_\_, 2020.

Mayor, City of Rockwall

City Secretary

City Engineer

FINAL PLAT  
NORTHGATE ADDITION  
BEING  
63.514 ACRES  
38 RESIDENTIAL LOTS  
AND 4 COMMON AREA LOTS  
SITUATED IN THE  
WILLIAM DALTON SURVEY, ABST. 72  
CITY OF ROCKWALL, ROCKWALL COUNTY, TEXAS

DATE: 10/29/20 CASE NO. P2020-022 SHEET 3 OF 3



**ENGINEERINGCONCEPTS**  
& DESIGN, L.P.

ENGINEERING / PROJECT MANAGEMENT /  
CONSTRUCTION SERVICES - FIRM REG. #F-001145  
201 WINDCO CIR, SUITE 200, WYLIE, TX 75098  
972-941-8400 FAX: 972-941-8401 WWW.ECDLP.COM

OWNER/DEVELOPER  
Northgate Rockwall LD, L.P.  
1189 Waters Edge Drive  
Rockwall, TX 75087  
(512) 965-6280

LAND SURVEYOR  
O'Neal Surveying Co.  
P.O. Box 361  
Athens Texas 75751  
(903) 804-2891  
Firm No. 10194132  
Job No. 19081

GENERAL ITEMS

1. All construction shall conform to the requirements set forth in the City of Rockwall's Engineering Department's "Standards of Design and Construction" and the "Standard Specifications for Public Works Construction" by the North Texas Central Council of Governments, 5th edition amended by the City of Rockwall. The CONTRACTOR shall reference the latest City of Rockwall standard details provided in the Rockwall Engineering Departments "Standards of Design and Construction" manual for details not provided in these plans. The CONTRACTOR shall possess one set of the NCTCOG Standard Specifications and Details and the City of Rockwall's "Standards of Design and Construction" manual on the project site at all times
2. Where any conflicting notes, details or specifications occur in the plans the City of Rockwall General Construction Notes, Standards, Details and Specifications shall govern unless detail or specification is more strict.
3. The City of Rockwall Engineering Departments "Standards of Design and Construction" can be found online at: <http://www.rockwall.com/cnegr.asp>
4. All communication between the City and the CONTRACTOR shall be through the Engineering Construction Inspector and City Engineer or designated representative only. It is the responsibility of the CONTRACTOR to contact the appropriate department for inspections that do not fall under this approved engineering plan set.
5. Prior to construction, CONTRACTOR shall have in their possession all necessary permits, plans, licenses, etc.
6. The CONTRACTOR shall have at least one original stamped and signed set of approved engineering plans and specifications on-site and in their possession at all times. A stop work order will be issued if items are not on-site. Copies of the approved plans will not be substituted for the required original "approved plans to be on-site".
7. All material submittals, concrete batch designs and shop drawings required for City review and approval shall be submitted by the CONTRACTOR to the City sufficiently in advance of scheduled construction to allow no less than 10 business days for review and response by the City.
8. All site dimensions are referenced to the face of curb or edge of pavement unless otherwise noted.
9. The City requires ten (10%) percent-two (2) year maintenance bond for paving, paving improvements, water systems, wastewater systems, storm sewer systems including detention systems, and associated fixtures and structures which are located within the right-of-ways or defined easements. The two (2) year maintenance bond is to state "from date of City acceptance" as the starting time.
10. A review of the site shall be conducted at twenty (20) months into the two (2) year maintenance period. The design engineer or their designated representative and the CONTRACTOR shall be present to walk the site with the City of Rockwall Engineering Inspection personnel.

EROSION CONTROL & VEGETATION

1. The CONTRACTOR or developer shall be responsible, as the entity exercising operational control, for all permitting as required by the Environmental Protection Agency (EPA) and the Texas Commission on Environmental Quality (TCEQ). This includes, but is not limited to, preparation of the Storm Water Pollution Prevention Plan (SWPPP), the Construction Site Notice (CSN), the Notice of Intent (NOI), the Notice of Termination (NOT) and any Notice of Change (NOC) and is required to pay all associated fees
2. Erosion control devices as shown on the erosion control plan for the project shall be installed prior to the start of land disturbing activities.
3. All erosion control devices are to be installed in accordance with the approved plans, specifications and Storm Water Pollution Prevention Plan (SWPPP) for the project. Erosion control devices shall be placed and in working order prior to start of construction. Changes are to be reviewed and approved by the design engineer and the City of Rockwall prior to implementation.
4. If the Erosion Control Plans and Storm Water Pollution Prevention Plan (SWPPP) as approved cannot appropriately control erosion and off-site sedimentation from the project, the erosion control plan and/or the SWPPP is required to be revised and any changes reported to the Texas Commission on Environmental Quality (TCEQ), when applicable.
5. All erosion control devices shall be inspected weekly by the CONTRACTOR and after all major rain events, or more frequently as dictated in the project Storm Water Pollution Prevention Plan (SWPPP). CONTRACTOR shall provide copies of inspection's reports to the engineering inspection after each inspection.
6. The CONTRACTOR shall not dispose of waste and any materials into streams, waterways or floodplains. The CONTRACTOR shall secure all excavation at the end of each day and dispose of all excess materials.
7. CONTRACTOR shall take all available precautions to control dust. CONTRACTOR shall control dust by sprinkling water or other means as approved by the City Engineer.
8. CONTRACTOR shall establish grass and maintain the seeded area, including watering, until a "Permanent Stand of Grass" is obtained at which time the project will be accepted by the City. A "Stand of Grass" (not winter rye or weeds) shall consist of 75% to 80% coverage of all disturbed areas and a minimum of one-inch (1") in height as determined by the City. No bare spots will be allowed. Re-seeding will be required in all washed areas and areas that don't grow.
9. All City right-of-ways shall be sodded if disturbed. No artificial grass is allowed in any City right-of-way and/or easements.
10. All adjacent streets/alleys shall be kept clean at all times
11. CONTRACTOR shall keep construction site clean at all times, immediately contain all debris and trash, all debris and trash shall be removed at the end of each work day, and all vegetation on the construction site 10-inches or taller in height must be cut immediately.
12. Suspension of all construction activities for the project will be enforced by the City if any erosion control requirements are not met. Work may commence after deficiency has been rectified.
13. During construction of the project, all soil stockpiles and borrow areas shall be stabilized or protected with sediment trapping measures. The CONTRACTOR is responsible for the temporary protection and permanent stabilization of all soil stockpiles on-site as well as borrow areas and soil intentionally transported from the project site.
14. Where construction vehicles access routes intersect paved or public roads/alleys, construction entrances shall be installed to minimize the transport of sediment by vehicular tracking onto paved surfaces. Where

sediment is transferred onto paved or public surfaces, the surface shall be immediately cleaned. Sediment shall be removed from the surface by shoveling or sweeping and transported to a sediment disposal area. Pavement washing shall be allowed only after sediment is removed in this manner.

15. All drainage inlets shall be protected from siltation, ineffective or unmaintained protection devices shall be immediately replaced and the inlet and storm system cleaned. Flushing is not an acceptable method of cleaning.
16. During all dewatering operations, water shall be pumped into an approved filtering device prior to discharge into a receiving outlet.

TRAFFIC CONTROL

1. All new Detouring or Traffic Control Plans are required to be submitted to the City for review and approval a minimum of 21 calendar days prior to planned day of implementation.
2. When the normal function of the roadway is suspended through closure of any portion of the right-of-way, temporary construction work zone traffic control devices shall be installed to effectively guide the motoring public through the area. Consideration for road user safety, worker safety, and the efficiency of road user flow is an integral element of every traffic control zone.
3. All traffic control plans shall be prepared and submitted to the Engineering Department in accordance with the standards identified in Part VI of the most recent edition of the TMUTCD. Lane closures will not occur on roadways without an approval from the Rockwall Engineering Department and an approved traffic control plan. Traffic control plans shall be required on all roadways as determined by the City Engineer or the designated representative.
4. All traffic control plans must be prepared, signed, and sealed by an individual that is licensed as a professional engineer in the State of Texas. All traffic control plans and copies of work zone certification must be submitted for review and approval a minimum of three (3) weeks prior to the anticipated temporary traffic control.
5. The CONTRACTOR executing the traffic control plan shall notify all affected property owners two (2) weeks prior to any the closures in writing and verbally.
6. Any deviation from an approved traffic control plan must be reviewed by the City Engineer or the designated representative. If an approved traffic control plan is not adhered to, the CONTRACTOR will first receive a verbal warning and be required to correct the problem immediately. If the deviation is not corrected, all construction work will be suspended, the lane closure will be removed, and the roadway opened to traffic.
7. All temporary traffic control devices shall be removed as soon as practical when they are no longer needed. When work is suspended for short periods of time at the end of the workday, all temporary traffic control devices that are no longer appropriate shall be removed or covered. The first violation of this provision will result in a verbal warning to the construction foreman. Subsequent violations will result in suspension of all work at the job site for a minimum of 48 hours. All contractors working on City funded projects will be charged one working day for each 24 hour closure.
8. Lane closures on any major or minor arterial will not be permitted between the hours of 6:00 am to 9:00 am and 3:30 pm to 7:00 pm. Where lane closures are needed in a school area, they will not be permitted during peak hours of 7:00 am – 9:00 am and 3:00 pm to 5:00 pm. Closures may be adjusted according to the actual start-finish times of the actual school with approval by the City Engineer. The first violation of this provision will result in a verbal warning to the construction foreman. Subsequent violations will result in suspension of all work at the job site for a minimum of 48 hours. All contractors working on City funded projects will be charged one working day for each 24 hour closure of a roadway whether they are working or not.
9. No traffic signs shall be taken down without permission from the City.
10. No street/roadway will be allowed to be fully closed.

UTILITY LINE LOCATES

1. It is the CONTRACTOR's responsibility to notify utility companies to arrange for utility locates at least 48 hours prior to beginning construction. The completeness and accuracy of the utility data shown on the plans is not guaranteed by the design engineer or the City. The CONTRACTOR is responsible for verifying the depth and location of existing underground utilities proper to excavating, trenching, or drilling and shall be required to take any precautionary measures to protect all lines shown and .or any other underground utilities not on record or not shown on the plans.
2. The CONTRACTOR shall be responsible for damages to utilities
3. CONTRACTOR shall adjust all City of Rockwall utilities to the final grades.
4. All utilities shall be placed underground.
5. CONTRACTOR shall be responsible for the protection of all existing main lines and service lines crossed or exposed by construction operations. Where existing mains or service lines are cut, broken or damaged, the CONTRACTOR shall immediately make repairs to or replace the entire service line with same type of original construction or better. The City of Rockwall can and will intervene to restore service if deemed necessary and charge the CONTRACTOR for labor, equipment, material and loss of water if repairs aren't made in a timely manner by the CONTRACTOR.
6. The City of Rockwall (City utilities) is not part of the Dig Tess or Texas one Call – 811 – line locate system. All City of Rockwall utility line locates are to be scheduled with the City of Rockwall Service Center. 972-771-7730. A 48-hour advance notice is required for all non-emergency line locates.
7. Underground utility lines shall be installed in accordance with the following standards in addition to other applicable criteria:
  - a. No more than 500 linear feet of trench may be opened at one time.
  - b. Material used for backfilling trenches shall be properly compacted to 95% standard density in order to minimize erosion, settlement, and promote stabilization that the geotechnical engineer recommends.
  - c. Applicable safety regulations shall be complied with.
11. This plan details pipes up to 5 feet from the building. Refer to the building plans for building connections. CONTRACTOR shall supply and install pipe adapters as necessary.
12. All underground lines shall be installed, inspected, and approved prior to backfilling.
13. All concrete encasement shall have a minimum of 28 days compressive strength at 3,000 psi (min. 5.5 sack/mix).

WATER LINE NOTES

1. The CONTRACTOR shall maintain existing water service at all times during construction.
2. Proposed water lines shall be AWWA C900-16 PVC Pipe (blue in color) for all sizes, DN 14 (PC 305) for pipeline sizes 12-inch and smaller, and DR 18 (PC 235) for 14-inch and larger water pipelines, unless otherwise shown on water plan and profiles sheets. Proposed water lines shall be constructed with minimum cover of 4 feet for 6-inch through 8-inch, 5 feet for 12-inch through 18-inch and 6 feet for 20-inch and larger.
3. Proposed water line embedment shall be NCTCOG Class 'B-3' as amended by the City of Rockwall's engineering standards of design and construction manual.
4. CONTRACTOR shall coordinate the shutting down of all water lines with the City of Rockwall Engineering Inspector and Water Department. The City shall operate all water valves. Allow 5 business days from the date of notice to allow City personnel time to schedule a shut down. Two additional days are required for the CONTRACTOR to notify residents in writing of the shut down after the impacted area has been identified. Water shut downs impacting businesses during their normal operation hours is not allowed. CONTRACTOR is required to coordinate with the Rockwall Fire Department regarding any fire watch requirements as well as any costs incurred when the loss of fire protection to a structure occurs.
5. CONTRACTOR shall furnish and install gaskets on water lines between all dissimilar metals and at valves (both existing and proposed).
6. All fire hydrants and valves removed and salvaged shall be returned to the City of Rockwall Municipal Service Center.
7. Blue EMS pads shall be installed at every change in direction, valve, curb stop and service tap on the proposed water line and every 250'.
8. All water valve hardware and valve extensions, bolts, nuts and washers shall be 316 stainless steel.
9. All fire hydrants bolts, nuts and washers that are buried shall be 316 stainless steel.
10. Abandoned water lines to remain in place shall be cut and plugged and all void spaces within the abandoned line shall be filled with grout, flowable fill or an expandable permanent foam product. Valves to be abandoned in place shall have any extensions and the valve box removed and shall be capped in concrete.
11. All fire hydrants will have a minimum of 5 feet of clearance around the appurtenance including but not limited to parking spaces and landscaping.
12. All joints are to be megalog joints with thrust blocking.
13. Water and sewer mains shall be kept 10 feet apart (parallel) or when crossing 2 feet vertical clearance.
14. CONTRACTOR shall maintain a minimum of 4 feet of cover on all water lines.
15. All domestic and irrigation services are required to have a testable backflow device with a double check valve installed per the City of Rockwall regulations at the property line and shown on plans.

WASTEWATER LINE NOTES

1. The CONTRACTOR shall maintain existing wastewater service at all times during construction.
2. Wastewater line for 4-inch through 15-inch shall be Green PVC – SDR 35 (ASTM D3034) [less 10 ft cover] and SDR 26 (ASTM D3034) [10 ft or more cover]. For 18-inch and larger wastewater line shall be Green PVC – PS 46 (ASTM F679) [less 10 ft cover] and PS 115 (ASTM F679) [10 ft or more cover]. No services will be allowed on a sanitary sewer line deeper than 10 feet.
3. Proposed wastewater line embedment shall be NCTCOG Class 'H' as amended by the City of Rockwall's public works standard design and construction manual.
4. Green EMS pads shall be installed at every 250', manhole, clean out and service lateral on proposed wastewater lines.
5. CONTRACTOR shall CCTV all existing wastewater lines that are to be abandoned to ensure that all laterals are accounted for and transferred to proposed wastewater lines prior to abandonment.
6. All abandoned wastewater and force main lines shall be cut and plugged and all void spaces within the abandoned line shall be filled with grout, flowable fill or an expandable permanent foam product.
7. Existing manholes and cleanouts not specifically called to be relocated shall be adjusted to match final grades.
8. All wastewater pipes and public services shall be inspected by photographic means (television and DVD) prior to final acceptance and after franchise utilities are installed. The CONTRACTOR shall furnish a DVD to the Engineering Construction Inspector for review. Any sags, open joints, cracked pipes, etc. shall be repaired or removed by the CONTRACTOR at the CONTRACTOR's expense. A television survey will be performed as part of the final testing in the twentieth (20<sup>th</sup>) month of the maintenance period.
9. All manholes (public or private) shall be fitted with inflow prevention. The inflow prevention shall conform to the measures called out in standard detail R-5031.
10. All new or existing manholes being modified shall have corrosion protection being Raven Liner 405 epoxy coating, ConShield, or approved equal. Consheild must have terracotta color dye mixed in the precast and cast-in-place concrete. Where connections to existing manholes are made the CONTRACTOR shall rehab manhole as necessary and install a 125 mil thick coating of Raven Liner 405 or approved equal.
11. If an existing wastewater main or trunk line is called out to be replaced in place a wastewater bypassing pump plan shall be required and submitted to the Engineering Construction Inspector and City Engineer for approval prior to implementation. Bypass pump shall be fitted with an auto dialer and conform to the City's Noise Ordinance. Plan shall be to the City sufficiently in advance of scheduled construction to allow no less than 10 business days for review and response by the City.
12. CONTRACTOR shall maintain a minimum of 4 feet of cover on all wastewater lines.

RELEASED FOR CONSTRUCTION  
ALL RESPONSIBILITY FOR ADEQUACY OF DESIGN  
REMAINS WITH THE DESIGN ENGINEER. THE CITY  
OF ROCKWALL, IN REVIEWING AND RELEASING  
PLANS FOR CONSTRUCTION, ASSUMES NO  
RESPONSIBILITY FOR ADEQUACY OR ACCURACY OF  
DESIGN.

RECORD DRAWINGS

To the best of our knowledge Engineering  
Concepts & Design, L.P., hereby states that  
this plan is As-Built. This information  
provided is based on surveying at the site  
and information provided by the contractor.

*Ryan C. King*  
RYAN C. KING

1/27/2021  
DATE



GENERAL CONSTRUCTION NOTES  
Sheet 1 of 2  
April 2020

CITY OF ROCKWALL  
ENGINEERING DEPARTMENT

385 S. Goliad  
Rockwall, Texas 75087

P (972) 771-7746  
F (972) 771-7748

DEMOLITION, REMOVAL, DISPOSAL AND EXCAVATION NOTES

1. All pavements to be removed and replaced shall be saw cut to full depth along neat squared lines shown in the plans.
2. Proposed concrete pavement shall be constructed with longitudinal butt construction joints at all connections to existing concrete pavement.
3. All public concrete pavement to be removed and replaced shall be full panel replacement, 1-inch thicker and on top of 6-inch thick compacted flexbase.
4. No excess excavated material shall be deposited in low areas or along natural drainage ways without written permission from the affected property owner and the City of Rockwall. No excess excavation shall be deposited in the City Limits without a permit from the City of Rockwall. If the CONTRACTOR places excess materials in these areas without written permission, the CONTRACTOR will be responsible for all damages resulting from such fill and shall remove the material at their own cost.

PAVING AND GRADING

1. All detention systems are to be installed and verified for design compliance along with the associated storm sewer and outflow structures, prior to the start of any paving operations (including building foundations). Erosion protection shall be placed at the pond outflow structures, silt fence along the perimeter of the pond along with any of the associated erosion BMPs noted on the erosion control plan, and the sides and bottom of the detention system shall have either sod or anchored seeded curlex installed prior to any concrete placement.
2. All paving roadway, driveways, fire lanes, drive-isles, parking, dumpster pads, etc. sections shall have a minimum thickness, strength, reinforcement, joint type, joint spacing and subgrade treatment shall at a minimum conform to the City standards of Design and Construction and table below.

Street/Pavement Type	Minimum Thickness (inches)	Streng th 28-Day (psi)	Minimum Cement (sacks / CY)		Steel Reinforcement	
			Machine placed	Hand Placed	Bar #	Spacing (O.C.E.W.)
Arterial	10"	3,600	6.0	6.5	#4 bars	18"
Collector	8"	3,600	6.0	6.5	#4 bars	18"
Residential	6"	3,600	6.0	6.5	#3 bars	24"
Alley	7"-5"-7"	3,600	6.0	6.5	#3 bars	24"
Fire Lane	6"	3,600	6.0	6.5	#3 bars	24"
Driveways	6"	3,600	6.0	6.5	#3 bars	24"
Barrier Free Ramps	6"	3,600	N/A	6.5	#3 bars	24"
Sidewalks	4"	3,000	N/A	5.5	#3 bars	24"
Parking Lot/Drive Aisles	5"	3,000	5.0	5.5	#3 bars	24"
Dumpster Pads	7"	3,600	6.0	6.5	#3 bars	24"

3. Reinforcing steel shall be tied (100%). Reinforcing steel shall be set on plastic chairs. Bar laps shall be minimum 30 diameters. Sawed transverse dummy joints shall be spaced every 15 feet or 1.25 time longitudinal butt joint spacing whichever is less. Sawing shall occur within 5 to 12 hours after the pour, including sealing. Otherwise, the section shall be removed and longitudinal butt joint constructed.
4. No sand shall be allowed under any paving.
5. All concrete mix design shall be submitted to the City for review and approval prior to placement.
6. Fly ash may be used in concrete pavement locations provided that the maximum cement reduction does not exceed 20% by weight per C.Y. of concrete. The fly ash replacement shall be 1.25 lbs. per 1.0 lb. cement reduction.
7. All curb and gutter shall be integral (monolithic) with the pavement.
8. All fill shall be compacted by sheep's foot roller to a minimum 95% standard proctor. Maximum loose lift for compaction shall be 8 inches. All lifts shall be tested for density by an independent laboratory.
9. All concrete compression tests and soil compaction/density tests are required to be submitted to the City's Engineering Inspector immediately upon results.
10. All proposed sidewalks shall include barrier free ramps at intersecting streets, alleys, etc. Barrier free ramps (truncated dome plate in Colonial or brick red color) shall meet current City and ADA requirements and be approved by the Texas Department of Licensing and Regulation (TDLR).
11. All public sidewalks shall be doveled into pavement where it abuts curbs and driveways. Expansion joint material shall be used at these locations.
12. All connection of proposed concrete pavement to existing concrete pavement shall include a longitudinal butt joint as the load transfer device. All longitudinal butt joints shall be clean, straight and smooth (not jagged in appearance)
13. Cracks formed in concrete pavement shall be repaired or removed by the CONTRACTOR at the City's discretion. CONTRACTOR shall replace existing concrete curbs, sidewalk, paving, a gutters as indicated on the plans and as necessary to connect to the existing infrastructure, including any damage caused by the CONTRACTOR.
14. All residential lots will require individual grading plans submitted during the building permit process that correspond with the engineered grading and drainage area plans.
15. Approval of this plan is not an authorization to grade adjacent properties when the plans or field conditions warrant off-site grading. Written permission must be obtained and signed from the affected property owner(s) and temporary construction easements may be required. The written permission shall be provided to the City as verification of approval by the adjacent property owner(s). Violation of this requirement will result in suspension of all work at the job site until issue has been rectified.
16. All cut or fill slopes of non-paved areas shall be a maximum of 4:1 and minimum of 1%.
17. CONTRACTOR agrees to repair any damage to property and the public right-of-way in accordance with the City Standards of Design and Construction.
18. CONTRACTOR shall protect all monuments, iron pins/rods, and property corners during construction.
19. CONTRACTOR shall ensure positive drainage so that runoff will drain by gravity flow to new or existing drainage inlets or sheet flow per these approved plans.

DRAINAGE / STORM SEWER NOTES

1. The CONTRACTOR shall maintain drainage at all times during construction. Ponding of water in streets, drives, trenches, etc. will not be allowed. Existing drainage ways shall not be blocked or removed unless explicitly stated in the plans or written approval is given by the City.
2. All structural concrete shall be 4200 psi compressive strength at 28 days minimum 7.0 sack mix, air entrained, unless noted otherwise. Fly ash shall not be allowed in any structural concrete.
3. Proposed storm sewer embedment shall be NCTCOG Class 'B' as amended by the City of Rockwall's Engineering Department Standards of Design and Construction Manual.
4. All public storm pipe shall be a minimum of 18-inch reinforced concrete pipe (RCP), Class III, unless otherwise noted.
5. All storm pipe entering structures shall be grouted to assure connection at the structure is watertight.
6. All storm structures shall have a smooth uniform poured mortar invert from invert in to invert out.
7. All storm sewer manholes in paved areas shall be flush with the paving grade, and shall have traffic bearing ring and covers.

RETAINING WALLS

1. All retaining walls, regardless of height, will be reviewed and approved by the City Engineering Department
2. All retaining walls (including foundation stem walls), regardless of height, will be constructed of rock/stone/brick or rock/stone/brick faced. No smooth concrete walls are allowed. Wall materials shall be the same for all walls on the project.
3. All portions, including footings, tie-backs, and drainage backfill, of the wall shall be on-site and not encroach into any public easements or right-of-way. The entire wall shall be in one lot and shall not be installed along a lot line.
4. All walls 3 feet and taller will be designed and signed/sealed by a registered professional engineer in the State of Texas. The wall design engineer is required to inspect the wall construction and supply a signed/sealed letter of wall construction compliance to the City of Rockwall along with wall as-builts prior to City Engineering acceptance.
5. No walls are allowed in detention easements. A variance to allow retaining walls in a detention easement will require approval by the Planning and Zoning Commission with appeals being heard by the City Council.

FINAL ACCEPTANCE AND RECORD DRWINGS/AS-BUILTS

1. Final Acceptance shall occur when all the items on the Checklist for Final Acceptance have been completed and signed-off by the City. An example of the checklist for final acceptance has been included in the Appendix of the Standards of Design and Construction. Items on the checklist for final acceptance will vary per project and additional items not shown on the check list may be required.
2. After improvements have been constructed, the developer shall be responsible for providing to the City "As Built" or "Record Drawings". The Design Engineer shall furnish all digital files of the project formatted in Auto Cad 14, or 2000 format or newer and Adobe Acrobat (.pdf) format with a CD-ROM disk or flash drive. The disk or drive shall include a full set of plans along with any landscaping, wall plans, and details sheets.
3. Submit 1-set of printed drawings of the "Record Drawings" containing copies of all sheets to the Engineering Construction Inspector for the project. The printed sheets will be reviewed by the inspector PRIOR to producing the "Record Drawing" digital files on disk or flash drive. This will allow any revisions to be addressed prior to producing the digital files.
4. Record Drawing Disk drawings shall have the Design Engineers seal, signature and must be stamped and dated as "Record Drawings" or "As Built Drawings" on all sheets.
5. The City of Rockwall will not accept any Record Drawing disk drawings which include a disclaimer. A disclaimer shall not directly or indirectly state or indicate that the design engineer or the design engineer's surveyor/surveyors did not verify grades after construction, or that the Record Drawings were based solely on information provided by the construction contractor/contractors. Any Record Drawings which include like or similar disclaimer verbiage will not be accepted by the City of Rockwall.
6. Example of Acceptable Disclaimer: "To the best of our knowledge ABC Engineering, Inc., hereby states that this plan is As-Built. This information provided is based on surveying at the site and information provided by the contractor."

RECORD DRAWINGS

To the best of our knowledge Engineering Concepts & Design, L.P., hereby states that this plan is As-Built. This information provided is based on surveying at the site and information provided by the contractor.

*Ryan C. King*  
RYAN C. KING

1/27/2021  
DATE

RELEASED FOR CONSTRUCTION  
ALL RESPONSIBILITY FOR ADEQUACY OF DESIGN  
REMAINS WITH THE DESIGN ENGINEER. THE CITY  
OF ROCKWALL, IN REVIEWING AND RELEASING  
PLANS FOR CONSTRUCTION, ASSUMES NO  
RESPONSIBILITY FOR ADEQUACY OR ACCURACY OF  
DESIGN.

CITY

DATE



GENERAL CONSTRUCTION NOTES  
Sheet 2 of 2  
April 2020


CITY OF ROCKWALL  
ENGINEERING DEPARTMENT

385 S. Goliad  
Rockwall, Texas 75087

P (972) 771-7746  
F (972) 771-7748

\*ALL RESPONSIBILITY FOR ADEQUACY OF DESIGN REMAINS WITH THE DESIGN ENGINEER. THE CITY OF ROCKWALL, IN REVIEWING AND RELEASING PLANS FOR CONSTRUCTION, ASSUMES NO RESPONSIBILITY FOR ADEQUACY OR ACCURACY OF DESIGN.


SEE SHEET 8 FOR TYPICAL PAVING SECTION

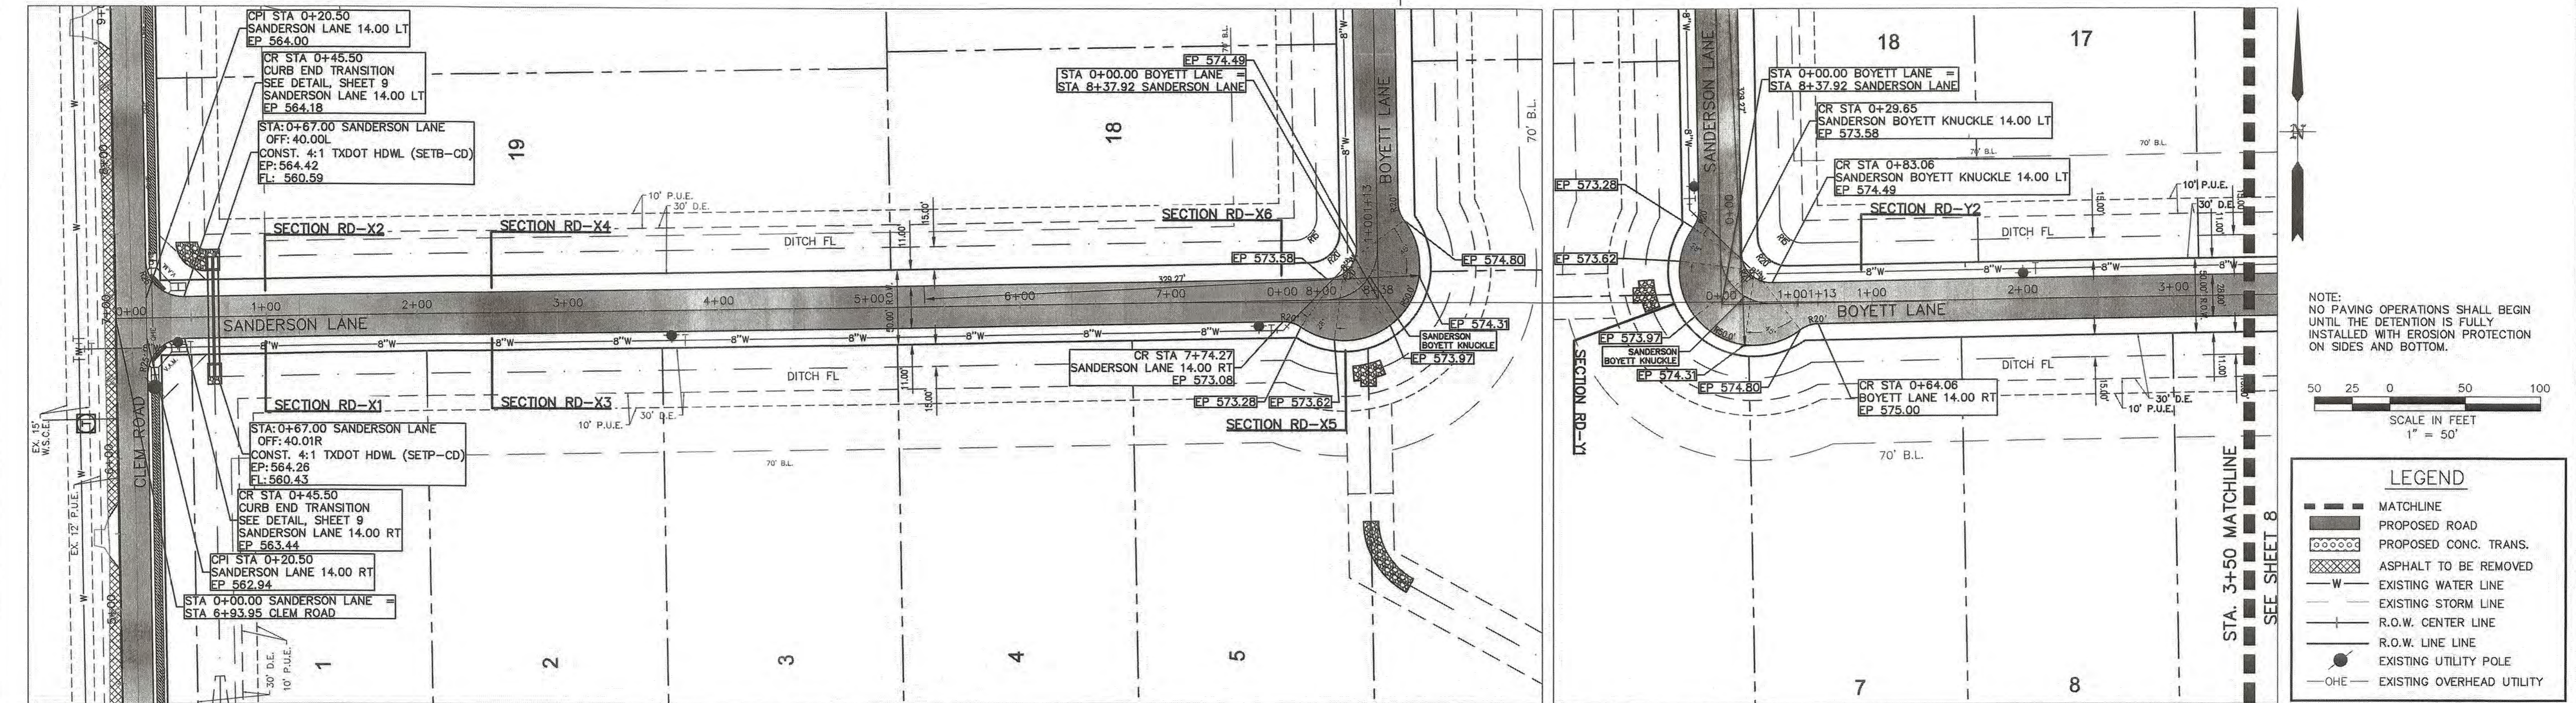

NOTE: NO PAVING OPERATIONS SHALL BEGIN UNTIL THE DETENTION IS FULLY INSTALLED WITH EROSION PROTECTION ON SIDES AND BOTTOM.

50 25 0 50 100  
SCALE IN FEET  
1" = 50'

LEGEND	
	MATCHLINE
	PROPOSED ROAD
	PROPOSED CONC. TRANS.
	ASPHALT TO BE REMOVED
	EXISTING WATER LINE
	EXISTING STORM LINE
	R.O.W. CENTER LINE
	R.O.W. LINE LINE
	EXISTING UTILITY POLE
	EXISTING OVERHEAD UTILITY

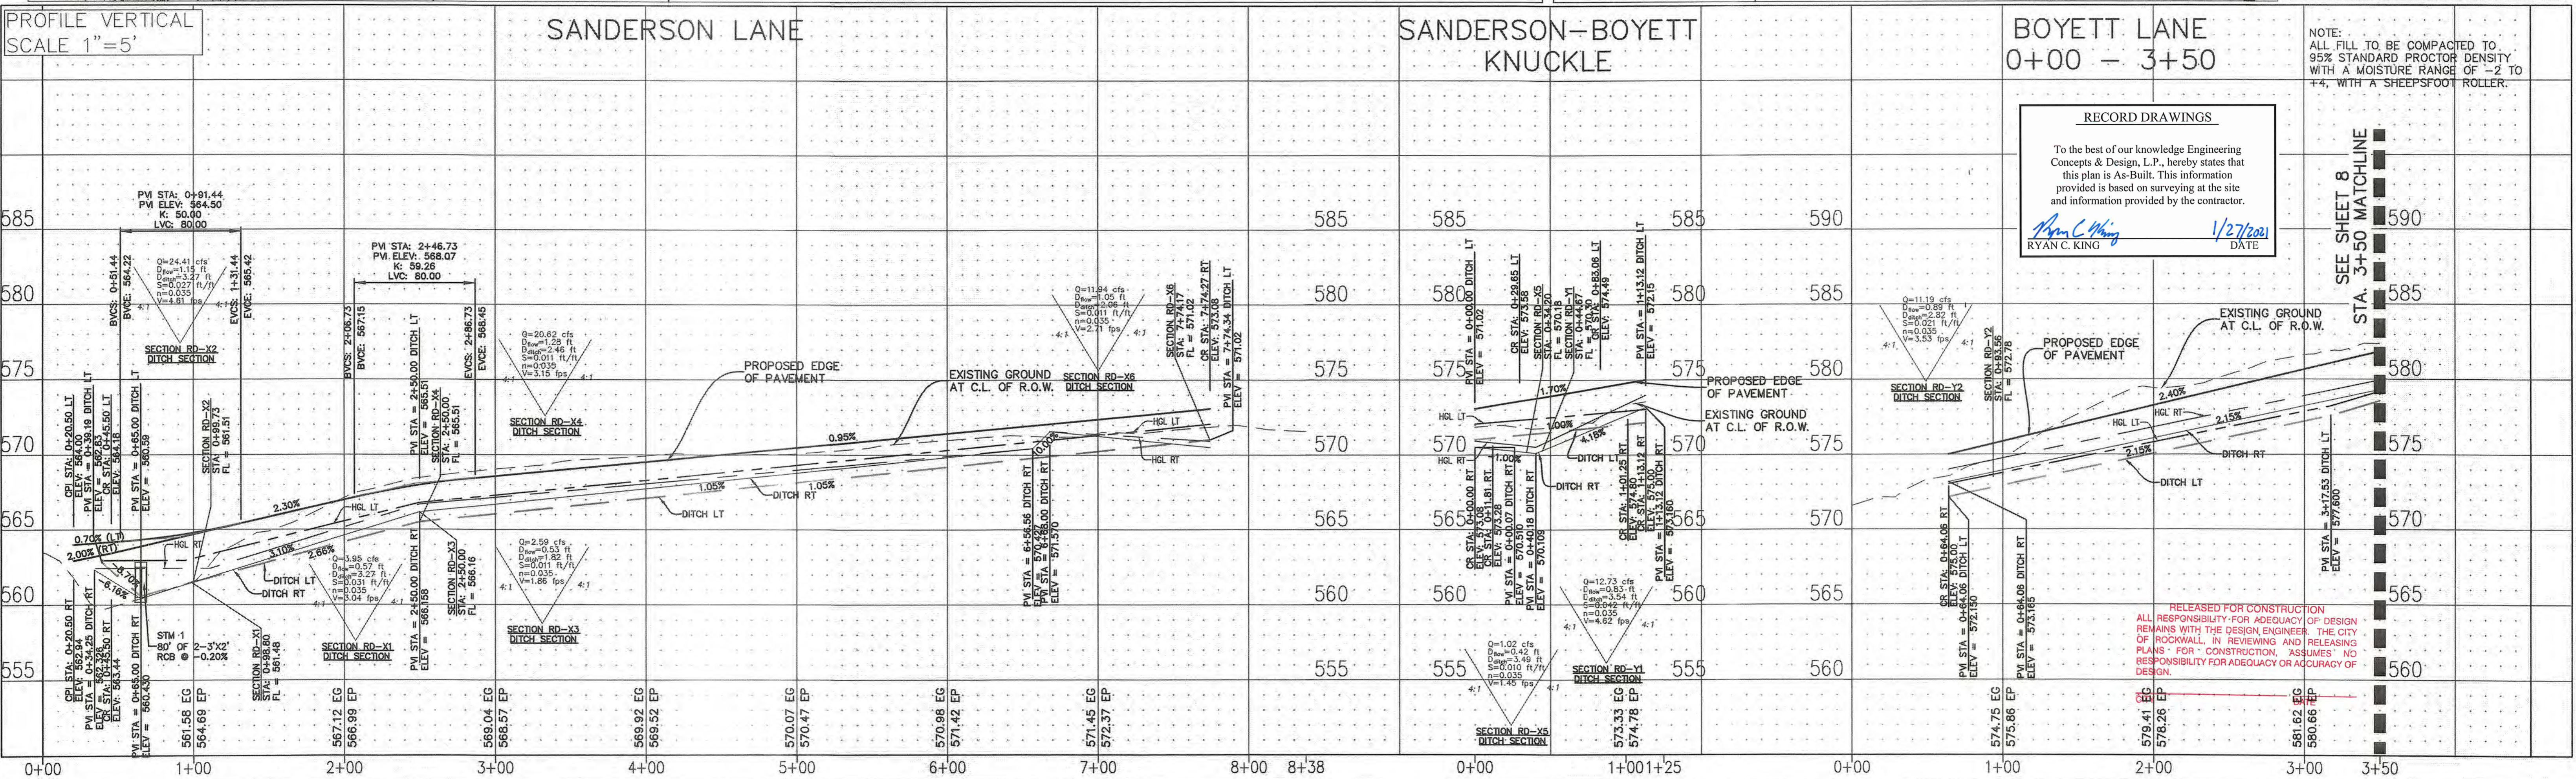

NOTE: ALL FILL TO BE COMPACTED TO 95% STANDARD PROCTOR DENSITY WITH A MOISTURE RANGE OF -2 TO +4, WITH A SHEEPSFOOT ROLLER.

RECORD DRAWINGS  
To the best of our knowledge Engineering Concepts & Design, L.P., hereby states that this plan is As-Built. This information provided is based on surveying at the site and information provided by the contractor.  
*Ryan C. King*  
RYAN C. KING  
1/27/2021  
DATE

SEE SHEET 8  
STA. 3+50 MATCHLINE

**CAUTION! EXISTING UTILITIES**

CONTRACTOR SHOULD CALL 1-800-868-7888 PRIOR TO BEGINNING ANY CONSTRUCTION ACTIVITIES FOR EXISTING UTILITY LOCATIONS. EXISTING UTILITIES AND UNDERGROUND FACILITIES INDICATED ON THESE PLANS HAVE BEEN LOCATED FROM REFERENCE INFORMATION. IT IS THE RESPONSIBILITY OF THE CONTRACTOR TO VERIFY BOTH HORIZONTALLY AND VERTICALLY THE LOCATION OF ALL EXISTING UTILITIES AND UNDERGROUND FACILITIES PRIOR TO CONSTRUCTION AND TO TAKE NECESSARY PRECAUTIONS IN ORDER TO PROTECT ALL FACILITIES ENCOUNTERED. THE CONTRACTOR SHALL PRESERVE AND PROTECT ALL EXISTING UTILITIES FROM DAMAGE DURING CONSTRUCTION.

BM-1: "PK" Nail on the south side of Clem Road, approximately 2275' west of the centerline intersection of Clem Road and FM 3549  
Elev.: 559.07'

BM-2: "PK" Nail in Clem Road, approximately 175' west of the centerline intersection of Clem Road and FM 3549  
Elev.: 584.83'

**ENGINEERINGCONCEPTS**  
& DESIGN, L.P.

ENGINEERING / PROJECT MANAGEMENT /  
CONSTRUCTION SERVICES - FIRM REG. #F-001145  
201 WINDCO CIR, STE 200, WYLIE, TX 75098  
972-941-8400 FAX: 972-941-8401 WWW.ECDLP.COM

REVISIONS:

DRAWN: MJH	DATE:
CHECKED: RCK	DATE: 6/1/2020
PROJECT NO.: 08338	
DWG FILE NAME: 08338 PV.DWG	

THIS DOCUMENT IS RELEASED FOR THE PURPOSE OF CONSTRUCTION. THE SEAL APPEARING ON THIS DOCUMENT WAS AUTHORIZED BY RYAN C. KING, P.E. 123635

6/1/2020



**PAVING PLAN - SANDERSON LANE**

**NORTHGATE**

CITY OF ROCKWALL, ROCKWALL COUNTY, TEXAS

SHEET  
7  
OF  
40

\*ALL RESPONSIBILITY FOR ADEQUACY OF DESIGN REMAINS WITH THE DESIGN ENGINEER. THE CITY OF ROCKWALL, IN REVIEWING AND RELEASING PLANS FOR CONSTRUCTION, ASSUMES NO RESPONSIBILITY FOR ADEQUACY OR ACCURACY OF DESIGN.

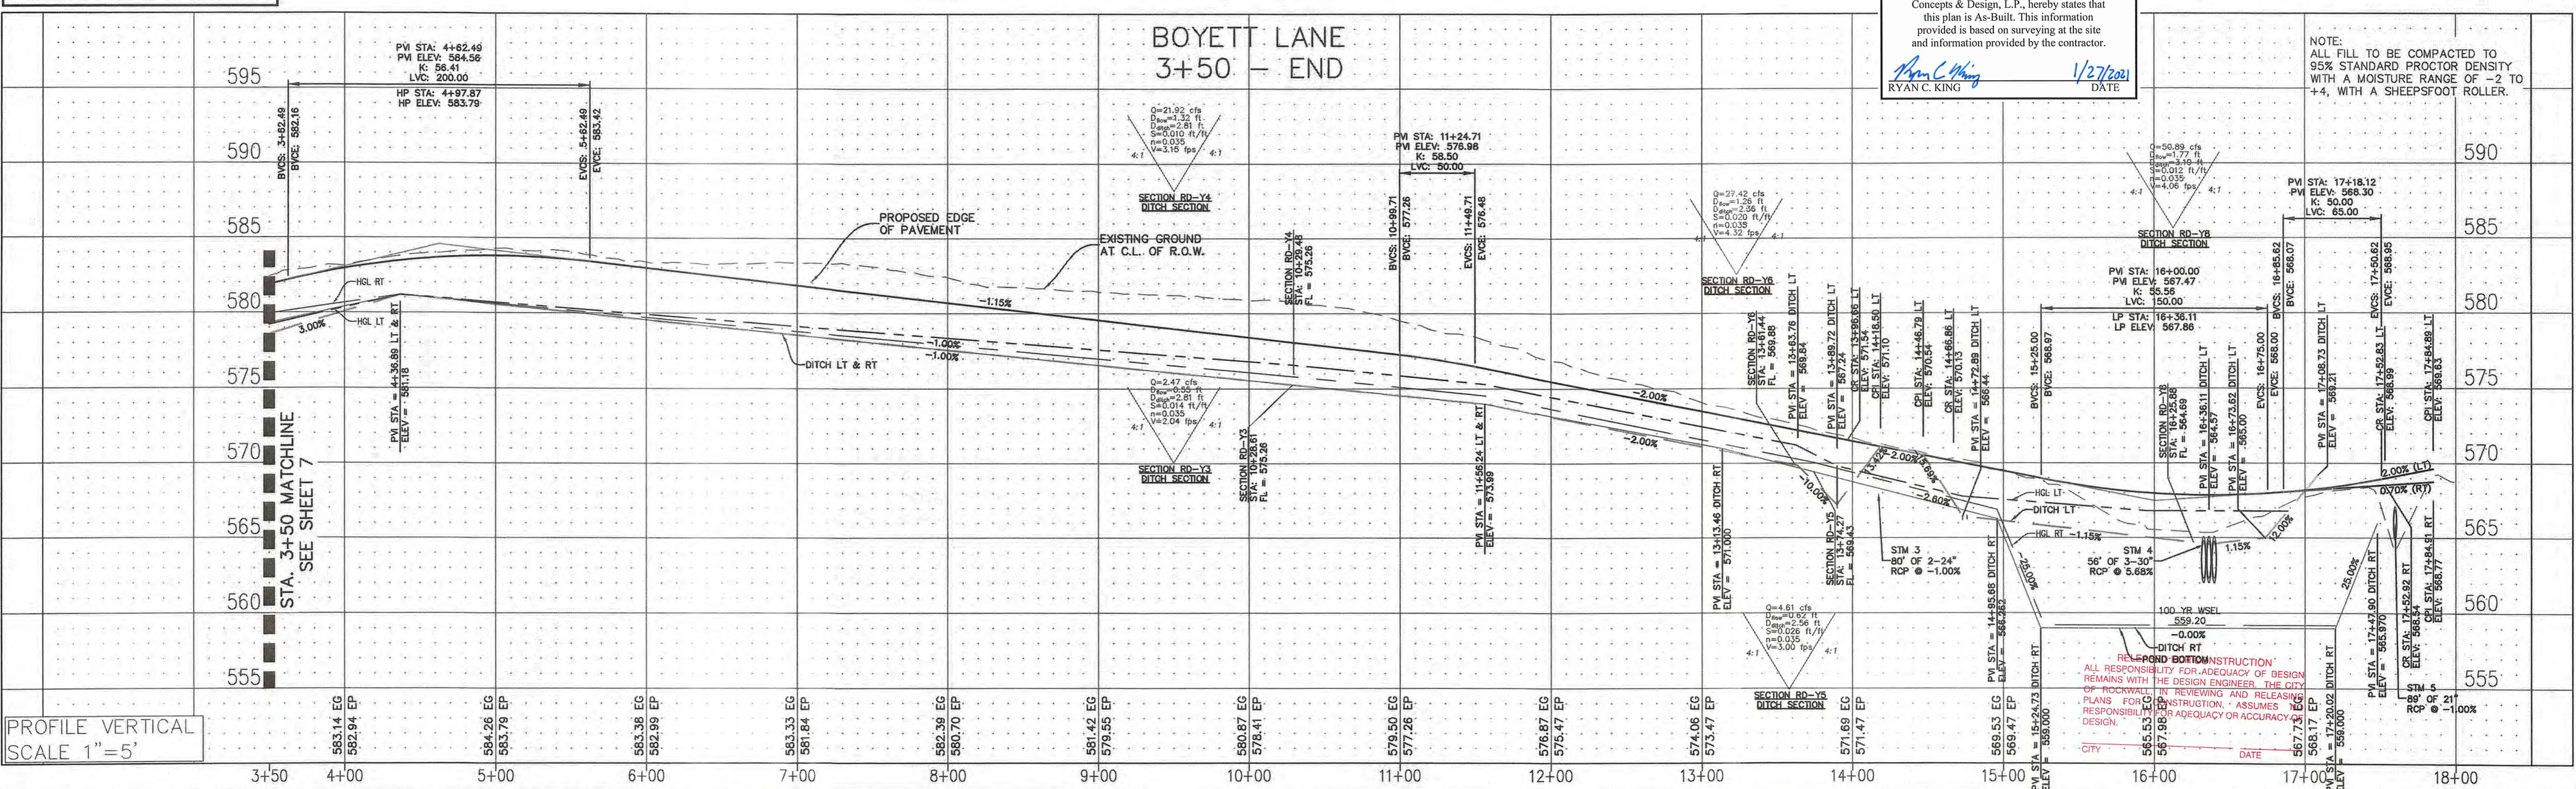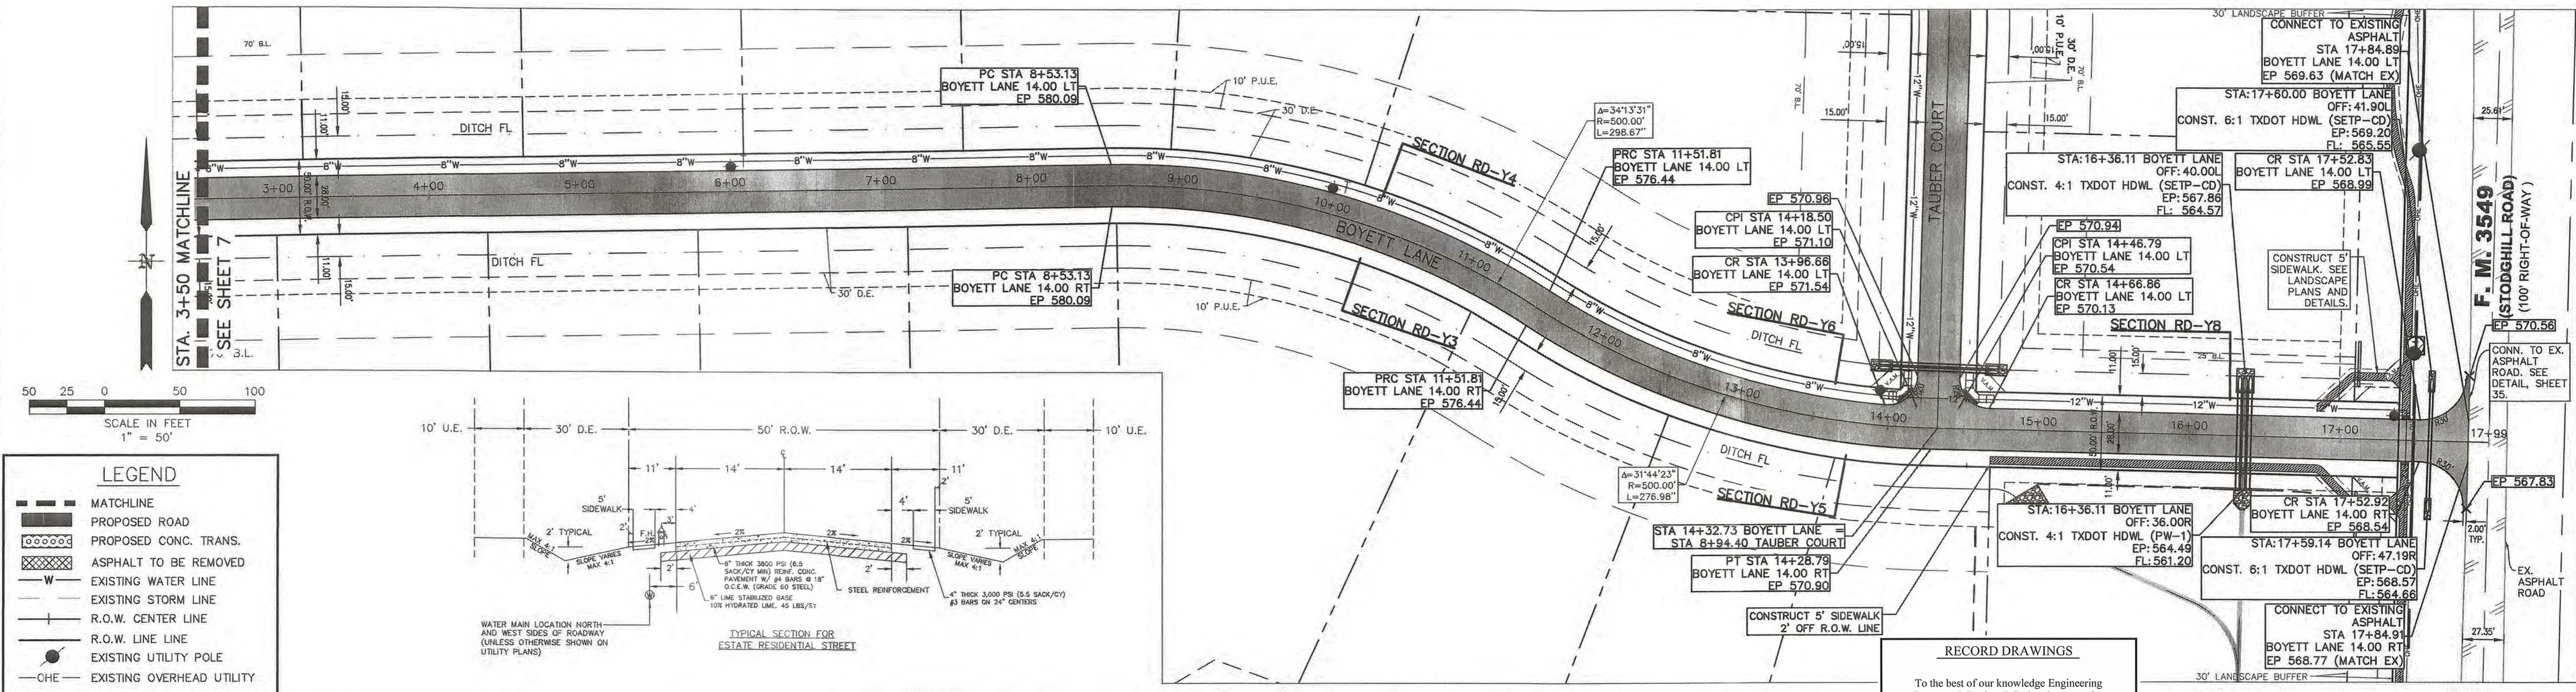

**CAUTION! EXISTING UTILITIES**

CONTRACTOR SHOULD CALL 1-800-368-5898 PRIOR TO BEGINNING ANY CONSTRUCTION ACTIVITIES FOR EXISTING UTILITY LOCATIONS. EXISTING UTILITIES AND UNDERGROUND FACILITIES INDICATED ON THESE PLANS HAVE BEEN LOCATED FROM REFERENCE INFORMATION. IT IS THE RESPONSIBILITY OF THE CONTRACTOR TO VERIFY BOTH HORIZONTALLY AND VERTICALLY THE LOCATION OF ALL EXISTING UTILITIES AND UNDERGROUND FACILITIES PRIOR TO CONSTRUCTION AND TO TAKE NECESSARY PRECAUTIONS IN ORDER TO PROTECT ALL FACILITIES ENCOUNTERED. THE CONTRACTOR SHALL PRESERVE AND PROTECT EXISTING UTILITIES FROM DAMAGE DURING CONSTRUCTION.

BM-1: "PK" Nail on the south side of Clem Road, approximately 2275' west of the centerline intersection of Clem Road and FM 3549  
Elev.: 559.07'

BM-2: "PK" Nail in Clem Road, approximately 175' west of the centerline intersection of Clem Road and FM 3549  
Elev.: 584.83'

**ENGINEERINGCONCEPTS**  
& DESIGN, L.P.

ENGINEERING / PROJECT MANAGEMENT /  
CONSTRUCTION SERVICES - FIRM REG. #F-001145  
201 WINDCO CIR, STE 200, WYLIE, TX 75098  
972-941-8400 FAX: 972-941-8401 WWW.ECDLP.COM

REVISIONS:

DRAWN: MJH	DATE: 6/1/2020
CHECKED: RCK	DATE: 6/1/2020
PROJECT NO.: 08838	
DWG FILE NAME: 08838 PV.DWG	

THIS DOCUMENT IS RELEASED FOR THE PURPOSE OF CONSTRUCTION. THE SEAL APPEARING ON THIS DOCUMENT WAS AUTHORIZED BY RYAN C. KING, P.E. 123635

6/1/2020


**PAVING PLAN - BOYETT LANE**

**NORTHGATE**



CITY OF ROCKWALL, ROCKWALL COUNTY, TEXAS

SHEET 8 OF 40

SEE SHEET 8 FOR TYPICAL  
PAVING SECTION

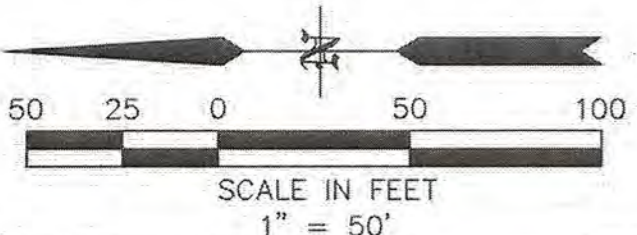

 MATCHLINE  
 PROPOSED ROAD  
 PROPOSED CONC. TRANS.  
 ASPHALT TO BE REMOVED  
 EXISTING WATER LINE  
 EXISTING STORM LINE  
 R.O.W. CENTER LINE  
 R.O.W. LINE  
 EXISTING UTILITY POLE  
 EXISTING OVERHEAD UTILITY

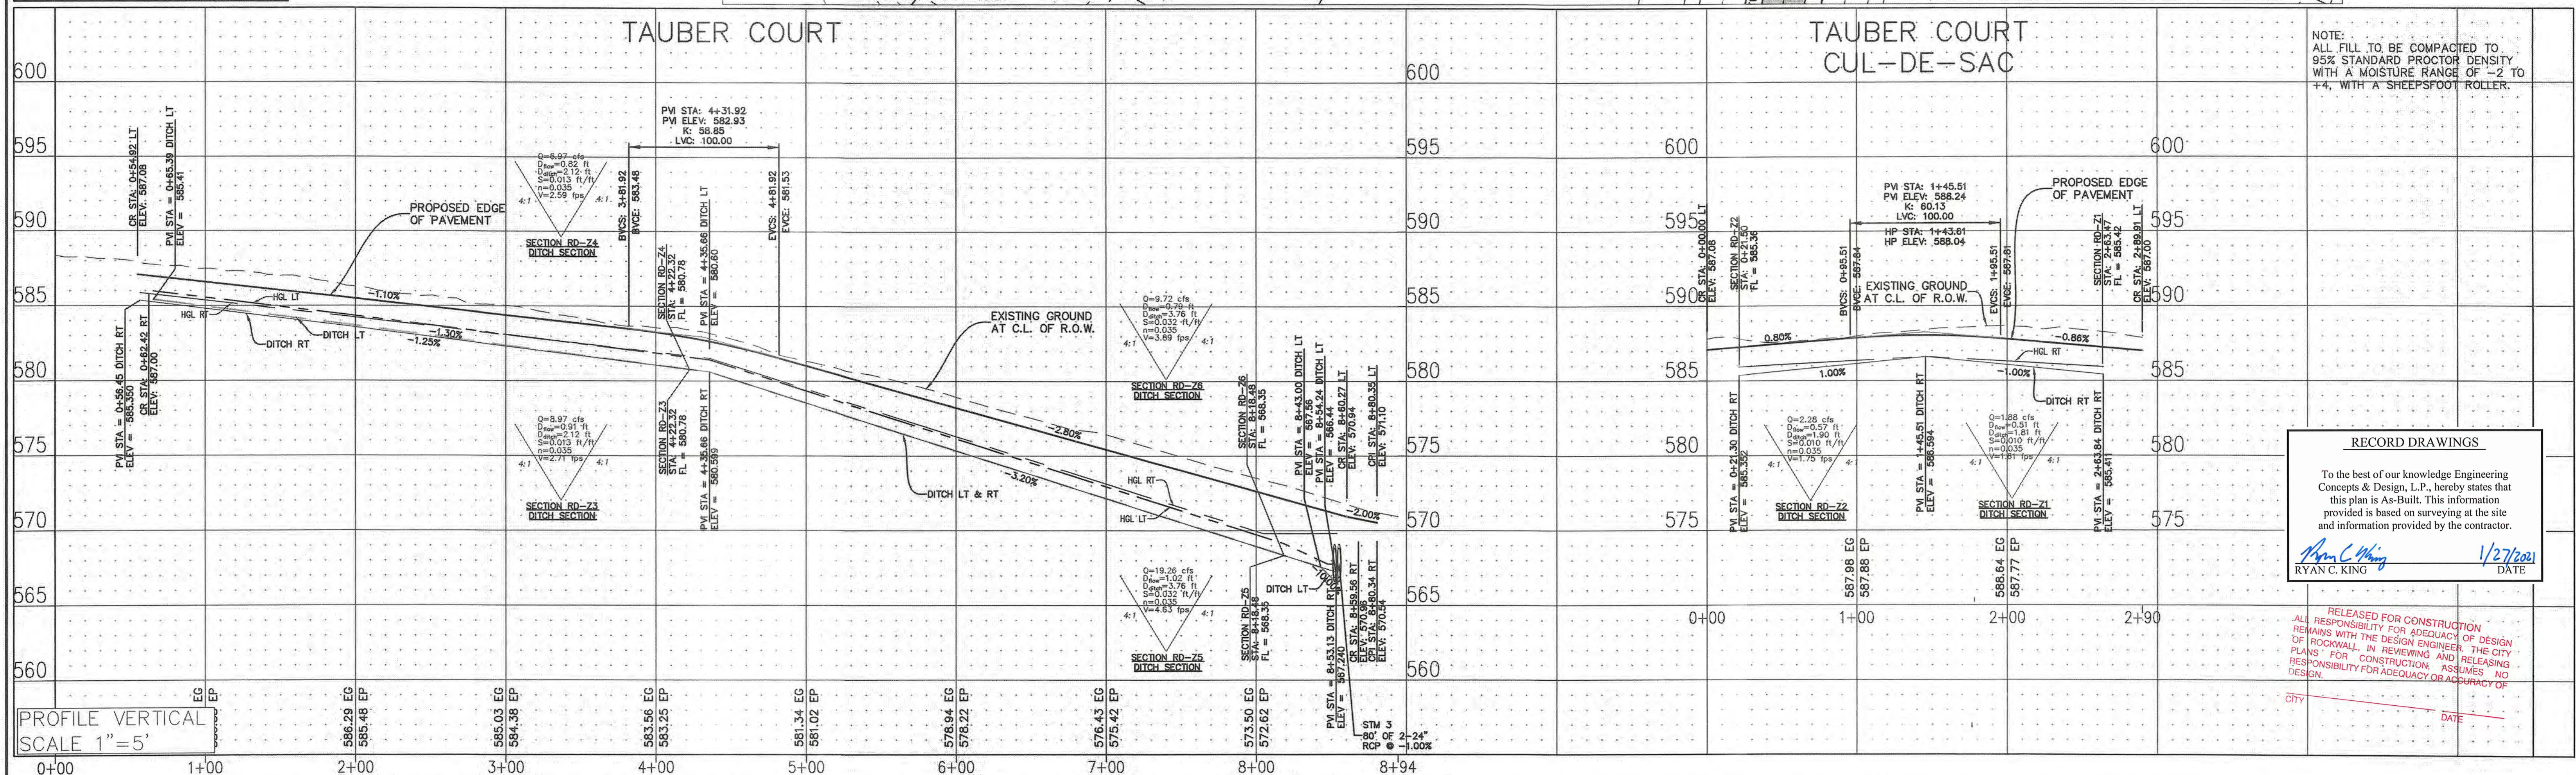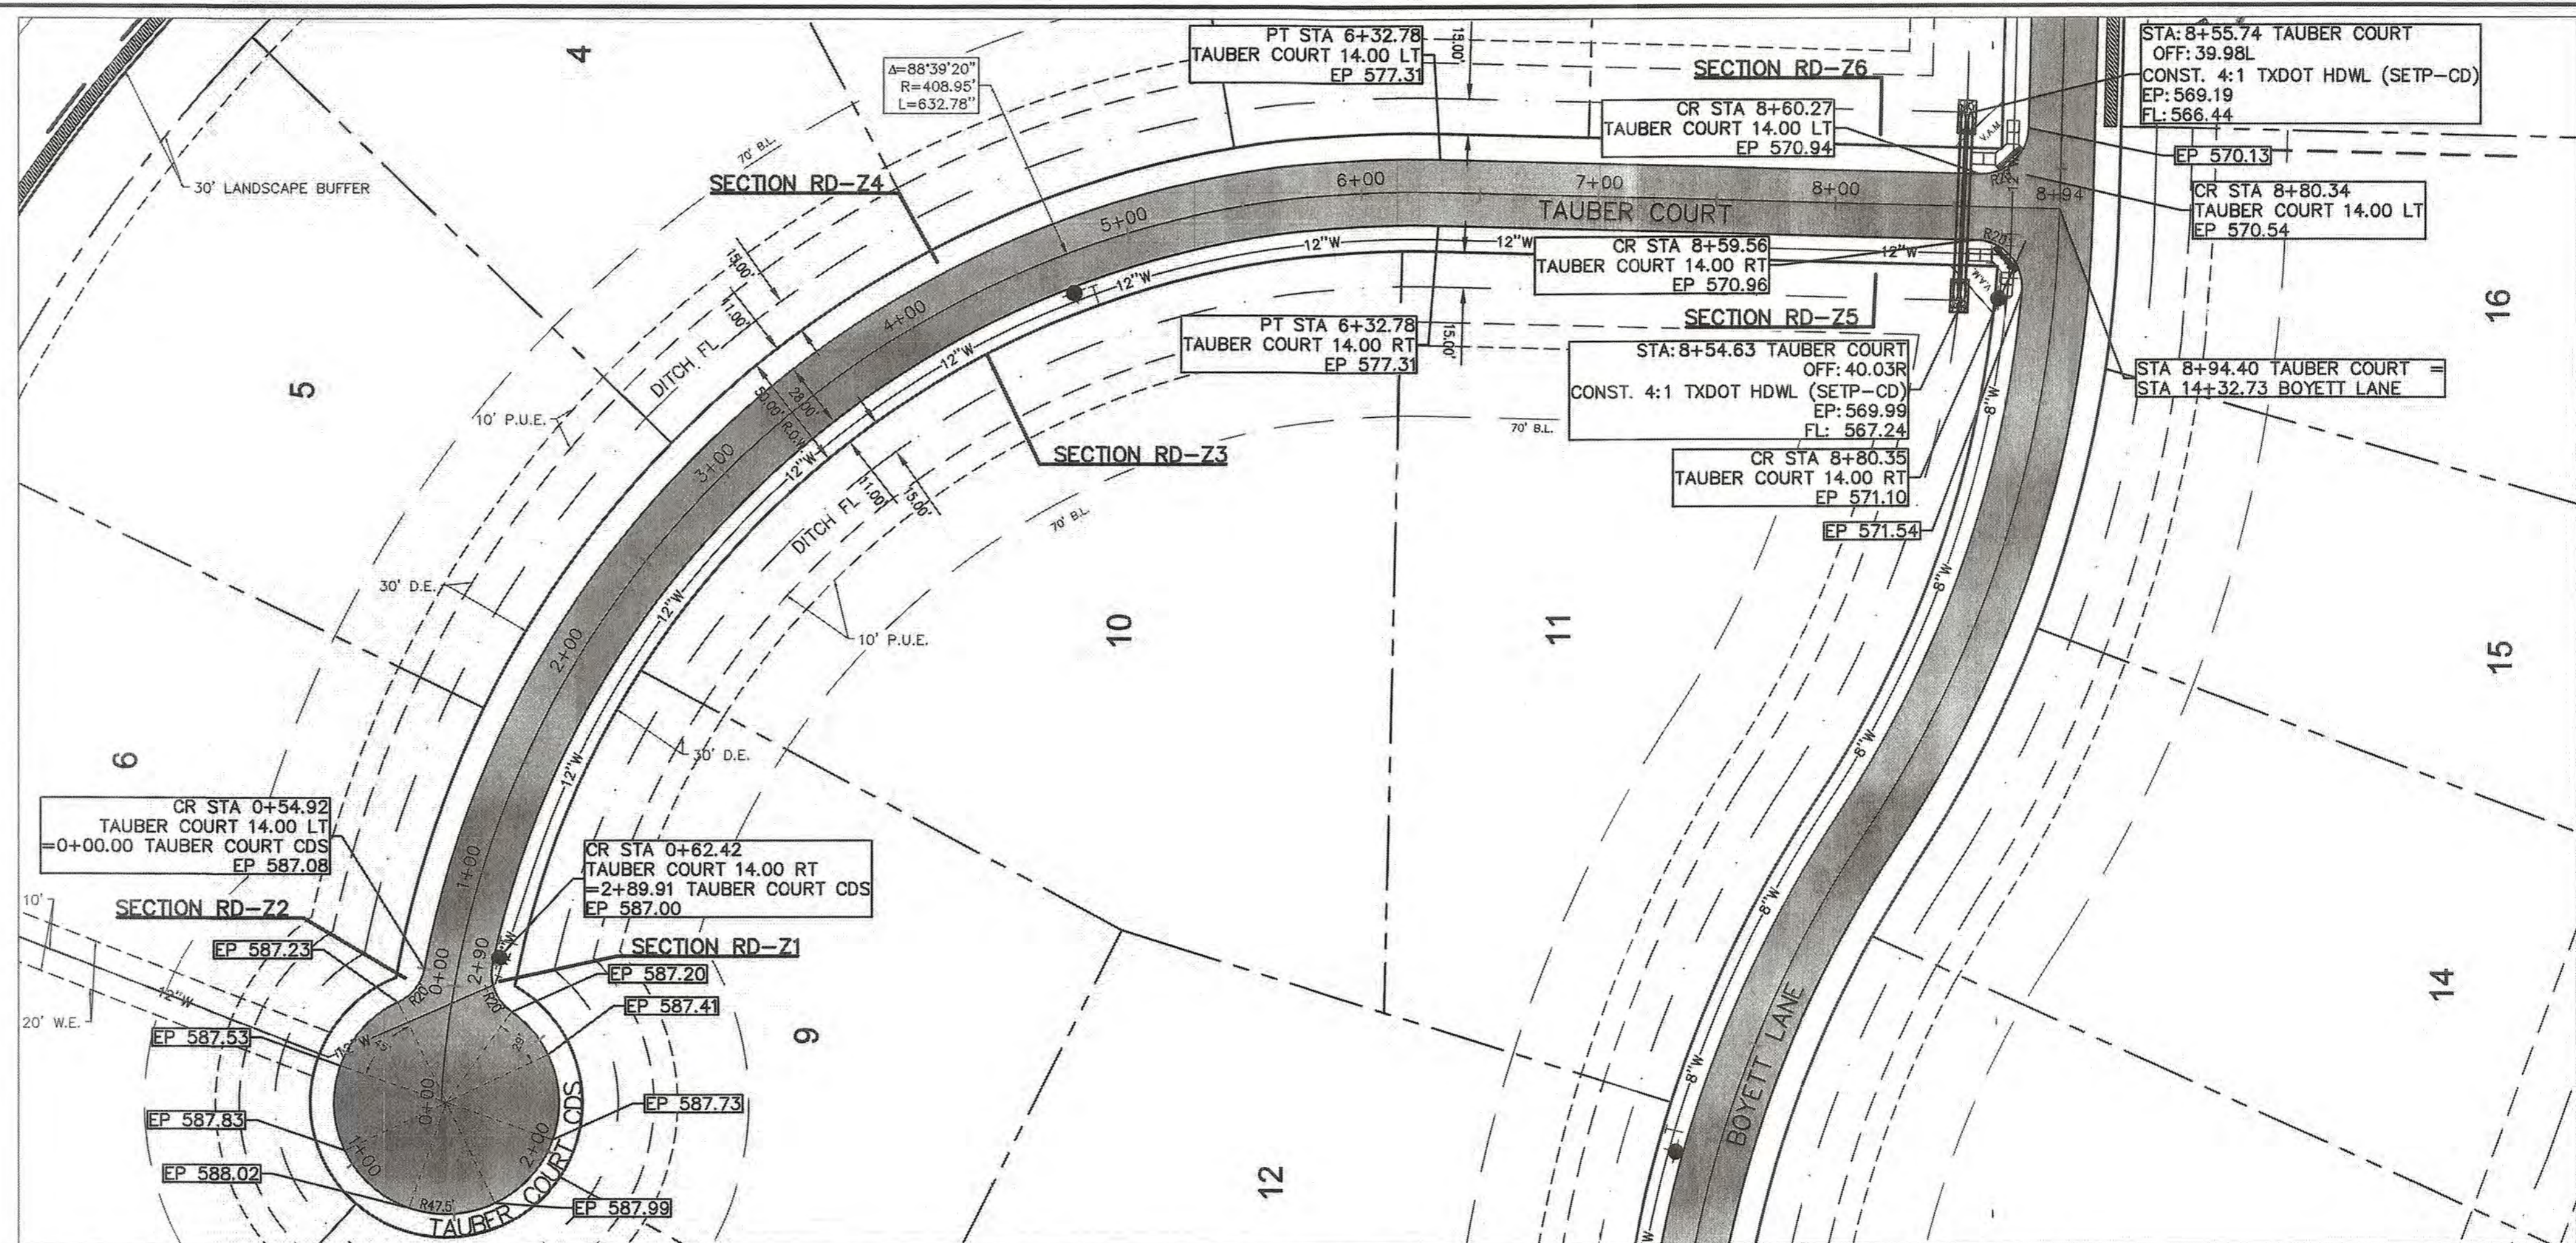

NOTE: ALL FILL TO BE COMPACTED TO 95% STANDARD PROCTOR DENSITY WITH A MOISTURE RANGE OF -2 TO +4, WITH A SHEEPSFOOT ROLLER.

## RECORD DRAWINGS

To the best of our knowledge Engineering Concepts & Design, L.P., hereby states that this plan is As-Built. This information provided is based on surveying at the site and information provided by the contractor.

RYAN C KING 1/27/2021

RELEASED FOR CONSTRUCTION  
ALL RESPONSIBILITY FOR ADEQUACY OF DESIGN  
REMAINS WITH THE DESIGN ENGINEER. THE CITY  
OF ROCKWALL, IN REVIEWING AND RELEASING  
PLANS FOR CONSTRUCTION, ASSUMES NO  
RESPONSIBILITY FOR ADEQUACY OR ACCURACY OF  
DESIGN.

CAUTION! EXISTING UTILITIES

CONTRACTOR SHOULD CALL 1-800-DIG-TRESS PRIOR TO BEGINNING ANY CONSTRUCTION ACTIVITIES FOR EXISTING UTILITY LOCATIONS. EXISTING UTILITIES AND UNDERGROUND FACILITIES INDICATED ON THESE PLANS HAVE BEEN LOCATED FROM REFERENCE INFORMATION. IT IS THE RESPONSIBILITY OF THE CONTRACTOR TO VERIFY BOTH HORIZONTALLY AND VERTICALLY THE LOCATION OF ALL EXISTING UTILITIES AND UNDERGROUND FACILITIES PRIOR TO CONSTRUCTION AND TO TAKE NECESSARY PRECAUTIONS IN ORDER TO PROTECT THESE FACILITIES ENCOUNTERED. THE CONTRACTOR SHALL BE RESPONSIBLE TO PROTECT ALL EXISTING UTILITIES FROM DAMAGE DURING CONSTRUCTION.

BM-1: "PK" Nail on the south side of Clem Road,  
approximately 2275' west of the centerline intersection  
of Clem Road and FM 3549  
Elev.: 559.07'

BM-2: "PK" Nail in Clem Road,  
approximately 175' west of the centerline intersection  
of Clem Road and FM 3549  
Elev.: 584.83'



**ENGINEERING CONCEPTS**  
& DESIGN, L.P.

ENGINEERING / PROJECT MANAGEMENT /  
CONSTRUCTION SERVICES - FIRM REG. #F-001145  
201 WINDCO CIR, STE 200, WYLIE, TX 75098  
972-941-8400 FAX: 972-941-8401 WWW.ECDLP.COM

## REVISIONS:

DRAWN:	MJH
CHECKED:	RCK
PROJECT NO.:	08838
DWG FILE NAME:	08838 PV.DWG

THIS DOCUMENT IS RELEASED FOR  
THE PURPOSE OF CONSTRUCTION.  
THE SEAL APPEARING ON THIS DOCUMENT WAS  
AUTHORIZED BY RYAN C. KING, P.E. 123635



PAVING PLAN - TAUBER COURT

**NORTHGATE**  
CITY OF ROCKWALL, ROCKWALL COUNTY, TEXAS

SHEET

9



OF

40

\*ALL RESPONSIBILITY FOR ADEQUACY OF DESIGN REMAINS WITH THE DESIGN ENGINEER. THE CITY OF ROCKWALL, IN REVIEWING AND RELEASING PLANS FOR CONSTRUCTION, ASSUMES NO RESPONSIBILITY FOR ADEQUACY OR ACCURACY OF DESIGN.

EX. ASPHALT TO REMAIN FOR DRIVEWAY ADDITIONS		
BEGIN STA	END STA	
DW 1	3+12.29	3+64.51
DW 2	3+84.91	4+37.34
DW 3	5+26.59	5+71.16
DW 4	8+72.94	9+09.26
DW 5	9+43.37	9+90.09
DW 6	10+48.52	10+69.57
DW 7	11+18.04	11+49.04
DW 8	12+67.23	13+17.75
DW 9	14+58.66	15+06.78

- DRIVEWAY CONNECTION NOTES:
- 1) FEATHER IN EXISTING ASPHALT PAVEMENT SO THAT THERE IS A SMOOTH TRANSITION FROM THE NEW CONCRETE ROAD TO THE EXISTING ASPHALT DRIVEWAYS
  - 2) PROPOSED DRIVEWAY TRANSITION TO HAVE THE SAME CONCRETE SPECIFICATIONS AS THE PROPOSED CLEM ROAD

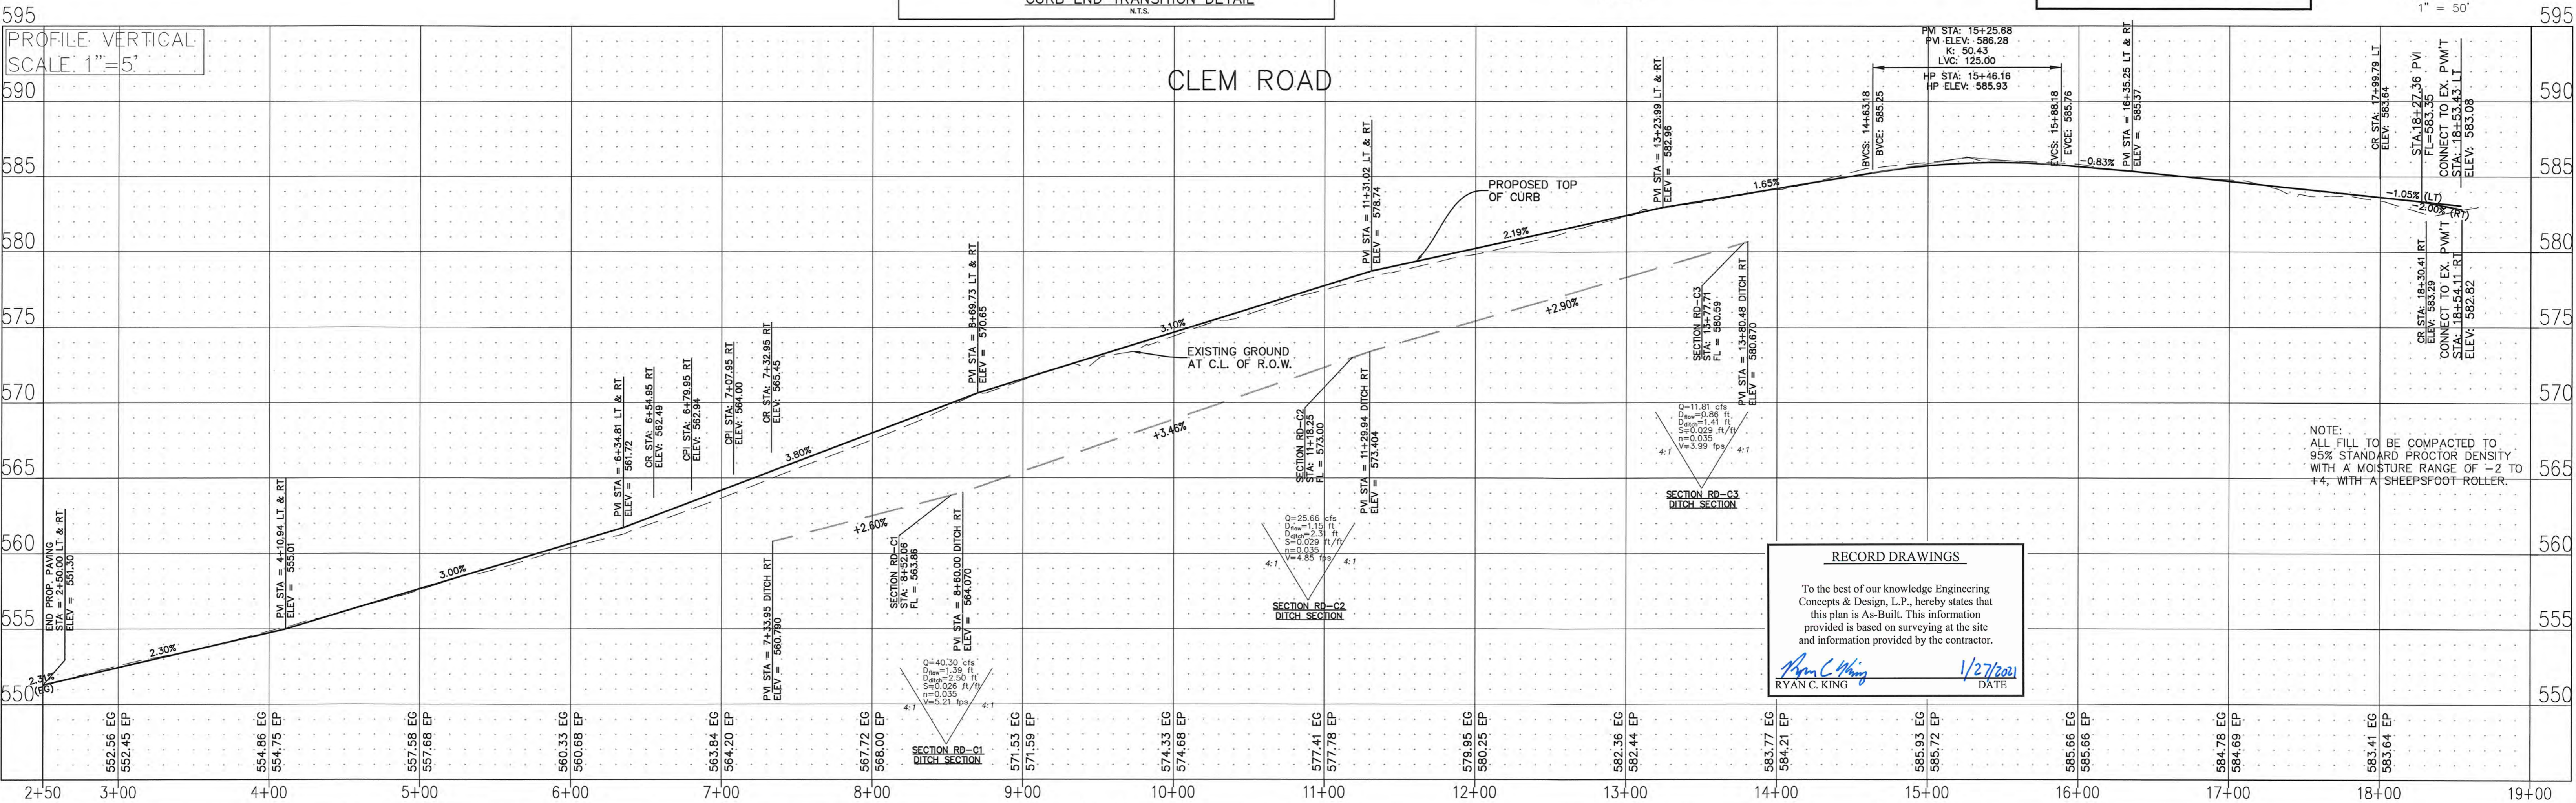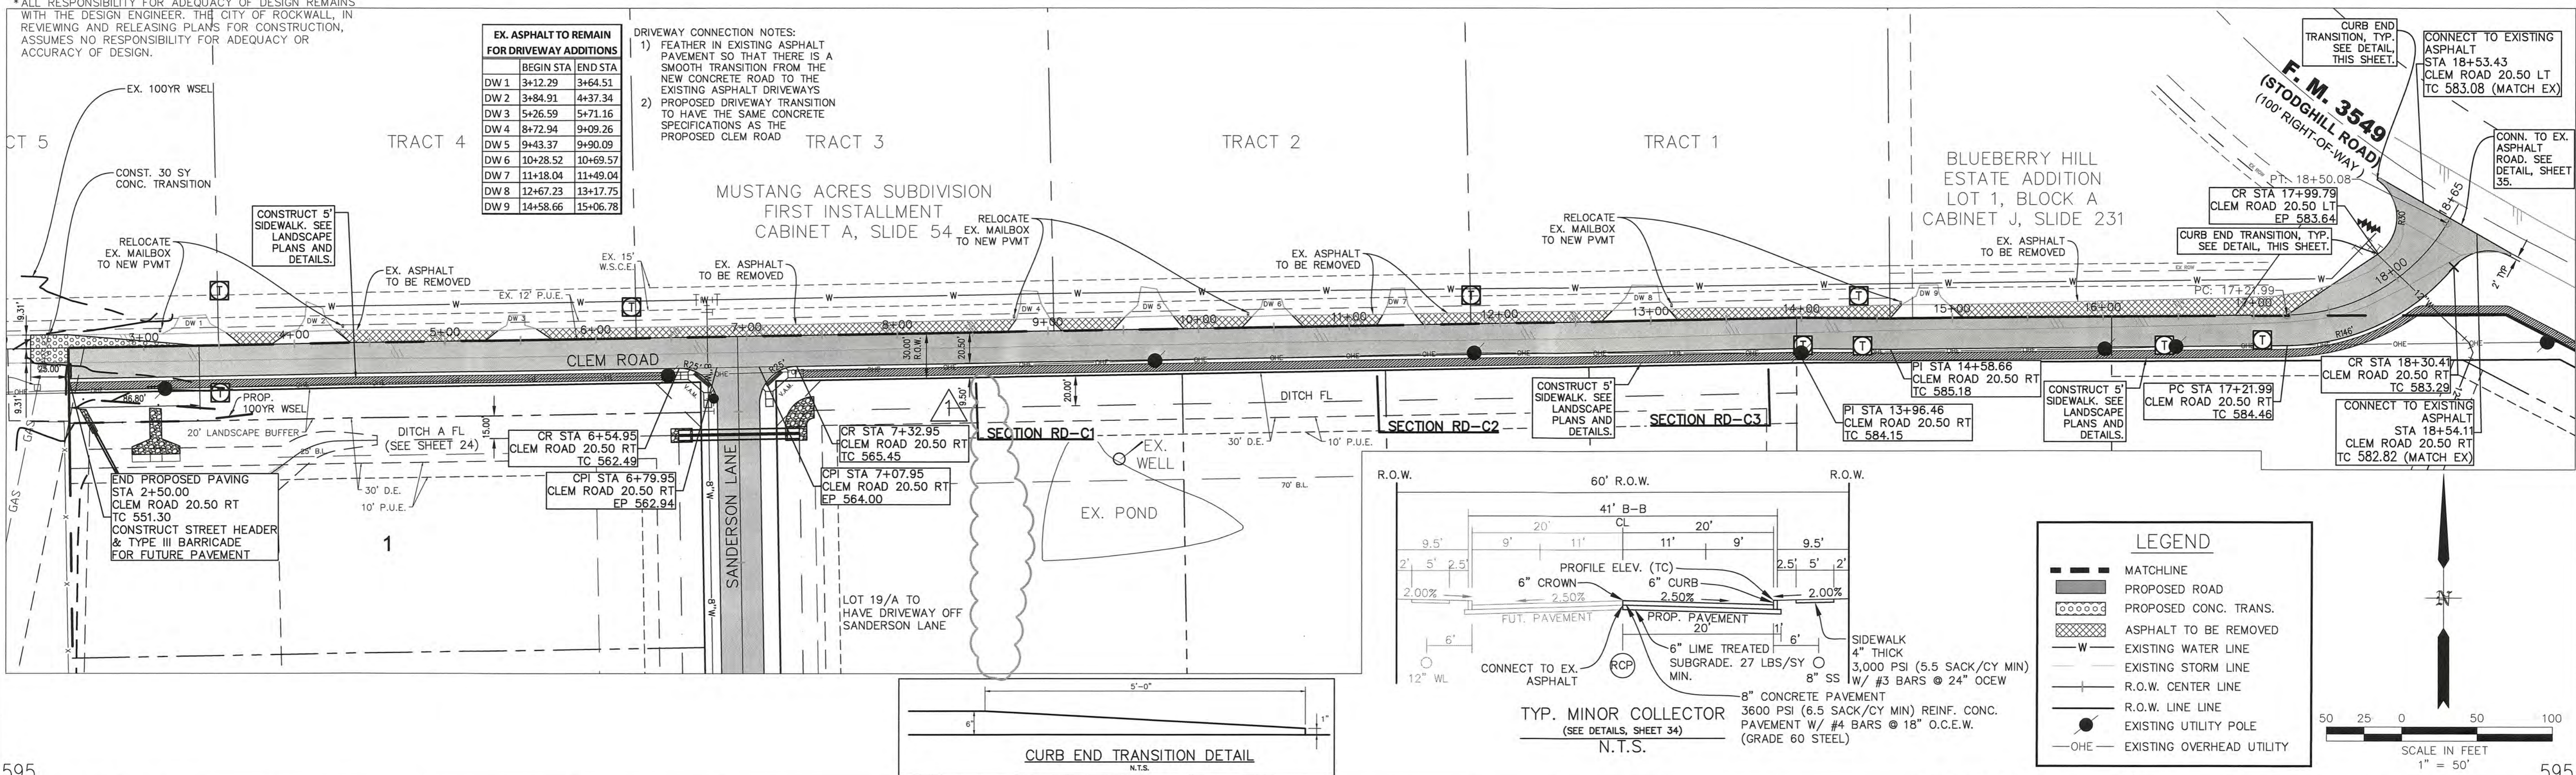

**CAUTION! EXISTING UTILITIES**

CONTRACTOR SHOULD CALL 1-800-DIG-TESS PRIOR TO BEGINNING ANY CONSTRUCTION ACTIVITIES FOR EXISTING UTILITY LOCATIONS. EXISTING UTILITIES AND UNDERGROUND FACILITIES INDICATED ON THESE PLANS HAVE BEEN LOCATED FROM REFERENCE INFORMATION. IT IS THE RESPONSIBILITY OF THE CONTRACTOR TO VERIFY BOTH HORIZONTALLY AND VERTICALLY THE LOCATION OF ALL EXISTING UTILITIES AND UNDERGROUND FACILITIES PRIOR TO CONSTRUCTION AND TO TAKE NECESSARY PRECAUTIONS IN ORDER TO PROTECT ALL FACILITIES ENCOUNTERED. THE CONTRACTOR SHALL PRESERVE AND PROTECT ALL EXISTING UTILITIES FROM DAMAGE DURING CONSTRUCTION.

BM-1: "PK" Nail on the south side of Clem Road, approximately 2275' west of the centerline intersection of Clem Road and FM 3549  
Elev.: 559.07'

BM-2: "PK" Nail in Clem Road, approximately 175' west of the centerline intersection of Clem Road and FM 3549  
Elev.: 584.83'

**ENGINEERINGCONCEPTS**  
& DESIGN, L.P.

ENGINEERING / PROJECT MANAGEMENT /  
CONSTRUCTION SERVICES - FIRM REG. #F-001145  
201 WINDCO CIR, STE 200, WYLIE, TX 75098  
972-941-8400 FAX: 972-941-8401 WWW.ECDLP.COM

REVISIONS:

1/25/2021 COMBINED LOTS A19 & A20

DRAWN: MJH DATE: 6/1/2020  
CHECKED: RCK DATE: 6/1/2020  
PROJECT NO.: 08838  
DWG FILE NAME: 08838.PV.DWG

THIS DOCUMENT IS RELEASED FOR THE PURPOSE OF CONSTRUCTION. THE SEAL APPEARING ON THIS DOCUMENT WAS AUTHORIZED BY RYAN C. KING, P.E. 123635





**PAVING PLAN - CLEM ROAD**

**NORTHGATE**

CITY OF ROCKWALL, ROCKWALL COUNTY, TEXAS


SHEET  
10  
OF  
40

# CLEM ROAD STA 0+00 - 15+00

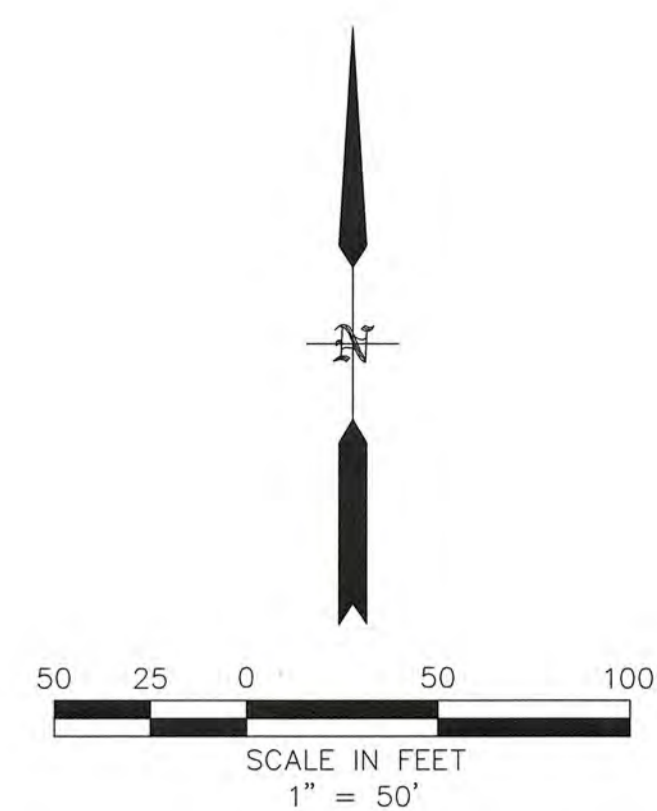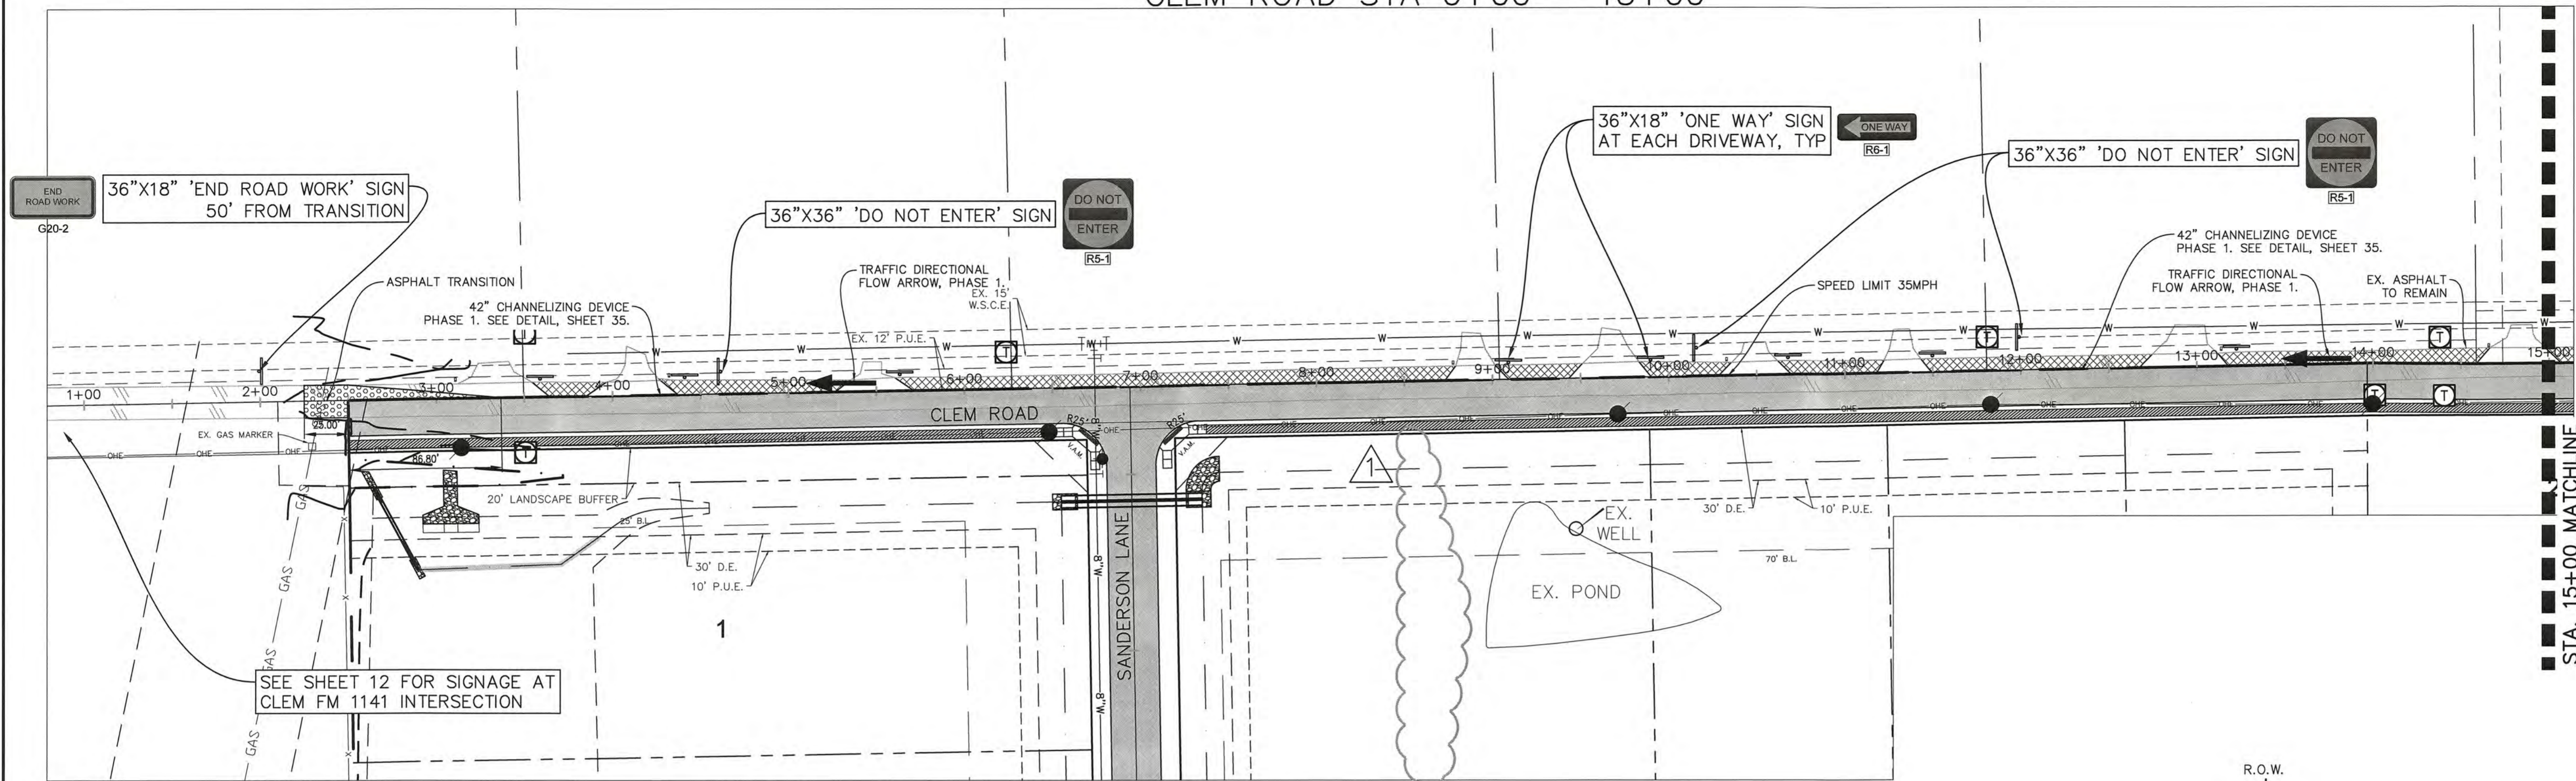


LEGEND	
	MATCHLINE
	PROPOSED ROAD
	PROPOSED CONC. TRANS.
	ASPHALT TO BE REMOVED
	EXISTING WATER LINE
	EXISTING STORM LINE
	R.O.W. CENTER LINE
	R.O.W. LINE LINE
	EXISTING UTILITY POLE
	EXISTING OVERHEAD UTILITY

## CLEM ROAD STA 15+00 - END

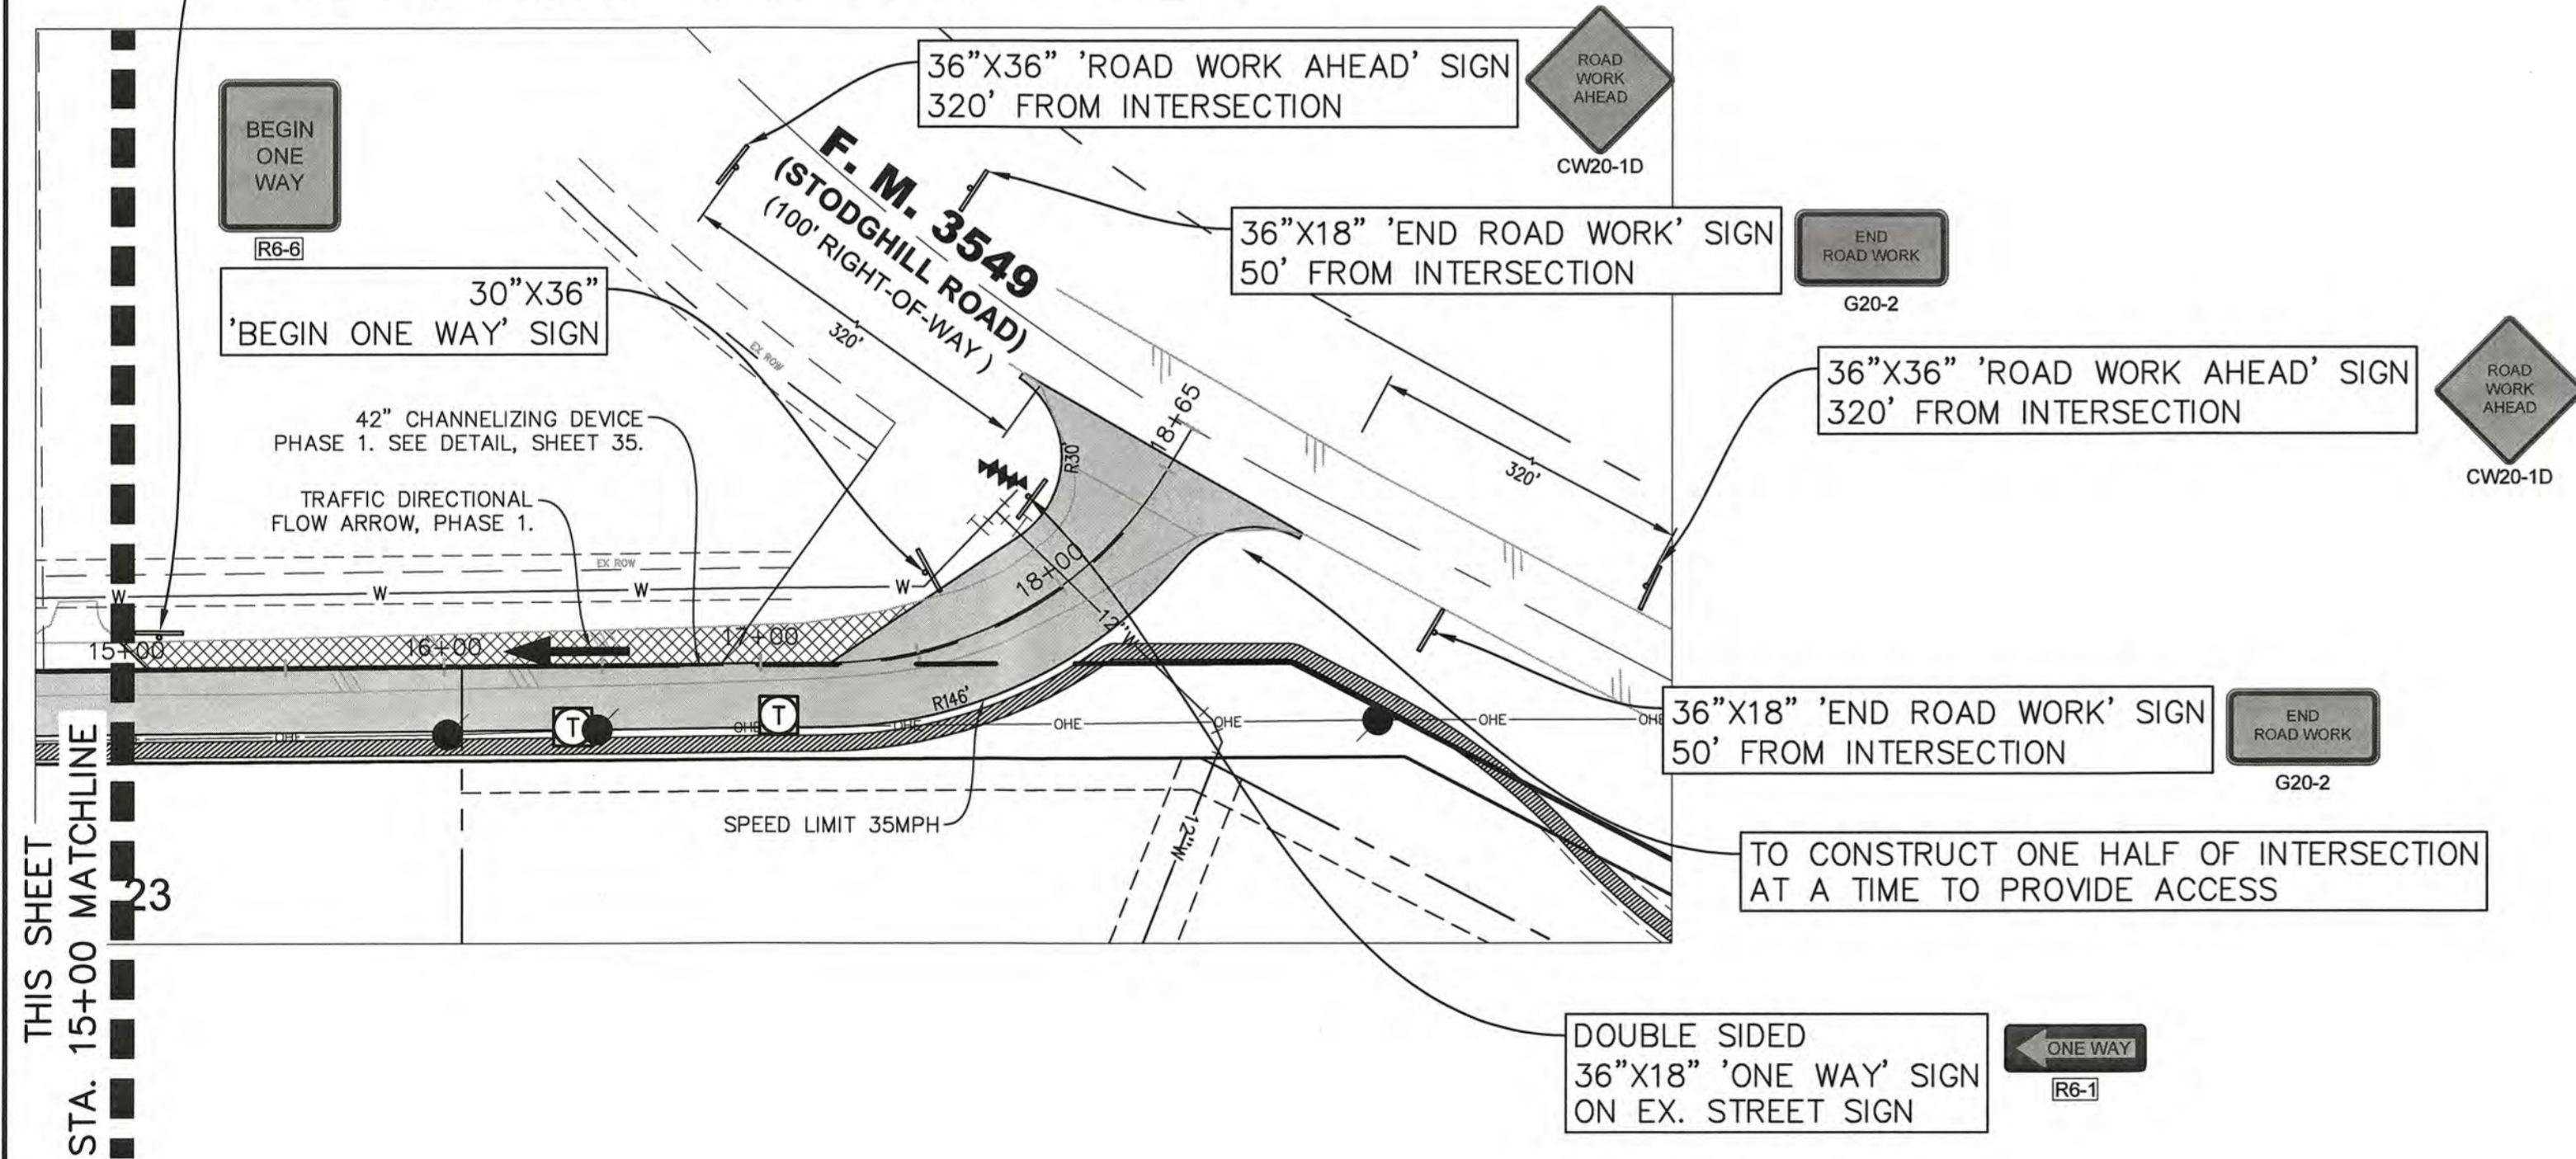


### CLEM ROAD CONSTRUCTION SEQUENCE OF EVENTS:

- PHASE 1
- 1) NOTIFY CITY 3 WEEKS IN ADVANCE
  - 2) PLACE BARRICADE
  - 3) INSTALL TEMPORARY TRAFFIC CONTROL
  - 4) CLOSE EASTBOUND TRAFFIC, WESTBOUND TRAFFIC TO REMAIN ON EXISTING ASPHALT
  - 5) REMOVE EXISTING ASPHALT
  - 6) CONSTRUCT 20' CONCRETE PAVING LANE
  - 7) INSTALL CONCRETE TRANSITIONS

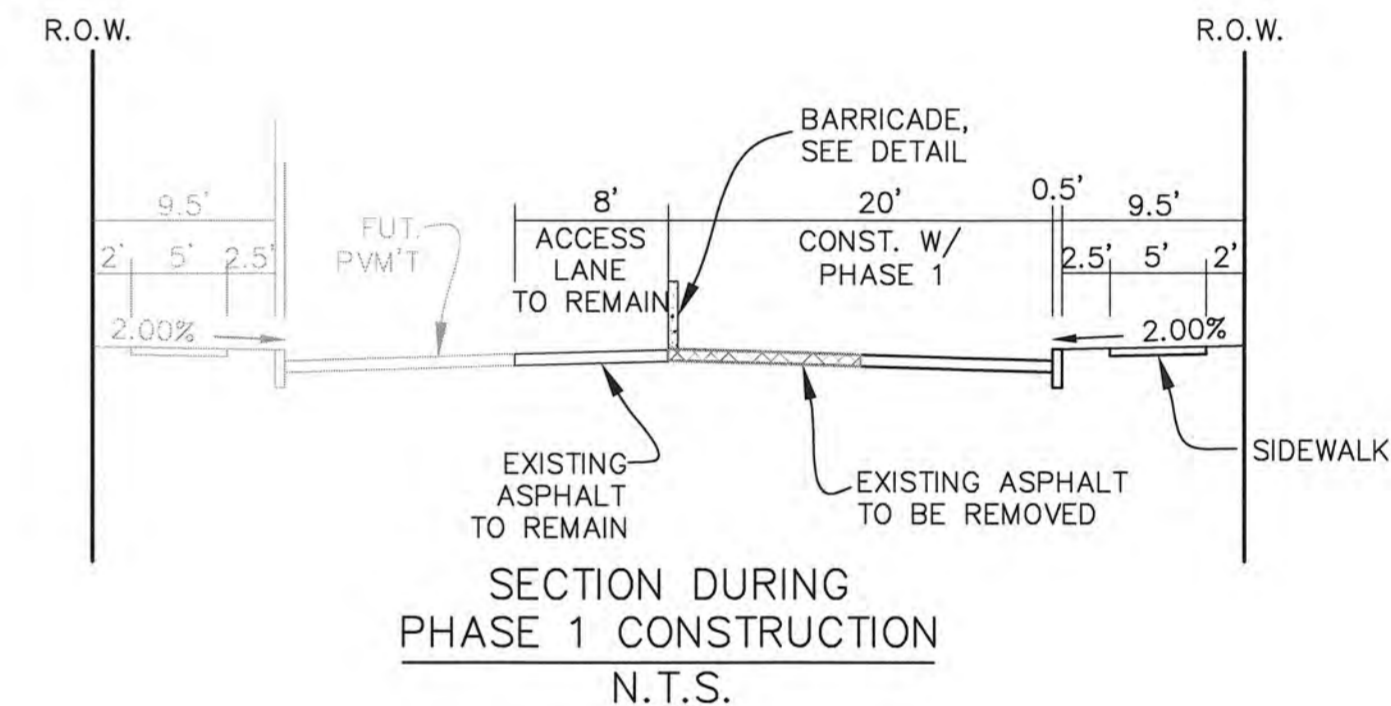

- PHASE 2
- 1) REMOVE BARRICADE
  - 2) OPEN EASTBOUND & WESTBOUND TRAFFIC ON NEW PAVEMENT
  - 3) REMOVE EXISTING ASPHALT (ASPHALT IN FRONT OF EXISTING DRIVEWAYS TO REMAIN, SEE SHEET 10)
  - 4) SOD DISTURBED R.O.W. AREA

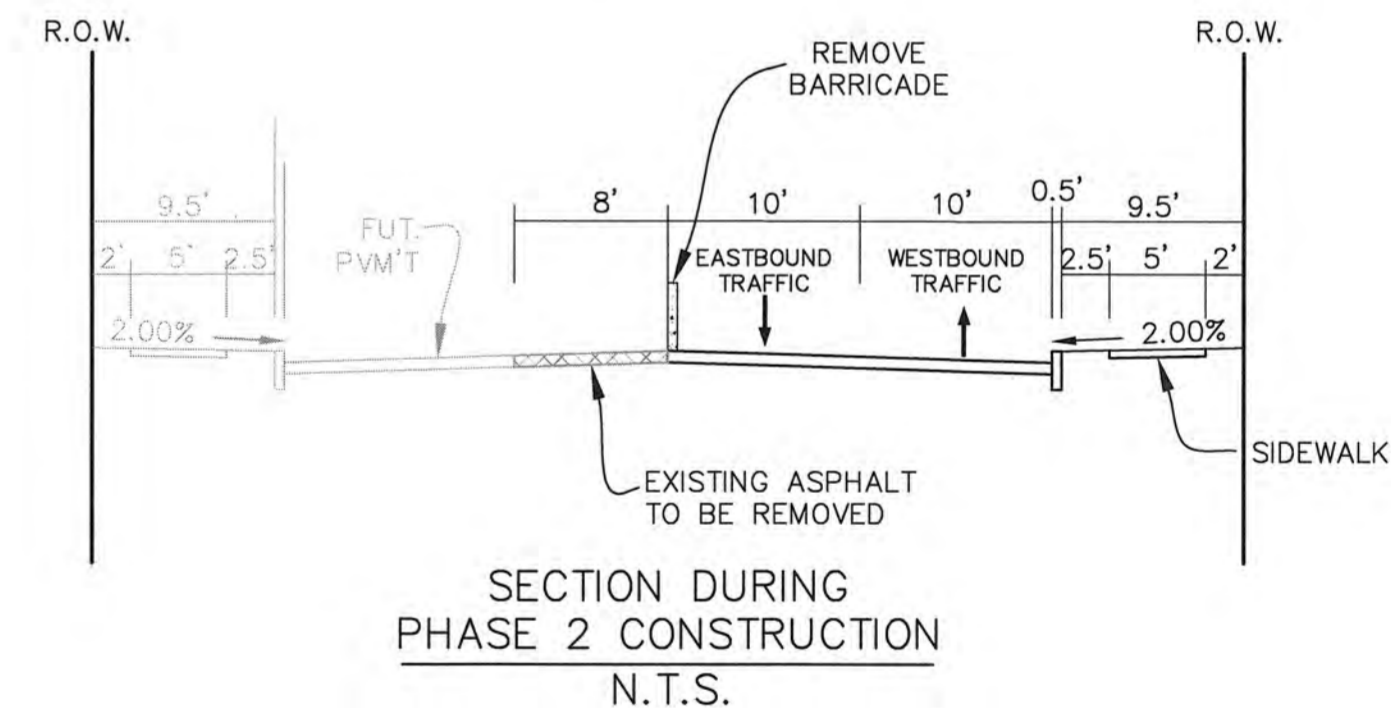

- NOTE:
- 1) ONE-WAY TRAFFIC TO BE WESTBOUND FROM STODGHELL TO FM 1141.
  - 2) CONTRACTOR/DEVELOPER WILL BE RESPONSIBLE FOR NOTIFYING ALL PROPERTY OWNERS ALONG CLOSURE AND EMERGENCY SERVICES (FIRE, POLICE, EMS), SCHOOL DISTRICTS, TRASH SERVICES, CITY PUBLIC COMMUNICATIONS OFFICERS, AND ENGINEERING DEPARTMENT OF CLOSURE 3 WEEKS BEFORE IT OCCURS. THIS INCLUDES PREPARATION OF ALL NOTICES TO BE PREPARED AND DISTRIBUTED.
  - 3) CONTRACTOR/DEVELOPER RESPONSIBLE FOR ALL SIGNAGE, BARRICADES, DETOURS, AND MESSAGE BOARDS FOR THE PROJECT.
  - 4) READ AND INCLUDE IN PLANS NOTES PER SECTION 2.17 TEMP. TRAFFIC CONTROL OF CITY STANDARDS.
  - 5) PLACE MESSAGE BOARDS OUT 2 WEEKS PRIOR TO START OF CLOSURE
  - 6) EXISTING ESTATE LOTS TO HAVE ACCESS AT ALL TIMES.

### RECORD DRAWINGS

To the best of our knowledge Engineering Concepts & Design, L.P., hereby states that this plan is As-Built. This information provided is based on surveying at the site and information provided by the contractor.

*Ryan C. King*  
RYAN C. KING  
1/27/2021  
DATE

\*ALL RESPONSIBILITY FOR ADEQUACY OF DESIGN REMAINS WITH THE DESIGN ENGINEER. THE CITY OF ROCKWALL, IN REVIEWING AND RELEASING PLANS FOR CONSTRUCTION, ASSUMES NO RESPONSIBILITY FOR ADEQUACY OR ACCURACY OF DESIGN.

**CAUTION! EXISTING UTILITIES**  
CONTRACTOR SHOULD CALL 1-800-DIG-TESS PRIOR TO BEGINNING ANY CONSTRUCTION ACTIVITIES FOR EXISTING UTILITY LOCATIONS. EXISTING UTILITIES AND UNDERGROUND FACILITIES INDICATED ON THESE PLANS HAVE BEEN LOCATED FROM REFERENCE INFORMATION. IT IS THE RESPONSIBILITY OF THE CONTRACTOR TO VERIFY BOTH HORIZONTALLY AND VERTICALLY THE LOCATION OF ALL EXISTING UTILITIES AND UNDERGROUND FACILITIES PRIOR TO CONSTRUCTION AND TO TAKE NECESSARY PRECAUTIONS IN ORDER TO PROTECT ALL FACILITIES ENCOUNTERED. THE CONTRACTOR SHALL PRESERVE AND PROTECT ALL EXISTING UTILITIES FROM DAMAGE DURING CONSTRUCTION.

BM-1: "PK" Nail on the south side of Clem Road, approximately 2275' west of the centerline intersection of Clem Road and FM 3549  
Elev.: 559.07'

BM-2: "PK" Nail in Clem Road, approximately 175' west of the centerline intersection of Clem Road and FM 3549  
Elev.: 584.83'

**ENGINEERINGCONCEPTS**  
& DESIGN, L.P.

ENGINEERING / PROJECT MANAGEMENT /  
CONSTRUCTION SERVICES - FIRM REG. #F-001145  
201 WINDCO CIR, STE 200, WYLIE, TX 75098  
972-941-8400 FAX: 972-941-8401 WWW.ECDLP.COM

REVISIONS:  
1/25/2021 COMBINED LOTS A19 & A20


DRAWN: MJH DATE:  
CHECKED: RCK DATE: 6/1/2020  
PROJECT NO.: 08838  
DWG FILE NAME: 08838 PV.DWG

THIS DOCUMENT IS RELEASED FOR  
THE PURPOSE OF CONSTRUCTION.  
THE SEAL APPEARING ON THIS DOCUMENT WAS  
AUTHORIZED BY RYAN C. KING, P.E. 123635



**TRAFFIC CONTROL PLAN - CLEM ROAD NORTHGATE**  
CITY OF ROCKWALL, ROCKWALL COUNTY, TEXAS

SHEET  
11  
OF  
40

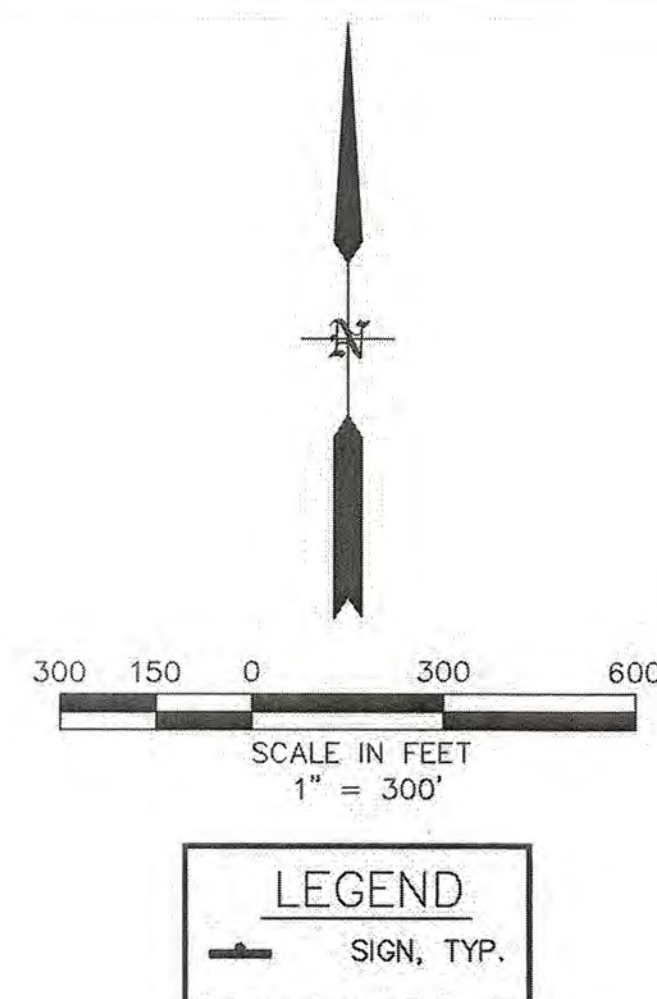

**RECORD DRAWINGS**

To the best of our knowledge Engineering Concepts & Design, L.P., hereby states that this plan is As-Built. This information provided is based on surveying at the site and information provided by the contractor.

*Ryan C. King*  
RYAN C. KING  
1/27/2021  
DATE

ALL RESPONSIBILITY FOR ADEQUACY OF DESIGN REMAINS WITH THE DESIGN ENGINEER. THE CITY OF ROCKWALL, IN REVIEWING AND RELEASING PLANS FOR CONSTRUCTION, ASSUMES NO RESPONSIBILITY FOR ADEQUACY OR ACCURACY OF DESIGN.

THIS PLAN IS FOR ILLUSTRATIVE PURPOSES ONLY AND IS NOT INTENDED TO RELIEVE THE CONTRACTOR FROM THE REQUIREMENTS SET FORTH BY RELATED CONTRACT DOCUMENTS, THE TEXAS MANUAL ON UNIFORM TRAFFIC CONTROL DEVICES (MUTCD), OR THE OVERALL RESPONSIBILITY TO TRAFFIC CONTROL SAFETY

**CAUTION! EXISTING UTILITIES**

CONTRACTOR SHOULD CALL 1-800-DIG-TESS PRIOR TO BEGINNING ANY CONSTRUCTION ACTIVITIES FOR EXISTING UTILITY LOCATIONS. EXISTING UTILITIES AND UNDERGROUND FACILITIES INDICATED ON THESE PLANS HAVE BEEN LOCATED FROM REFERENCE INFORMATION. IT IS THE RESPONSIBILITY OF THE CONTRACTOR TO VERIFY BOTH HORIZONTALLY AND VERTICALLY THE LOCATION OF ALL EXISTING UTILITIES AND UNDERGROUND FACILITIES PRIOR TO CONSTRUCTION AND TO TAKE NECESSARY PRECAUTIONS IN ORDER TO PROTECT ALL FACILITIES ENCOUNTERED. THE CONTRACTOR SHALL PRESERVE AND PROTECT ALL EXISTING UTILITIES FROM DAMAGE DURING CONSTRUCTION.

BM-1: "PK" Nail on the south side of Clem Road, approximately 2275' west of the centerline intersection of Clem Road and FM 3549  
Elev.: 559.07'

BM-2: "PK" Nail in Clem Road, approximately 175' west of the centerline intersection of Clem Road and FM 3549  
Elev.: 584.83'

**ENGINEERINGCONCEPTS**  
& DESIGN, L.P.

ENGINEERING / PROJECT MANAGEMENT /  
CONSTRUCTION SERVICES - FIRM REG. #F-001145  
201 WINDCO CIR, STE 200, WYLIE, TX 75098  
972-941-8400 FAX: 972-941-8401 WWW.ECDLP.COM

REVISIONS:

NO.	DESCRIPTION	DATE
1	ISSUED FOR PERMIT	6/1/2020



DRAWN: MJH  
CHECKED: RCK  
PROJECT NO.: 08838  
DWG FILE NAME: 08838 DETOUR.DWG

THIS DOCUMENT IS RELEASED FOR THE PURPOSE OF CONSTRUCTION. THE SEAL APPEARING ON THIS DOCUMENT WAS AUTHORIZED BY RYAN C. KING, P.E. 123635



**DETOUR PLAN**  
**NORTHGATE**  
CITY OF ROCKWALL, ROCKWALL COUNTY, TEXAS

SHEET  
12  
OF  
40

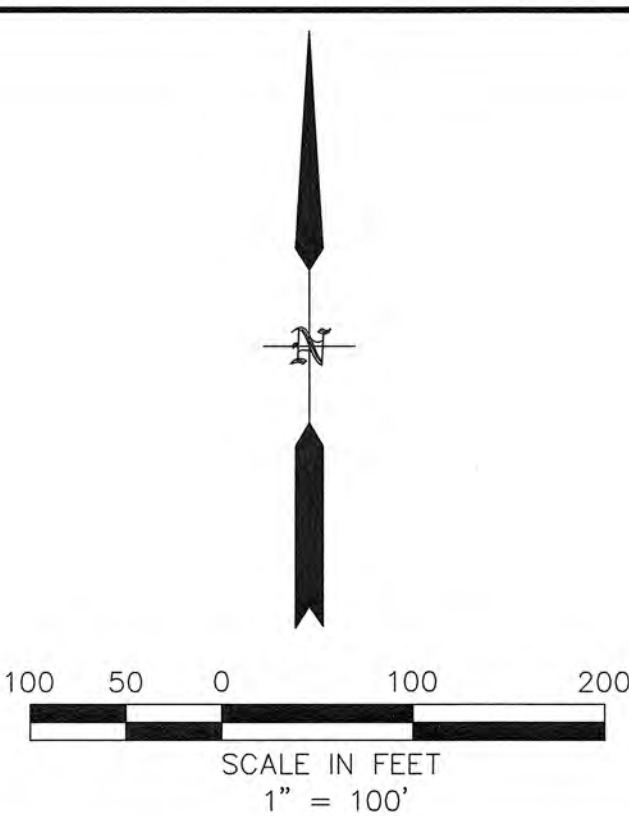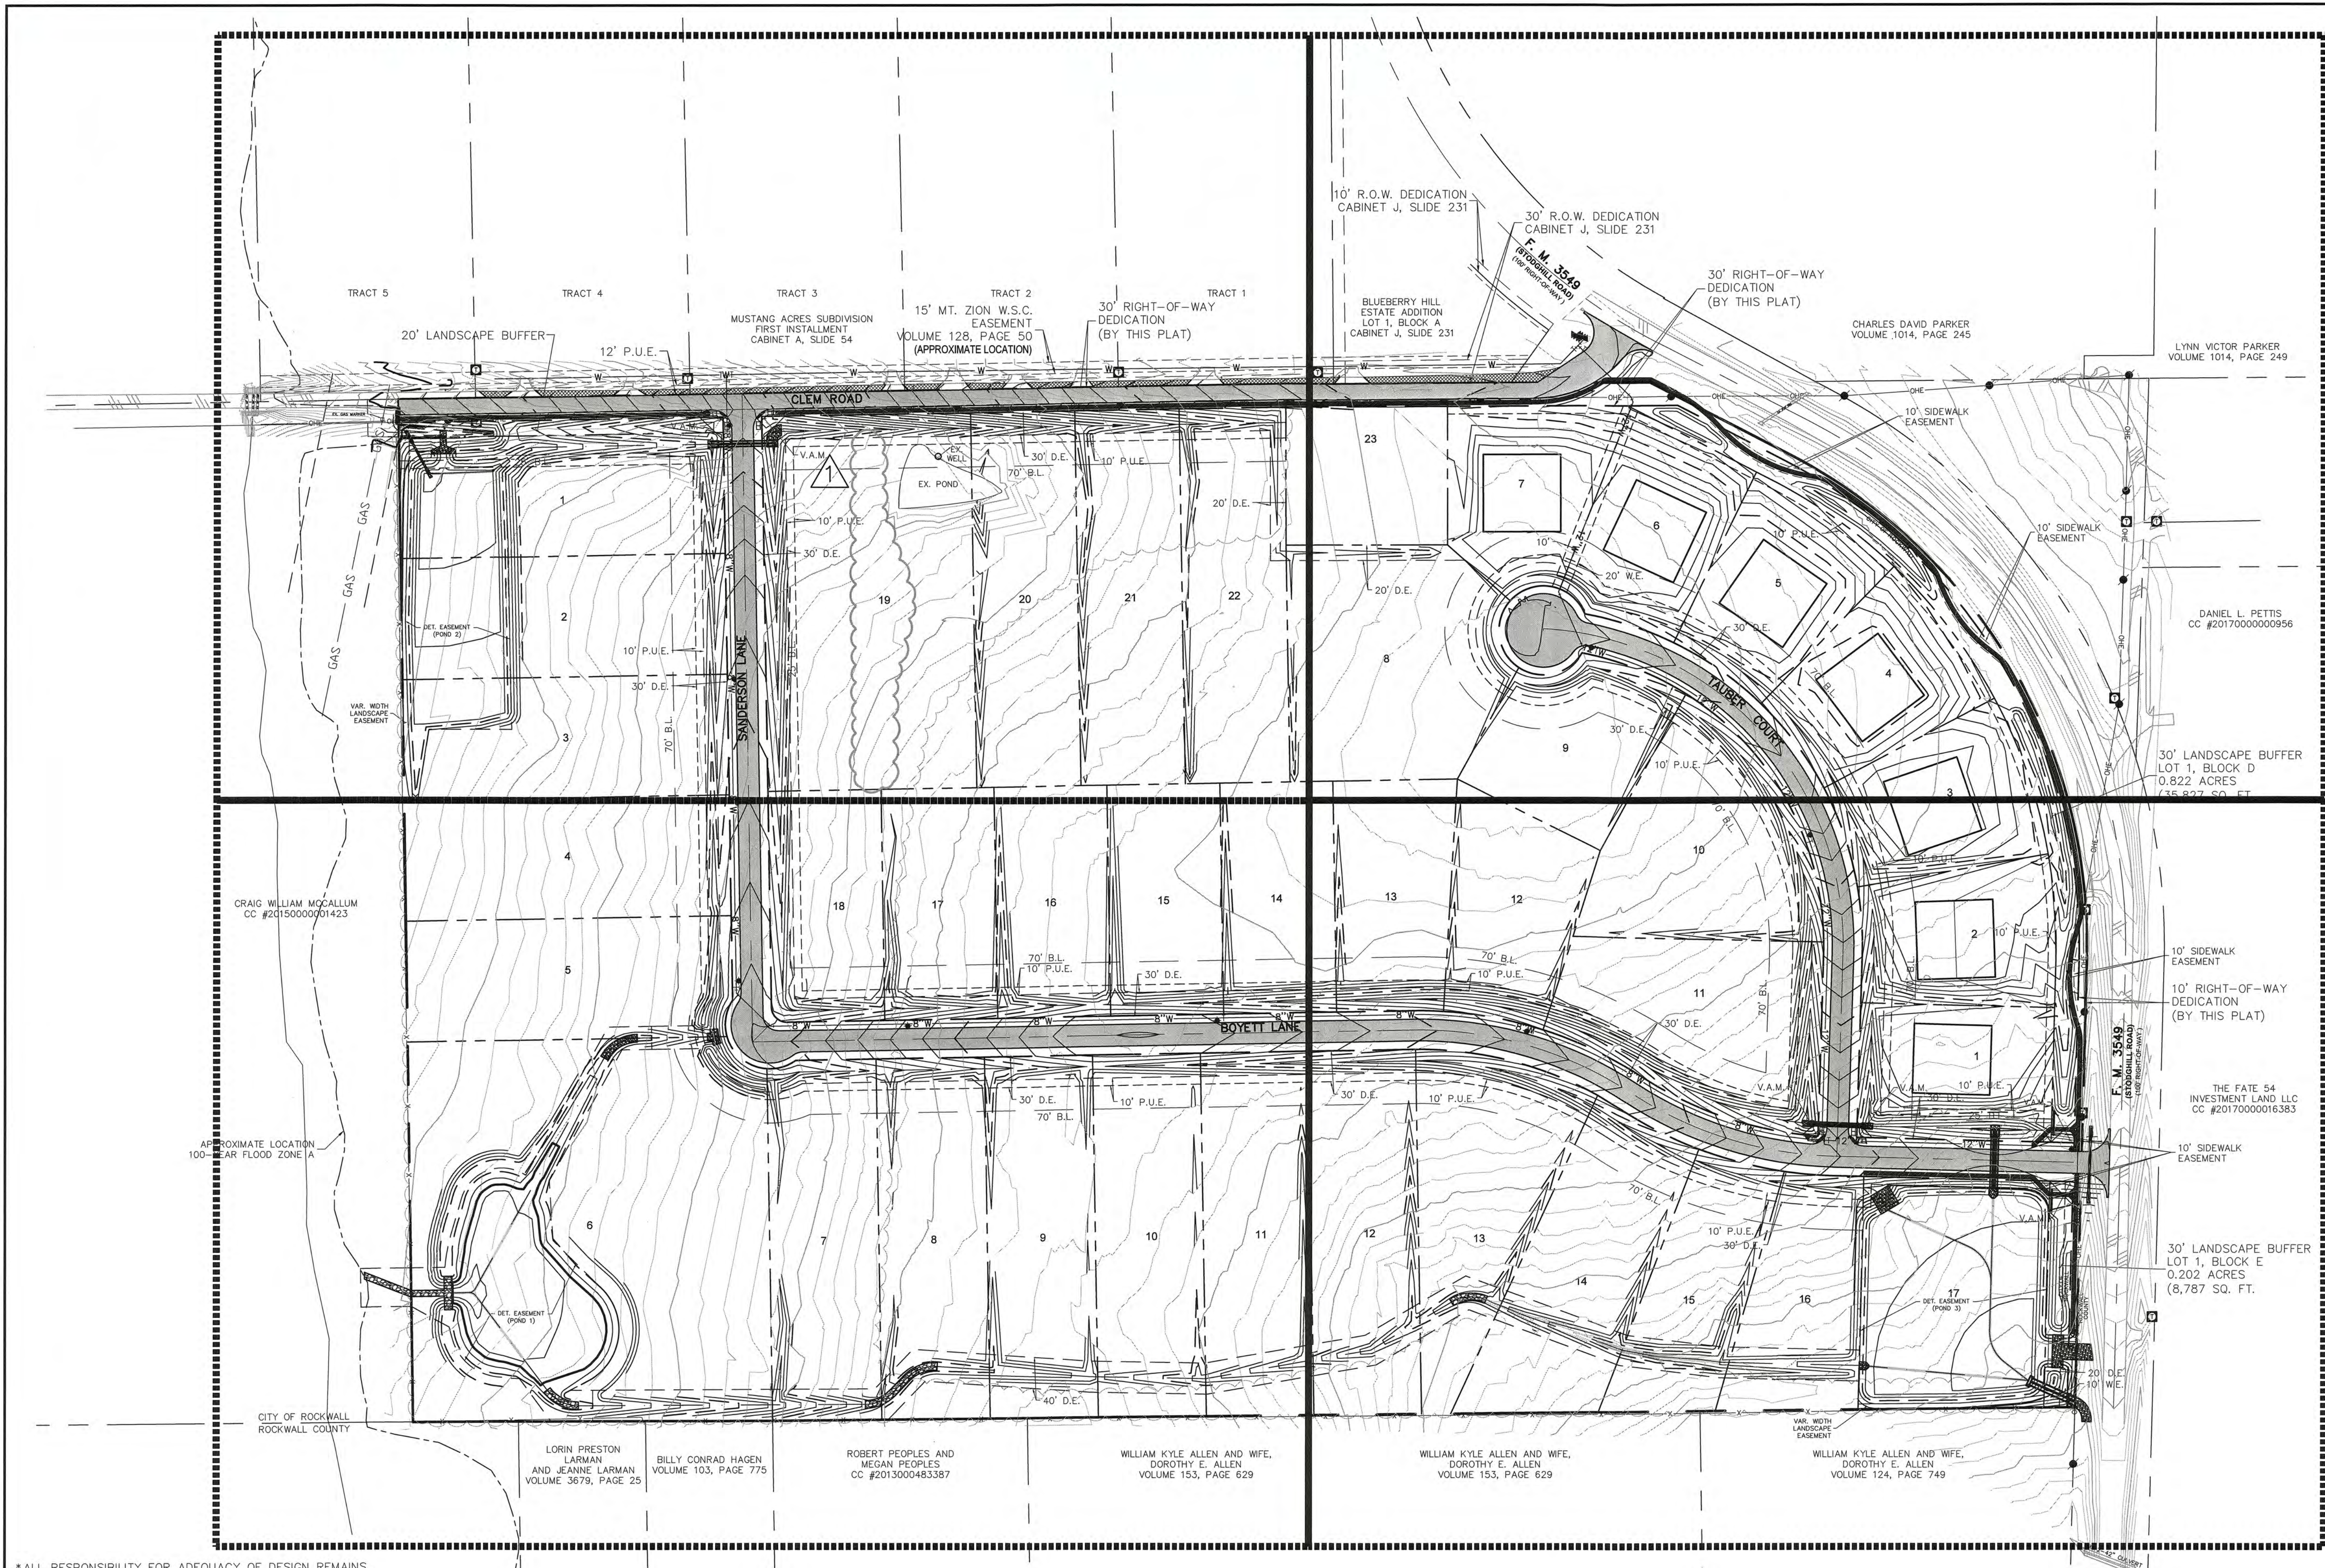

LEGEND	
	MATCHLINE
	PROPOSED MAJOR CONTOUR
	PROPOSED MINOR CONTOUR
	EXISTING MAJOR CONTOUR
	EXISTING MINOR CONTOUR
	RETAINING WALL

\* ALL RESPONSIBILITY FOR ADEQUACY OF DESIGN REMAINS WITH THE DESIGN ENGINEER. THE CITY OF ROCKWALL, IN REVIEWING AND RELEASING PLANS FOR CONSTRUCTION, ASSUMES NO RESPONSIBILITY FOR ADEQUACY OR ACCURACY OF DESIGN.

RECORD DRAWINGS  
To the best of our knowledge Engineering Concepts & Design, L.P., hereby states that this plan is As-Built. This information provided is based on surveying at the site and information provided by the contractor.  
*Ryan C. King*  
RYAN C. KING  
1/27/2021  
DATE

CAUTION! EXISTING UTILITIES  
CONTRACTOR SHOULD CALL 1-800-DIG-TESS PRIOR TO BEGINNING ANY CONSTRUCTION ACTIVITIES FOR EXISTING UTILITY LOCATIONS. EXISTING UTILITIES AND UNDERGROUND FACILITIES INDICATED ON THESE PLANS HAVE BEEN LOCATED FROM REFERENCE INFORMATION. IT IS THE RESPONSIBILITY OF THE CONTRACTOR TO VERIFY BOTH HORIZONTALLY AND VERTICALLY THE LOCATION OF ALL EXISTING UTILITIES AND UNDERGROUND FACILITIES PRIOR TO CONSTRUCTION AND TO TAKE NECESSARY PRECAUTIONS IN ORDER TO PROTECT ALL FACILITIES ENCOUNTERED. THE CONTRACTOR SHALL PRESERVE AND PROTECT ALL EXISTING UTILITIES FROM DAMAGE DURING CONSTRUCTION.

BM-1: "PK" Nail on the south side of Clem Road, approximately 2275' west of the centerline intersection of Clem Road and FM 3549  
Elev.: 559.07'  
  
BM-2: "PK" Nail in Clem Road, approximately 175' west of the centerline intersection of Clem Road and FM 3549  
Elev.: 584.83'

ENGINEERING / PROJECT MANAGEMENT /  
CONSTRUCTION SERVICES - FIRM REG. #F-001145  
201 WINDCO CIR, STE 200, WYLIE, TX 75098  
972-941-8400 FAX: 972-941-8401 WWW.ECDLP.COM

REVISIONS:	
1/25/2021 COMBINED LOTS A19 & A20	
DRAWN: MJH	DATE:
CHECKED: RCK	DATE: 6/1/2020
PROJECT NO.: 08838	
DWG FILE NAME: 08838 GR.DWG	


THIS DOCUMENT IS RELEASED FOR THE PURPOSE OF CONSTRUCTION.  
THE SEAL APPEARING ON THIS DOCUMENT WAS AUTHORIZED BY RYAN C. KING, P.E. 123635

1/25/2021


GRADING PLAN KEY MAP  
  
NORTHGATE  
CITY OF ROCKWALL, ROCKWALL COUNTY, TEXAS

SHEET  
13  
OF  
40

\*ALL RESPONSIBILITY FOR ADEQUACY OF DESIGN REMAINS WITH THE DESIGN ENGINEER. THE CITY OF ROCKWALL, IN REVIEWING AND RELEASING PLANS FOR CONSTRUCTION, ASSUMES NO RESPONSIBILITY FOR ADEQUACY OR ACCURACY OF DESIGN.

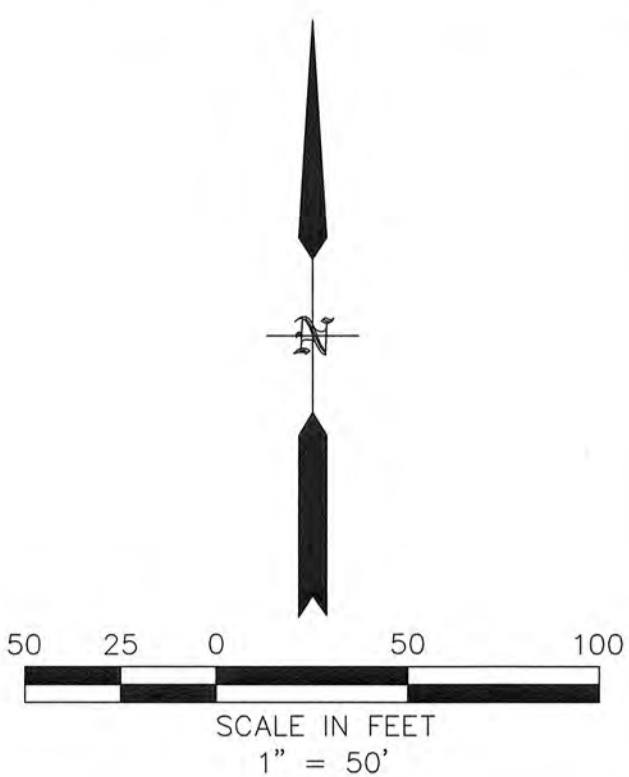

LEGEND	
	MATCHLINE
	PROPOSED MAJOR CONTOUR
	PROPOSED MINOR CONTOUR
	EXISTING MAJOR CONTOUR
	EXISTING MINOR CONTOUR
	PROPOSED RETAINING WALL
	PROPOSED ELEVATION
	PROPOSED TOP OF CURB

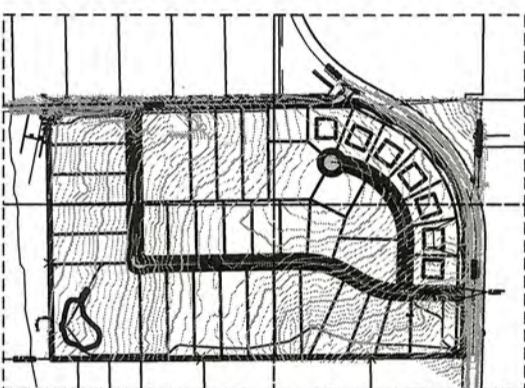

#### RECORD DRAWINGS


To the best of our knowledge Engineering Concepts & Design, L.P., hereby states that this plan is As-Built. This information provided is based on surveying at the site and information provided by the contractor.

*Ryan C. King*  
RYAN C. KING  
1/27/2021  
DATE

#### GRADING NOTES:

1. ALL WALLS SHALL BE ON ONE LOT INCLUDING FOOTINGS, TIE BACKS, OR STRUCTURAL FILL.
2. ALL COMPACTION TO BE 95% STANDARD DENSITY USING A SHEEP FOOT ROLLER.
3. ALL FINAL ELEVATIONS TO BE VERIFIED PRIOR TO CITY ACCEPTANCE.
4. MAX SLOPE IS 4:1.
5. MAX DRIVEWAY SLOPE IS 14%.
6. WALLS 3' AND OVER MUST BE DESIGNED BY A LICENSED ENGINEER AND APPROVED BEFORE CONSTRUCTION.
7. ALL RETAINING WALLS TO BE ROCK OR STONE FACED. NO SMOOTH CONCRETE.
8. A LOT SPECIFIC GRADING PLAN WILL BE REQUIRED WITH EACH BUILDING PERMIT TO ENSURE THAT DRAINAGE FLOW MATCHES ENGINEERING PLANS.

GRADING CONTRACTOR TO ENSURE THAT DRAINAGE IS MAINTAINED ACROSS ENTIRE SITE. NO PONDING SHALL OCCUR.

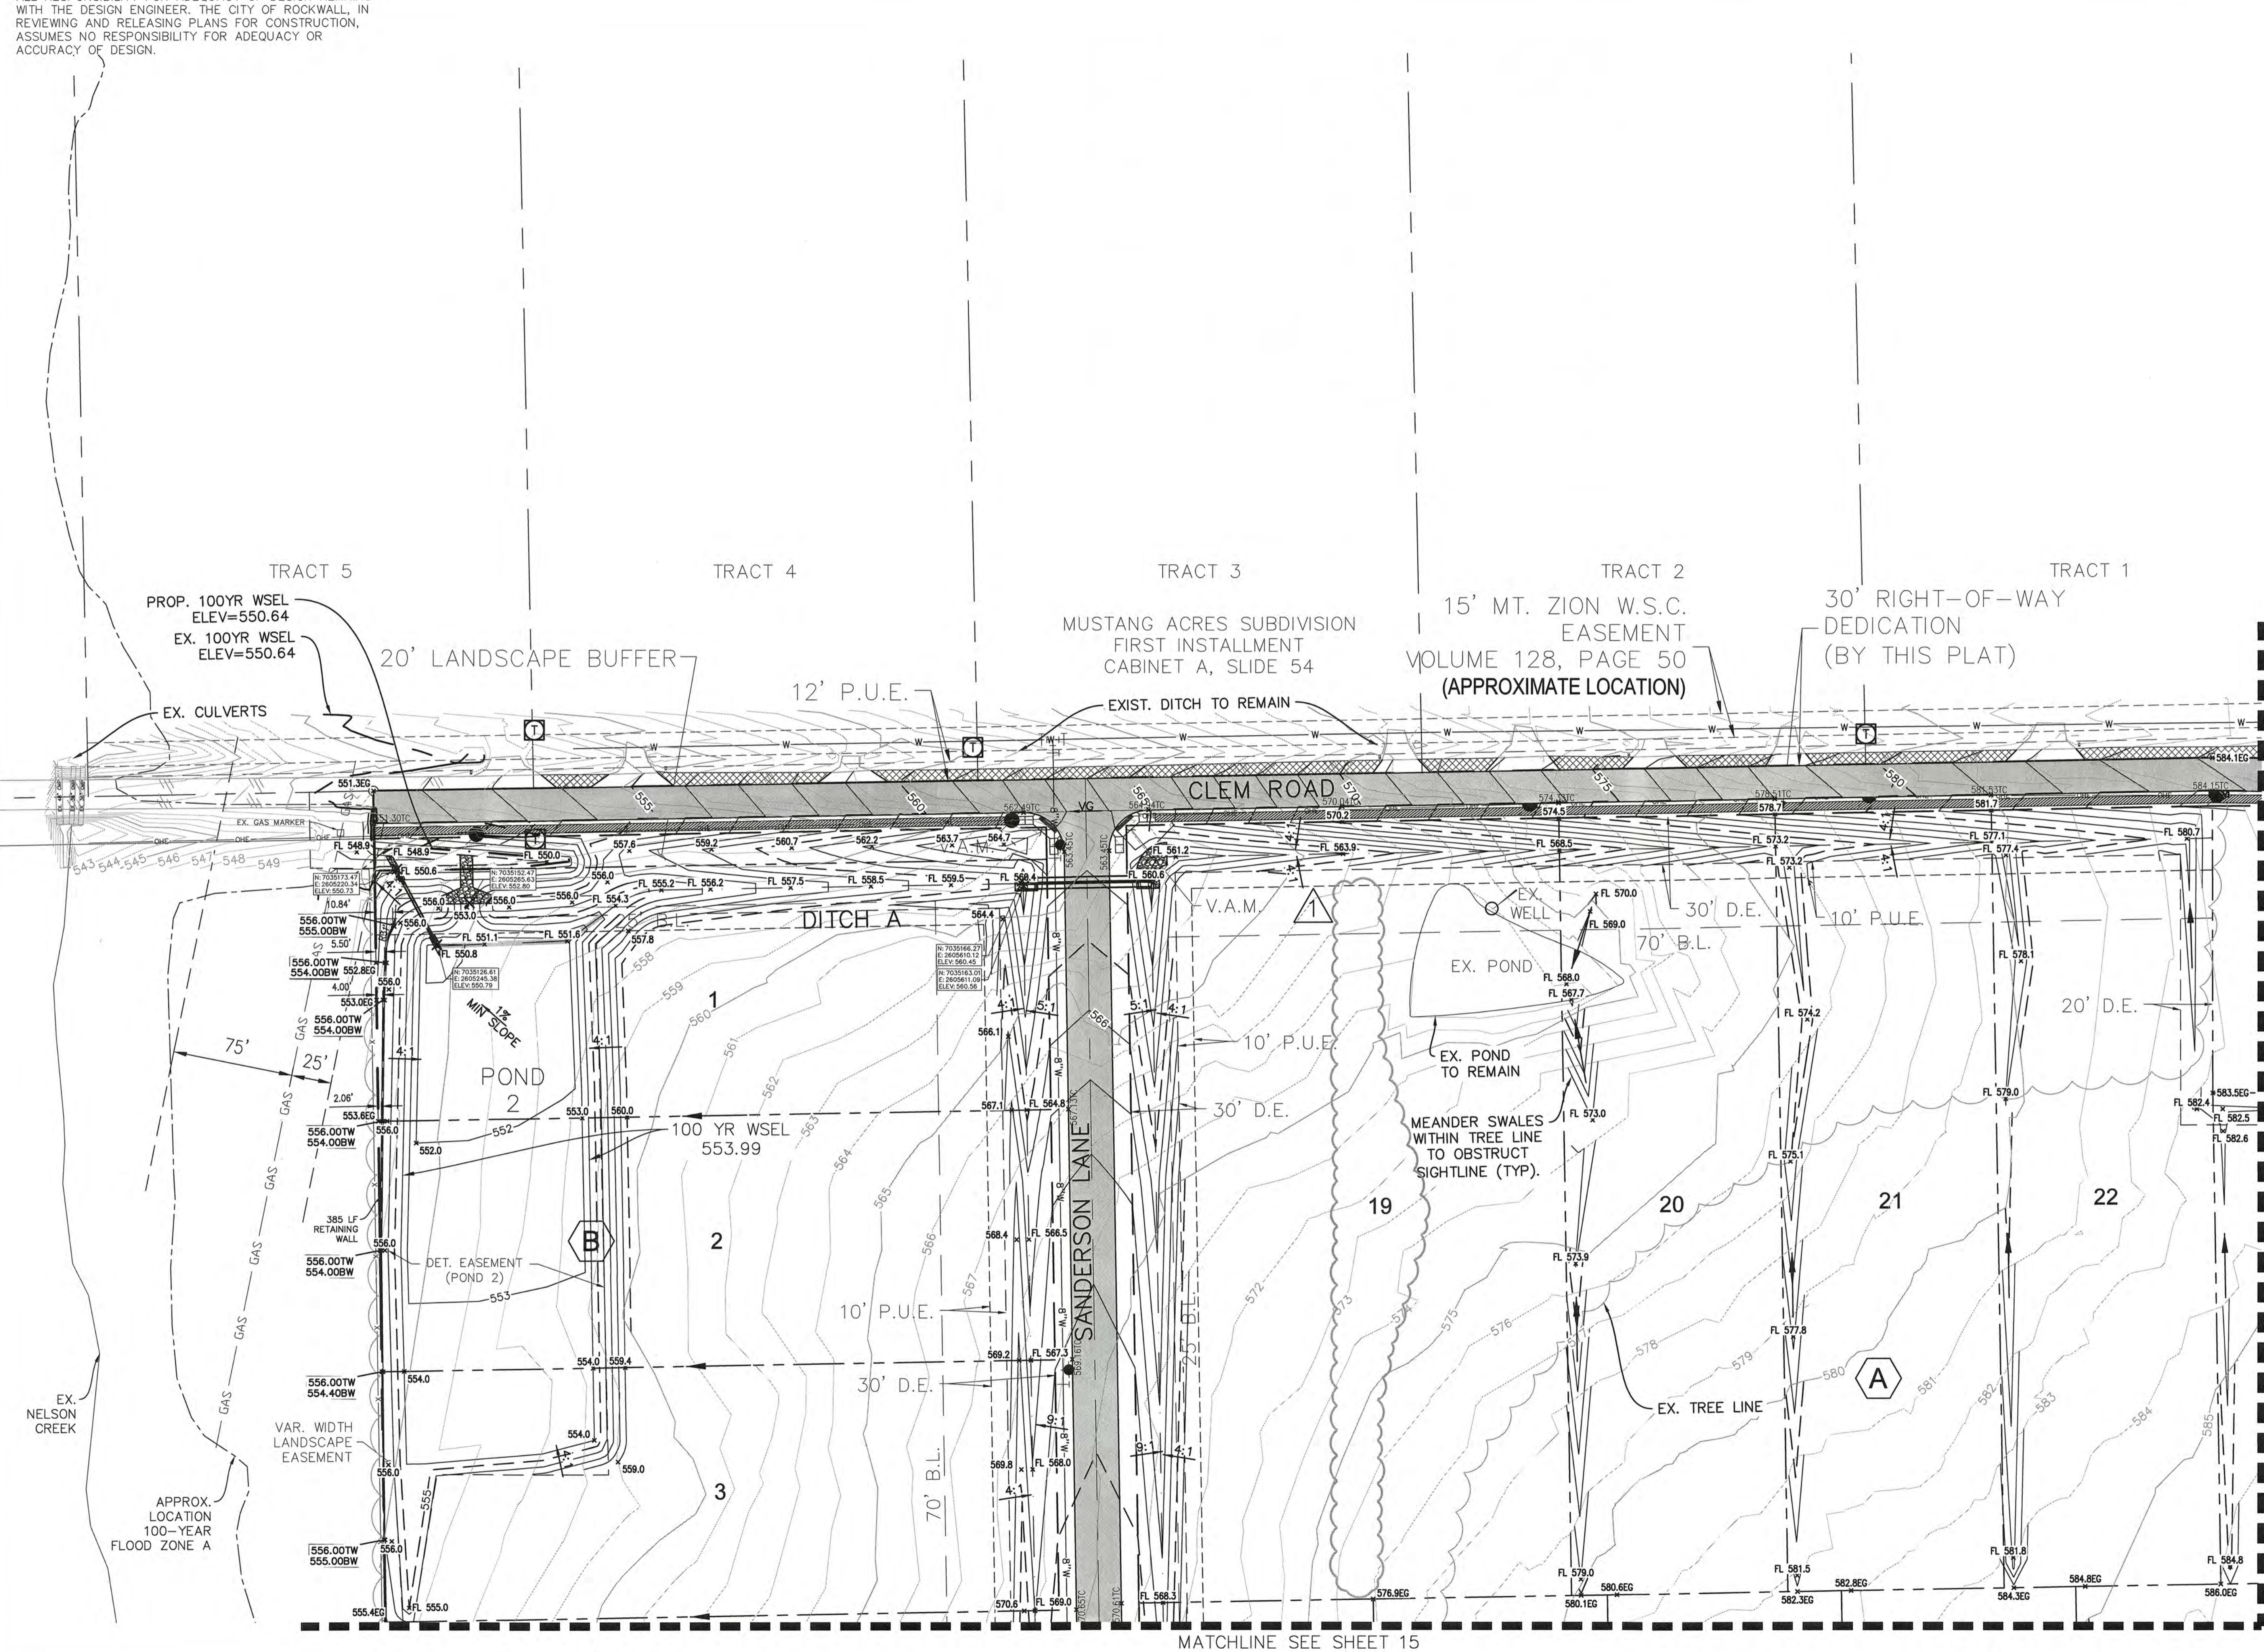

MATCHLINE SEE SHEET 17

MATCHLINE SEE SHEET 15

**CAUTION! EXISTING UTILITIES**  
CONTRACTOR SHOULD CALL 1-800-DIG-TESS PRIOR TO BEGINNING ANY CONSTRUCTION ACTIVITIES FOR EXISTING UTILITY LOCATIONS. EXISTING UTILITIES AND UNDERGROUND FACILITIES INDICATED ON THESE PLANS HAVE BEEN LOCATED FROM RESISTANCE INFORMATION. IT IS THE RESPONSIBILITY OF THE CONTRACTOR TO VERIFY BOTH HORIZONTALLY AND VERTICALLY THE LOCATION OF ALL EXISTING UTILITIES AND UNDERGROUND FACILITIES PRIOR TO CONSTRUCTION AND TO TAKE NECESSARY PRECAUTIONS IN ORDER TO PROTECT ALL FACILITIES ENCOUNTERED. THE CONTRACTOR SHALL PRESERVE AND PROTECT ALL EXISTING UTILITIES FROM DAMAGE DURING CONSTRUCTION.

BM-1: "PK" Nail on the south side of Clem Road, approximately 2275' west of the centerline intersection of Clem Road and FM 3549  
Elev.: 559.07'

BM-2: "PK" Nail in Clem Road, approximately 175' west of the centerline intersection of Clem Road and FM 3549  
Elev.: 584.83'

**ENGINEERINGCONCEPTS**  
& DESIGN, L.P.

ENGINEERING / PROJECT MANAGEMENT /  
CONSTRUCTION SERVICES - FIRM REG. #F-001145  
201 WINDCO CIR, STE 200, WYLIE, TX 75098  
972-941-8400 FAX: 972-941-8401 WWW.ECDLP.COM

REVISIONS:	
1/25/2021 COMBINED LOTS A19 & A20	
DRAWN: MJH	DATE:
CHECKED: RCK	DATE: 6/1/2020
PROJECT NO.: 08838	
DWG FILE NAME: 08838 GR.DWG	

THIS DOCUMENT IS RELEASED FOR THE PURPOSE OF CONSTRUCTION. THE SEAL APPEARING ON THIS DOCUMENT WAS AUTHORIZED BY RYAN C. KING, P.E. 123635



**GRADING PLAN 1**  
**NORTHGATE**  
CITY OF ROCKWALL, ROCKWALL COUNTY, TEXAS

SHEET  
**14**  
OF  
**40**

\*ALL RESPONSIBILITY FOR ADEQUACY OF DESIGN REMAINS WITH THE DESIGN ENGINEER. THE CITY OF ROCKWALL, IN REVIEWING AND RELEASING PLANS FOR CONSTRUCTION, ASSUMES NO RESPONSIBILITY FOR ADEQUACY OR ACCURACY OF DESIGN.

CRAIG WILLIAM MCCALLUM  
CC #2015000001423

APPROXIMATE LOCATION  
100-YEAR FLOOD ZONE A

CITY OF ROCKWALL  
ROCKWALL COUNTY

LORIN PRESTON  
LARMAN  
AND JEANNE LARMAN  
VOLUME 3679, PAGE 25


BILLY CONRAD HAGEN  
VOLUME 103, PAGE 775

ROBERT PEOPLES AND  
MEGAN PEOPLES  
CC #2013000483387


WILLIAM KYLE ALLEN AND WIFE,  
DOROTHY E. ALLEN  
VOLUME 153, PAGE 629

MATCHLINE SEE SHEET 14

MATCHLINE SEE SHEET 16

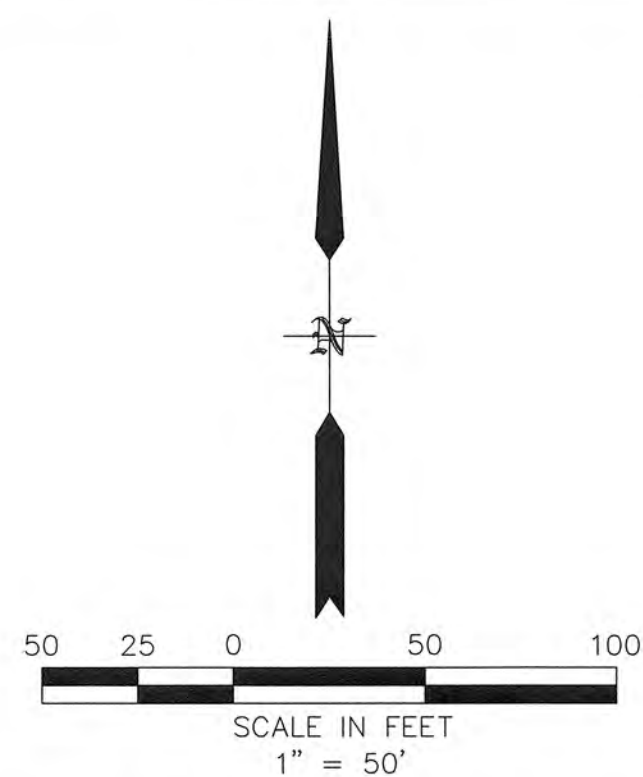

LEGEND	
	MATCHLINE
	PROPOSED MAJOR CONTOUR
	PROPOSED MINOR CONTOUR
	EXISTING MAJOR CONTOUR
	EXISTING MINOR CONTOUR
	PROPOSED RETAINING WALL
	PROPOSED ELEVATION
	PROPOSED TOP OF CURB

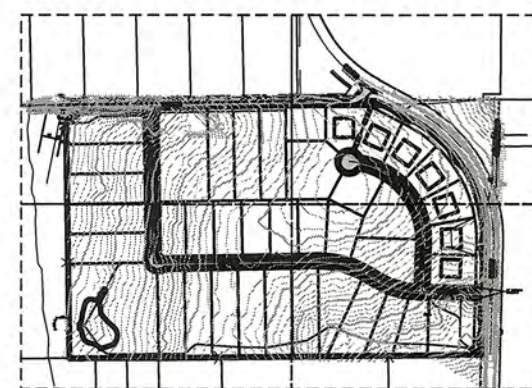

- GRADING NOTES:
1. ALL WALLS SHALL BE ON ONE LOT INCLUDING FOOTINGS, TIE BACKS, OR STRUCTURAL FILL.
  2. ALL COMPACTION TO BE 95% STANDARD DENSITY USING A SHEEP FOOT ROLLER.
  3. ALL FINAL ELEVATIONS TO BE VERIFIED PRIOR TO CITY ACCEPTANCE.
  4. MAX SLOPE IS 4:1.
  5. MAX DRIVEWAY SLOPE IS 14%.
  6. WALLS 3' AND OVER MUST BE DESIGNED BY A LICENSED ENGINEER AND APPROVED BEFORE CONSTRUCTION.
  7. ALL RETAINING WALLS TO BE ROCK OR STONE FACED. NO SMOOTH CONCRETE.
  8. A LOT SPECIFIC GRADING PLAN WILL BE REQUIRED WITH EACH BUILDING PERMIT TO ENSURE THAT DRAINAGE FLOW MATCHES ENGINEERING PLANS.

GRADING CONTRACTOR TO ENSURE THAT DRAINAGE IS MAINTAINED ACROSS ENTIRE SITE. NO PONDING SHALL OCCUR.

#### RECORD DRAWINGS

To the best of our knowledge Engineering Concepts & Design, L.P., hereby states that this plan is As-Built. This information provided is based on surveying at the site and information provided by the contractor.

*Ryan C. King*  
RYAN C. KING

1/27/2021  
DATE

#### REVISIONS:

DRAWN: MJH	DATE: 6/1/2020
CHECKED: RCK	DATE: 6/1/2020
PROJECT NO.: 08838	
DWG FILE NAME: 08838 GR.DWG	

THIS DOCUMENT IS RELEASED FOR THE PURPOSE OF CONSTRUCTION. THE SEAL APPEARING ON THIS DOCUMENT WAS AUTHORIZED BY RYAN C. KING, P.E. 123635



## GRADING PLAN 2

## NORTHGATE

CITY OF ROCKWALL, ROCKWALL COUNTY, TEXAS

SHEET  
15  
OF  
40

#### CAUTION! EXISTING UTILITIES

CONTRACTOR SHOULD CALL 1-800-DIG-BEFORE PRIOR TO BEGINNING ANY CONSTRUCTION ACTIVITIES FOR EXISTING UTILITY LOCATIONS. EXISTING UTILITIES AND UNDERGROUND FACILITIES INDICATED ON THESE PLANS HAVE BEEN LOCATED FROM REFERENCE INFORMATION. IT IS THE RESPONSIBILITY OF THE CONTRACTOR TO VERIFY BOTH HORIZONTALLY AND VERTICALLY THE LOCATION OF ALL EXISTING UTILITIES AND UNDERGROUND FACILITIES PRIOR TO CONSTRUCTION AND TO TAKE NECESSARY PRECAUTIONS IN ORDER TO PROTECT ALL FACILITIES ENCOUNTERED. THE CONTRACTOR SHALL PRESERVE AND PROTECT ALL EXISTING UTILITIES FROM DAMAGE DURING CONSTRUCTION.

BM-1: "PK" Nail on the south side of Clem Road, approximately 2275' west of the centerline intersection of Clem Road and FM 3549 Elev.: 559.07'

BM-2: "PK" Nail in Clem Road, approximately 175' west of the centerline intersection of Clem Road and FM 3549 Elev.: 584.83'




ENGINEERINGCONCEPTS  
& DESIGN, L.P.

ENGINEERING / PROJECT MANAGEMENT /  
CONSTRUCTION SERVICES - FIRM REG. #F-001145  
201 WINDCO CIR, STE 200, WYLIE, TX 75098  
972-941-8400 FAX: 972-941-8401 WWW.ECDLP.COM


\*ALL RESPONSIBILITY FOR ADEQUACY OF DESIGN REMAINS WITH THE DESIGN ENGINEER. THE CITY OF ROCKWALL, IN REVIEWING AND RELEASING PLANS FOR CONSTRUCTION, ASSUMES NO RESPONSIBILITY FOR ADEQUACY OR ACCURACY OF DESIGN.

MATCHLINE SEE SHEET 17

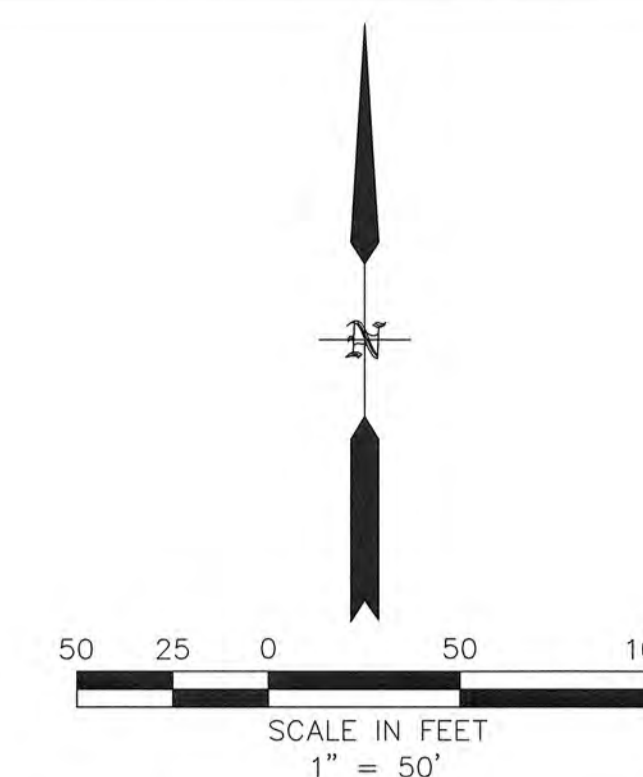

LEGEND

	MATCHLINE
~545~	PROPOSED MAJOR CONTOUR
~~~~~	PROPOSED MINOR CONTOUR
~560~	EXISTING MAJOR CONTOUR
~~~~~	EXISTING MINOR CONTOUR
-----	PROPOSED RETAINING WALL
558.1	PROPOSED ELEVATION
543.45TC	PROPOSED TOP OF CURB

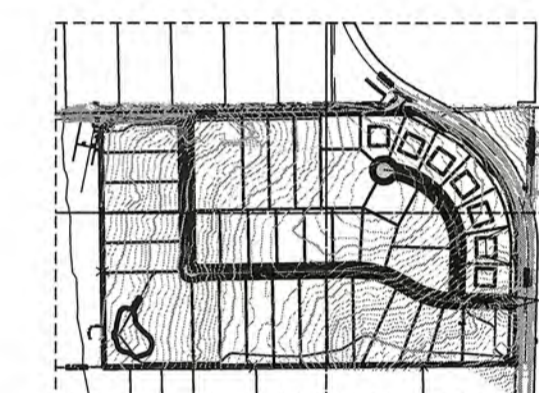

THE FATE 54  
INVESTMENT LAND LLC  
CC #20170000016383

10' SIDEWALK  
EASEMENT

30' LANDSCAPE BUFFER  
LOT 1, BLOCK E  
0.202 ACRES  
(8,787 SQ. FT.)

CONSTRUCT  
SIDEWALK. S  
LANDSCAPE  
PLANS AND  
DETAILS.

GRADING NOTES:

1. ALL WALLS SHALL BE ON ONE LOT INCLUDING FOOTINGS, TIE BACKS, OR STRUCTURAL FILL.
2. ALL COMPACTION TO BE 95% STANDARD DENSITY USING A SHEEP FOOT ROLLER.
3. ALL FINAL ELEVATIONS TO BE VERIFIED PRIOR TO CITY ACCEPTANCE.
4. MAX SLOPE IS 4:1.
5. MAX DRIVEWAY SLOPE IS 14%.
6. WALLS 3' AND OVER MUST BE DESIGNED BY A LICENSED ENGINEER AND APPROVED BEFORE CONSTRUCTION.
7. ALL RETAINING WALLS TO BE ROCK OR STONE FACED. NO SMOOTH CONCRETE.
8. A LOT SPECIFIC GRADING PLAN WILL BE REQUIRED WITH EACH BUILDING PERMIT TO ENSURE THAT DRAINAGE FLOW MATCHES ENGINEERING PLANS.

GRADING CONTRACTOR TO  
ENSURE THAT DRAINAGE IS  
MAINTAINED ACROSS ENTIRE SITE.  
NO PONDING SHALL OCCUR.

RECORD DRAWINGS

To the best of our knowledge Engineering Concepts & Design, L.P., hereby states that this plan is As-Built. This information provided is based on surveying at the site and information provided by the contractor

RYAN C KING 1/27/20

THIS DOCUMENT IS RELEASED FOR  
THE PURPOSE OF CONSTRUCTION.  
THE SEAL APPEARING ON THIS DOCUMENT WAS  
AUTHORIZED BY RYAN C. KING, P.E. 123635



GRADING PLAN 3

NORTHGATE

CITY OF ROCKWALL, ROCKWALL COUNTY, TEXAS

SHEET  
16  
OF  
40



**ENGINEERINGCONCEPTS**  
& DESIGN, L.P.

ENGINEERING / PROJECT MANAGEMENT /  
CONSTRUCTION SERVICES - FIRM REG. #F-001145  
201 WINDCO CIR, STE 200, WYLIE, TX 75098  
972-941-8400 FAX: 972-941-8401 WWW.ECDLP.COM

REVISONS:	
DRAWN: MJH	DATE:
CHECKED: RCK	DATE: 6/1/2020
PROJECT NO.: 08838	
DWG FILE NAME: 08R3R GR DWG	


BM-1: "PK" Nail on the south side of Clem Road,  
approximately 2275' west of the centerline intersection  
of Clem Road and FM 3549  
Elev.: 559.07'

BM-2: "PK" Nail in Clem Road,  
approximately 175' west of the centerline intersection  
of Clem Road and FM 3549  
Elev.: 584.83'

CAUTION! EXISTING UTILITIES



CONTRACTOR SHOULD CALL 1-800-DIG-TESS PRIOR TO BEGINNING ANY CONSTRUCTION ACTIVITIES FOR EXISTING UTILITY LOCATIONS. EXISTING UTILITIES AND UNDERGROUND FACILITIES INDICATED ON THESE PLANS HAVE BEEN LOCATED FROM REFERENCE INFORMATION. IT IS THE RESPONSIBILITY OF THE CONTRACTOR TO VERIFY BOTH HORIZONTALLY AND VERTICALLY THE LOCATION OF ALL EXISTING UTILITIES AND UNDERGROUND FACILITIES PRIOR TO CONSTRUCTION AND TO TAKE NECESSARY PRECAUTIONS IN ORDER TO PROTECT ALL FACILITIES ENCOUNTERED. THE CONTRACTOR SHALL PROTECT ALL EXISTING UTILITIES FROM DAMAGE DURING CONSTRUCTION.

\*ALL RESPONSIBILITY FOR ADEQUACY OF DESIGN REMAINS WITH THE DESIGN ENGINEER. THE CITY OF ROCKWALL, IN REVIEWING AND RELEASING PLANS FOR CONSTRUCTION, ASSUMES NO RESPONSIBILITY FOR ADEQUACY OR ACCURACY OF DESIGN.

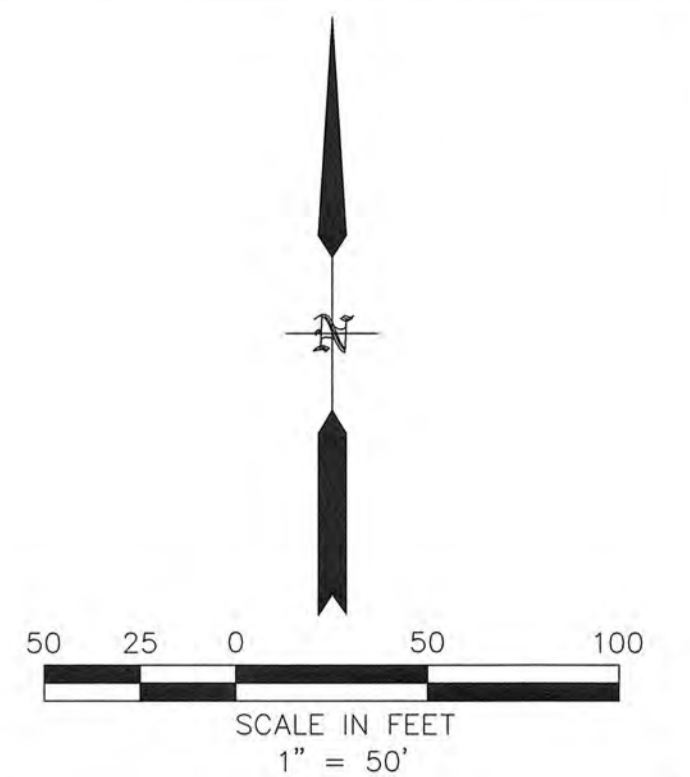

### LEGEND

- | MATCHLINE          |                         |
|--------------------|-------------------------|
| ~545~              | PROPOSED MAJOR CONTOUR  |
| ~                  | PROPOSED MINOR CONTOUR  |
| ~560~              | EXISTING MAJOR CONTOUR  |
| ~                  | EXISTING MINOR CONTOUR  |
| ---                | PROPOSED RETAINING WALL |
| 558.1 <sub>x</sub> | PROPOSED ELEVATION      |
| 543.45TC           | PROPOSED TOP OF CURB    |

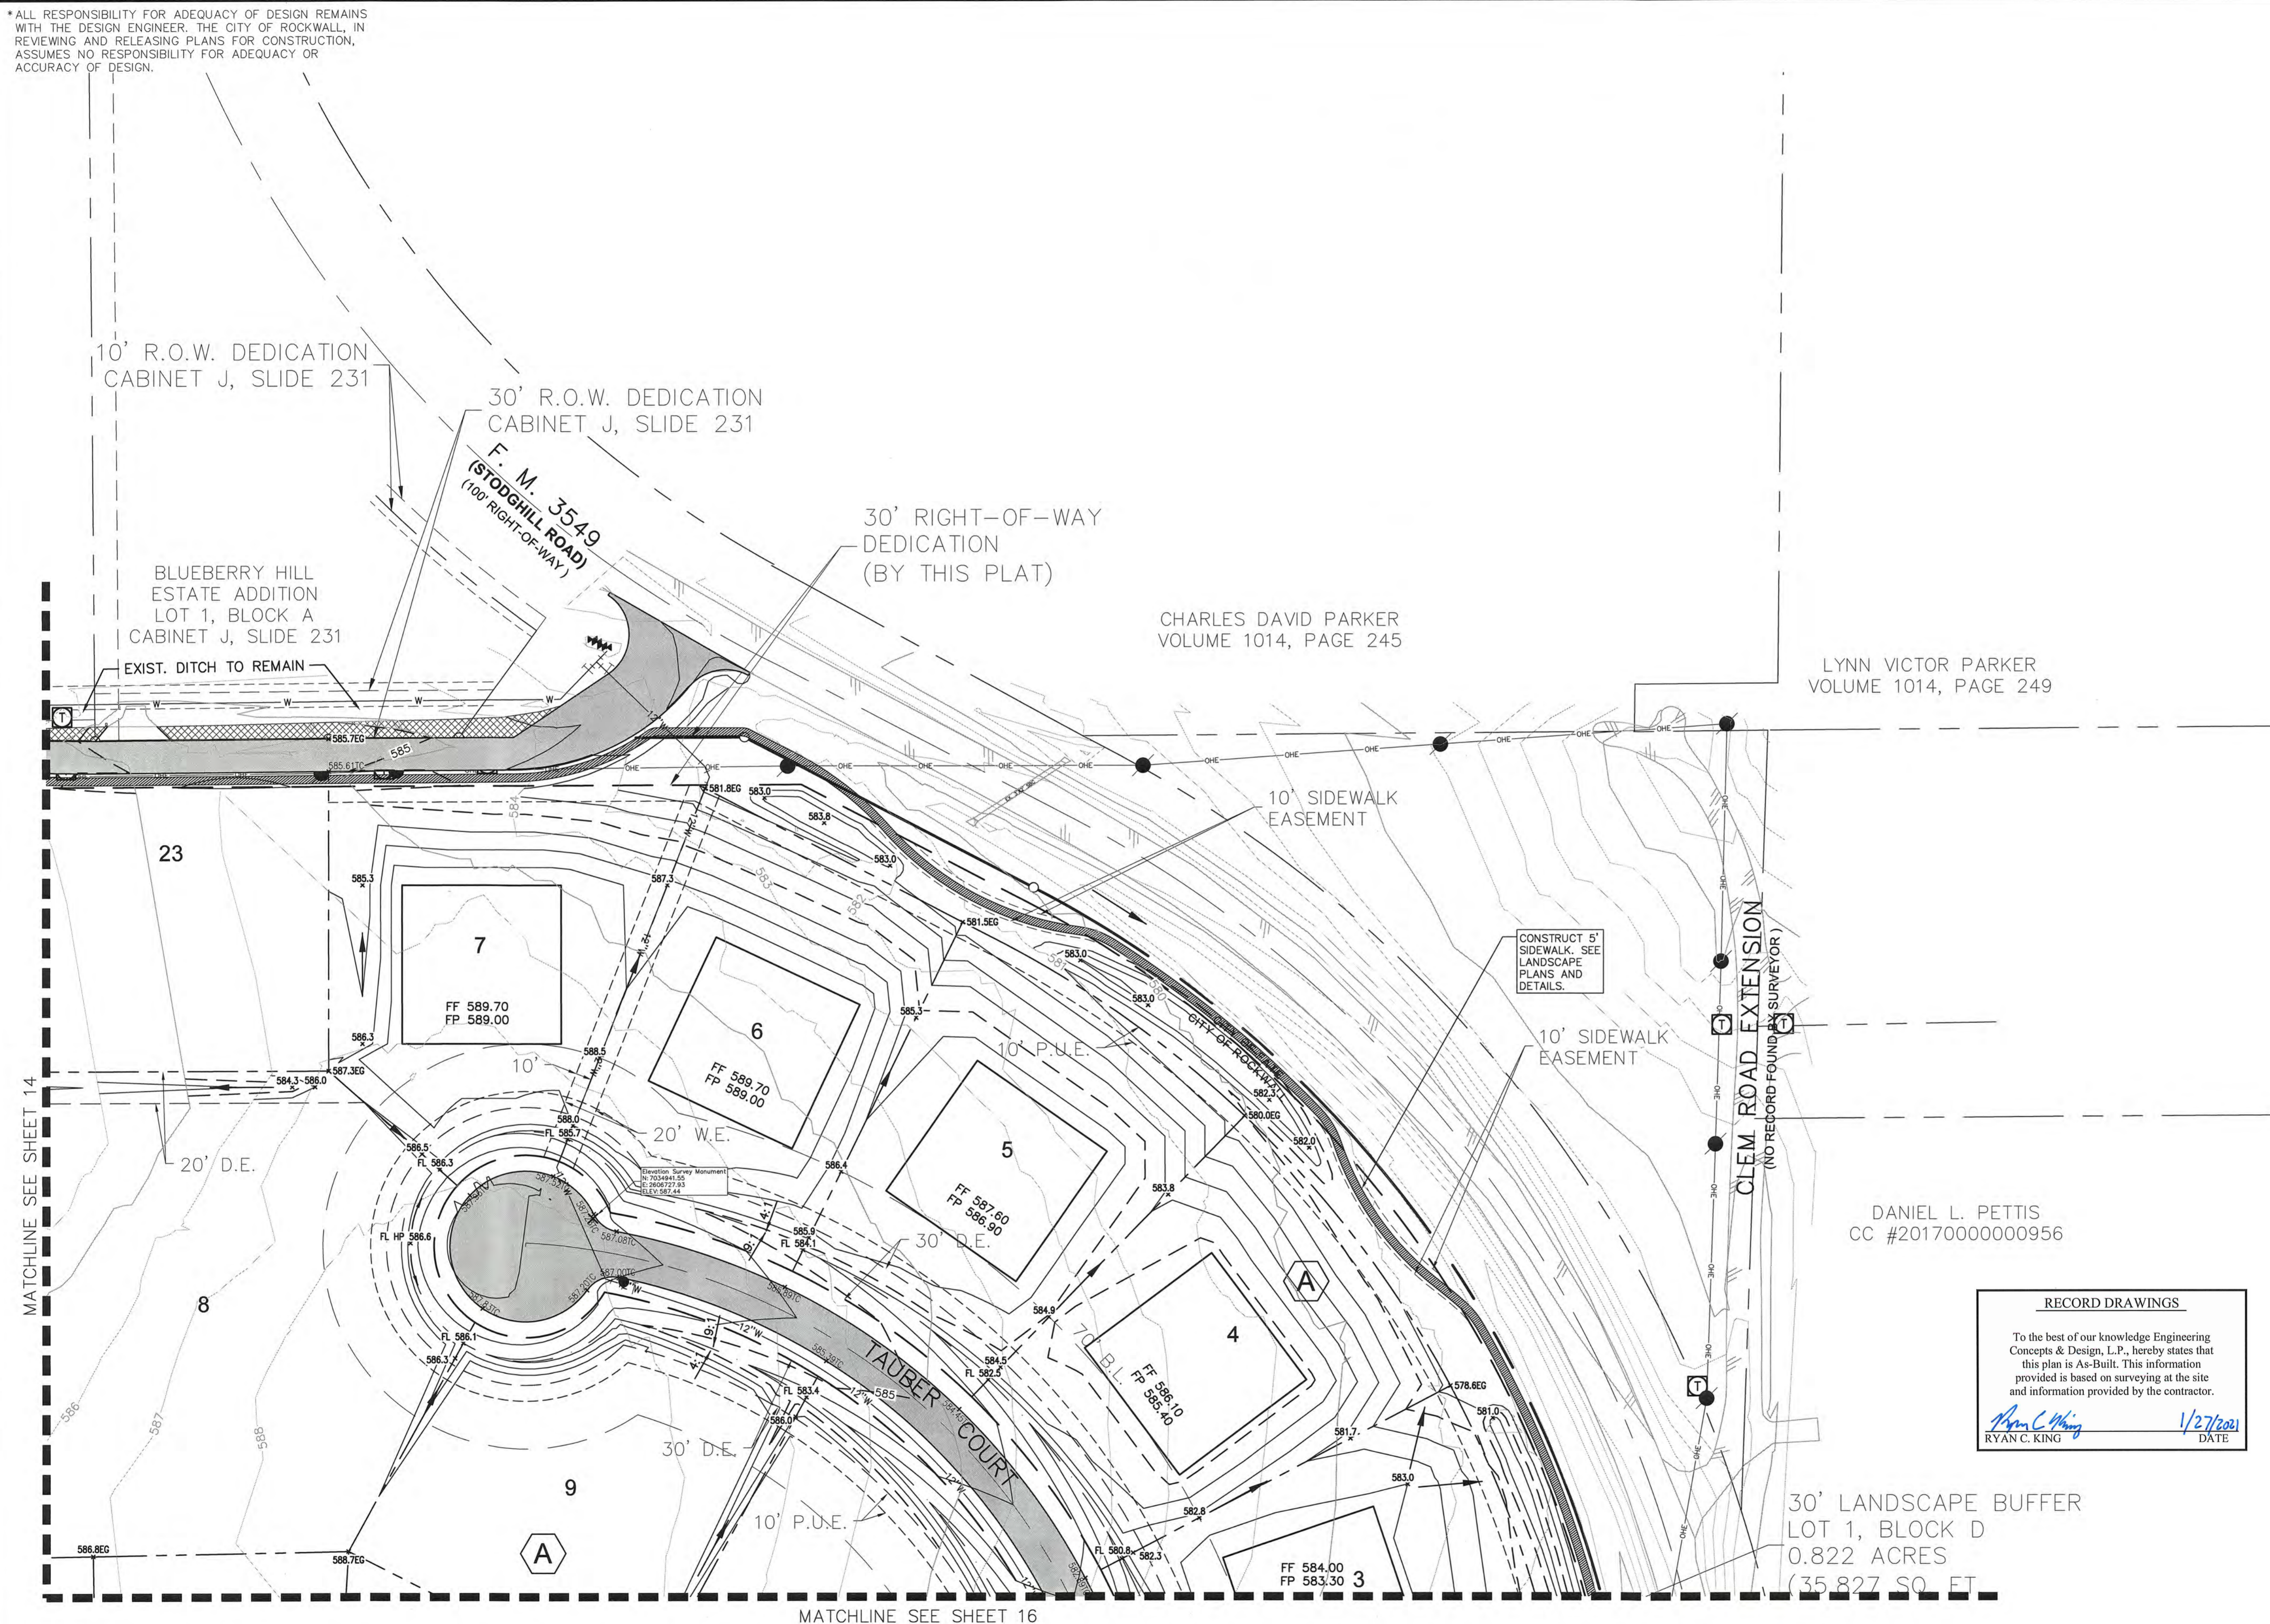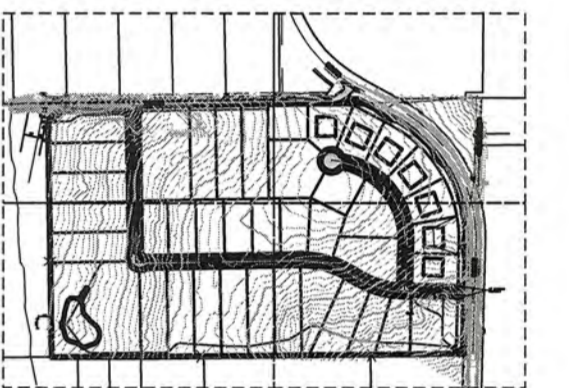

GRADING NOTES:

1. ALL WALLS SHALL BE ON ONE LOT INCLUDING FOOTINGS, TIE BACKS, OR STRUCTURAL FILL.
2. ALL COMPACTION TO BE 95% STANDARD DENSITY USING A SHEEP FOOT ROLLER.
3. ALL FINAL ELEVATIONS TO BE VERIFIED PRIOR TO CITY ACCEPTANCE.
4. MAX SLOPE IS 4:1.
5. MAX DRIVEWAY SLOPE IS 14%.
6. WALLS 3' AND OVER MUST BE DESIGNED BY A LICENSED ENGINEER AND APPROVED BEFORE CONSTRUCTION.
7. ALL RETAINING WALLS TO BE ROCK OR STONE FACED. NO SMOOTH CONCRETE.
8. A LOT SPECIFIC GRADING PLAN WILL BE REQUIRED WITH EACH BUILDING PERMIT TO ENSURE THAT DRAINAGE FLOW MATCHES ENGINEERING PLANS.

## RECORD DRAWINGS

To the best of our knowledge Engineering Concepts & Design, L.P., hereby states that this plan is As-Built. This information provided is based on surveying at the site and information provided by the contractor.

Ryan C. King  
RYAN C. KING

1/27/2021  
DATE

30' LANDSCAPE BUFFER  
LOT 1, BLOCK D  
0.822 ACRES  
(35.827 SQ. FT.)

GRADING CONTRACTOR TO  
ENSURE THAT DRAINAGE IS  
MAINTAINED ACROSS ENTIRE SITE.  
NO PONDING SHALL OCCUR.

CAUTION! EXISTING UTILITIES

CONTRACTOR SHOULD CALL 1-800-DIG-TESS PRIOR TO BEGINNING ANY CONSTRUCTION ACTIVITIES FOR EXISTING UTILITY LOCATIONS. EXISTING UTILITIES AND UNDERGROUND FACILITIES INDICATED ON THESE PLANS HAVE BEEN LOCATED FROM REFERENCE INFORMATION. IT IS THE RESPONSIBILITY OF THE CONTRACTOR TO VERIFY BOTH HORIZONTALLY AND VERTICALLY THE LOCATION OF ALL EXISTING UTILITIES AND UNDERGROUND FACILITIES PRIOR TO ANY CUTTING AND TAMPING NECESSARY PRECAUTIONS IN ORDER TO PROTECT ALL FACILITIES ENCOUNTERED. THE CONTRACTOR SHALL PRESERVE AND PROTECT ALL EXISTING UTILITIES FROM DAMAGE DURING CONSTRUCTION.

BM-1: "PK" Nail on the south side of Clem Road,  
approximately 2275' west of the centerline intersection  
of Clem Road and FM 3549  
Elev.: 559.07'

BM-2: "PK" Nail in Clem Road,  
approximately 175' west of the centerline intersection  
of Clem Road and FM 3549  
Elev.: 584.83'



**ENGINEERINGCONCEPTS**  
& DESIGN, L.P.

ENGINEERING / PROJECT MANAGEMENT /  
CONSTRUCTION SERVICES - FIRM REG. #F-001145  
201 WINDCO CIR, STE 200, WYLIE, TX 75098  
972-941-8400 FAX: 972-941-8401 WWW.ECDLP.COM

REVISIONS:

DRAWN:

**CHECKED:**

PROJECT NO.

PROJECT NO.

DATE:

DATE:

--	--

---

THIS DOCUMENT IS RELEASED FOR  
THE PURPOSE OF CONSTRUCTION.  
THE SEAL APPEARING ON THIS DOCUMENT WAS  
AUTHORIZED BY RYAN C. KING, P.E. 123635



## GRADING PLAN 4

NORTHGATE



CITY OF ROCKWALL, ROCKWALL COUNTY, TEXAS

SHEET |

7

OF

40 |

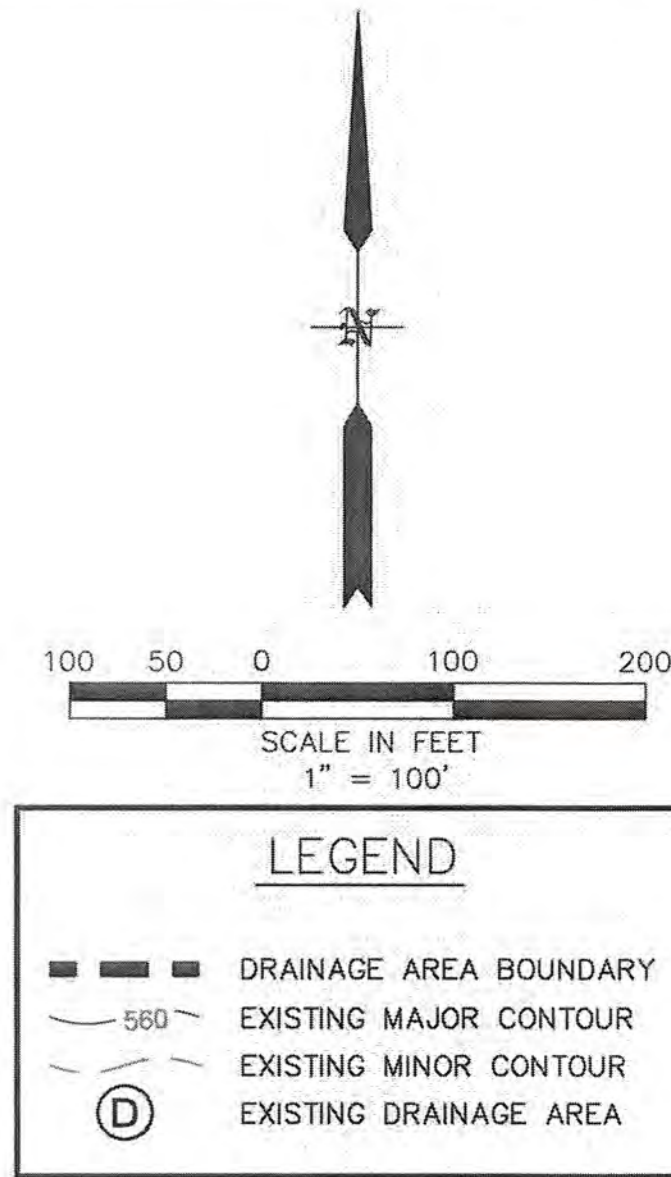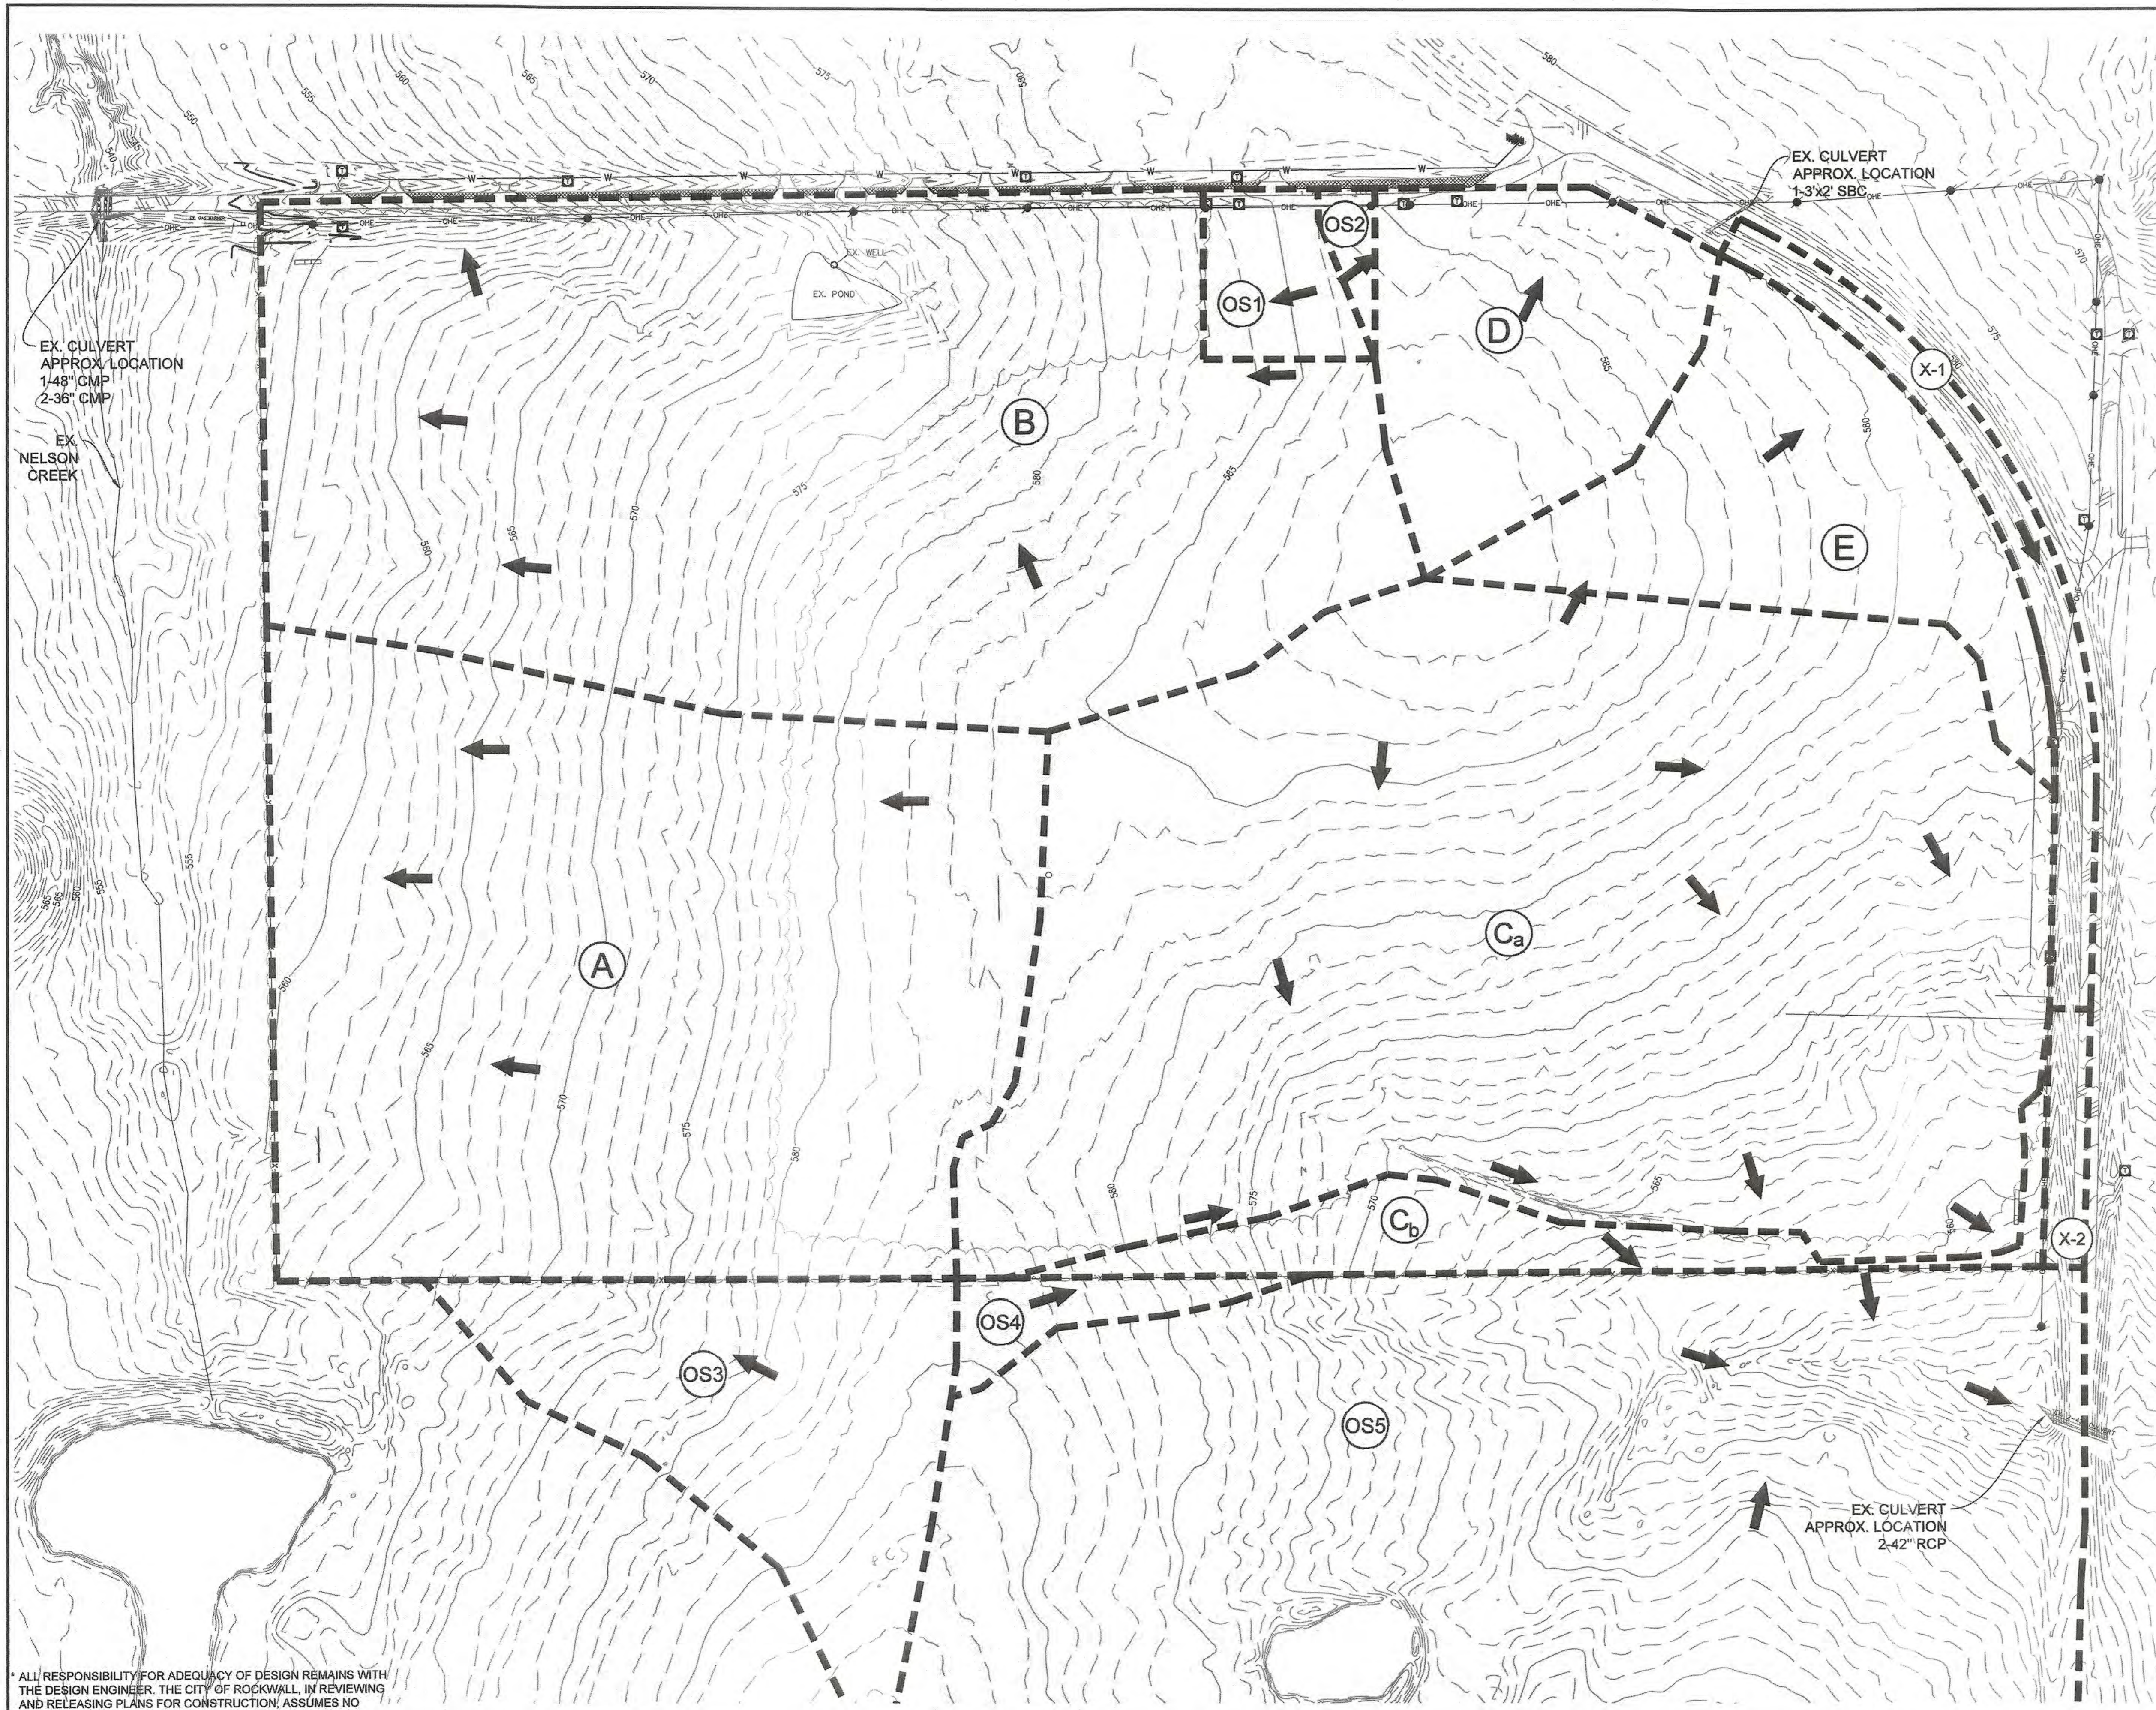

Existing Drainage Area Calculations							
Drainage Area	Area (AC)	Tc (Min)	C	K	I <sub>100</sub> (in/hr)	Q <sub>100</sub> (cfs)	Description
A	14.95	20.00	0.35	1.00	8.30	43.43	TO EX. CLEM ROAD CULVERT
B	17.79	20.00	0.35	1.00	8.30	51.68	TO EX. CLEM ROAD CULVERT
C <sub>a</sub>	20.85	20.00	0.35	1.00	8.30	60.57	TO EX. F.M. 3549 2-42" RCP (TO SOUTH)
C <sub>b</sub>	1.64	20.00	0.35	1.00	8.30	4.76	TO EX. F.M. 3549 2-42" RCP (TO SOUTH)
D	3.32	20.00	0.35	1.00	8.30	9.64	TO EX. F.M. 3549 3'x2' SBC
E	3.95	20.00	0.35	1.00	8.30	11.47	TO EX. F.M. 3549 2-42" RCP (TO SOUTH)
OS1	0.81	10.00	0.50	1.00	9.80	3.97	TO AREA B
OS2	0.20	10.00	0.50	1.00	9.80	0.98	TO AREA D
OS3	4.04	20.00	0.35	1.00	8.30	11.74	TO AREA A
OS4	0.58	20.00	0.35	1.00	8.30	1.68	TO AREA C <sub>b</sub>
OS5	40.95	20.00	0.35	1.00	8.30	118.96	TO EX. F.M. 3549 2-42" RCP (TO SOUTH)
X-1	1.28	10.00	0.90	1.00	9.80	11.29	TO EX. F.M. 3549 2-42" RCP (TO SOUTH)
X-2	0.36	10.00	0.90	1.00	9.80	3.18	TO EX. F.M. 3549 2-42" RCP (TO SOUTH)

RECORD DRAWINGS

To the best of our knowledge Engineering Concepts & Design, L.P., hereby states that this plan is As-Built. This information provided is based on surveying at the site and information provided by the contractor.

*Ryan C. King* 1/27/2021  
RYAN C. KING DATE

RELEASED FOR CONSTRUCTION

ALL RESPONSIBILITY FOR ADEQUACY OF DESIGN REMAINS WITH THE DESIGN ENGINEER. THE CITY OF ROCKWALL, IN REVIEWING AND RELEASING PLANS FOR CONSTRUCTION, ASSUMES NO RESPONSIBILITY FOR ADEQUACY OR ACCURACY OF DESIGN.

CITY \_\_\_\_\_ DATE \_\_\_\_\_

\*REFER TO NORTHGATE STORMWATER DETENTION ANALYSIS PREPARED BY NATHAN D. MAIER CONSULTING ENGINEERS, INC. DATED APRIL 2020

CAUTION! EXISTING UTILITIES

CONTRACTOR SHOULD CALL 1-800-DIG-TESS PRIOR TO BEGINNING ANY CONSTRUCTION ACTIVITIES FOR EXISTING UTILITY LOCATIONS. EXISTING UTILITIES AND UNDERGROUND FACILITIES INDICATED ON THESE PLANS HAVE BEEN LOCATED FROM REFERENCE INFORMATION. IT IS THE RESPONSIBILITY OF THE CONTRACTOR TO VERIFY BOTH HORIZONTALLY AND VERTICALLY THE LOCATION OF ALL EXISTING UTILITIES AND UNDERGROUND FACILITIES PRIOR TO CONSTRUCTION AND TO TAKE NECESSARY PRECAUTIONS IN ORDER TO PROTECT ALL FACILITIES ENCOUNTERED. THE CONTRACTOR SHALL PRESERVE AND PROTECT ALL EXISTING UTILITIES FROM DAMAGE DURING CONSTRUCTION.

BM-1: "PK" Nail on the south side of Clem Road, approximately 2275' west of the centerline intersection of Clem Road and FM 3549  
Elev.: 559.07'

BM-2: "PK" Nail in Clem Road, approximately 175' west of the centerline intersection of Clem Road and FM 3549  
Elev.: 584.83'

**ENGINEERINGCONCEPTS**  
& DESIGN, L.P.

ENGINEERING / PROJECT MANAGEMENT /  
CONSTRUCTION SERVICES - FIRM REG. #F-001145  
201 WINDCO CIR, STE 200, WYLIE, TX 75098  
972-941-8400 FAX: 972-941-8401 WWW.ECDLP.COM

REVISIONS:

DRAWN: MJH	DATE:
CHECKED: RCK	DATE: 6/1/2020
PROJECT NO.: 08838	
DWG FILE NAME: 08838 D.A.DWG	

THIS DOCUMENT IS RELEASED FOR THE PURPOSE OF CONSTRUCTION. THE SEAL APPEARING ON THIS DOCUMENT WAS AUTHORIZED BY RYAN C. KING, P.E. 123635




**DRAINAGE AREA EXISTING**


**NORTHGATE**

CITY OF ROCKWALL, ROCKWALL COUNTY, TEXAS

SHEET  
18  
OF  
40

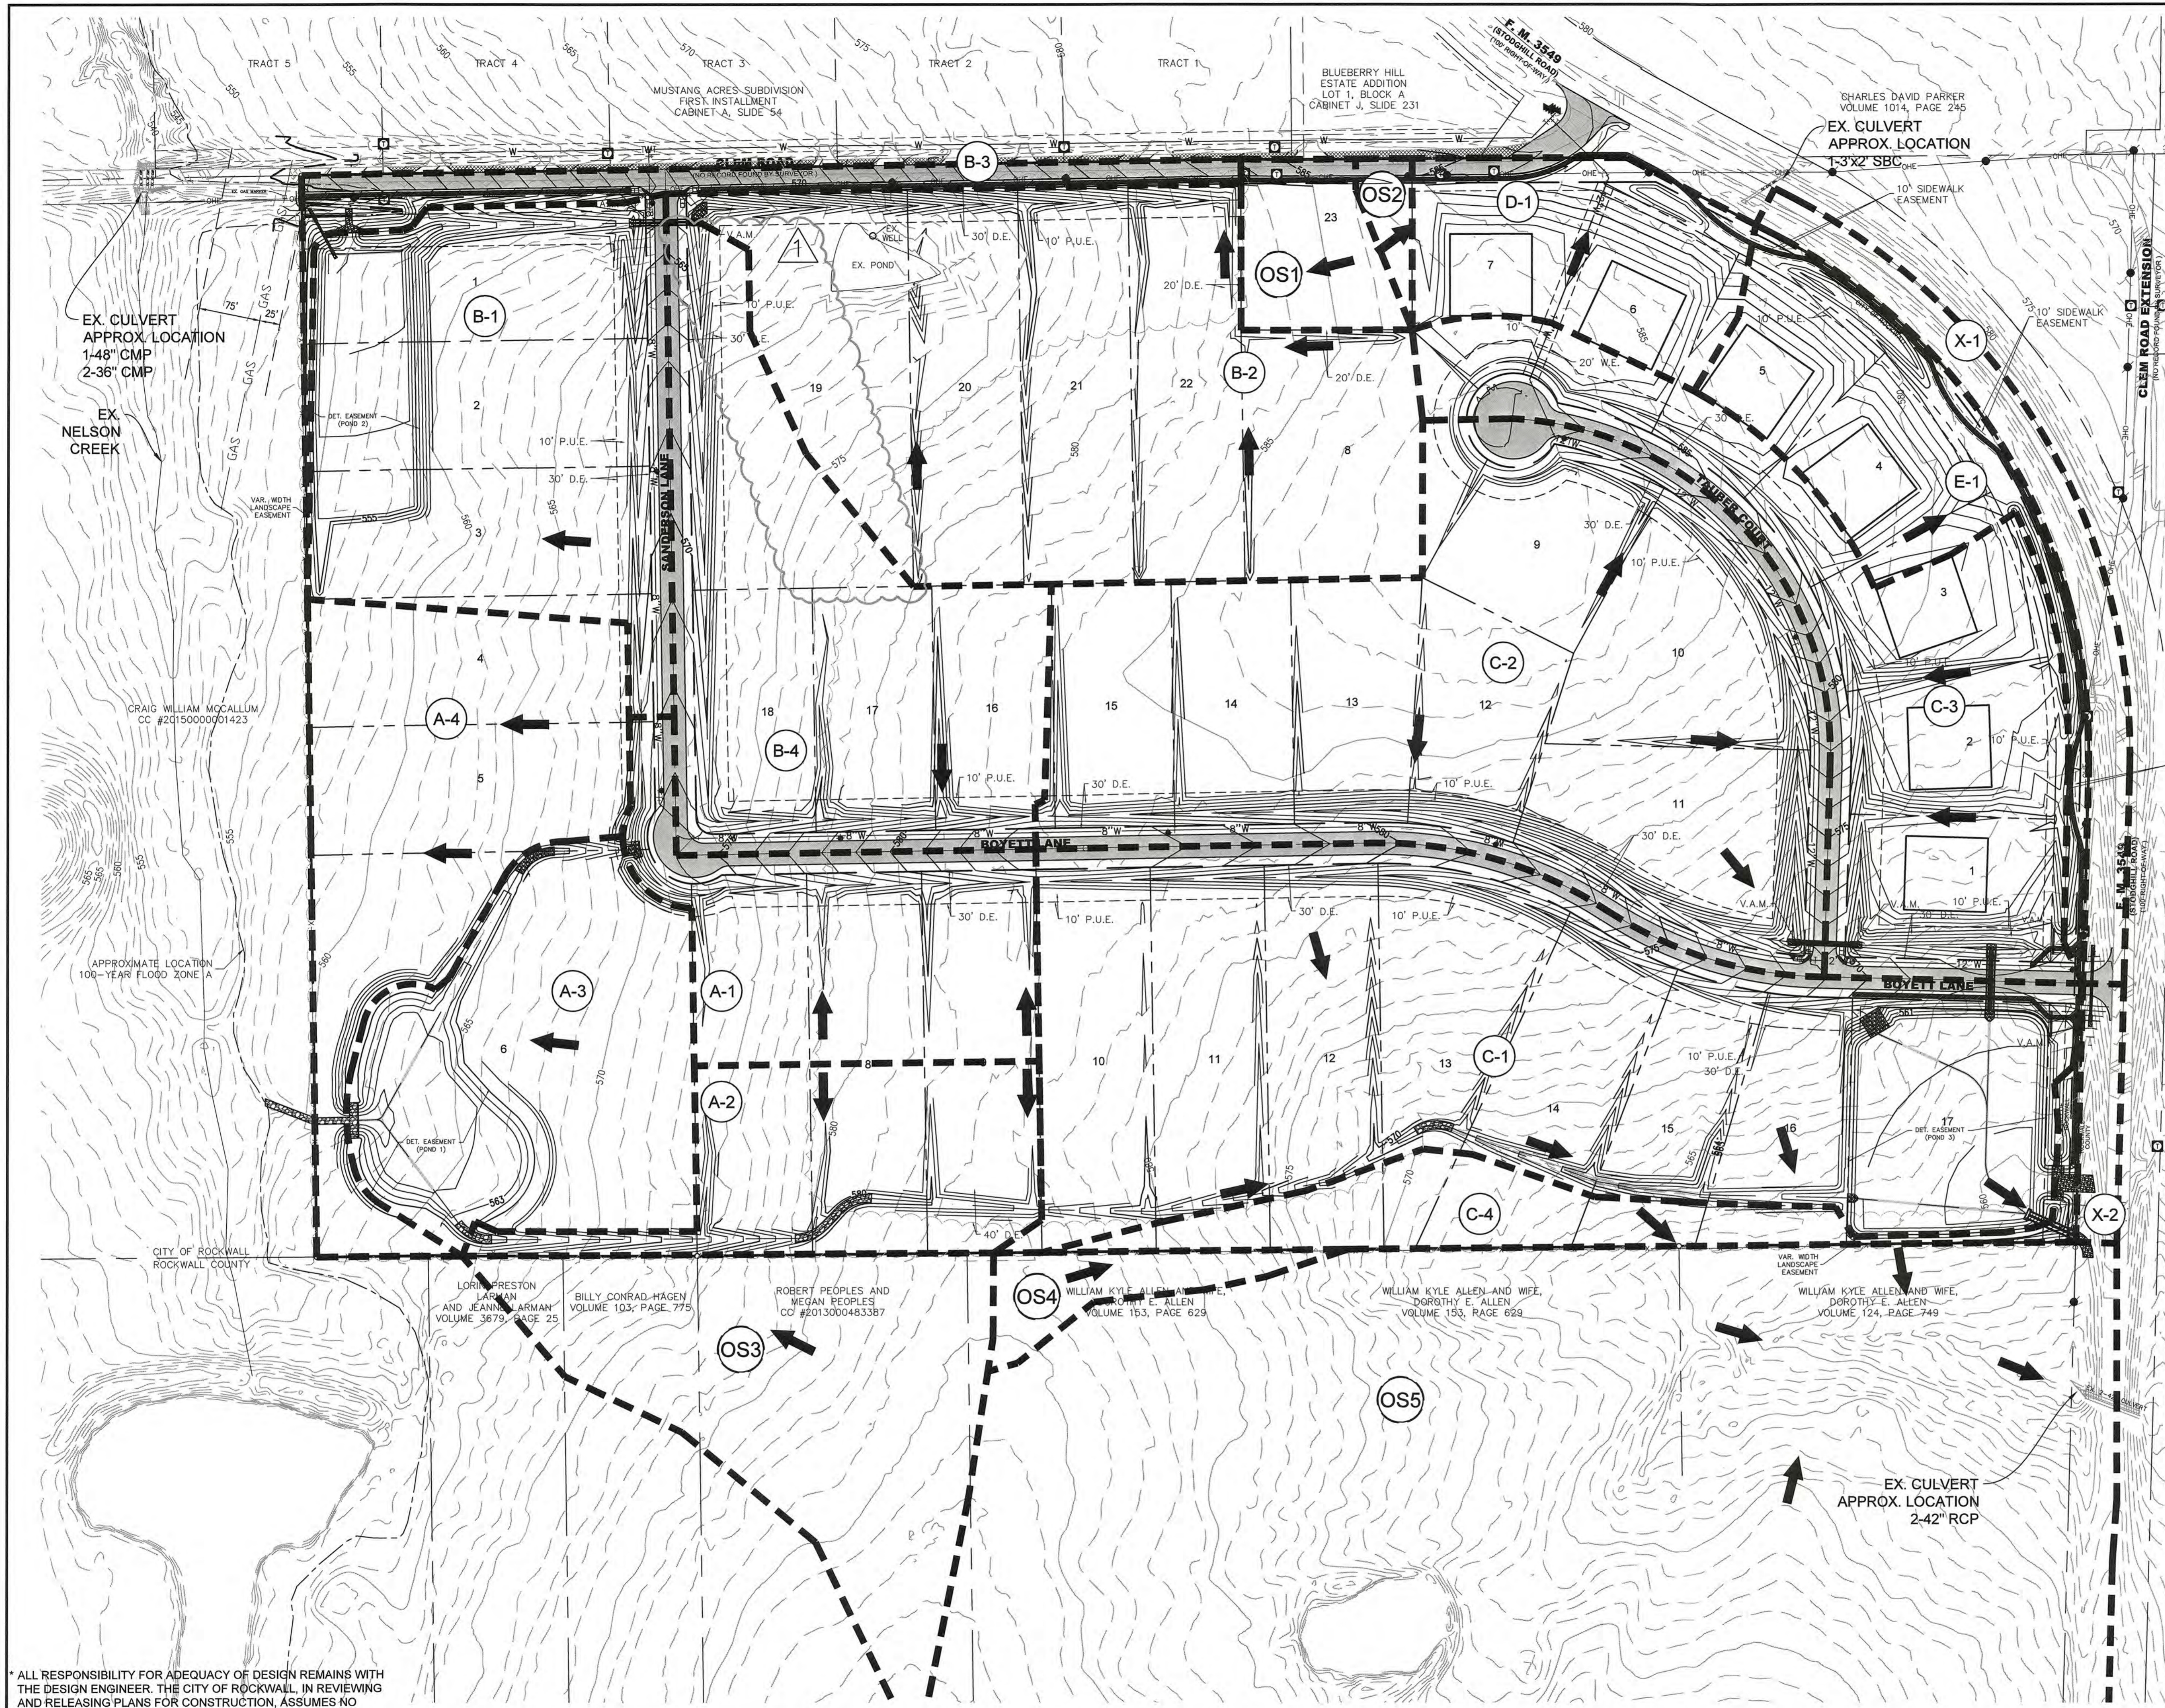

\*REFER TO NORTHGATE STORMWATER  
DETENTION ANALYSIS PREPARED BY NATHAN  
D. MAIER CONSULTING ENGINEERS, INC.  
DATED MAY 2020

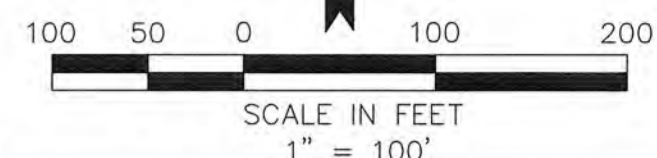

LEGEND	
	DRAINAGE AREA BOUNDARY
	EXISTING MAJOR CONTOUR
	EXISTING MINOR CONTOUR
	PROPOSED DRAINAGE AREA

Proposed Drainage Area Calculations									
Drainage Area	Area (AC)	Tc (min)	C	K	I <sub>100</sub> (in/hr)	Q <sub>100</sub> (cfs)	Description		
A-1	2.81	10.00	0.50	1.00	9.80	13.75	TO POND 1		
A-2	2.41	10.00	0.50	1.00	9.80	11.81	TO POND 1		
A-3	3.72	10.00	0.50	1.00	9.80	18.20	TO POND 1		
A-4	3.88	10.00	0.50	1.00	9.80	19.00	BYPASS POND 1		
B-1	5.05	10.00	0.50	1.00	9.80	24.74	TO POND 2		
B-2	7.69	10.00	0.50	1.00	9.80	37.66	TO POND 2		
B-3	1.06	10.00	0.50	1.00	9.80	5.19	BYPASS POND 2		
B-4	4.98	10.00	0.50	1.00	9.80	24.40	TO POND 2		
C-1	10.55	10.00	0.50	1.00	9.80	51.70	TO POND 3		
C-2	9.53	10.00	0.50	1.00	9.80	46.70	TO POND 3		
C-3	4.90	10.00	0.50	1.00	9.80	24.00	TO POND 3		
C-4	1.64	10.00	0.50	1.00	9.80	8.04	BYPASS POND 3		
D-1	1.96	10.00	0.50	1.00	9.80	9.60	TO EX. F.M. 3549 3'x2' SBC		
E-1	2.34	10.00	0.50	1.00	9.80	11.47	BYPASS POND 3		
OS1	0.81	10.00	0.50	1.00	9.80	3.97	TO AREA B-2 (TO POND 2)		
OS2	0.20	10.00	0.50	1.00	9.80	0.98	TO AREA D-1 (NOT DETAINED)		
OS3	4.04	20.00	0.35	1.00	8.30	11.74	TO AREA A-1		
OS4	0.58	20.00	0.35	1.00	8.30	1.68	TO AREA C-4 (NOT TO POND)		
OS5	40.95	20.00	0.35	1.00	8.30	118.96	TO EX. F.M. 3549 2-42" RCP (NOT TO POND)		
X-1	1.28	10.00	0.90	1.00	9.80	11.29	TO EX. F.M. 3549 2-42" RCP (NOT TO POND)		
X-2	0.36	10.00	0.90	1.00	9.80	3.18	TO EX. F.M. 3549 2-42" RCP (NOT TO POND)		

\* ALL RESPONSIBILITY FOR ADEQUACY OF DESIGN REMAINS WITH THE DESIGN ENGINEER. THE CITY OF ROCKWALL, IN REVIEWING AND RELEASING PLANS FOR CONSTRUCTION, ASSUMES NO RESPONSIBILITY FOR ADEQUACY OR ACCURACY OF DESIGN.

**CAUTION! EXISTING UTILITIES**  
CONTRACTOR SHOULD CALL 1-800-DIG-TESS PRIOR TO BEGINNING ANY CONSTRUCTION ACTIVITIES FOR EXISTING UTILITY LOCATIONS. EXISTING UTILITIES AND UNDERGROUND FACILITIES INDICATED ON THESE PLANS HAVE BEEN LOCATED FROM REFERENCE INFORMATION. IT IS THE RESPONSIBILITY OF THE CONTRACTOR TO VERIFY BOTH HORIZONTALLY AND VERTICALLY THE LOCATION OF ALL EXISTING UTILITIES AND UNDERGROUND FACILITIES PRIOR TO CONSTRUCTION AND TO TAKE NECESSARY PRECAUTIONS IN ORDER TO PROTECT ALL FACILITIES ENCOUNTERED. THE CONTRACTOR SHALL PRESERVE AND PROTECT ALL EXISTING UTILITIES FROM DAMAGE DURING CONSTRUCTION.

BM-1: "PK" Nail on the south side of Clem Road, approximately 2275' west of the centerline intersection of Clem Road and FM 3549  
Elev.: 559.07'

BM-2: "PK" Nail in Clem Road, approximately 175' west of the centerline intersection of Clem Road and FM 3549  
Elev.: 584.83'

**ENGINEERINGCONCEPTS**  
& DESIGN, L.P.

ENGINEERING / PROJECT MANAGEMENT /  
CONSTRUCTION SERVICES - FIRM REG. #F-001145  
201 WINDCO CIR, STE 200, WYLIE, TX 75098  
972-941-8400 FAX: 972-941-8401 WWW.ECDLP.COM

REVISIONS:	
1/25/2021 COMBINED LOTS A19 & A20	
DRAWN: MJH	DATE:
CHECKED: RCK	DATE: 6/1/2020
PROJECT NO.: 08838	
DWG FILE NAME: 08838 DA.DWG	



THIS DOCUMENT IS RELEASED FOR THE PURPOSE OF CONSTRUCTION. THE SEAL APPEARING ON THIS DOCUMENT WAS AUTHORIZED BY RYAN C. KING, P.E. 123635




**DRAINAGE AREA PROPOSED**  
**NORTHGATE**  
CITY OF ROCKWALL, ROCKWALL COUNTY, TEXAS

SHEET  
**19**  
OF  
**40**

**RECORD DRAWINGS**  
To the best of our knowledge Engineering Concepts & Design, L.P., hereby states that this plan is As-Built. This information provided is based on surveying at the site and information provided by the contractor.  
  
RYAN C. KING  
1/27/2021  
DATE

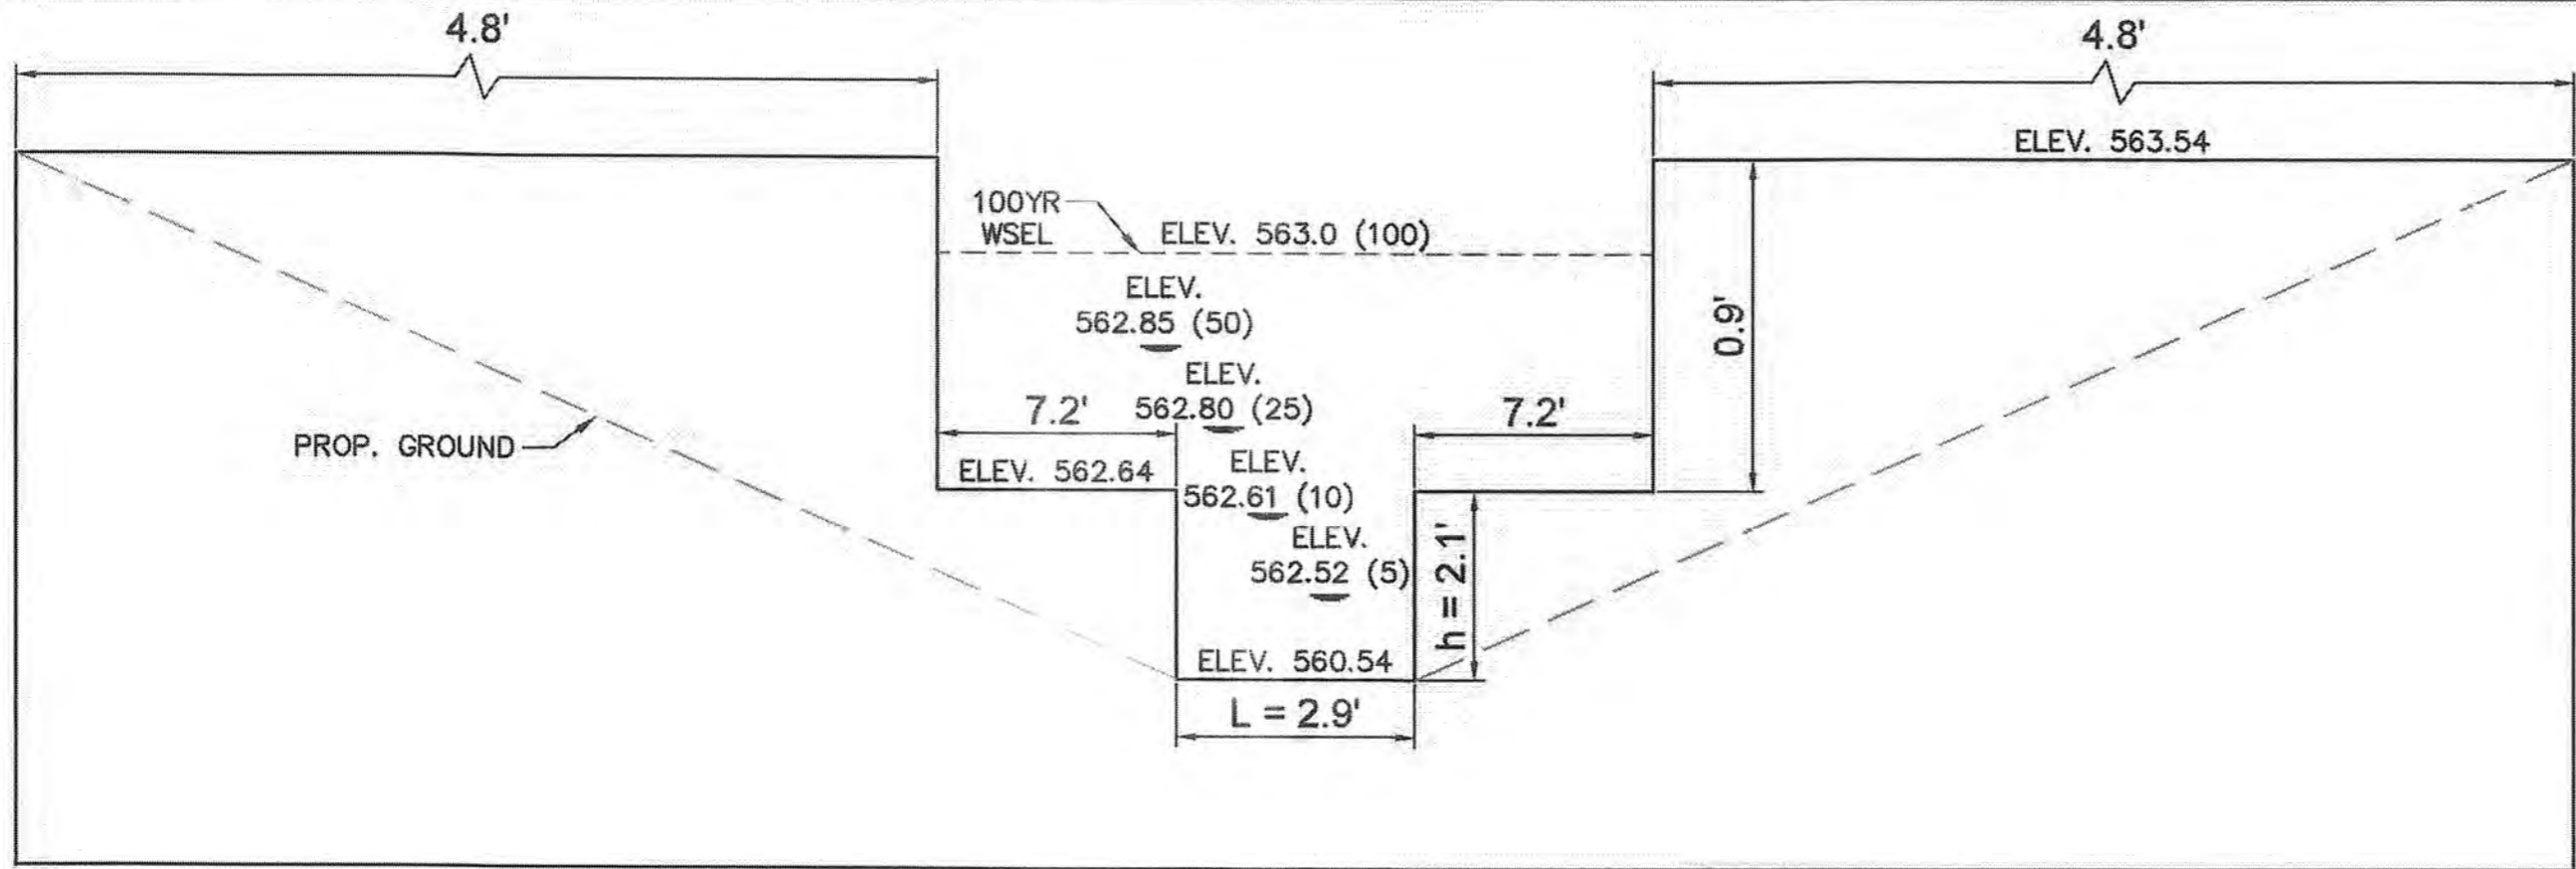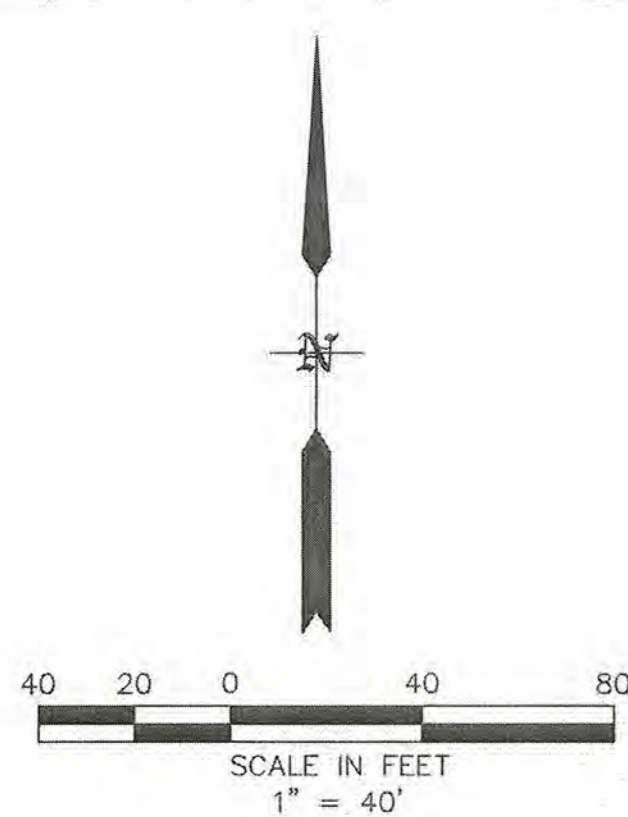

SECTION A-A  
OUTFALL STRUCTURE  
N.T.S.

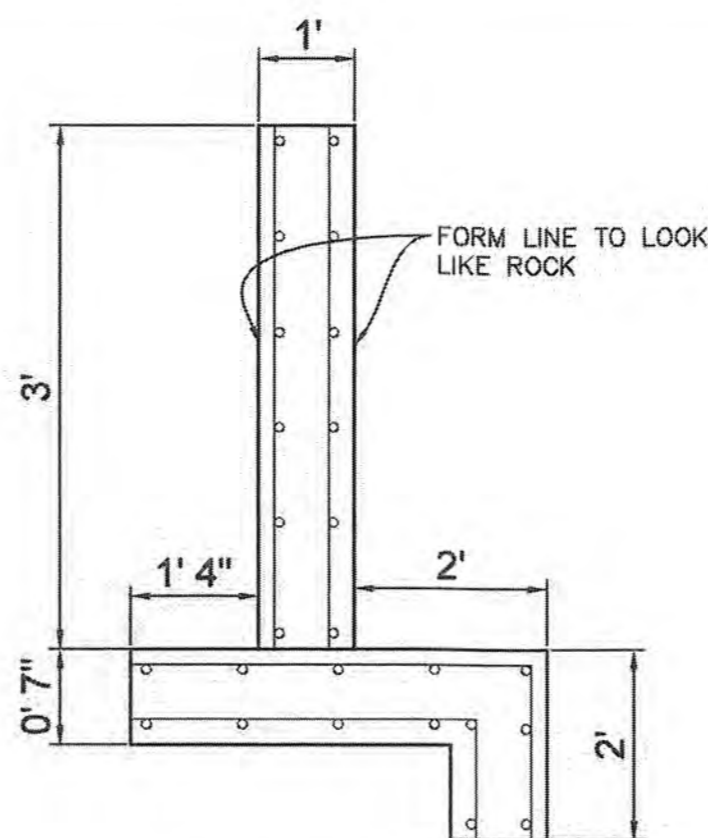

SECTION B-B

- NOTES:
- 12" THICK CLASS F 4200 PSI CONCRETE FOR ENTIRE STRUCTURE. 7.0 SACK/CY MIN. (NO FLY ASH ALLOWED FOR STORM STRUCTURES.)
  - #4 BARS @ 12" O.C.E.W.

POND 1 DRAINAGE AREAS				
DA	Pre-Developed Area (AC)	Developed Area (AC)	Bypass Area (AC)	Flow Through Area (AC)
A	14.95			
A-1		2.81		
A-2		2.41		
A-3		3.72		
A-4		3.88	3.88	
OS3				4.04
TOTAL	14.95	12.81	3.88	4.04

STAGE STORAGE - POND 1			
Elevation (FT)	Pond Surface (SF)	Volume (CF)	Cum. Volume (CF)
560.56	0	0	0
561.00	1287	283	283
562.00	20102	10695	10978
562.52	26428	12098	23076
562.61	27523	14526	25503
562.80	29835	19975	30952
562.85	30443	21482	32459
563.00	32268	26185	37163
564.00	40674	36471	73634

DETENTION CALCS - POND (100 YR)						
Time (min)	C* <sup>K</sup>	Intensity, I (in/hr)	Runoff(1), Q (cfs)	Volume In (CF)	Volume Out (CF)	Storage Req. (CF)
10	0.50	9.80	63.56	38134.7	21701.2	16433.6
15	0.50	9.00	58.37	52532.6	27126.5	25406.1
20	0.50	8.30	53.83	64595.6	32551.8	32043.8
30	0.50	6.90	44.75	80549.9	43402.4	37147.5
40	0.50	5.80	37.62	90278.2	54253.0	36025.2
50	0.50	5.00	32.43	97282.5	65103.6	32178.9
60	0.50	4.50	29.18	105065.1	75954.2	29110.9
70	0.50	4.00	25.94	108956.4	86804.8	22151.6
80	0.50	3.70	24.00	115182.5	97655.4	17527.1
90	0.50	3.50	22.70	122576.0	108506.0	14070.0
100	0.50	3.40	22.05	132304.2	119356.5	12947.7
110	0.50	3.20	20.75	136973.8	130207.1	6766.6
120	0.50	2.70	17.51	126078.1	141057.7	-14979.6
150	0.50	2.40	15.57	140086.8	173609.5	-33522.7

POND 1 RELEASE CALCULATIONS (10 YR)						
	On-Site Area A	Tc (min)	K-Value	C-Factor	Intensity I (in/hr)	Flow Q (cfs)
PRE-DEVELOPED CONDITIONS (Onsite - Total)	14.95	20	1.00	0.35	5.90	30.87
DEVELOPED CONDITIONS (Onsite - Total)	12.81	10	1.00	0.50	7.10	45.47
BYPASS CONDITIONS (Onsite - Not to Pond)	3.88	10	1.00	0.50	7.10	13.76
FLOW THROUGH CONDITIONS (Offsite - To Pond)	4.04	20	1.00	0.35	5.90	8.34

Existing Site Release Flow Q <sub>e</sub> =	Pre-Developed Q + Flow Through
Q <sub>e</sub> =	39.21 cfs
Pond Release Flow Q <sub>p</sub> =	Pre-Developed Q + Flow Through - Bypass Q
Q <sub>p</sub> =	25.45 cfs Max Release
Site Release Flow Q <sub>s</sub> =	Pond Release Q <sub>p</sub> + Bypass Q
Q <sub>s</sub> =	39.21 cfs

#### RECORD DRAWINGS

To the best of our knowledge Engineering Concepts & Design, L.P., hereby states that this plan is As-Built. This information provided is based on surveying at the site and information provided by the contractor.

*Ryan C. King* 1/27/2021  
RYAN C. KING DATE

POND 1 RELEASE CALCULATIONS (5 YR)						
	On-Site Area A (AC)	Tc (min)	K-Value	C-Factor	Intensity I (in/hr)	Flow Q (cfs)
PRE-DEVELOPED CONDITIONS (Onsite - Total)	14.95	20	1.00	0.35	4.90	25.64
DEVELOPED CONDITIONS (Onsite - Total)	12.81	10	1.00	0.50	6.10	39.06
BYPASS CONDITIONS (Onsite - Not to Pond)	3.88	10	1.00	0.50	6.10	11.82
FLOW THROUGH CONDITIONS (Offsite - To Pond)	4.04	20	1.00	0.35	4.90	6.93

Existing Site Release Flow Q <sub>e</sub> =	Pre-Developed Q + Flow Through
Q <sub>e</sub> =	32.57 cfs
Pond Release Flow Q <sub>p</sub> =	Pre-Developed Q + Flow Through - Bypass Q
Q <sub>p</sub> =	20.74 cfs Max Release
Site Release Flow Q <sub>s</sub> =	Pond Release Q <sub>p</sub> + Bypass Q
Q <sub>s</sub> =	32.57 cfs

POND 1 RELEASE CALCULATIONS (100 YR)						
	On-Site Area A	Tc (min)	K-Value	C-Factor	Intensity I (in/hr)	Flow Q (cfs)
PRE-DEVELOPED CONDITIONS (Onsite - Total)	14.95	20	1.00	0.35	8.30	43.43
DEVELOPED CONDITIONS (Onsite - Total)	12.81	10	1.00	0.50	9.80	62.76
BYPASS CONDITIONS (Onsite - Not to Pond)	3.88	10	1.00	0.50	9.80	19.00
FLOW THROUGH CONDITIONS (Offsite - To Pond)	4.04	20	1.00	0.35	8.30	11.74


Existing Site Release Flow Q <sub>e</sub> =	Pre-Developed Q + Flow Through
Q <sub>e</sub> =	55.17 cfs
Pond Release Flow Q <sub>p</sub> =	Pre-Developed Q + Flow Through - Bypass Q
Q <sub>p</sub> =	36.17 cfs Max Release
Site Release Flow Q <sub>s</sub> =	Pond Release Q <sub>p</sub> + Bypass Q
Q <sub>s</sub> =	55.17 cfs

POND 1 RELEASE CALCULATIONS (50 YR)						
	On-Site Area A	Tc (min)	K-Value	C-Factor	Intensity I (in/hr)	Flow Q (cfs)
PRE-DEVELOPED CONDITIONS (Onsite - Total)	14.95	20	1.00	0.35	7.50	39.24
DEVELOPED CONDITIONS (Onsite - Total)	12.81	10	1.00	0.50	9.00	57.64
BYPASS CONDITIONS (Onsite - Not to Pond)	3.88	10	1.00	0.50	9.00	17.45
FLOW THROUGH CONDITIONS (Offsite - To Pond)	4.04	20	1.00	0.35	7.50	10.61

Existing Site Release Flow Q <sub>e</sub> =	Pre-Developed Q + Flow Through
Q <sub>e</sub> =	49.85 cfs
Pond Release Flow Q <sub>p</sub> =	Pre-Developed Q + Flow Through - Bypass Q
Q <sub>p</sub> =	32.40 cfs Max Release
Site Release Flow Q <sub>s</sub> =	Pond Release Q <sub>p</sub> + Bypass Q
Q <sub>s</sub> =	49.85 cfs

POND 1 RELEASE CALCULATIONS (25 YR)						
	On-Site Area A	Tc (min)	K-Value	C-Factor	Intensity I (in/hr)	Flow Q (cfs)
PRE-DEVELOPED CONDITIONS (Onsite - Total)	14.95	20	1.00	0.35	6.60	34.53
DEVELOPED CONDITIONS (Onsite - Total)	12.81	10	1.00	0.50	8.30	53.15
BYPASS CONDITIONS (Onsite - Not to Pond)	3.88	10	1.00	0.50	8.30	16.09
FLOW THROUGH CONDITIONS (Offsite - To Pond)	4.04	20	1.00	0.35	6.60	9.33

Existing Site Release Flow Q <sub>e</sub> =	Pre-Developed Q + Flow Through
Q <sub>e</sub> =	43.87 cfs
Pond Release Flow Q <sub>p</sub> =	Pre-Developed Q + Flow Through - Bypass Q
Q <sub>p</sub> =	27.78 cfs Max Release
Site Release Flow Q <sub>s</sub> =	Pond Release Q <sub>p</sub> + Bypass Q
Q <sub>s</sub> =	43.87 cfs

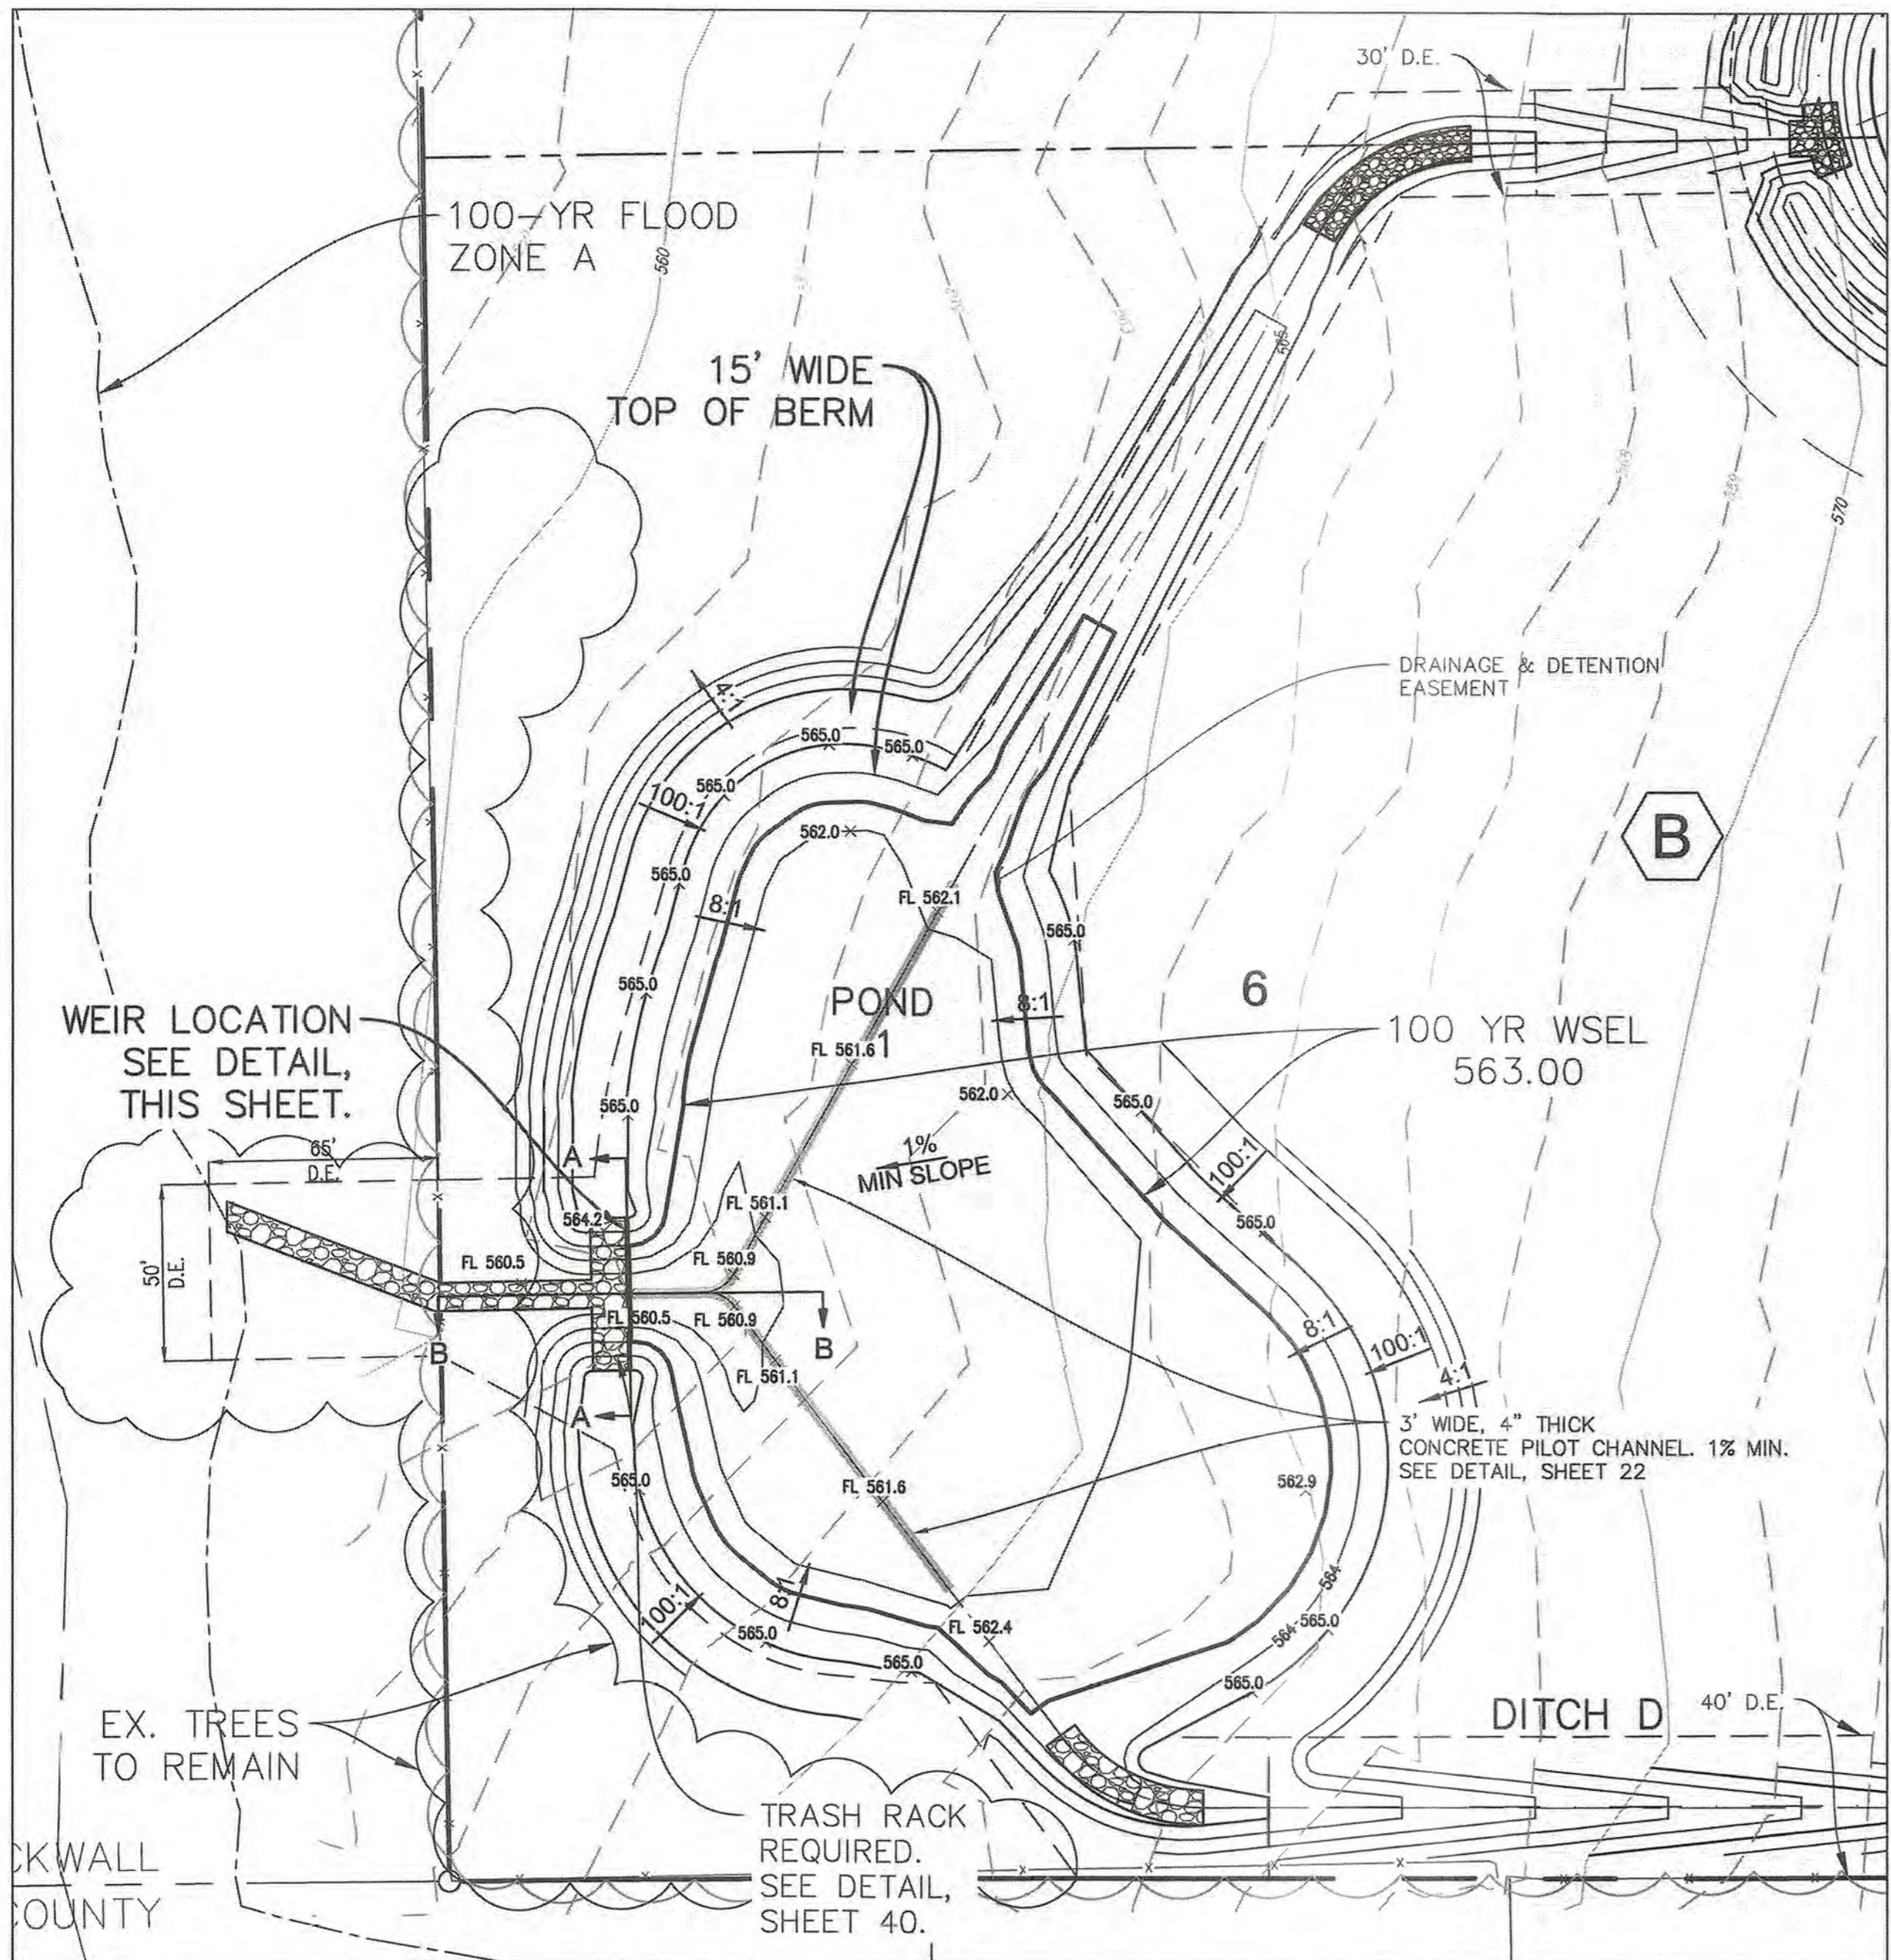

\* ALL RESPONSIBILITY FOR ADEQUACY OF DESIGN REMAINS WITH THE DESIGN ENGINEER. THE CITY OF ROCKWALL, IN REVIEWING AND RELEASING PLANS FOR CONSTRUCTION, ASSUMES NO RESPONSIBILITY FOR ADEQUACY OR ACCURACY OF DESIGN.

**CAUTION: EXISTING UTILITIES**  
CONTRACTOR SHOULD CALL 1-800-485-1111 PRIOR TO BEGINNING ANY CONSTRUCTION ACTIVITIES FOR EXISTING UTILITY LOCATIONS. EXISTING UTILITIES AND UNDERGROUND FACILITIES INDICATED ON THESE PLANS HAVE BEEN LOCATED FROM REFERENCE INFORMATION. IT IS THE RESPONSIBILITY OF THE CONTRACTOR TO VERIFY BOTH HORIZONTALLY AND VERTICALLY THE LOCATION OF ALL EXISTING UTILITIES AND UNDERGROUND FACILITIES PRIOR TO CONSTRUCTION AND TO TAKE NECESSARY PRECAUTIONS IN ORDER TO PROTECT ALL FACILITIES ENCOUNTERED. THE CONTRACTOR SHALL PRESERVE AND PROTECT ALL EXISTING UTILITIES FROM DAMAGE DURING CONSTRUCTION.

BM-1: "PK" Nail on the south side of Clem Road, approximately 2275' west of the centerline intersection of Clem Road and FM 3549  
Elev.: 559.07'

BM-2: "PK" Nail in Clem Road, approximately 175' west of the centerline intersection of Clem Road and FM 3549  
Elev.: 584.83'

**ENGINEERINGCONCEPTS**  
& DESIGN, L.P.

ENGINEERING / PROJECT MANAGEMENT /  
CONSTRUCTION SERVICES - FIRM REG. #F-001145  
201 WINDCO CIR, STE 200, WYLLIE, TX 75098  
972-941-8400 FAX: 972-941-8401 WWW.ECDLP.COM


REVISIONS:	
DRAWN: MJH	DATE:
CHECKED: RCK	DATE: 6/1/2020
PROJECT NO.: 08838	
DWG FILE NAME: 08838 DET.DWG	

THIS DOCUMENT IS RELEASED FOR THE PURPOSE OF CONSTRUCTION. THE SEAL APPEARING ON THIS DOCUMENT WAS AUTHORIZED BY RYAN C. KING, P.E. 123635



**DETENTION POND 1**  
**NORTHGATE**  
CITY OF ROCKWALL, ROCKWALL COUNTY, TEXAS

SHEET  
20  
OF  
40

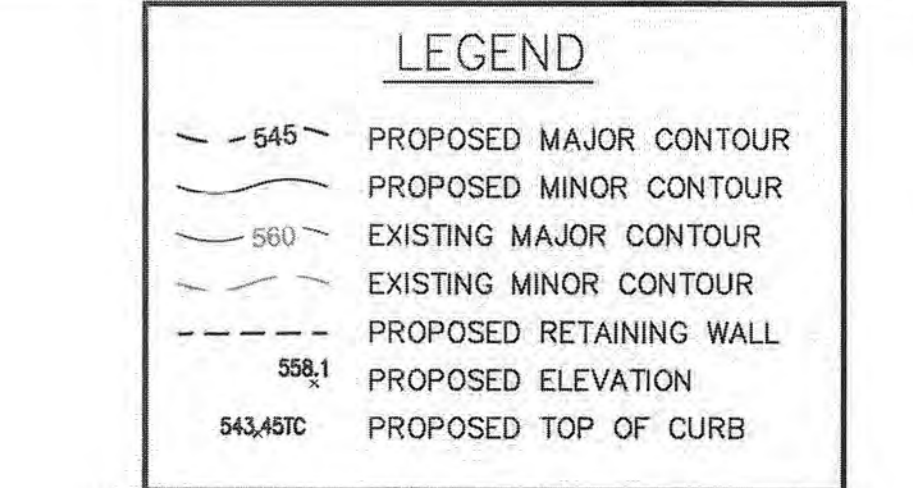


- NOTES:
- ALL DETENTION SYSTEMS TO BE COMPLETED PER PLAN AND FUNCTIONING PRIOR TO ANY PAVING CONSTRUCTION. THE BOTTOM AND SIDES TO BE EITHER ANCHORED CURLEX OR SOD. MUST BE SEEDDED WITH ANNUAL GRASS SEED.
  - NO CITY ACCEPTANCE UNTIL 75%-80% OF ALL DISTURBED AREA TO HAVE 1" MINIMUM STAND OF ANNUAL GRASS (NO WINTER RYE OR SIMILAR).

DETENTION CALCS - POND (50 YR)						
Time (min)	C* <sup>K</sup>	Intensity, I (in/hr)	Runoff(1), Q (cfs)	Volume In (CF)	Volume Out (CF)	Storage Req. (CF)
10	0.50	9.00	58.37	35021.7	19441.4	15580.4
15	0.50	8.10	52.53	47279.3	24301.7	22977.6
20	0.50	7.50	48.64	58369.5	29162.0	29207.5
30	0.50	6.10	39.56	71210.8	38882.7	32328.1
40	0.50	5.20	33.72	80939.0	48603.4	32335.7
50	0.50	4.50	29.18	87554.3	58324.1	29230.2
60	0.50	3.90	25.29	91056.4	68044.7	23011.7
70	0.50	3.70	24.00	100784.7	77765.4	23019.3
80	0.50	3.50	22.70	108956.4	87486.1	21470.3
90	0.50	3.30	21.40	115571.6	97206.8	18364.9
100	0.50	3.00	19.46	116739.0	106927.4	9811.6
110	0.50	2.90	18.81	124132.5	116648.1	7484.4
120	0.50	2.40	15.57	112069.4	126368.8	-14299.3
150	0.50	2.00	12.97	116739.0	155530.8	-38791.8

DETENTION CALCS - POND (25 YR)						
Time (min)	C* <sup>K</sup>	Intensity, I (in/hr)	Runoff(1), Q (cfs)	Volume In (CF)	Volume Out (CF)	Storage Req. (CF)
10	0.50	8.30	53.83	32297.8	16666.4	15631.4
15	0.50	7.50	48.64	43777.1	20833.0	22944.1
20	0.50	6.60	42.80	51365.2	24999.6	26365.5
30	0.50	5.50	35.67	64206.5	33332.8	30873.6
40	0.50	4.60	29.83	71599.9	41666.0	29933.9
50	0.50	4.00	25.94	77826.0	49999.2	27826.8
60	0.50	3.50	22.70	81717.3	58332.4	23384.9
70	0.50	3.30	21.40	89889.0	66665.6	23223.4
80	0.50	3.10	20.11	96504.2	74998.8	21505.4
90	0.50	2.90	18.81	101562.9	83332.1	18230.9
100	0.50	2.70	17.51	105065.1	91665.3	13399.8
110	0.50	2.50	16.21	107010.8	99999.5	7012.3
120	0.50	2.15	13.94	100395.5	108331.7	-7936.1
150	0.50	1.80	11.67	105065.1	133331.3	-28266.2

DETENTION CALCS - POND (10 YR)						
Time (min)	C* <sup>K</sup>	Intensity, I (in/hr)	Runoff(1), Q (cfs)	Volume In (CF)	Volume Out (CF)	Storage Req. (CF)
10	0.50	7.10	46.05	27628.2	15270.6	12357.6
15	0.50	6.50	42.16	37940.2	19088.3	18851.9
20	0.50	5.90	38.26	45917.3	22905.9	23011.4
30	0.50	4.80	31.13	56034.7	30541.2	25493.5
40	0.50	4.00	25.94	62260.8	38176.5	24084.3
50	0.50	3.50	22.70	68097.8	45811.8	22286.0
60	0.50	3.00	19.46	70043.4	53447.1	16596.3
70	0.50	2.80	18.16	76269.5	61082.4	15187.1
80	0.50	2.60	16.86	80939.0	68717.7	12221.3
90	0.50	2.50	16.21	87554.3	76353.0	11201.3
100	0.50	2.40	15.57	93391.2	83988.3	9402.9
110	0.50	2.30	14.92	98449.9	91623.6	6826.3
120	0.50	1.80	11.67	84052.1	99258.9	-15206.8
150	0.50	1.50	9.73	87554.3	122164.8	-34610.6

DETENTION CALCS - POND (5 YR)						
Time (min)	C* <sup>K</sup>	Intensity, I (in/hr)	Runoff(1) Q (cfs)	Volume In (CF)	Volume Out (CF)	Storage Req. (CF)
10	0.50	6.10	39.56	23736.9	12445.8	11291.1
15	0.50	5.50	35.67	32103.2	15557.3	16546.0
20	0.50	4.90	31.78	38134.7	18668.7	19466.0
30	0.50	4.10	26.59	47863.0	24891.6	22971.4
40	0.50	3.40	22.05	52921.7	31114.5	21807.2
50	0.50	2.80	18.16	54478.2	37337.4	17140.8
60	0.50	2.60	16.86	60704.3	43560.3	17144.0
70	0.50	2.40	15.57	65373.8	49783.2	15590.6
80	0.50	2.30	14.92	71599.9	56006.1	15593.8
90	0.50	2.10	13.62	73545.6	62229.0	11316.6
100	0.50	1.90	12.32	73934.7	68451.9	5482.8
110	0.50	1.80	11.67	77047.7	74674.8	2372.9
120	0.50	1.60	10.38	74713.0	80897.7	-6184.7
150	0.50	1.35	8.76	78798.8	99566.4	-20767.6

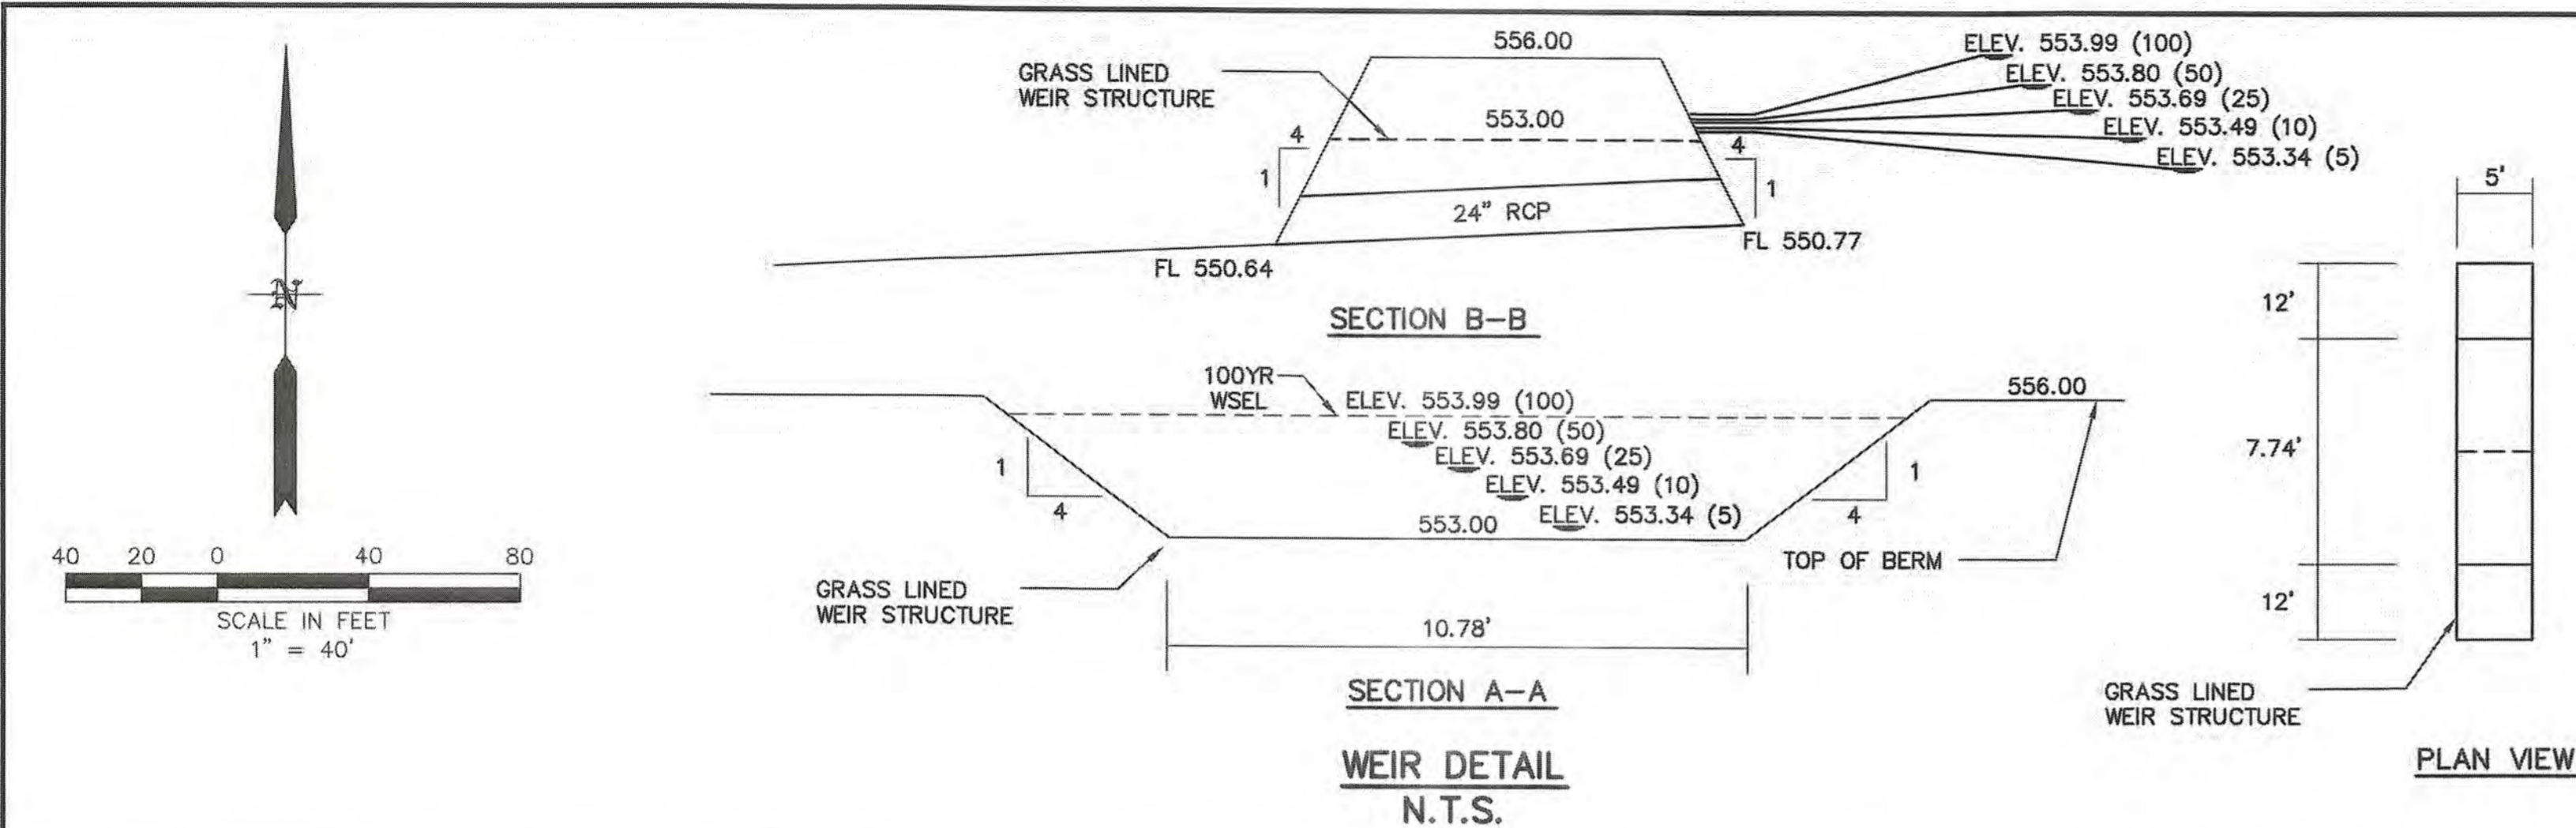

ORIFICE DESIGN (1-24" Pipe)						
$Q_o = A \cdot C \cdot (2 \cdot g \cdot h)^{0.5}$						
STAGE	100	50	25	10	5	YEAR
C	0.66	0.66	0.66	0.66	0.66	ORIFICE COEFFICIENT
g	32.2	32.2	32.2	32.2	32.2	GRAVITATIONAL CONSTANT
h	2.22	2.03	1.92	1.72	1.57	FT
A	3.14	3.14	3.14	3.14	3.14	SF (AREA OF ORIFICE)
Qo	24.79	23.71	23.06	21.82	20.85	CFS

TRAPEZOIDAL WEIR CALCULATION						
$Q_w = 3.367 \cdot L \cdot H^{3/2}$						
STAGE	100	50	25	10	5	YEAR
H	0.99	0.80	0.69	0.49	0.34	FT
L	7.74	7.74	7.74	7.74	7.74	FT
V	2.22	2.13	2.06	1.88	1.67	FPS
Qw	25.67	18.65	14.94	8.94	5.17	CFS

ACTUAL VS. ALLOWABLE RELEASE FLOW						
STAGE	100	50	25	10	5	YEAR
ACTUAL	50.46	42.35	37.99	30.76	26.02	FT
ALLOWABLE	50.46	45.58	40.06	35.85	29.75	FT

LEGEND	
	PROPOSED MAJOR CONTOUR
	PROPOSED MINOR CONTOUR
	EXISTING MAJOR CONTOUR
	EXISTING MINOR CONTOUR
	PROPOSED RETAINING WALL
	PROPOSED ELEVATION
	PROPOSED TOP OF CURB

- NOTES:
- ALL DETENTION SYSTEMS TO BE COMPLETED PER PLAN AND FUNCTIONING PRIOR TO ANY PAVING CONSTRUCTION. THE BOTTOM AND SIDES TO HAVE EITHER ANCHORED CURLEX OR SOD. MUST BE SEEDED WITH ANNUAL GRASS SEED.
  - NO CITY ACCEPTANCE UNTIL 75%-80% OF ALL DISTURBED AREA TO HAVE 1" MINIMUM STAND OF ANNUAL GRASS (NO WINTER RYE OR SIMILAR).

DETENTION CALCS - POND 2 (50 YR)						
Time (min)	C*K	Intensity, I (in/hr)	Runoff(1), Q (cfs)	Volume In (CF)	Volume Out (CF)	Storage Req. (CF)
10	0.50	9.00	83.36	50017.5	27347.0	22670.6
15	0.50	8.10	75.03	67523.6	34183.7	33339.9
20	0.50	7.50	69.47	83362.5	41020.4	42342.1
30	0.50	6.10	56.50	101702.3	54693.9	47008.4
40	0.50	5.20	48.17	115596.0	68367.4	47228.6
50	0.50	4.50	41.68	125043.8	82040.9	43002.9
60	0.50	3.90	36.12	130045.5	95714.3	34331.2
70	0.50	3.70	34.27	143939.3	109387.8	34551.5
80	0.50	3.50	32.42	155610.0	123061.3	32548.7
90	0.50	3.30	30.57	165057.8	136734.8	28323.0
100	0.50	3.00	27.79	166725.0	150408.2	16316.8
110	0.50	2.90	26.86	177284.3	164081.7	13202.6
120	0.50	2.40	22.23	160056.0	177755.2	-17699.2
150	0.50	2.00	18.53	166725.0	218775.6	-52050.6

DETENTION CALCS - POND 2 (25 YR)						
Time (min)	C*K	Intensity, I (in/hr)	Runoff(1), Q (cfs)	Volume In (CF)	Volume Out (CF)	Storage Req. (CF)
10	0.50	8.30	76.88	46127.3	24036.9	22090.3
15	0.50	7.50	69.47	62521.9	30046.2	32475.7
20	0.50	6.60	61.13	73359.0	36055.4	37303.6
30	0.50	5.50	50.94	91698.8	48073.9	43624.9
40	0.50	4.60	42.61	102258.0	60092.3	42165.7
50	0.50	4.00	37.05	111150.0	72110.8	39039.2
60	0.50	3.50	32.42	116707.5	84129.3	32578.2
70	0.50	3.30	30.57	128378.3	96147.7	32230.5
80	0.50	3.10	28.71	137826.0	108166.2	29659.8
90	0.50	2.90	26.86	145050.8	120184.7	24866.1
100	0.50	2.70	25.01	150052.5	132203.1	17849.4
110	0.50	2.50	23.16	152831.3	144221.6	8609.7
120	0.50	2.15	19.91	143383.5	156240.0	-12856.5
150	0.50	1.80	16.67	150052.5	192295.4	-42242.9

DETENTION CALCS - POND 2 (10 YR)						
Time (min)	C*K	Intensity, I (in/hr)	Runoff(1), Q (cfs)	Volume In (CF)	Volume Out (CF)	Storage Req. (CF)
10	0.50	7.10	65.76	39458.3	21511.4	17946.8
15	0.50	6.50	60.21	54185.6	26889.3	27296.3
20	0.50	5.90	54.65	65578.5	32267.2	33311.3
30	0.50	4.80	44.46	80028.0	43022.9	37005.1
40	0.50	4.00	37.05	88920.0	53778.6	35141.4
50	0.50	3.50	32.42	97256.3	64534.3	32721.9
60	0.50	3.00	27.79	100035.0	75290.0	24745.0
70	0.50	2.80	25.94	108927.0	86045.8	22881.2
80	0.50	2.60	24.08	115596.0	96801.5	18794.5
90	0.50	2.50	23.16	125043.8	107557.2	17486.6
100	0.50	2.40	22.23	133380.0	118312.9	15067.1
110	0.50	2.30	21.30	140604.8	129068.6	11536.1
120	0.50	1.80	16.67	120042.0	139824.4	-19782.4
150	0.50	1.50	13.89	125043.8	172091.5	-47047.8

DETENTION CALCS - POND 2 (5 YR)						
Time (min)	C*K	Intensity, I (in/hr)	Runoff(1), Q (cfs)	Volume In (CF)	Volume Out (CF)	Storage Req. (CF)
10	0.50	6.10	56.50	33900.8	17850.2	16050.5
15	0.50	5.50	50.94	45849.4	22312.8	23536.6
20	0.50	4.90	45.39	54463.5	26775.4	27688.1
30	0.50	4.10	37.98	68357.3	35700.5	32656.8
40	0.50	3.40	31.49	75582.0	44625.6	30956.4
50	0.50	2.80	25.94	77805.0	53550.7	24254.3
60	0.50	2.60	24.08	86697.0	62475.8	24221.2
70	0.50	2.40	22.23	93366.0	71401.0	21965.0
80	0.50	2.30	21.30	102258.0	80326.1	21931.9
90	0.50	2.10	19.45	105036.8	89251.2	15785.6
100	0.50	1.90	17.60	105592.5	98176.3	7416.2
110	0.50	1.80	16.67	110038.5	107101.4	2937.1
120	0.50	1.60	14.82	106704.0	116026.6	-9322.6
150	0.50	1.35	12.50	112539.4	142801.9	-30262.5

POND 2 RELEASE CALCULATIONS														
	On-Site Area A (AC)	Tc (min)	K-Value	C-Factor	Intensity I <sub>100</sub> (in/hr)	I <sub>50</sub> (in/hr)	I <sub>25</sub> (in/hr)	I <sub>10</sub> (in/hr)	I <sub>5</sub> (in/hr)	Flow Q <sub>100</sub> (cfs)	Q <sub>50</sub> (cfs)	Q <sub>25</sub> (cfs)	Q <sub>10</sub> (cfs)	Q <sub>5</sub> (cfs)
PRE-DEVELOPED CONDITIONS (Onsite - Total)	17.79	20	1.00	0.35	8.30	7.50	6.60	5.90	4.90	51.68	46.70	41.09	36.74	30.55
DEVELOPED CONDITIONS (Onsite - Total)	18.77	10	1.00	0.50	9.80	9.00	8.30	7.10	6.10	91.99	84.48	77.91	66.65	57.22
BYPASS CONDITIONS (Onsite - Not to Pond)	1.06	10	1.00	0.50	9.80	9.00	8.30	7.10	6.10	5.19	4.77	4.39	3.76	3.23
FLOW THROUGH CONDITIONS (Offsite - To Pond)	0.81	10	1.00	0.50	9.80	9.00	8.30	7.10	6.10	3.97	3.65	3.36	2.88	2.47
Existing Site Release Flow Q <sub>e</sub> = Pre-Developed Q + Flow Through														
	Q <sub>e100</sub>	Q <sub>e50</sub>	Q <sub>e25</sub>	Q <sub>e10</sub>	Q <sub>e5</sub>									
	55.65	50.34	44.46	39.61	32.98	(cfs)								
Pond Release Flow Q <sub>p</sub> = Pre-Developed Q + Flow Through - Bypass Q														
	Q <sub>p100</sub>	Q <sub>p50</sub>	Q <sub>p25</sub>	Q <sub>p10</sub>	Q <sub>p5</sub>									
	50.46	45.58	40.06	35.85	29.75	(cfs)								
Site Release Flow Q <sub>s</sub> = Pond Release Q <sub>p</sub> + Bypass Q														
	Q <sub>s100</sub>	Q <sub>s50</sub>	Q <sub>s25</sub>	Q <sub>s10</sub>	Q <sub>s5</sub>									
	55.65	50.34	44.46	39.61	32.98	(cfs)								

POND 2 DRAINAGE AREAS				
DA	Pre-Developed Area (AC)	Developed Area (AC)	Bypass Area (AC)	Flow Through Area (AC)
B	17.79			
B-1		5.05		
B-2		7.69		
B-3		1.05	1.06	
B-4		4.98		
OS-1				0.81
TOTAL	17.79	18.77	1.06	0.81

STAGE STORAGE - POND 2			
Elevation (FT)	Pond Surface (SF)	Volume (CF)	Cum. Volume (CF)
550.77	0	0	0
551.00	459	53	53
552.00	11346	5903	5955
553.00	24133	17740	23695
5YR 553.34	28992	9031	32726
10YR 553.49	31135	13541	37235
25YR 553.69	33993	20054	43748
50YR 553.80	35565	23879	47574
100YR 553.99	38280	30894	54589
554.00	38423	31278	54973
555.00	49688	44056	99028
556.00	54453	52071	151099

DETENTION CALCS - POND 2 (100 YR)						
Time (min)	C*K	Intensity, I (in/hr)	Runoff, Q (cfs)	Volume In (CF)	Volume Out (CF)	Storage Req. (CF)
10	0.50	9.80	90.77	54463.5	30275.9	24187.6
15	0.50	9.00	83.36	75026.3	37844.9	37181.4
20	0.50	8.30	76.88	92254.5	45413.9	46840.6
30	0.50	6.90	63.91	115040.3	60551.8	54488.4
40	0.50	5.80	53.72	128934.0	75689.8	53244.2
50	0.50	5.00	46.31	138937.5	90827.7	48109.8
60	0.50	4.50	41.68	150052.5	105965.7	44086.8
70	0.50	4.00	37.05	155610.0	121103.6	34506.4
80	0.50	3.70	34.27	164502.0	136241.6	28260.4
90	0.50	3.50	32.42	175061.3	151379.6	23681.7
100	0.50	3.40	31.49	188955.0	166517.5	22437.5
110	0.50	3.20	29.64	195624.0	181655.5	13968.5
120	0.50	2.70	25.01	180063.0	196793.4	-16730.4
150	0.50	2.40	22.23	200070.0	242207.3	-42137.3



## FLOOD PLAIN CUT/FILL

Existing 100YR WSEL Cut/Fill			
Elevation (FT)	Contour Surface (SF)	Volume (CF)	Cum. Volume (CF)
549.00	162	0	0
550.00	655	409	409
550.64	1180	587	996

Proposed 100YR WSEL Cut/Fill			
Elevation (FT)	Contour Surface (SF)	Volume (CF)	Cum. Volume (CF)
549.00	171	0	0
550.00	665	418	418
550.64	1181	591	1009

## RECORD DRAWINGS

To the best of our knowledge Engineering Concepts & Design, L.P., hereby states that this plan is As-Built. This information provided

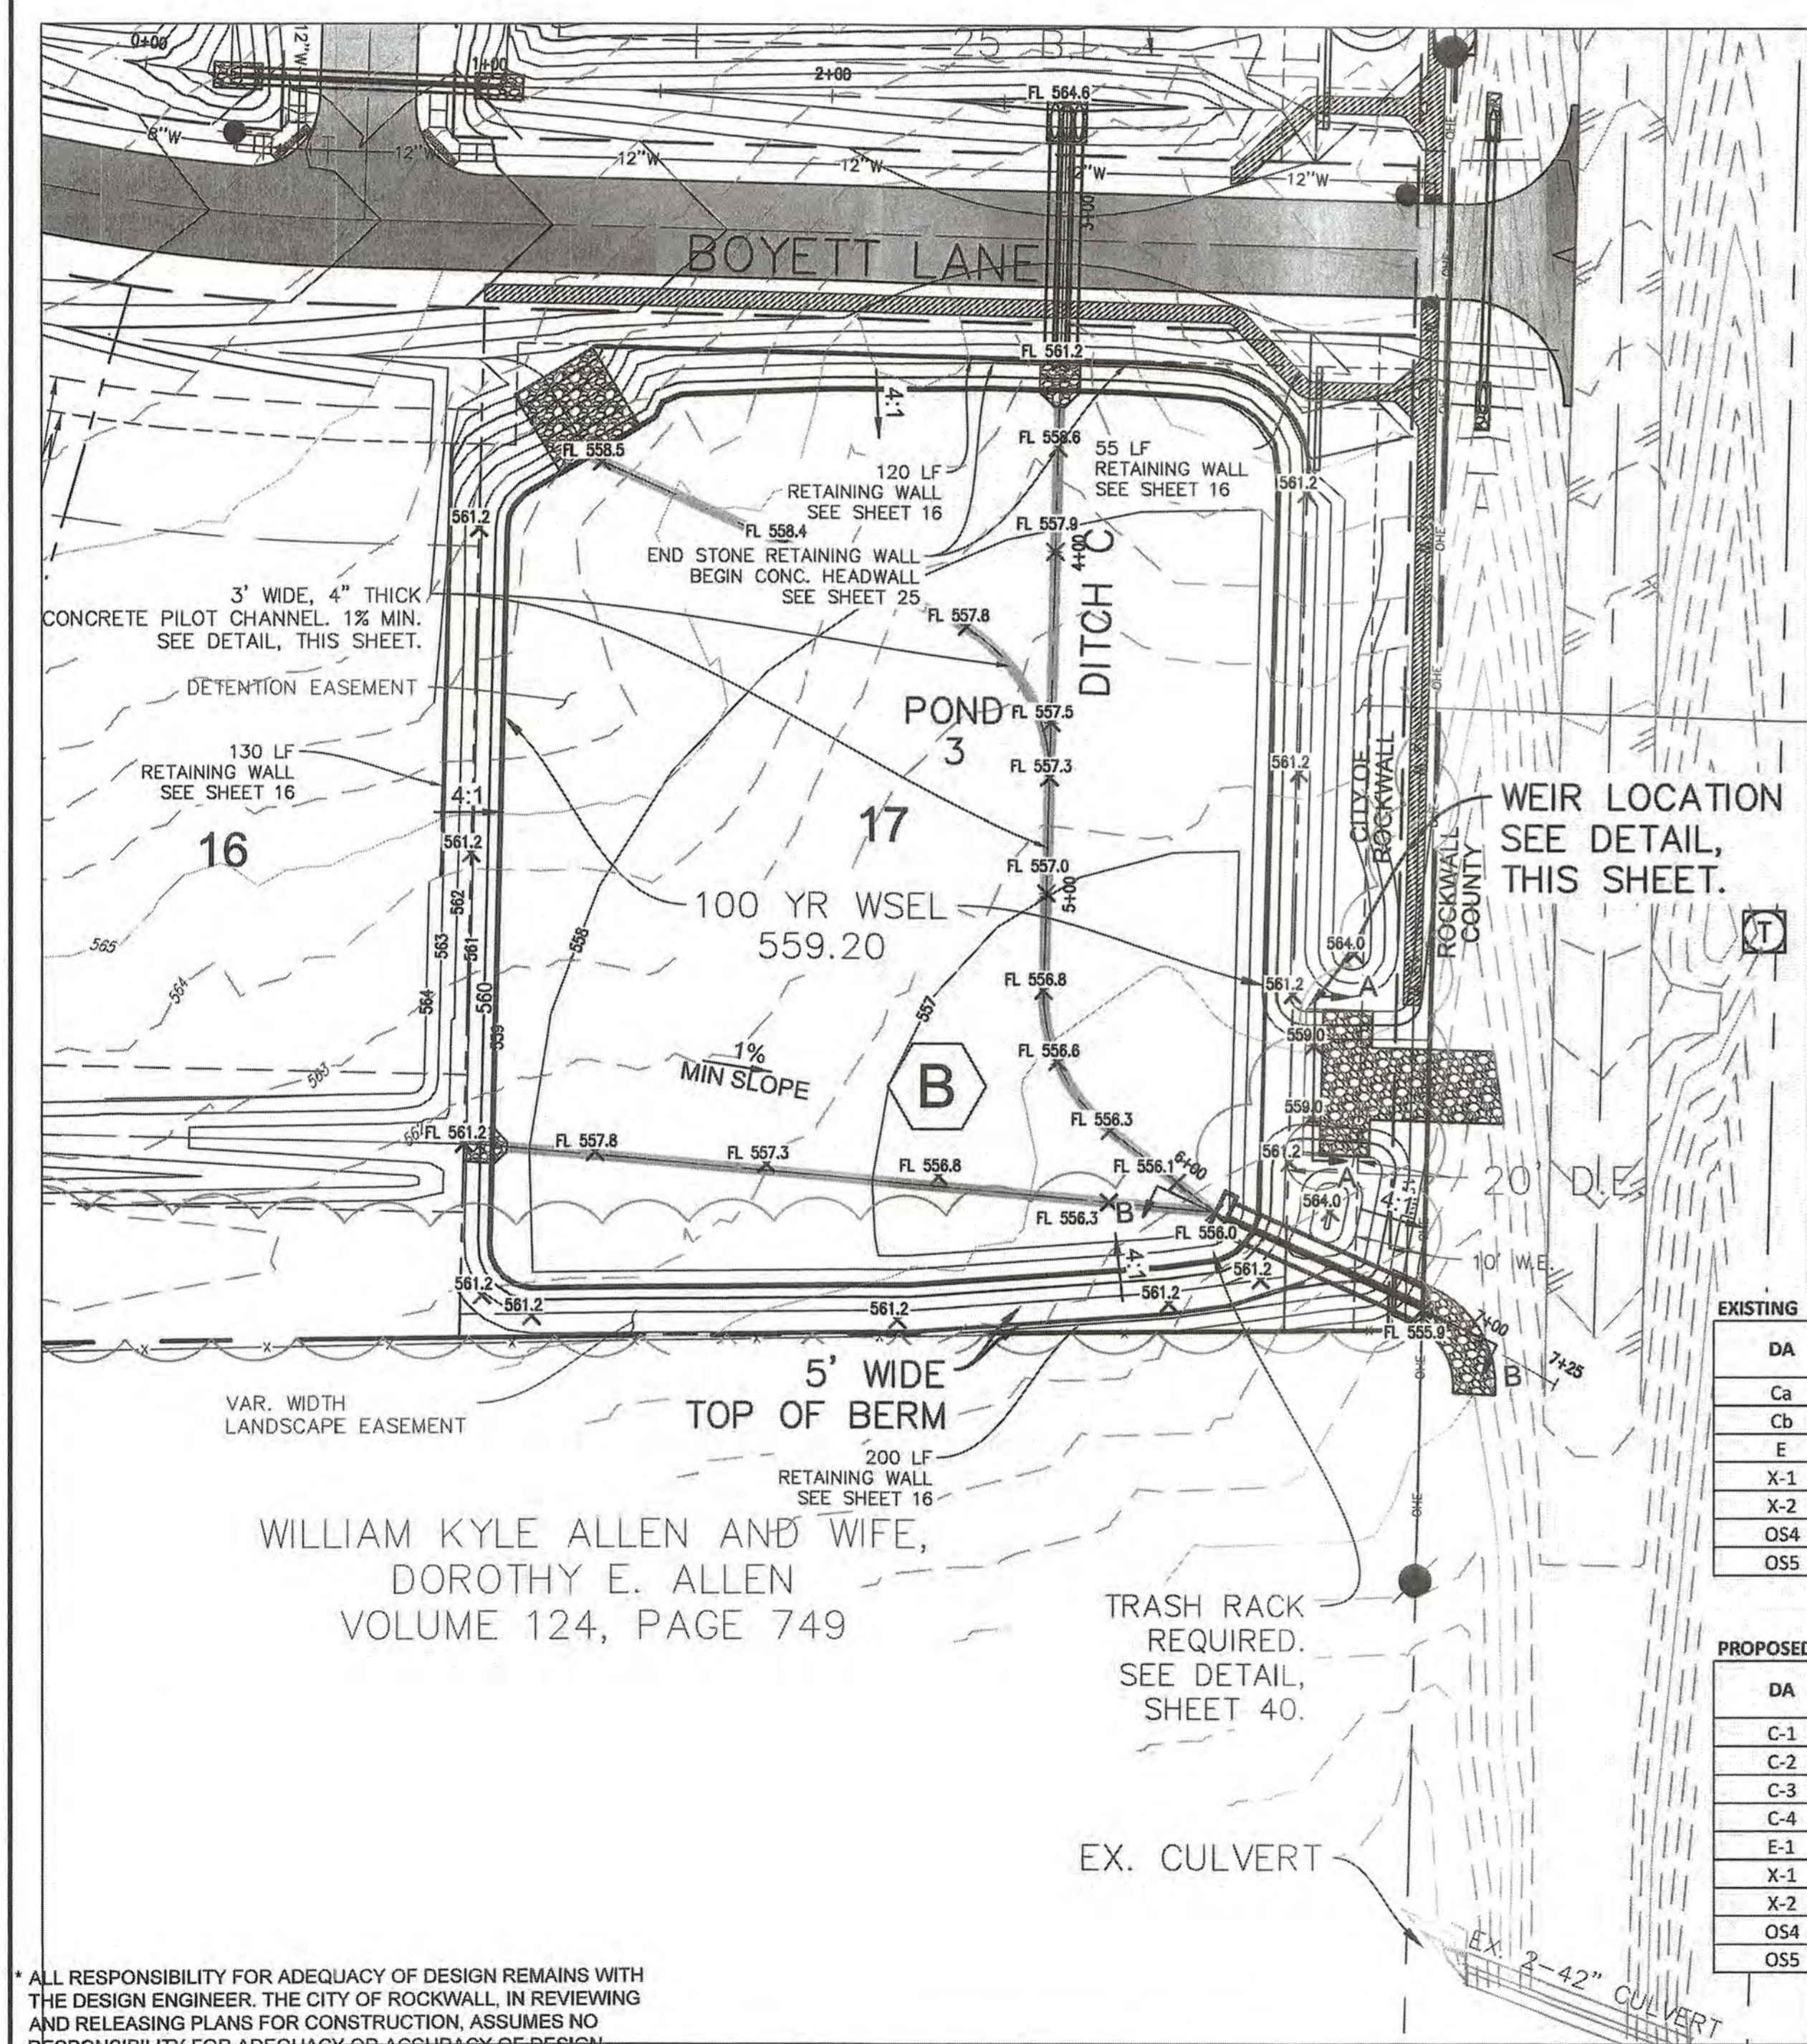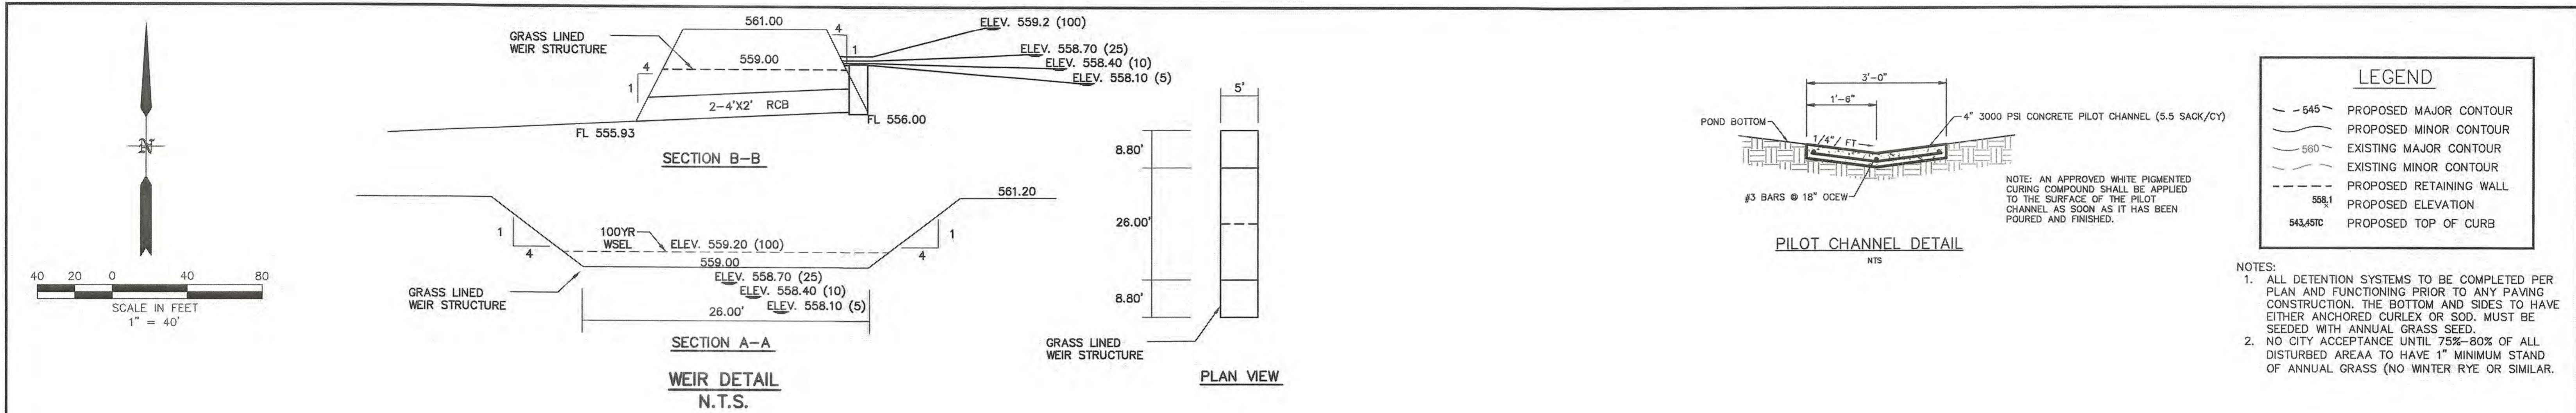

\* ALL RESPONSIBILITY FOR ADEQUACY OF DESIGN REMAINS WITH THE DESIGN ENGINEER. THE CITY OF ROCKWALL, IN REVIEWING AND RELEASING PLANS FOR CONSTRUCTION, ASSUMES NO RESPONSIBILITY FOR ADEQUACY OR ACCURACY OF DESIGN.

CAUTION! EXISTING UTILITIES

CONTRACTOR SHOULD CALL 1-800-DIG-TESS PRIOR TO BEGINNING ANY CONSTRUCTION ACTIVITIES FOR EXISTING UTILITY LOCATIONS. EXISTING UTILITIES AND UNDERGROUND FACILITIES INDICATED ON THESE PLANS HAVE BEEN LOCATED FROM REFERENCE INFORMATION. IT IS THE RESPONSIBILITY OF THE CONTRACTOR TO VERIFY BOTH HORIZONTALLY AND VERTICALLY THE LOCATION OF ALL EXISTING UTILITIES AND UNDERGROUND FACILITIES PRIOR TO CONSTRUCTION AND TO TAKE NECESSARY PRECAUTIONS IN ORDER TO PROTECT ALL FACILITIES ENCOUNTERED. THE CONTRACTOR SHALL PRESERVE AND PROTECT ALL EXISTING UTILITIES FROM DAMAGE DURING CONSTRUCTION.

BM-1: "PK" Nail on the south side of Clem Road, approximately 2275' west of the centerline intersection of Clem Road and FM 3549 Elev.: 559.07'

BM-2: "PK" Nail in Clem Road, approximately 175' west of the centerline intersection of Clem Road and FM 3549 Elev.: 584.83'

ENGINEERINGCONCEPTS & DESIGN, L.P.

ENGINEERING / PROJECT MANAGEMENT / CONSTRUCTION SERVICES - FIRM REG. #F-001145 201 WINDCO CIR, STE 200, WYLLIE, TX 75098 972-941-8400 FAX: 972-941-8401 WWW.ECDLP.COM

REVISIONS:

DRAWN: MJH DATE: 6/1/2020

CHECKED: RCK DATE: 6/1/2020

PROJECT NO.: 08838

DWG FILE NAME: 08838 DET.DWG

THIS DOCUMENT IS RELEASED FOR THE PURPOSE OF CONSTRUCTION. THE SEAL APPEARING ON THIS DOCUMENT WAS AUTHORIZED BY RYAN C. KING, P.E. 123635



DETENTION POND 3

NORTHGATE

CITY OF ROCKWALL, ROCKWALL COUNTY, TEXAS

SHEET 22 OF 40

Storm Event	Peak Discharges (cfs)*				
	Pre (1)	Post No Pond (2)	Post w/pond (3)	(2) - (1)	(3) - (1)
5-Year	249.1	280.1	246.5	31	-2.6
10-Year	305.4	341.5	294.1	36.1	-11.3
25-Year	362	403	341.8	41	-20.2
100-Year	468.5	518.5	441	50	-27.5

Storm Event	Peak Storage (ac-ft)	Peak Elevation (ft)
5-Year	0.80	558.1
10-Year	1.10	558.4
25-Year	1.40	558.7
100-Year	2.00	559.2

WQv Orifice Flow

$$Q = C_a \sqrt{2gh}$$

FL = 556.00  
Corfice = 0.60

Weir Flow

$$Q = CLh^{3/2}$$

Cweir = 2.7

Water Surface Elevation	WQv Orifice						Weir - Outfall structure				Weir - Spillway				Cum. volume (ac-ft)	Total Discharge (cfs)
	Centroid	depth (ft.)	width (ft.)	Area (sq ft)	Head (feet)	Discharge (cfs)	Crest	Length (feet)	Head (feet)	Discharge (cfs)	Crest	Length (feet)	Head (feet)	Discharge (cfs)		
556.00	556.50	1.00	12.00	12.0000	0.00	0.00									0.00	0.00
556.50	556.50	1.00	12.00	12.0000	0.00	0.00									0.06	0.00
557.00	556.50	1.00	12.00	12.0000	0.50	40.86									0.11	40.86
557.50	556.50	1.00	12.00	12.0000	1.00	57.78									0.39	57.78
558.00	556.50	1.00	12.00	12.0000	1.50	70.77									0.66	70.77
558.50	556.50	1.00	12.00	12.0000	2.00	81.71	558.20	12.00	0.3000	5.32					1.20	87.04
559.00	556.50	1.00	12.00	12.0000	2.50	91.36	558.20	12.00	0.8000	23.18	559.00	26.00	0.00	0.00	1.74	114.54
559.20	556.50	1.00	12.00	12.0000	2.70	94.94	558.20	12.00	1.0000	32.40	559.00	26.00	0.20	6.28	2.00	133.62
559.50	556.50	1.00	12.00	12.0000	3.00	100.08	558.20	12.00	1.3000	48.02	559.00	26.00	0.50	24.82	2.41	172.92
560.00	556.50	1.00	12.00	12.0000	3.50	108.10	558.20	12.00	1.8000	78.24	559.00	26.00	1.00	70.20	3.08	256.54
560.50	556.50	1.00	12.00	12.0000	4.00	115.56	558.20	12.00	2.3000	113.02	559.00	26.00	1.50	128.97	3.80	357.54
561.00	556.50	1.00	12.00	12.0000	4.50	122.57	558.20	12.00	2.8000	151.80	559.00	26.00	2.00	198.56	4.51	472.93

DA	DA Area (ac)	DA Area (sq mi)	LU Area 1			LU Area 2			LU Area 3			Weighted CN	Weighted CN
			Description	Area (ac)	CN	Description	Area (ac)	CN	Description	Area (ac)	CN		
Ca	20.85	0.032583	Open Space/Range/Pasture (OSg)	20.85	80							80.00	90.20
Cb	1.64	0.002563	Wooded (Wg)	1.64	77							77.00	88.51
E	3.95	0.006178	Open Space/Range/Pasture (OSg)	3.95	80							80.00	90.20
X-1	1.28	0.001992	Paved Roads, R.O.W. (Rp)	1.28	93							93.00	96.83
X-2	0.36	0.000567	Paved Roads, R.O.W. (Rp)	0.36	93							93.00	96.83
OS4	0.58	0.000911	Open Space/Range/Pasture (OSg)	0.58	80							80.00	90.20
OS5	40.95	0.063985	Open Space/Range/Pasture (OSg)	30.00	80	Residential (R20)	8.12	86	Paved Roads, R.O.W. (Rp)	2.83	93	82.09	91.33

DA	DA Area (ac)	DA Area (sq mi)	LU Area 1			LU Area 2			LU Area 3			Weighted CN	Weighted CN
			Description	Area (ac)	CN	Description	Area (ac)	CN	Description	Area (ac)	CN		
C-1	10.55	0.016490	Residential (R20)	8.79	86	Inundated (W)	1.76	100				88.34	94.57
C-2	9.53	0.014885	Residential (R30)	9.53	87							87.00	93.90
C-3	4.90	0.007653	Residential (R20)	4.90	86							86.00	93.39
C-4	1.64	0.002563	Wooded (Wg)	1.64	77							77.00	88.51
E-1	2.34	0.003650	Residential (R20)	2.34	86							86.00	93.39
X-1	1.28	0.001992	Paved Roads, R.O.W. (Rp)	1.28	93							93.00	96.83
X-2	0.36	0.000567	Paved Roads, R.O.W. (Rp)	0.36	93							93.00	96.83
OS4	0.58	0.000911	Open Space/Range/Pasture (OSg)	0.58	80							80.00	90.20
OS5	40.95	0.063985	Open Space/Range/Pasture (OSg)	30.00	80	Residential (R20)	8.12	86	Paved Roads, R.O.W. (Rp)	2.83	93	82.09	91.33



- NOTES:
- 4200 PSI CONCRETE FOR ENTIRE STRUCTURE. 7.0 SACK/CY MIN.
  - DOUBLE #4 BARS @ 12" O.C.E.W. FOR WALLS AND BASE WITH MINIMUM 3" COVER.
  - SINGLE #4 BARS @ 12" O.C.E.W. FOR TOP.
  - 30" MH LID ON TOP, CENTERED IN STRUCTURE.
  - TRASH RACK REQUIRED. SEE DETAIL, SHEET 39.

RELEASED FOR CONSTRUCTION

ALL RESPONSIBILITY FOR ADEQUACY OF DESIGN OF DETENTION POND 3, IN REVIEWING AND RELEASING PLANS FOR CONSTRUCTION, ASSUMES NO RESPONSIBILITY FOR ADEQUACY OR ACCURACY OF DESIGN.

CITY \_\_\_\_\_ DATE \_\_\_\_\_

\*REFER TO NORTHGATE STORMWATER DETENTION ANALYSIS PREPARED BY NATHAN D. MAIER CONSULTING ENGINEERS, INC. DATED MAY 2020

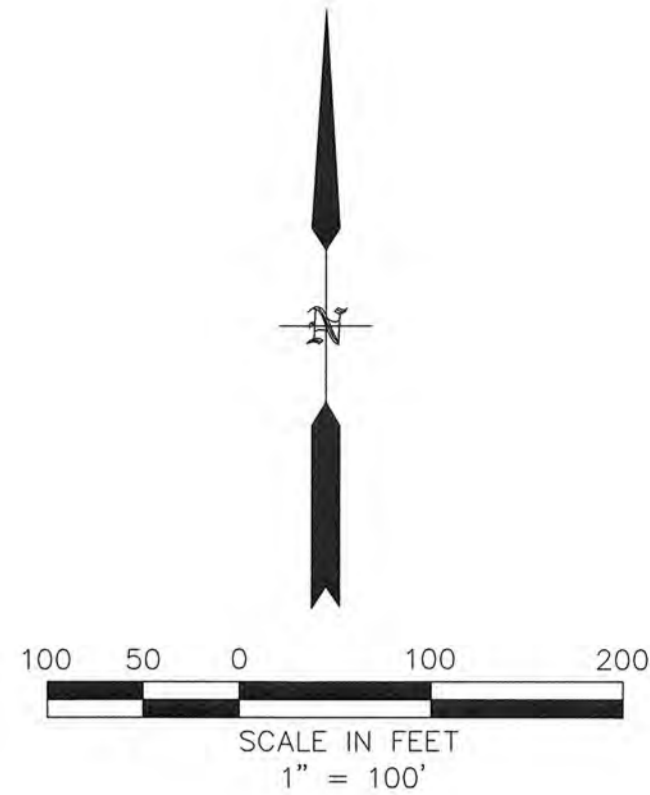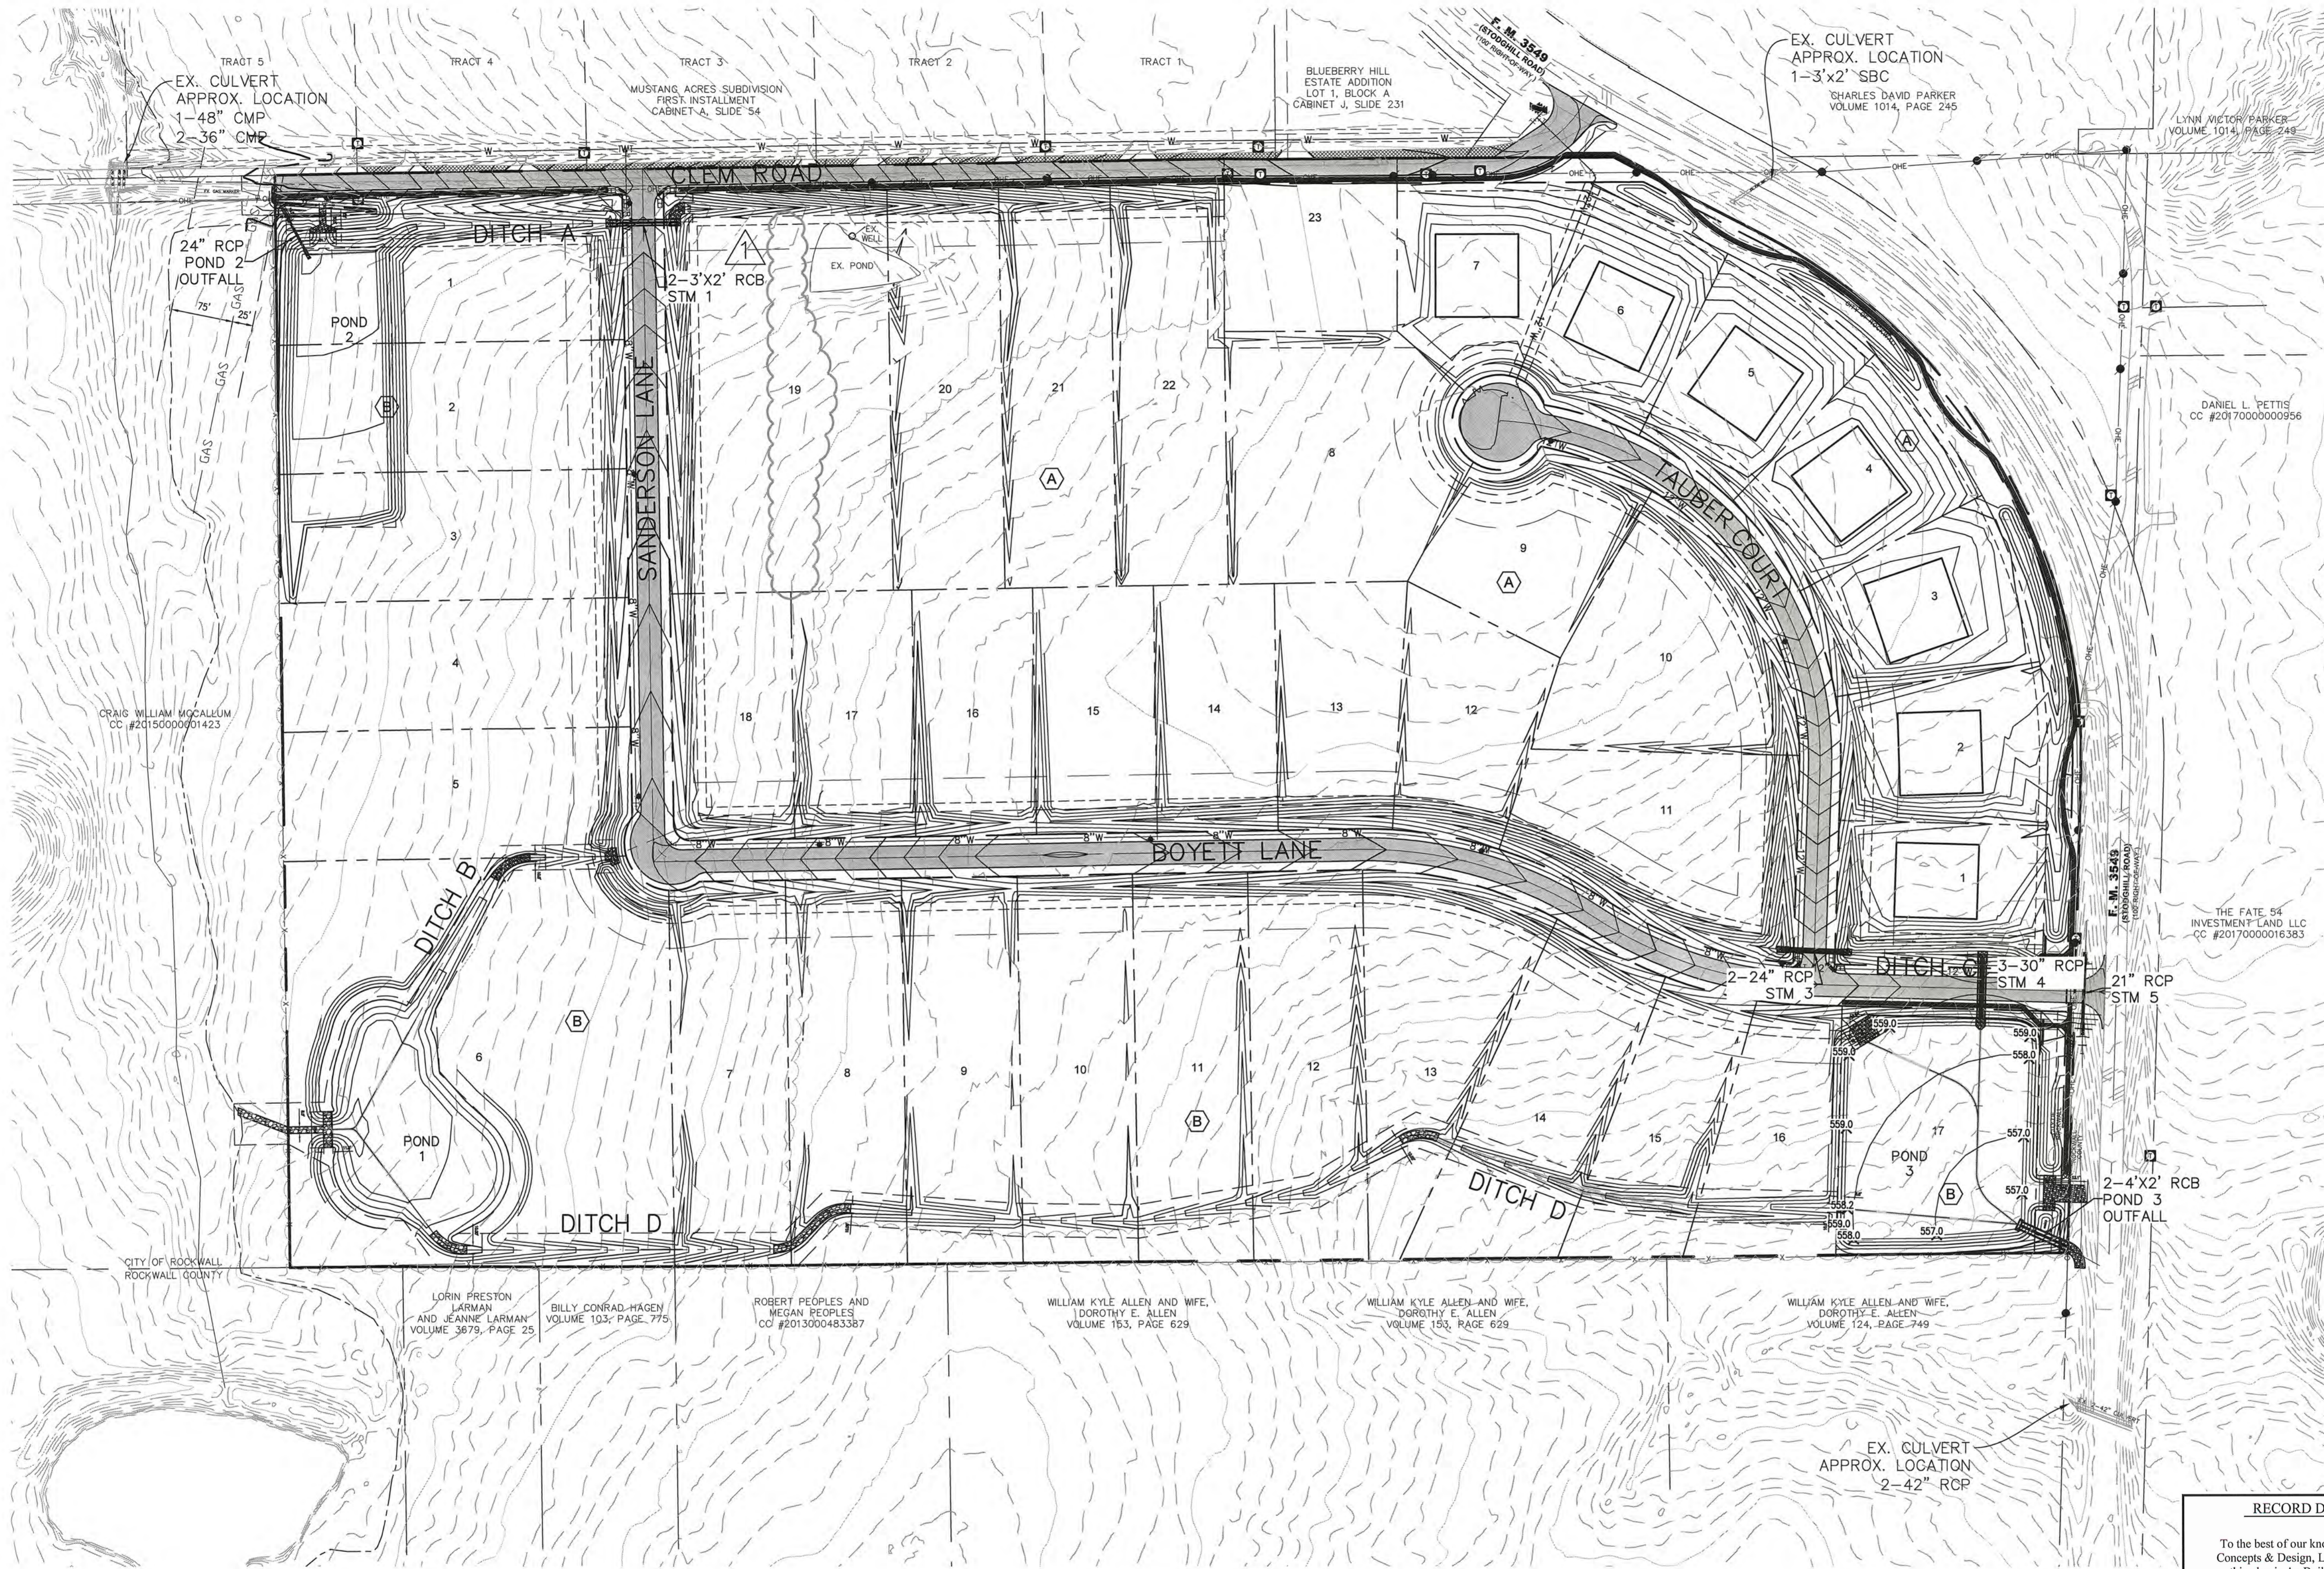


LEGEND	
~545~	PROPOSED MAJOR CONTOUR
~550~	PROPOSED MINOR CONTOUR
~560~	EXISTING MAJOR CONTOUR
~570~	EXISTING MINOR CONTOUR
----	RETAINING WALL

\*ALL RESPONSIBILITY FOR ADEQUACY OF DESIGN REMAINS WITH THE DESIGN ENGINEER. THE CITY OF ROCKWALL, IN REVIEWING AND RELEASING PLANS FOR CONSTRUCTION, ASSUMES NO RESPONSIBILITY FOR ADEQUACY OR ACCURACY OF DESIGN.

RECORD DRAWINGS

To the best of our knowledge Engineering Concepts & Design, L.P., hereby states that this plan is As-Built. This information provided is based on surveying at the site and information provided by the contractor.

1/27/2021  
RYAN C. KINGDATE

**CAUTION! EXISTING UTILITIES**  
CONTRACTOR SHOULD CALL 1-800-DIG-BEFORE BEGINNING ANY CONSTRUCTION ACTIVITIES FOR EXISTING UTILITY LOCATIONS. EXISTING UTILITIES AND UNDERGROUND FACILITIES INDICATED ON THESE PLANS HAVE BEEN LOCATED FROM REFERENCE INFORMATION. IT IS THE RESPONSIBILITY OF THE CONTRACTOR TO VERIFY BOTH HORIZONTALLY AND VERTICALLY THE LOCATION OF ALL EXISTING UTILITIES AND UNDERGROUND FACILITIES PRIOR TO CONSTRUCTION AND TO TAKE NECESSARY PRECAUTIONS IN ORDER TO PROTECT ALL UTILITIES ENCOUNTERED. THE CONTRACTOR SHALL PRESERVE AND PROTECT ALL EXISTING UTILITIES FROM DAMAGE DURING CONSTRUCTION.

BM-1: "PK" Nail on the south side of Clem Road, approximately 2275' west of the centerline intersection of Clem Road and FM 3549  
Elev.: 559.07'  
  
BM-2: "PK" Nail in Clem Road, approximately 175' west of the centerline intersection of Clem Road and FM 3549  
Elev.: 584.83'

ENGINEERINGCONCEPTS  
& DESIGN, L.P.

ENGINEERING / PROJECT MANAGEMENT /  
CONSTRUCTION SERVICES - FIRM REG. #F-001145  
201 WINDCO CIR, STE 200, WYLIE, TX 75098  
972-941-8400 FAX: 972-941-8401 WWW.ECDLP.COM


REVISIONS:	
1/25/2021 COMBINED LOTS A19 & A20	
DRAWN: MJH	DATE:
CHECKED: RCK	DATE: 6/1/2020
PROJECT NO.: 08838	
DWG FILE NAME: 08838.ST.DWG	

THIS DOCUMENT IS RELEASED FOR THE PURPOSE OF CONSTRUCTION. THE SEAL APPEARING ON THIS DOCUMENT WAS AUTHORIZED BY RYAN C. KING, P.E. 123635




OVERALL STORM PLAN  
  
NORTHGATE  
CITY OF ROCKWALL, ROCKWALL COUNTY, TEXAS

SHEET  
23  
OF  
40


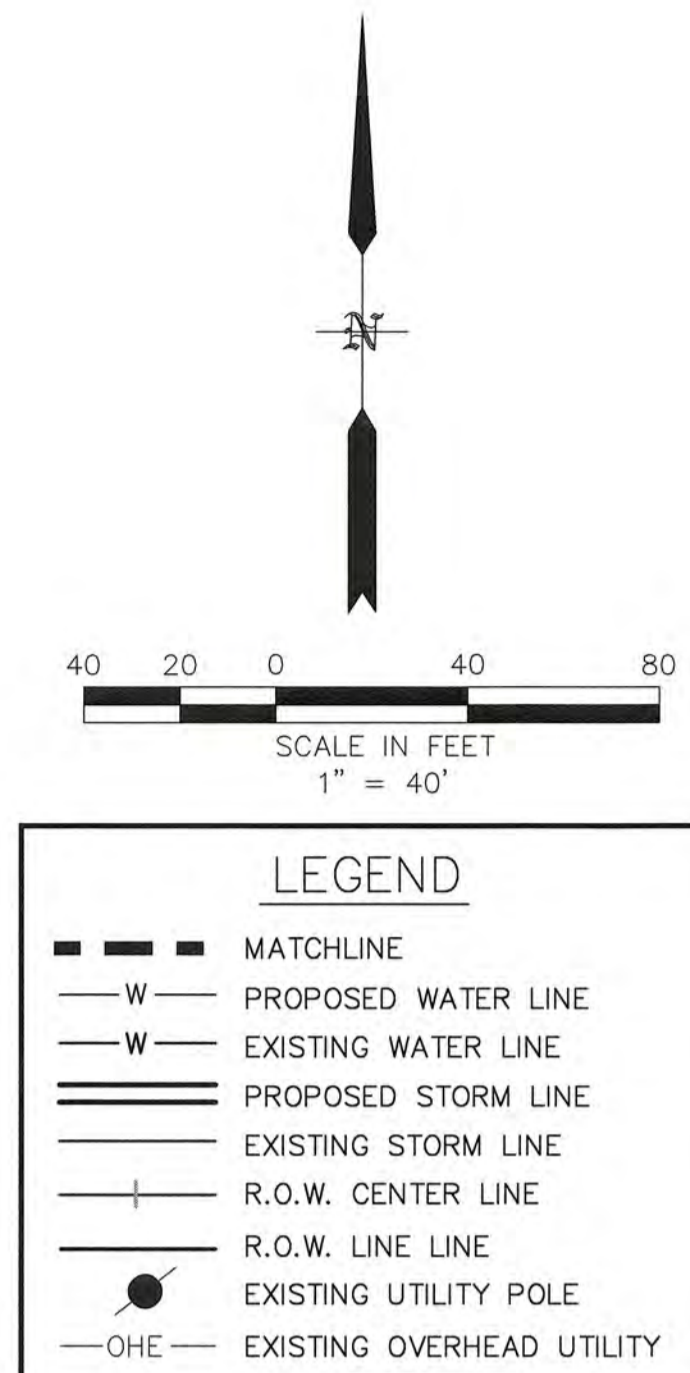



ALL RCP PIPE TO BE  
CLASS III UNLESS  
OTHERWISE NOTED.

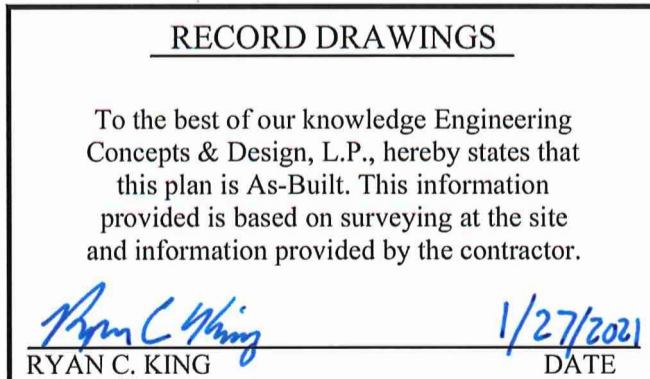

PROFILE VERTICAL  
SCALE: 1"=5'

SHEET  
24  
OF  
40

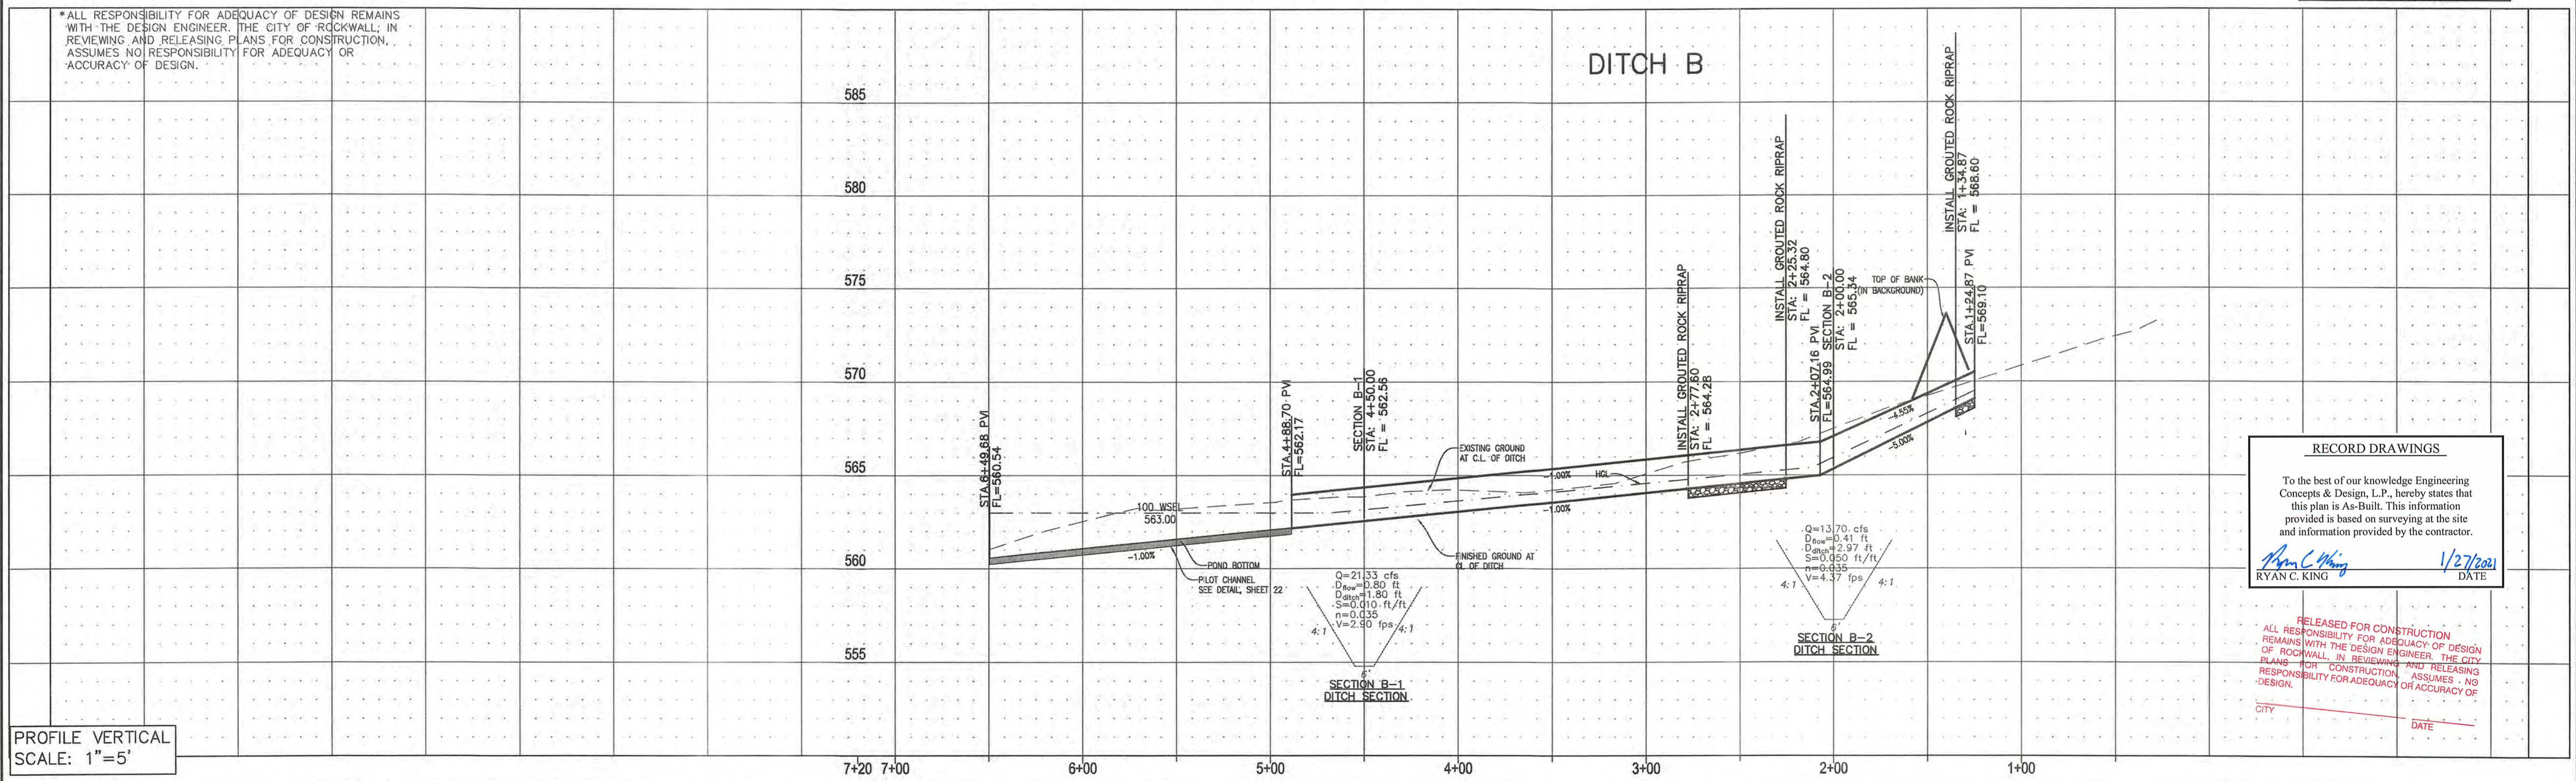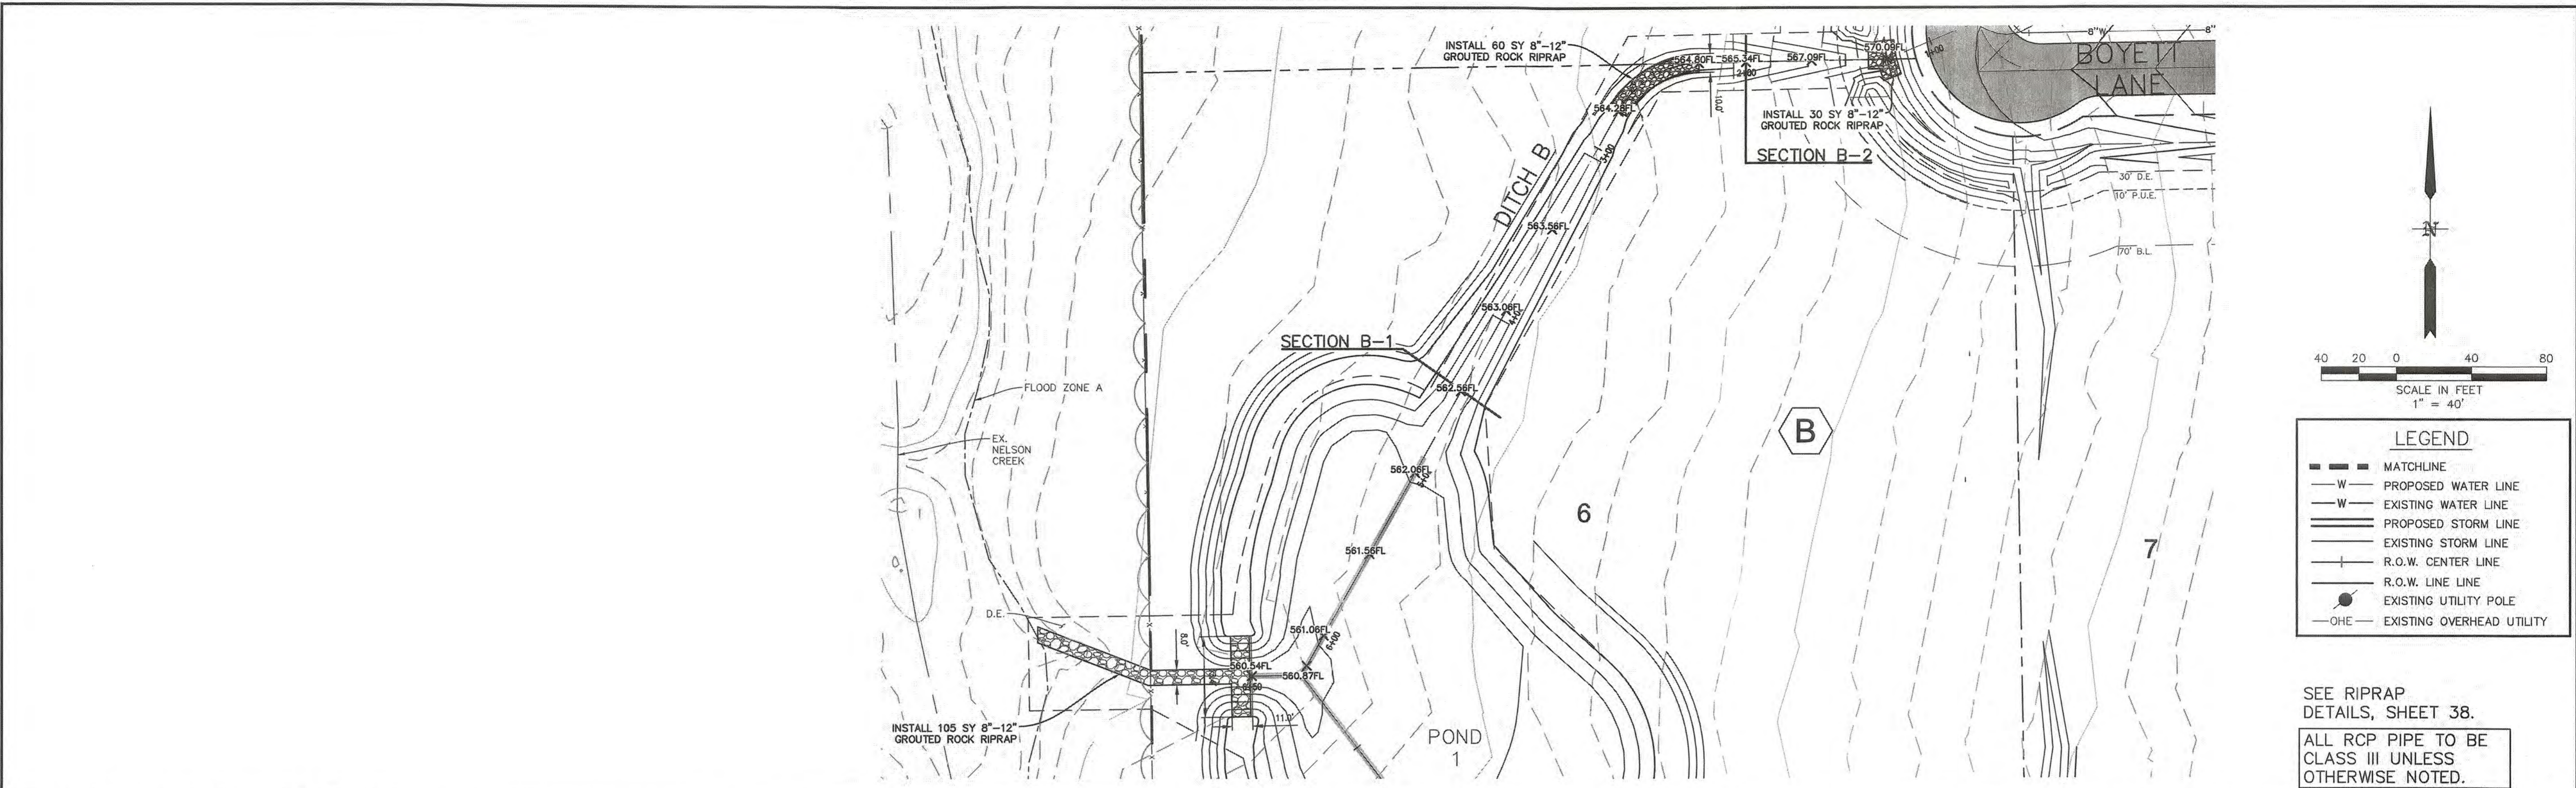

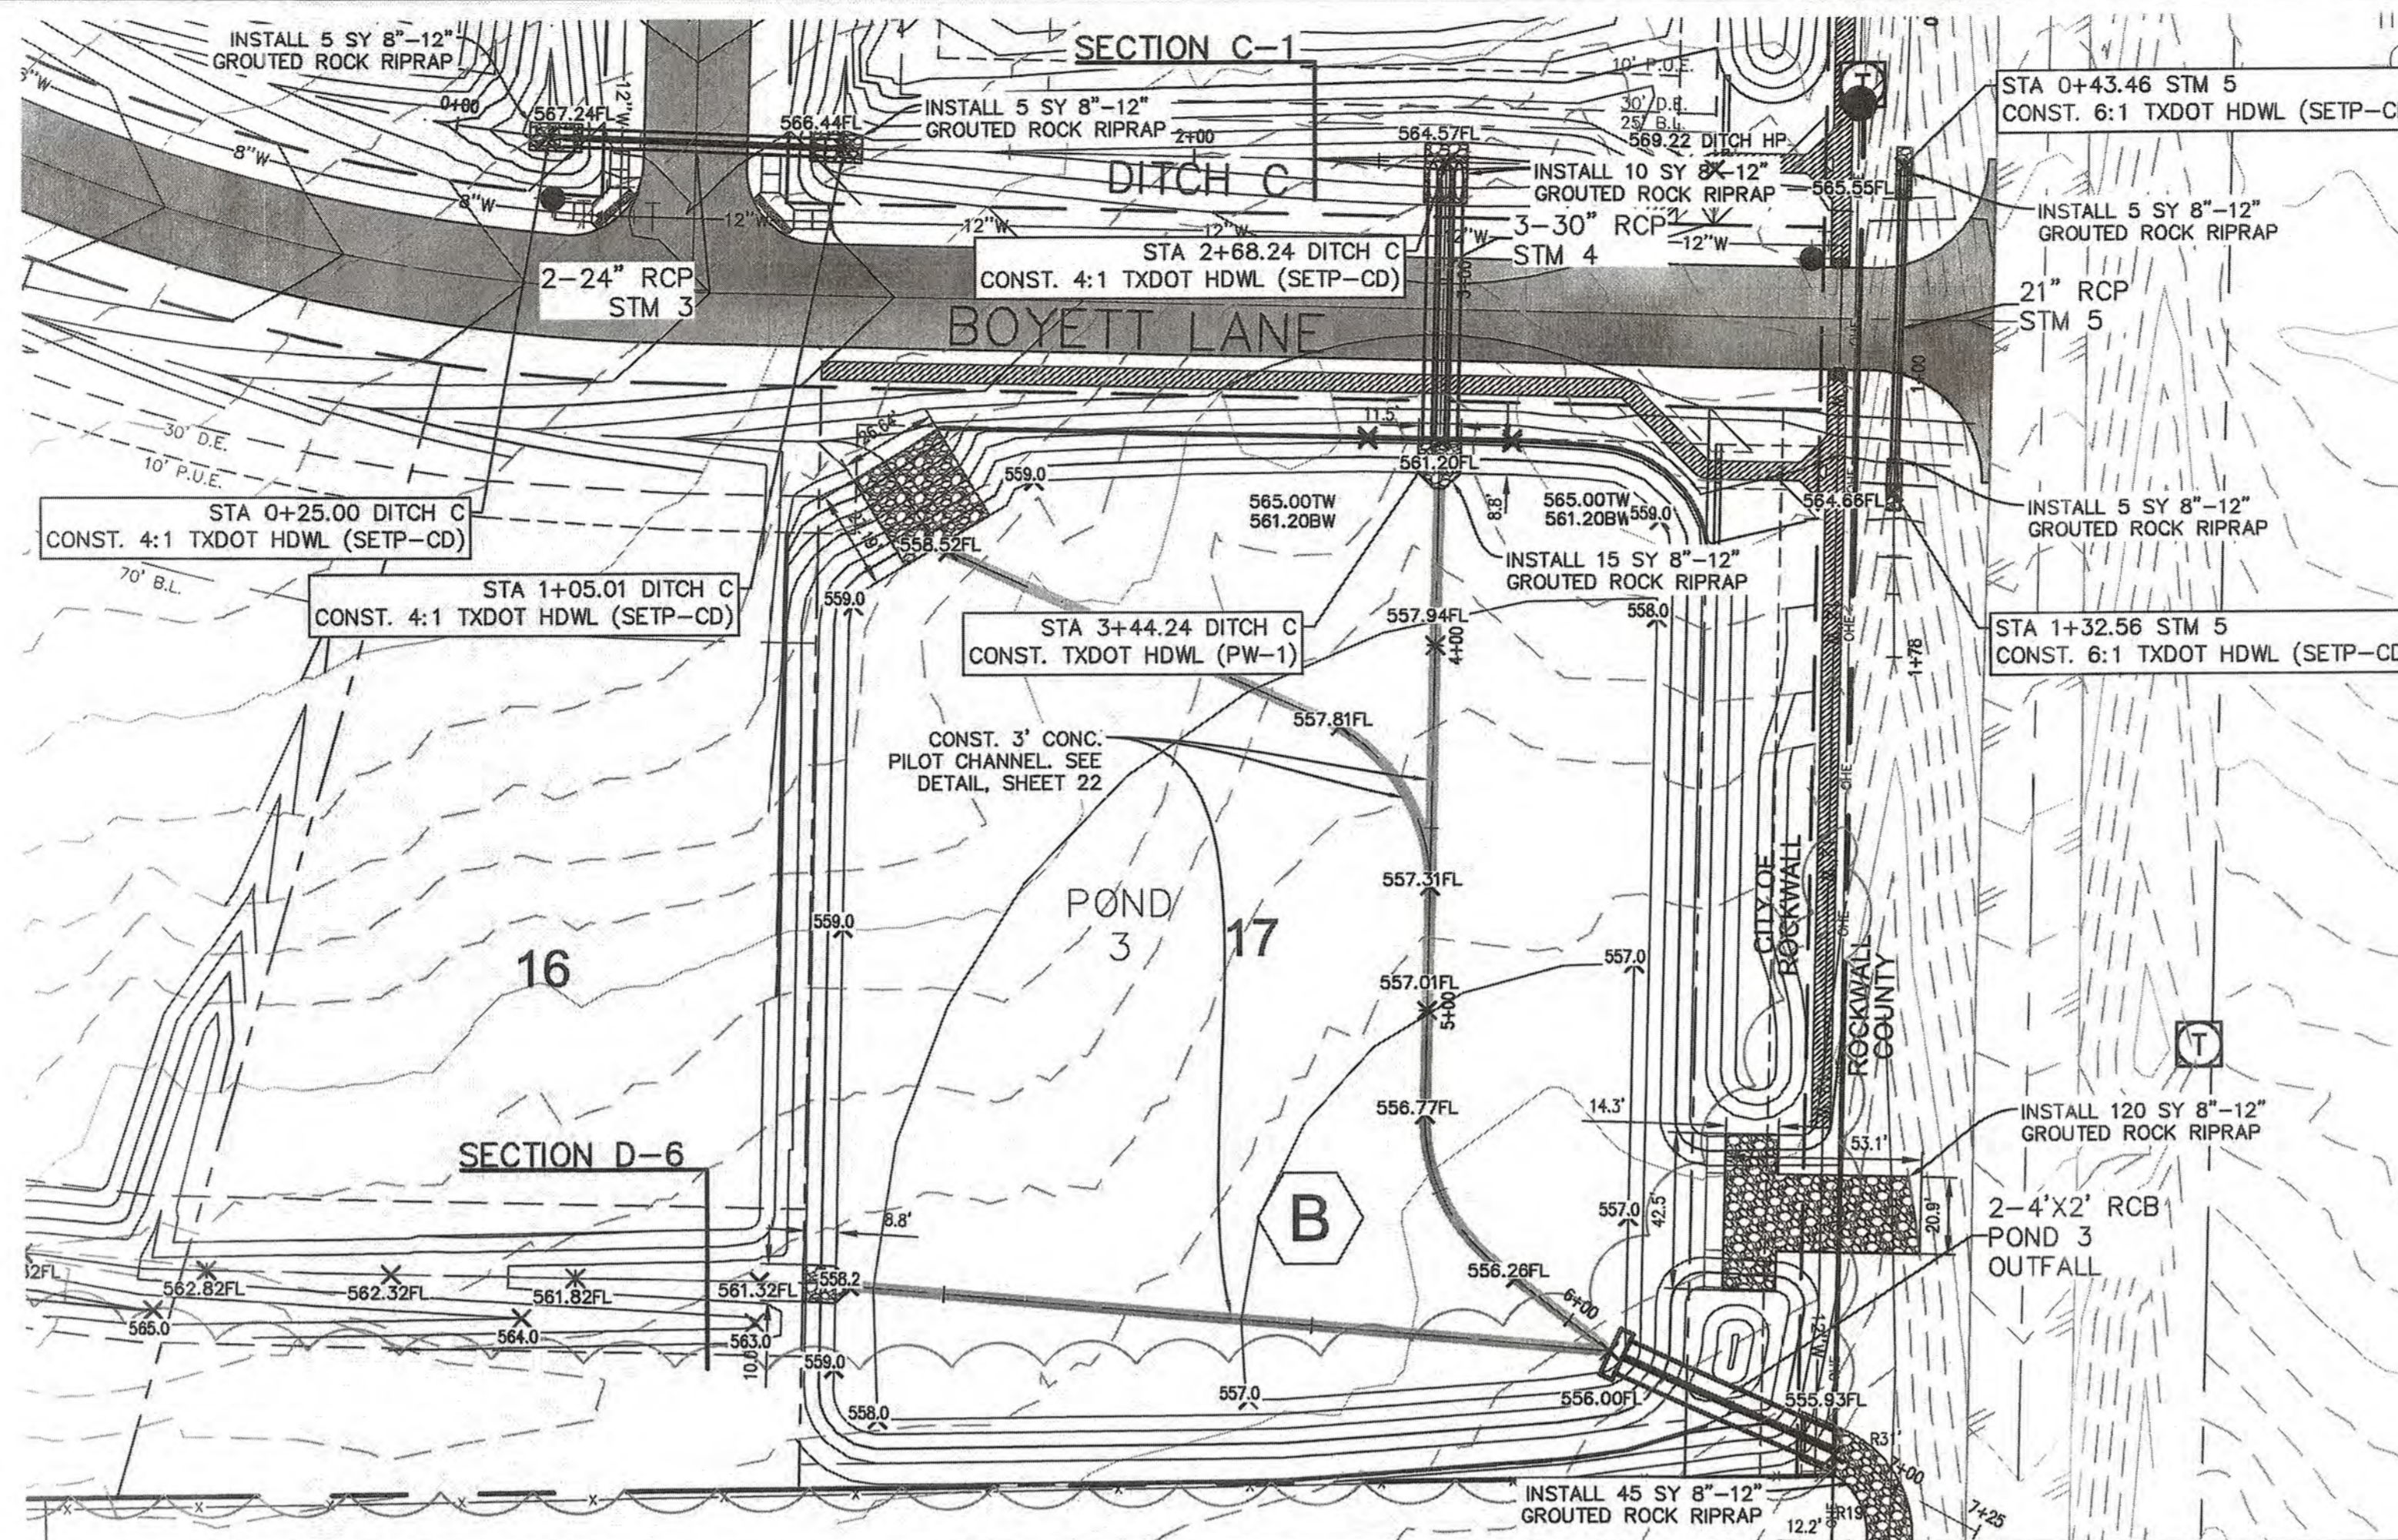


LEGEND

---	MATCHLINE
W	PROPOSED WATER LINE
W	EXISTING WATER LINE
---	PROPOSED STORM LINE
---	EXISTING STORM LINE
+	R.O.W. CENTER LINE
+	R.O.W. LINE LINE
●	EXISTING UTILITY POLE
—O—	EXISTING OVERHEAD UTILITY

SEE RIPRAP  
DETAILS, SHEET 38.

ALL RCP PIPE TO BE  
CLASS III UNLESS  
OTHERWISE NOTED.

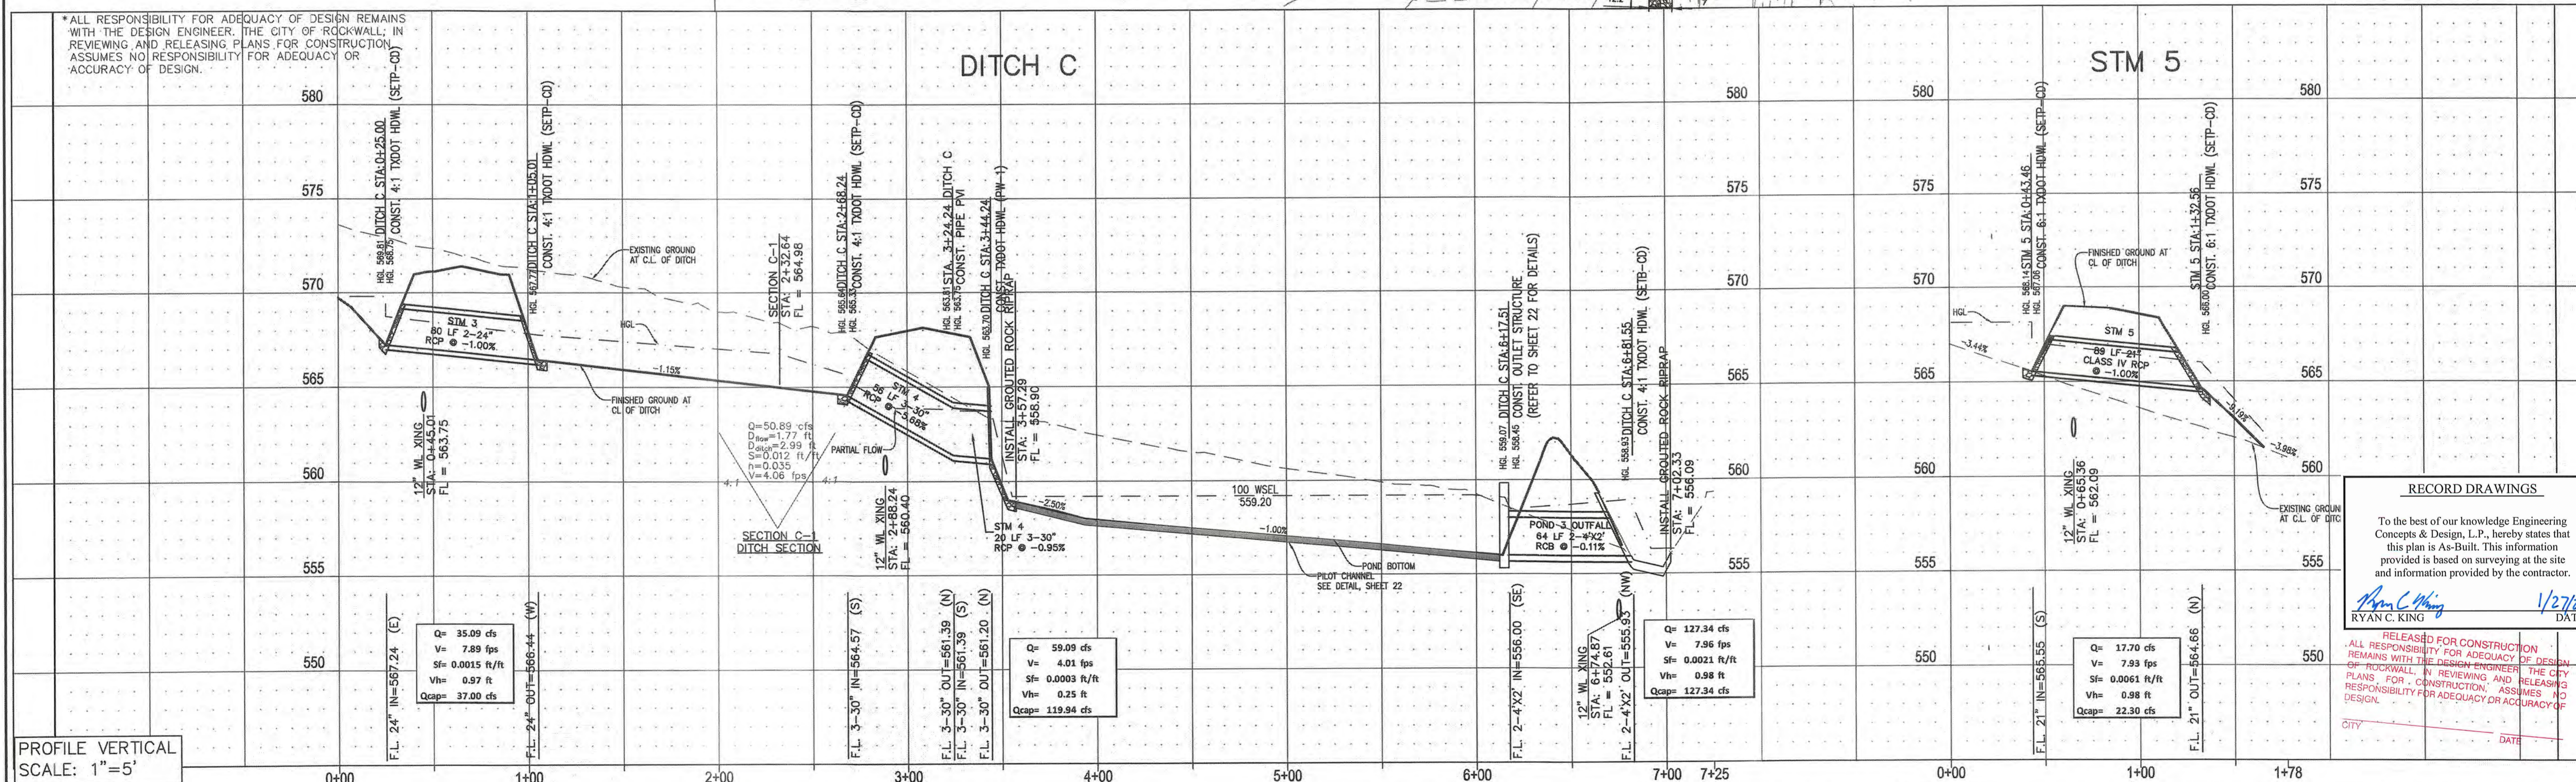

PROFILE VERTICAL  
SCALE: 1"=5'

RECORD DRAWINGS

To the best of our knowledge Engineering Concepts & Design, L.P., hereby states that this plan is As-Built. This information provided is based on surveying at the site and information provided by the contractor.

*Ryan C. King*  
RYAN C. KING  
1/27/2021  
DATE

RELEASED FOR CONSTRUCTION  
REMAINS WITH THE DESIGN ENGINEER  
OF ROCKWALL, IN REVIEWING AND RELEASING  
PLANS, FOR CONSTRUCTION, ASSUMES NO  
RESPONSIBILITY FOR ADEQUACY OR ACCURACY OF  
DESIGN.

CITY \_\_\_\_\_ DATE \_\_\_\_\_

CAUTION! EXISTING UTILITIES

CONTRACTOR SHOULD CALL 1-800-565-7888 PRIOR TO BEGINNING ANY CONSTRUCTION ACTIVITIES FOR EXISTING UTILITY LOCATIONS. EXISTING UTILITIES AND UNDERGROUND FACILITIES INDICATED ON THESE PLANS HAVE BEEN LOCATED FROM REFERENCE INFORMATION. IT IS THE RESPONSIBILITY OF THE CONTRACTOR TO VERIFY BOTH HORIZONTALLY AND VERTICALLY THE LOCATION OF ALL EXISTING UTILITIES AND UNDERGROUND FACILITIES PRIOR TO CONSTRUCTION AND TO TAKE NECESSARY PRECAUTIONS IN ORDER TO PROTECT ALL FACILITIES ENCOUNTERED. THE CONTRACTOR SHALL PRESERVE AND PROTECT ALL EXISTING UTILITIES FROM DAMAGE DURING CONSTRUCTION.

BM-1: "PK" Nail on the south side of Clem Road, approximately 227' west of the centerline intersection of Clem Road and FM 3549 Elev.: 559.07'

BM-2: "PK" Nail in Clem Road, approximately 175' west of the centerline intersection of Clem Road and FM 3549 Elev.: 584.83'

**ENGINEERINGCONCEPTS**  
& DESIGN, L.P.

ENGINEERING / PROJECT MANAGEMENT /  
CONSTRUCTION SERVICES - FIRM REG. #F-001145  
201 WINDCO CIR, STE 200, WYLIE, TX 75098  
972-941-8400 FAX: 972-941-8401 WWW.ECDLP.COM

REVISIONS:

DRAWN: MJH	DATE: 6/1/2020
CHECKED: RCK	DATE: 6/1/2020
PROJECT NO.: 08838	
DWG FILE NAME: 08838 ST.DWG	

THIS DOCUMENT IS RELEASED FOR  
THE PURPOSE OF CONSTRUCTION.  
THE SEAL APPEARING ON THIS DOCUMENT WAS  
AUTHORIZED BY RYAN C. KING, P.E. 123635





**STORM PLAN - DITCH C**

**NORTHGATE**

CITY OF ROCKWALL, ROCKWALL COUNTY, TEXAS

SHEET  
26  
OF  
40

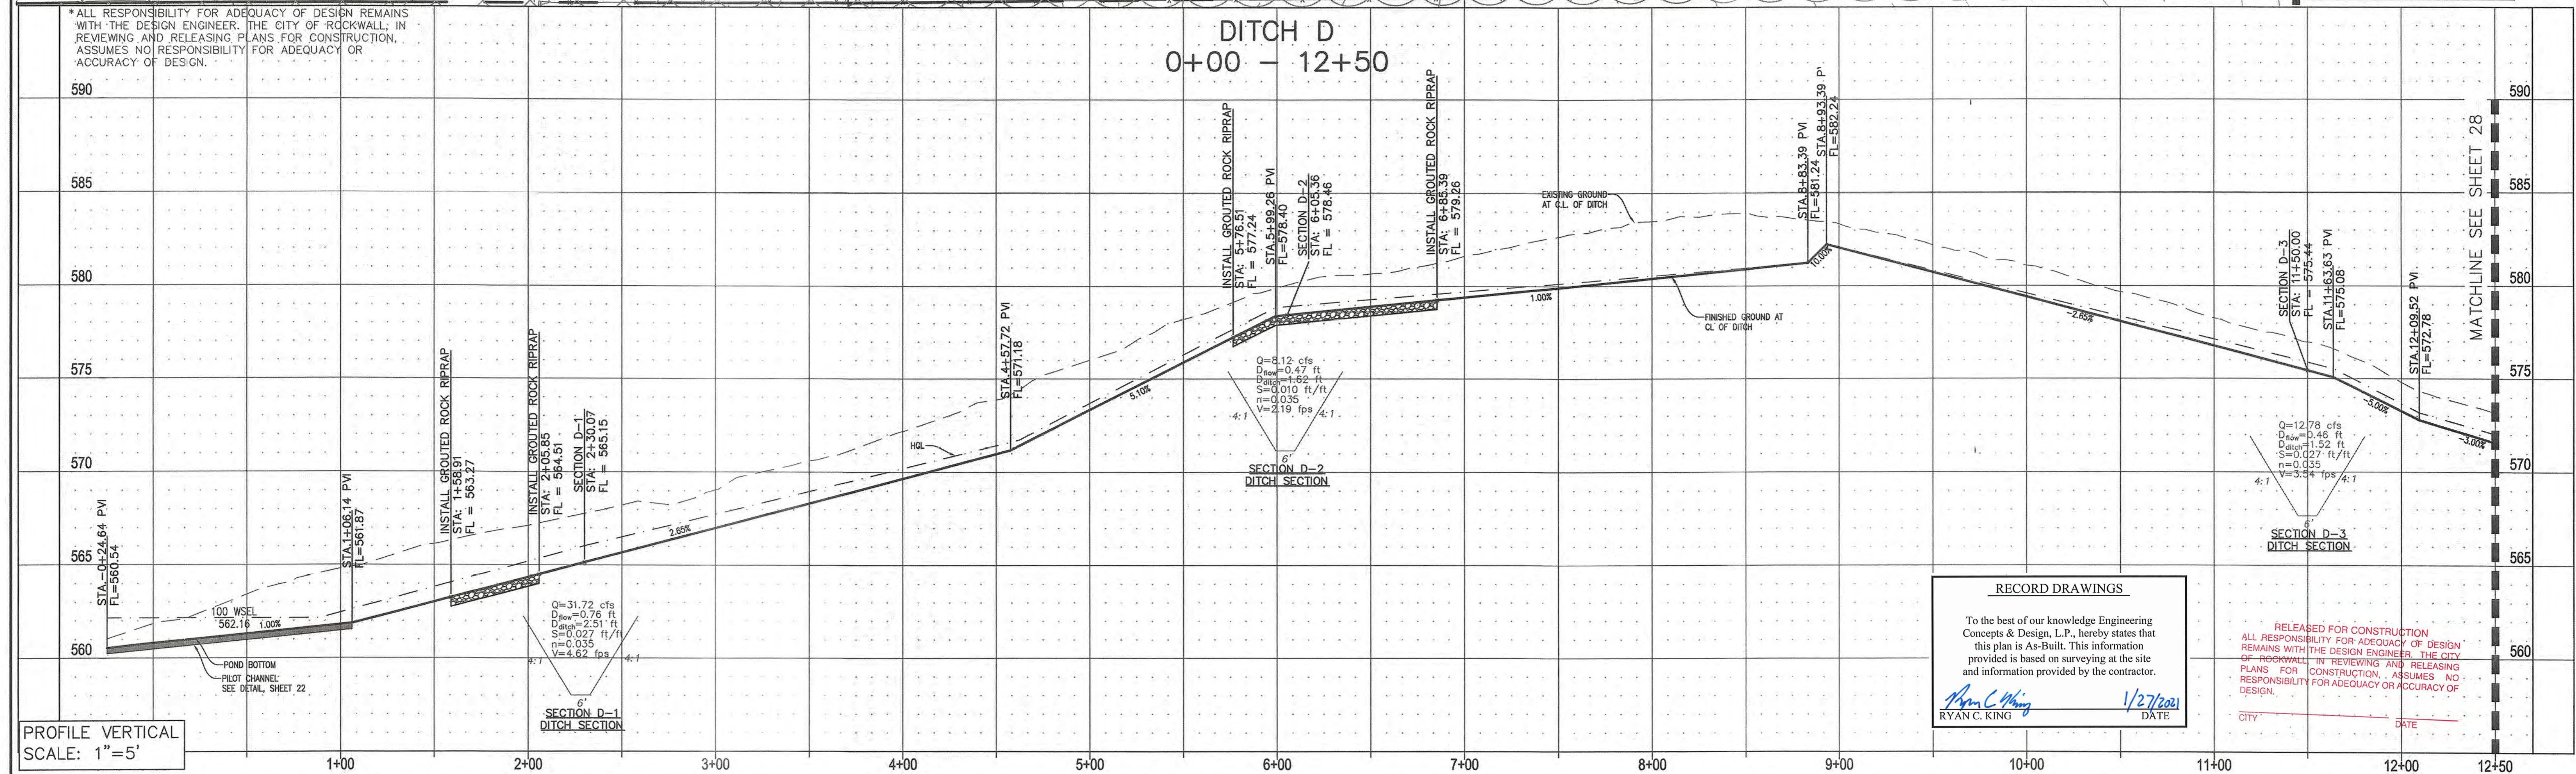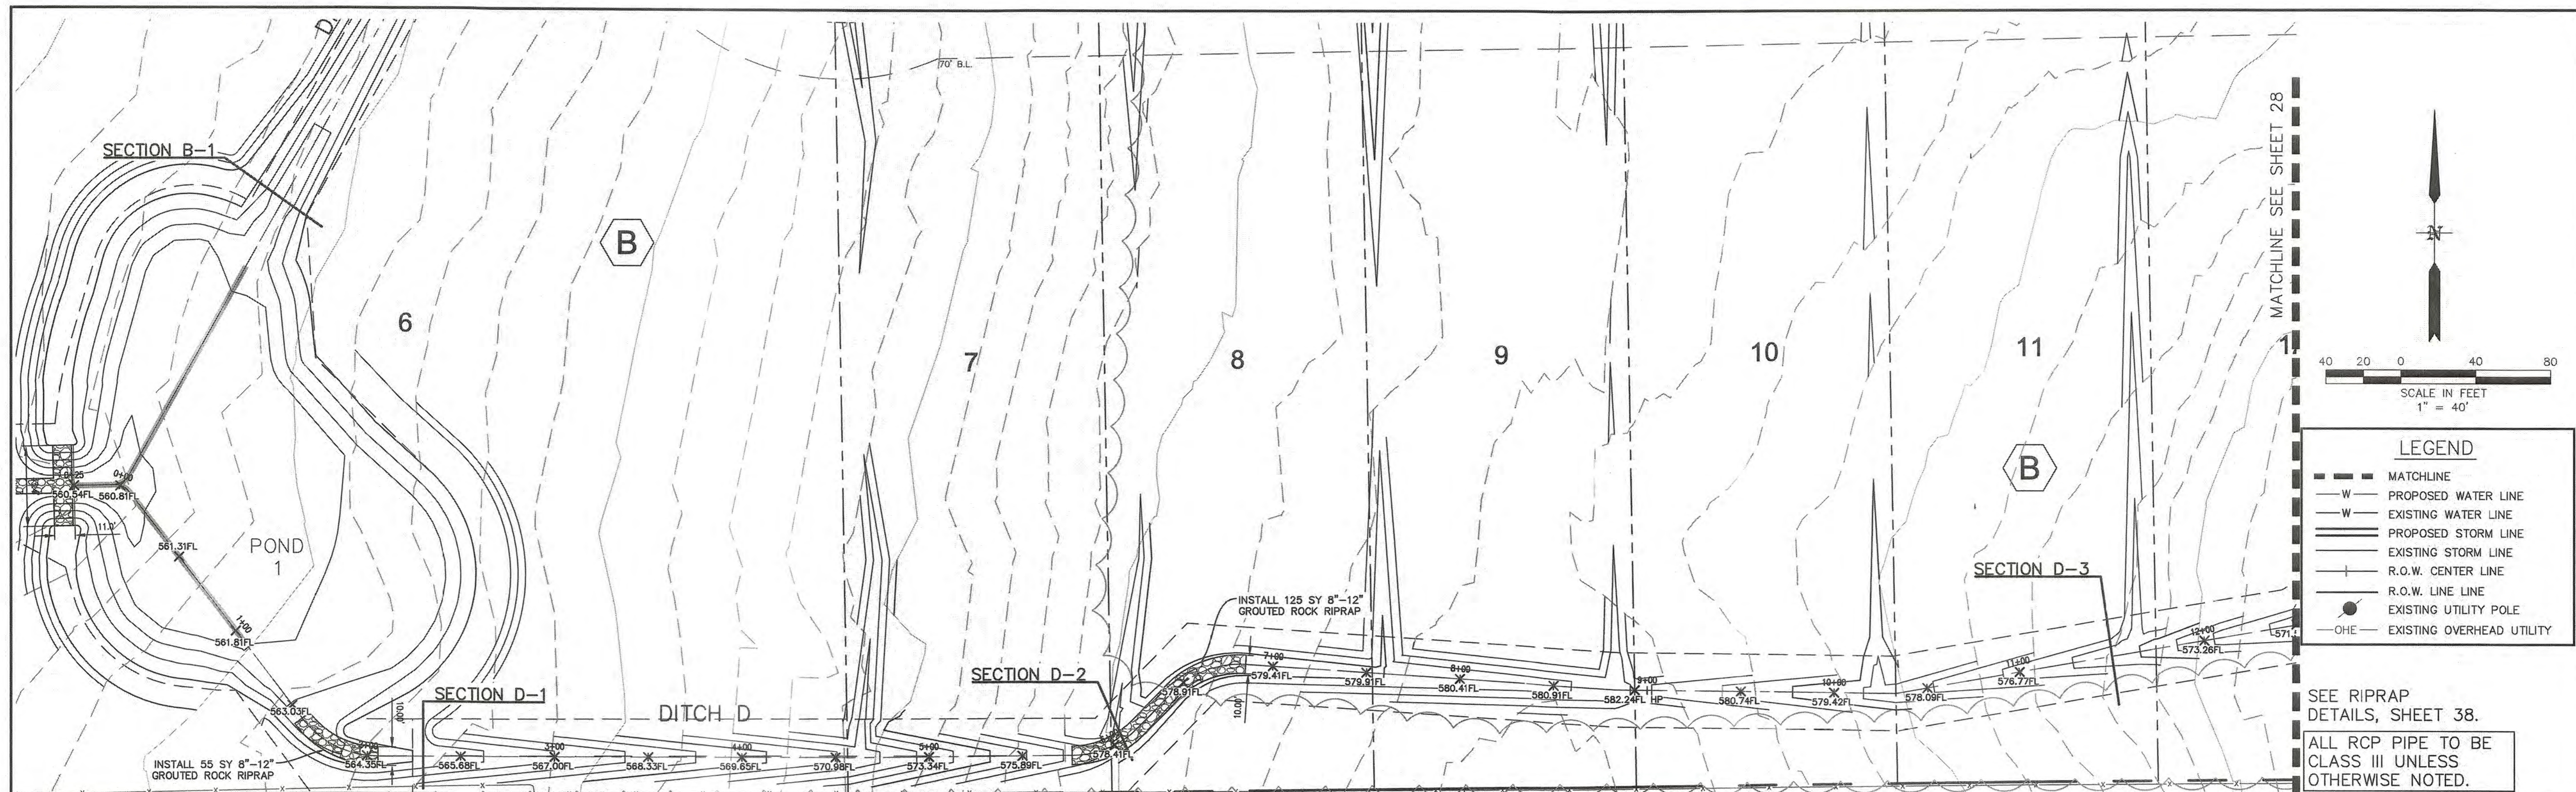

**CAUTION! EXISTING UTILITIES**

CONTRACTOR SHOULD CALL 1-800-DIG-TESS PRIOR TO BEGINNING ANY CONSTRUCTION ACTIVITIES FOR EXISTING UTILITY LOCATIONS. EXISTING UTILITIES AND UNDERGROUND FACILITIES INDICATED ON THESE PLANS HAVE BEEN LOCATED FROM REFERENCE INFORMATION. IT IS THE RESPONSIBILITY OF THE CONTRACTOR TO VERIFY BOTH HORIZONTALLY AND VERTICALLY THE LOCATION OF ALL EXISTING UTILITIES AND UNDERGROUND FACILITIES PRIOR TO CONSTRUCTION AND TO TAKE NECESSARY PRECAUTIONS IN ORDER TO PROTECT ALL FACILITIES ENCOUNTERED. THE CONTRACTOR SHALL PRESERVE AND PROTECT ALL EXISTING UTILITIES FROM DAMAGE DURING CONSTRUCTION.

BM-1: "PK" Nail on the south side of Clem Road, approximately 2275' west of the centerline intersection of Clem Road and FM 3549  
Elev.: 559.07'

BM-2: "PK" Nail in Clem Road, approximately 175' west of the centerline intersection of Clem Road and FM 3549  
Elev.: 584.83'

**ENGINEERINGCONCEPTS & DESIGN, L.P.**

ENGINEERING / PROJECT MANAGEMENT / CONSTRUCTION SERVICES - FIRM REG. #F-001145  
201 WINDCO CIR, STE 200, WYLLIE, TX 75098  
972-941-8400 FAX: 972-941-8401 WWW.ECDLP.COM

REVISIONS:

DRAWN: MJH	DATE:
CHECKED: RCK	DATE: 6/1/2020
PROJECT NO.: 08838	
DWG FILE NAME: 08838 ST.DWG	

THIS DOCUMENT IS RELEASED FOR THE PURPOSE OF CONSTRUCTION. THE SEAL APPEARING ON THIS DOCUMENT WAS AUTHORIZED BY RYAN C. KING, P.E. 123635



**RYAN C. KING**  
123635  
REGISTERED PROFESSIONAL ENGINEER  
STATE OF TEXAS  
6/1/2020

**STORM PLAN - DITCH D 0+00 - 12+50**

**NORTHGATE**

CITY OF ROCKWALL, ROCKWALL COUNTY, TEXAS


SHEET  
**27**  
OF  
**40**

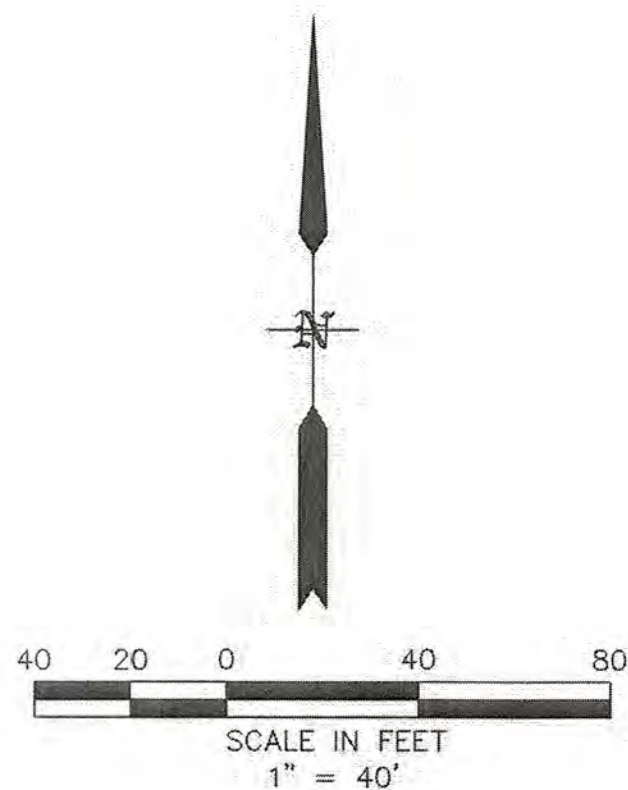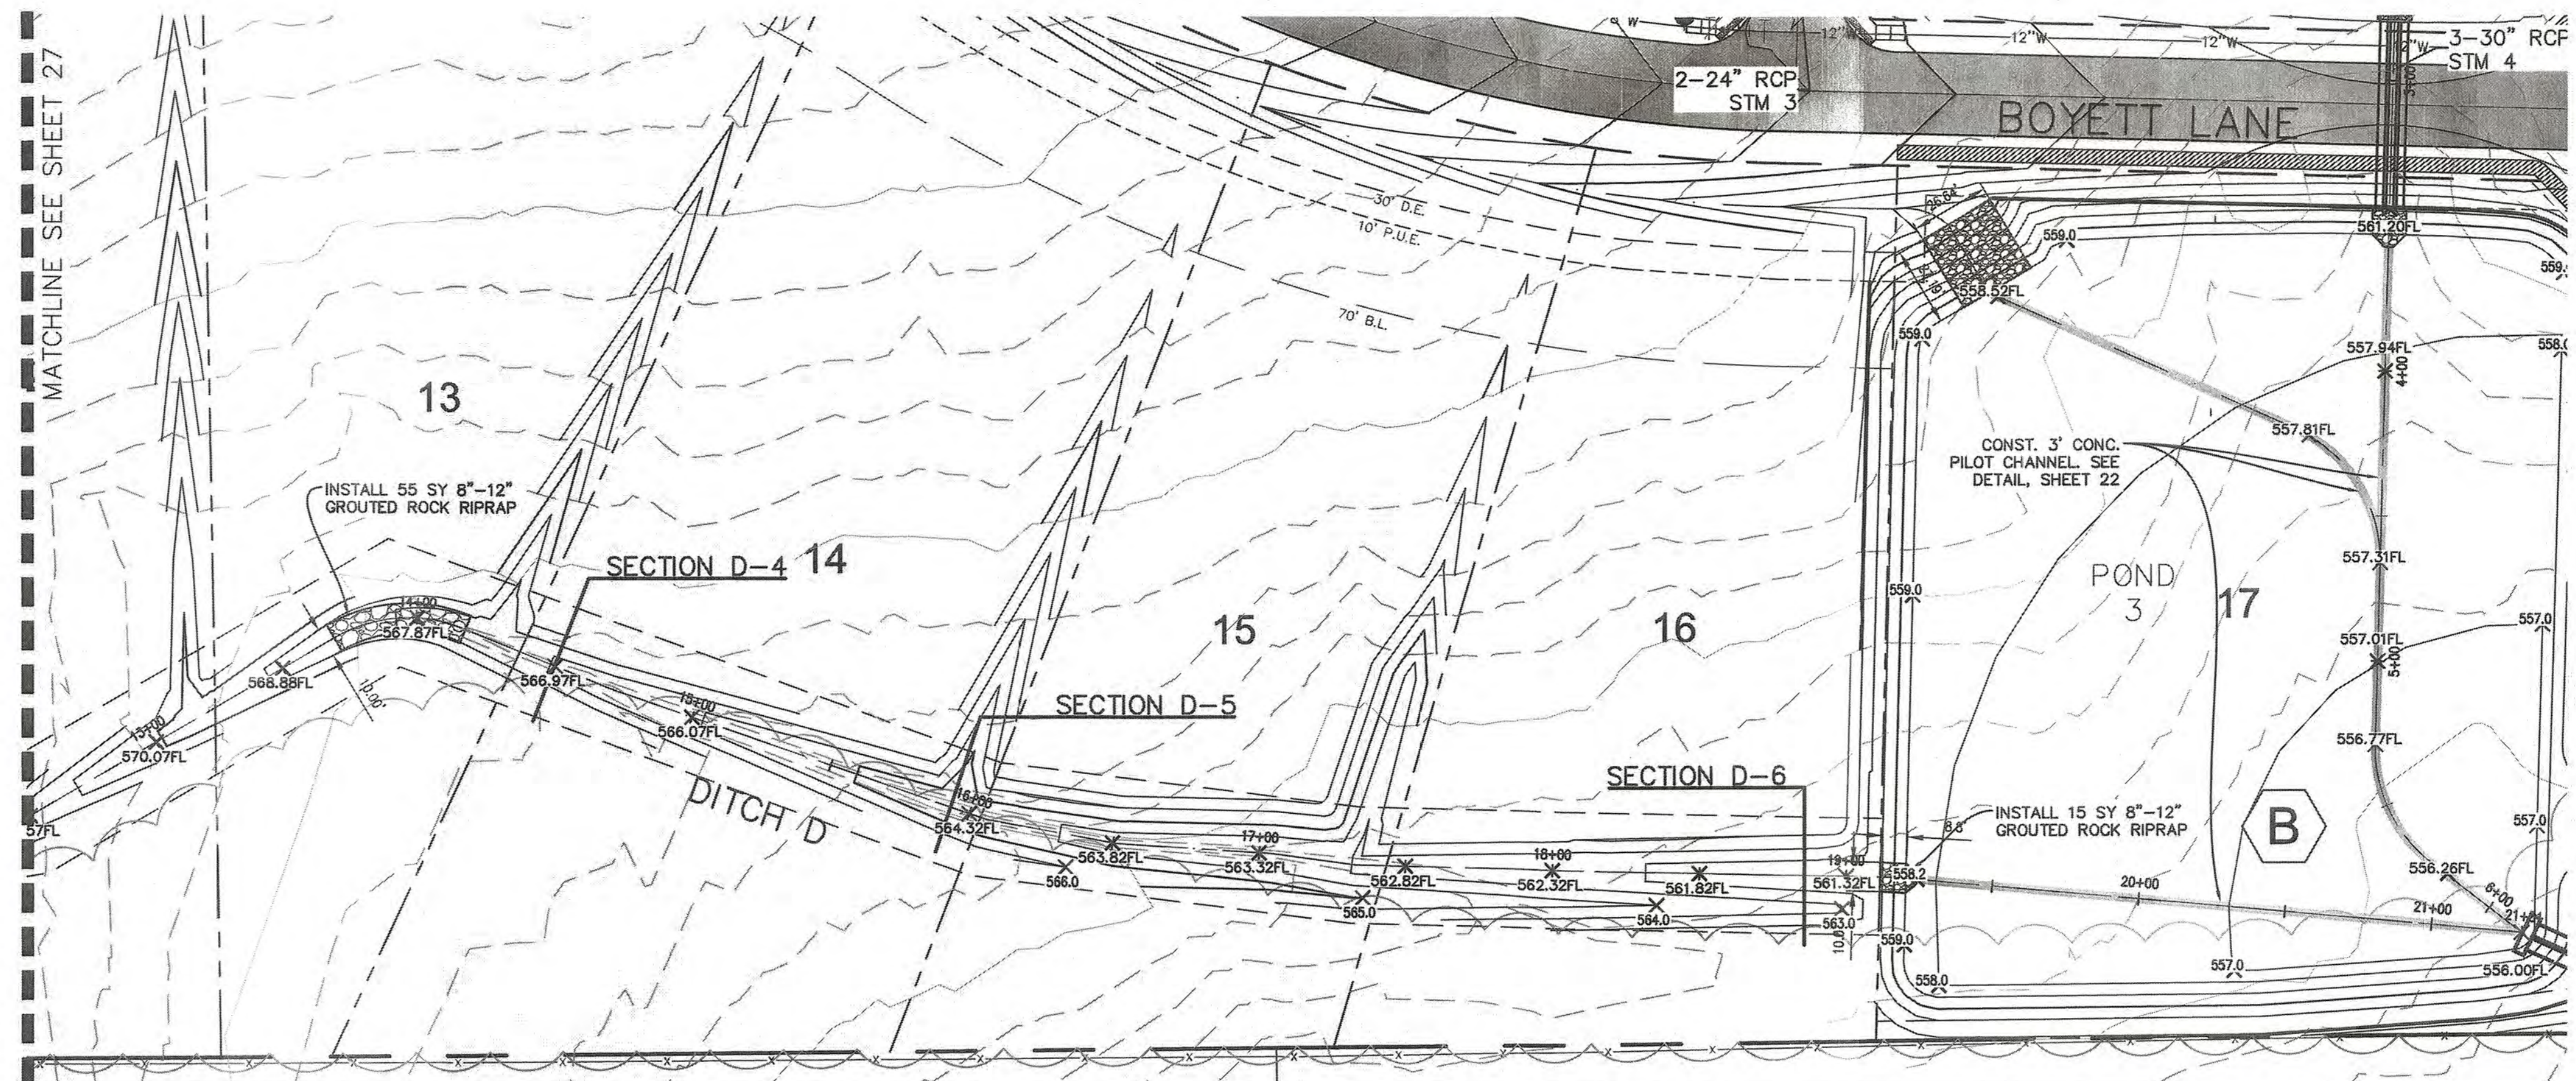

LEGEND	
---	MATCHLINE
W	PROPOSED WATER LINE
W	EXISTING WATER LINE
---	PROPOSED STORM LINE
---	EXISTING STORM LINE
+	R.O.W. CENTER LINE
+	R.O.W. LINE LINE
●	EXISTING UTILITY POLE
---	EXISTING OVERHEAD UTILITY

SEE RIPRAP  
DETAILS, SHEET 38.

ALL RCP PIPE TO BE  
CLASS III UNLESS  
OTHERWISE NOTED.

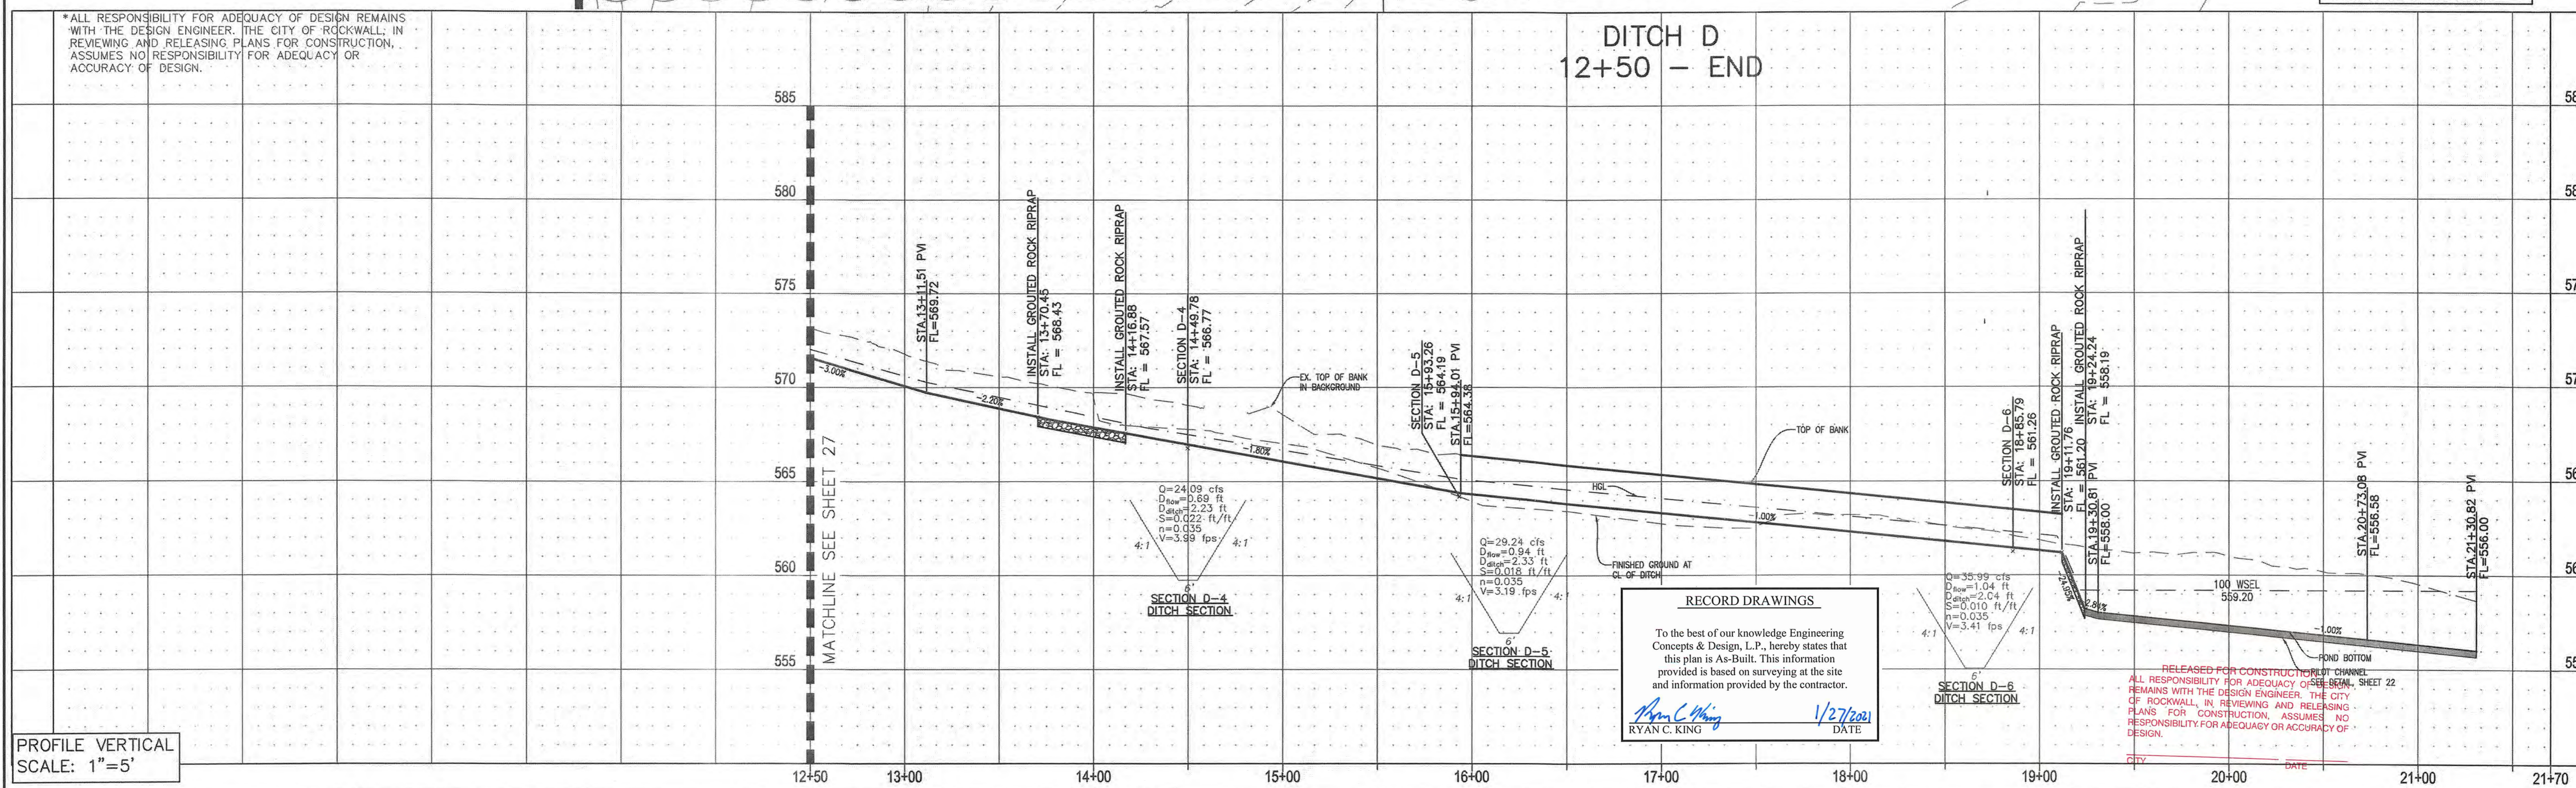

PROFILE VERTICAL  
SCALE: 1"=5'

RECORD DRAWINGS

To the best of our knowledge Engineering Concepts & Design, L.P., hereby states that this plan is As-Built. This information provided is based on surveying at the site and information provided by the contractor.

*Ryan C. King*  
RYAN C. KING  
DATE: 1/27/2021

**CAUTION: EXISTING UTILITIES**

CONTRACTOR SHOULD CALL 1-800-DIG-TEST PRIOR TO BEGINNING ANY CONSTRUCTION ACTIVITIES FOR EXISTING UTILITY LOCATIONS. EXISTING UTILITIES AND UNDERGROUND FACILITIES INDICATED ON THESE PLANS HAVE BEEN LOCATED FROM REFERENCE INFORMATION. IT IS THE RESPONSIBILITY OF THE CONTRACTOR TO VERIFY BOTH HORIZONTALLY AND VERTICALLY THE LOCATION OF ALL EXISTING UTILITIES AND UNDERGROUND FACILITIES PRIOR TO CONSTRUCTION AND TO TAKE NECESSARY PRECAUTIONS IN ORDER TO PROTECT ALL FACILITIES ENCOUNTERED. THE CONTRACTOR SHALL PRESERVE AND PROTECT ALL EXISTING UTILITIES FROM DAMAGE DURING CONSTRUCTION.

BM-1: "PK" Nail on the south side of Clem Road, approximately 2275' west of the centerline intersection of Clem Road and FM 3549  
Elev.: 559.07'

BM-2: "PK" Nail in Clem Road, approximately 175' west of the centerline intersection of Clem Road and FM 3549  
Elev.: 584.83'

**ENGINEERINGCONCEPTS**  
& DESIGN, L.P.

ENGINEERING / PROJECT MANAGEMENT /  
CONSTRUCTION SERVICES - FIRM REG. #F-001145  
201 WINDCO CIR, STE 200, WYLIE, TX 75098  
972-941-8400 FAX: 972-941-8401 WWW.ECDLP.COM

REVISIONS:	
DRAWN: MJH	DATE:
CHECKED: RCK	DATE: 6/1/2020
PROJECT NO.: 08838	
DWG FILE NAME: 08838 ST.DWG	

THIS DOCUMENT IS RELEASED FOR  
THE PURPOSE OF CONSTRUCTION.  
THE SEAL APPEARING ON THIS DOCUMENT WAS  
AUTHORIZED BY RYAN C. KING, P.E. 123635



**STORM PLAN - DITCH D 12+50  
- END**

**NORTHGATE**

CITY OF ROCKWALL, ROCKWALL COUNTY, TEXAS




SHEET  
**28**  
OF  
**40**

Pipe Calculations																																												
Line Desc.	Upstream Sta.	Downstream Sta.	Dist. Btwn. Points	Area Number	D A (AC)	Coeff., CK	Increm. CA	Accum-ulated CA	Time at Upstream	Design Storm Freq.	Rainfall Intensity I (in/hr)	Storm Water Runoff, Q (cfs)	Cum. Runoff Q (cfs)	Number of Barrels	Storm Sewer Diameter, Ø (in)	RCP		Type	Area of Pipe (ft²)	Wetted Perimeter of Pipe (ft)	Hydraulic Radius of Pipe (ft)	Mann. Coeff. (in)	Flowline Elevation		Slope of Storm Pipe (%)	Velocity in Storm Pipe (fps)	Hydraulic Gradient Slope, S <sub>f</sub> (ft/ft)	Storm Sewer Capacity Q (cfs)	Partial Flow	L*S <sub>f</sub>	V1²/2g	V2²/2g	Head Loss Coeff, K <sub>j</sub>	Velocity Head Loss Upstream (ft)	Inlet and Bend Losses	Flow Time Distance (V*60) (min)	Flow Time of Downstream Sta. (min)	Down-stream HGL	Upstream HGL	Starting HGL	Top of Curb Elevation	HGL Below Top of Curb	Flow Regime	Remarks
																Span (ft)	Rise (ft)						Up-stream	Down-stream																				
1	2	3	4	17/36	18	19	20	21	22	23	24	25	25	5	6	7	8	9	10	11	12	13	14	15	16	28	30	26	27	31	34	35	37	38	38	29		33	32	39	40	41	42	43
STM 4	268.24	324.24	56.00	INLET	12.06	0.50	6.03	6.03	10.00	100-YR	9.80	59.09	59.09	3	30	0	0	RCP	14.73	23.56	0.63	0.0130	564.57	561.39	5.68%	4.01	0.0023	293.27	Yes	0.129		0.25	1.25	0.00	0.31	0.23	10.23	565.33	565.64	567.64	2.00	INLET		
STM 4	324.24	344.24	20.00	PVI	0.00	0.50	0.00	6.03	10.23	100-YR	9.76	0.00	59.09	3	30	0	0	RCP	14.73	23.56	0.63	0.0130	561.39	561.20	0.95%	4.01	0.0023	119.94	No	0.046	4.01	0.25	0.25	0.00	0.06	0.08	10.32	563.75	563.81	563.70		INLET		

CULVERT CALCULATIONS

CULVERT DESIGN CALCULATIONS															TRAIL CULVERT					HEADWATER CALCULATION															The Greater Controlling Head Water (Inlet or Outlet) (ft)	SELECTED CONDUIT SIZE
Description	Area (AC)	Area Cum (AC)	Q100 (cfs)	Length "L" (ft)	Roughness Coeff "n"	Tailwater	Roadway Elev.	U.S. Culvert FL	D.S. Culvert FL	D.S. Culvert HGL	U.S. Culvert HGL	HW	Required Freeboard	Culvert Slope "S <sub>c</sub> "	AHW (ft)	CULVERT SIZE					INLET CONTROL		OUTLET CONTROL													
																No. Openings	Width of Box "B" (in)	Box Depth or Pipe Dia "D" (in)	Total Culvert Area "A <sub>c</sub> " (sq. ft)	"Q" Each Opening (cfs)	HW/D	HW	CASE III HW=H+TW-L*S <sub>o</sub> (ft)					CASE IV HW=H+h <sub>o</sub> -L*S <sub>o</sub> (ft)								
																							Entrance Coeff. K <sub>e</sub>	"H" (ft)	"TW" (ft)	LxS <sub>o</sub> (ft)	"HW" (ft)	"H" (ft)	d <sub>c</sub> (ft)	(d <sub>c</sub> +D)/2 (ft)	"TW" (ft)	h <sub>o</sub> (ft)	LxS <sub>o</sub> (ft)	"HW" (ft)		
															4	6		8	9	10	14	15	16	17	18	19	20	21	22	23	24	25	26	27	28	29
1/A	1.08	4.00	19.62	22.00	0.013	0.77	574.87	571.50	570.80	571.57	572.62	573.14	1.00	3.20	1.64	2	24	6.28	9.81	0.82	1.64	0.50	0.27	0.77	0.70	0.34	0.27	1.12	1.56	0.77	1.56	0.70	1.12	INLET	24	
2/A	1.11	2.92	14.33	22.00	0.013	1.65	579.05	576.22	575.52	576.16	577.17	577.56	1.00	3.20	1.34	2	24	6.28	7.17	0.67	1.34	0.50	0.14	0.64	0.70	0.08	0.14	0.95	1.48	0.64	1.48	0.70	0.91	INLET	24	
3/A	0.48	1.81	8.88	22.00	0.013	1.51	582.60	580.43	579.73	580.27	581.24	581.60	1.00	3.20	1.17	2	18	3.53	4.44	0.78	1.17	0.50	0.19	0.54	0.70	0.03	0.19	0.81	1.15	0.54	1.15	0.70	0.64	INLET	18	
4/A	0.31	1.34	6.55	22.00	0.013	0.98	584.27	582.20	581.91	582.46	582.89	583.18	1.00	1.30	0.98	2	18	3.53	3.27	0.65	0.98	0.50	0.10	0.55	0.29	0.36	0.10	0.69	1.09	0.55	1.09	0.29	0.91	INLET	18	
5/A	0.32	1.03	5.03	22.00	0.013	0.89	585.74	583.88	583.59	584.07	584.48	584.72	1.00	1.30	0.84	2	18	3.53	2.51	0.56	0.84	0.50	0.06	0.48	0.29	0.25	0.06	0.60	1.05	0.48	1.05	0.29	0.82	INLET	18	
6/A	0.37	0.71	3.48	22.00	0.013	0.79	587.27	585.49	585.20	585.59	585.99	586.17	1.00	1.30	0.68	2	18	3.53	1.74	0.45	0.68	0.50	0.03	0.39	0.29	0.13	0.03	0.50	1.00	0.39	1.00	0.29	0.74	OUTLET	18	
7/A	0.34	0.34	1.67	22.00	0.013	0.71	587.92	586.20	585.98	586.39	586.69	586.86	1.00	1.00	0.66	1	18	1.77	1.67	0.44	0.66	0.50	0.03	0.41	0.22	0.22	0.03	0.49	0.99	0.41	0.99	0.22	0.80	OUTLET	18	
8/A	0.00	0.00	0.00	NA	NA	NA	NA	NA	NA	NA	NA	NA	NA	NA	NA	NA	NA	NA	NA	NA	NA	NA	NA	NA	NA	NA	NA	NA	NA	NA	NA	NA	NA	NA	NA	NA
9/A	0.85	0.85	4.17	22.00	0.013	0.82	587.60	585.85	585.58	586.01	586.40	586.61	1.00	1.25	0.76	2	18	3.53	2.08	0.51	0.76	0.50	0.04	0.43	0.28	0.20	0.04	0.54	1.02	0.43	1.02	0.28	0.79	OUTLET	18	
10/A	1.63	2.49	12.18	22.00	0.013	1.15	583.83	581.67	581.40	582.10	582.55	582.91	1.00	1.25	1.24	2	24	6.28	6.09	0.62	1.24	0.50	0.10	0.71	0.28	0.53	0.10	0.87	1.44	0.71	1.44	0.28	1.27	OUTLET	24	
11/A	1.69	4.17	20.45	22.00	0.013	1.89	578.33	573.17	572.47	573.30	574.36	575.05	1.00	3.20	1.88	3	30	14.73	6.82	0.75	1.88	0.50	0.05	0.83	0.70	0.18	0.05	0.87	1.68	0.83	1.68	0.70	1.03	INLET	30	
12/A	1.13	3.87	18.99	22.00	0.013	1.37	579.52	576.51	576.29	577.30	577.66	578.30	1.00	1.00	1.79	2	21	4.81	9.49	1.02	1.79	0.50	0.44	1.01	0.22	1.23	0.44	1.15	1.45	1.01	1.45	0.22	1.67	INLET	21	
13/A	1.07	2.74	13.44	22.00	0.013	1.18	580.95	577.77	577.55	578.37	578.73	579.18	1.00	1.00	1.41	2	21	4.81	6.72	0.81	1.41	0.50	0.22	0.82	0.22	0.82	0.22	0.96	1.35	0.82	1.35	0.22	1.36	INLET	21	
14/A	1.09	1.67	8.19	22.00	0.013	1.33	582.62	579.23	579.01	580.02	580.34	581.08	1.00	1.00	1.85	1	18	1.77	8.19	1.23	1.85	0.50	0.63	1.01	0.22	1.42	0.63	1.11	1.30	1.01	1.30	0.22	1.72	INLET	18	
15/A	0.59	0.59	2.87	22.00	0.013	0.86	583.77	580.69	580.47	581.02	581.33	581.60	1.00	1.00	0.91	1	18	1.77	2.87	0.61	0.91	0.50	0.08	0.55	0.22	0.41	0.08	0.64	1.07	0.55	1.07	0.22	0.93	OUTLET	18	
16/A	0.44	0.44	2.17	22.00	0.013	1.22	583.49	581.15	580.49	580.86	581.71	581.90	1.00	3.00	0.75	1	18	1.77	2.17	0.50	0.75	0.50	0.04	0.37	0.66	-0.25	0.04	0.56	1.03	0.37	1.03	0.66	0.41	INLET	18	
17/A	1.08	1.53	7.48	22.00	0.013	1.53	580.52	577.09	576.62	577.43	578.15	578.80	1.00	2.15	1.71	1	18	1.77	7.48	1.14	1.71	0.50	0.53	0.81	0.47	0.87	0.53	1.06	1.28	0.81	1.28	0.47	1.34	INLET	18	
18/A	1.00	2.52	12.37	22.00	0.013	1.43	577.06	574.00	573.53	574.25	574.96	575.48	1.00	2.15	1.48	2	18	3.53	6.18	0.99	1.48	0.50	0.36	0.72	0.47	0.61	0.36	0.96	1.23	0.72	1.23	0.47	1.12	INLET	18	
19/A	5.71	5.71	27.97	22.00	0.013	1.94	570.87	567.92	567.15	567.95	569.09	569.66	1.00	3.50	1.74	3	21	7.22	9.32	0.99	1.74	0.50	0.43	0.80	0.77	0.46	0.43	1.18	1.46	0.80	1.46	0.77	1.12	INLET	21	
20/A	1.50	5.08	24.90	22.00	0.013	1.80	575.16	572.58	571.81	572.49	573.61	574.05	1.00	3.50	1.47	3	24	9.42	8.30	0.73	1.47	0.50	0.19	0.68	0.77	0.10	0.19	1.03	1.51	0.68	1.51	0.77	0.94	INLET	24	
21/A	1.50	3.58	17.55	22.00	0.013	1.49	578.81	576.62	575.98	576.56	577.47	577.80	1.00	2.90	1.18	3	24	9.42	5.85	0.59	1.18	0.50	0.10	0.58	0.64	0.04	0.10	0.85	1.43	0.58	1.43	0.64	0.88	INLET	24	
22/A	2.18	2.08	10.20	22.00	0.013	1.28	582.40	580.53	579.89	580.32	581.17	581.39	1.00	2.90	0.86	3	24	9.42	3.40	0.43	0.86	0.50	0.03	0.43	0.64	-0.18	0.03	0.64	1.32	0.43	1.32	0.64	0.72	INLET	24	
1/B	0.15	0.95	4.66	22.00	0.013	1.26	563.42	563.84	563.16	563.54	564.42	564.63	1.00	3.10	0.79	2	18	3.53	2.33	0.53	0.79	0.50	0.05	0.38	0.68	-0.25	0.05	0.58	1.04	0.38	1.04	0.68	0.41	INLET	18	
2/B	0.20	0.80	3.94	22.00	0.013	0.76	568.90	567.04	566.81	567.25	567.57	567.77	1.00	1.05	0.73	2	18	3.53	1.97	0.49	0.73	0.50	0.04	0.44	0.23	0.25	0.04	0.53	1.01	0.44	1.01	0.23	0.82	OUTLET	18	
3/B	0.20	0.61	2.97	22.00	0.013	0.69	570.38	568.68	568.43	568.83	569.14	569.30	1.00	1.05	0.62	2	18	3.53	1.49	0.41	0.62	0.50	0.02	0.38	0.23	0.17	0.02	0.46	0.98	0.38	0.98	0.23	0.77	OUTLET	18	
4/B	0.19	0.41	2.01	22.00	0.013	0.60	571.86	570.32	570.09	570.40	570.69	570.82	1.00	1.05	0.50	2	18	3.53	1.00	0.33	0.50	0.50	0.01	0.31	0.23	0.09	0.01	0.37	0.94	0.31	0.94	0.23	0.71	OUTLET	18	
5/B	0.22	0.22	1.08	22.00	0.013	0.61	572.35	571.28	571.06	571.39	571.67	571.80	1.00	1.00	0.52	1	18	1.77	1.08	0.35	0.52	0.50	0.01	0.33	0.22	0.12	0.01	0.39	0.94	0.33	0.94	0.22	0.74	OUTLET	18	
6/B	0.43	2.59	12.67	22.00	0.013	1.64	573.90	571.36	570.44	570.89	572.08	572.32	1.00	4.18	0.96	3	24	9.42	4.22	0.48	0.96	0.50	0.05	0.45	0.92	-0.42	0.05	0.72	1.36	0.45	1.36	0.92	0.49	INLET	24	
7/B	0.83	2.16	10.58	22.00	0.013	1.13	576.78	574.78	574.31	574.78	575.44	575.67	1.00	2.15	0.89	3	24	9.42	3.53	0.44	0.89	0.50	0.03	0.47	0.47	0.03	0.03	0.66	1.33	0.47	1.33	0.47	0.89	OUTLET	24	
8/B	0.87	1.33	6.49	22.00	0.013	1.37	580.22	577.84	577.37	578.03	578.74	579.11	1.00	2.15	1.27	1	24	3.14	6.49	0.63	1.27	0.50	0.12	0.66	0.47	0.31	0.12	0.90	1.45	0.66	1.45	0.47	1.10	INLET	24	
9/B	0.45	0.45	2.21	22.00	0.013	1.03	588.28	580.87	580.40	580.80	581.43	581.64	1.00	2.15	0.77	1	18	1.77	2.21	0.51	0.77	0.50	0.05	0.40	0.47	-0.02	0.05	0.56	1.03	0.40	1.03	0.47	0.60	INLET	18	
10/B	0.18	0.18	0.86	22.00	0.013	0.57	583.61	580.92	580.70	580.99	581.27	581.38	1.00	1.00	0.46	1	18	1.77	0.86	0.31	0.46	0.50	0.01	0.29	0.22	0.08	0.01	0.35	0.92	0.29	0.92	0.22	0.71	OUTLET	18	
11/B	0.18	0.35	1.72	22.00	0.013	0.71	582.94	579.51	579.29	579.71	580.00	580.18	1.00	1.00	0.67	1	18	1.77	1.72	0.45	0.67	0.50	0.03	0.42	0.22	0.23	0.03	0.49	1.00	0.42	1.00	0.22	0.80	OUTLET	18	
12/B	0.18	0.53	2.58	22.00	0.013	0.83	581.33	578.10	577.88	578.40	578.71	578.95	1.00	1.00	0.85	1	18	1.77	2.58	0.57	0.85	0.50	0.06	0.52	0.22	0.36	0.06	0.61	1.05	0.52	1.05	0.22	0.90	OUTLET	18	
13/B	0.30	0.83	4.07	22.00	0.013	0.99	579.07	576.13	575.91	576.57	576.90	577.25	1.00	1.00	1.12	1	18	1.77	4.07	0.75	1.12	0.50	0.16	0.66	0.22	0.60	0.16	0.77	1.14	0.66	1.14	0.22	1.07	INLET	18	

\*ALL RESPONSIBILITY FOR ADEQUACY OF DESIGN REMAINS WITH THE DESIGN ENGINEER. THE CITY OF ROCKWALL, IN REVIEWING AND RELEASING PLANS FOR CONSTRUCTION, ASSUMES NO RESPONSIBILITY FOR ADEQUACY OR ACCURACY OF DESIGN.

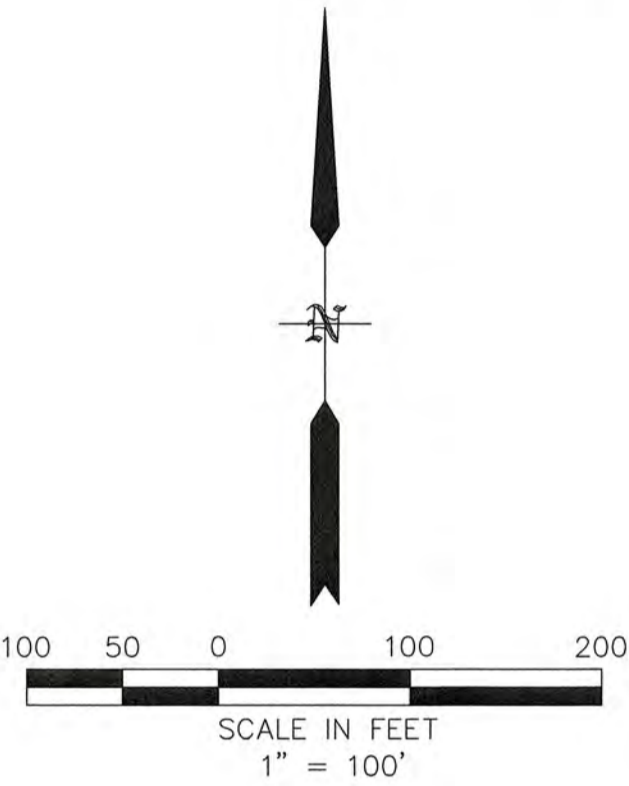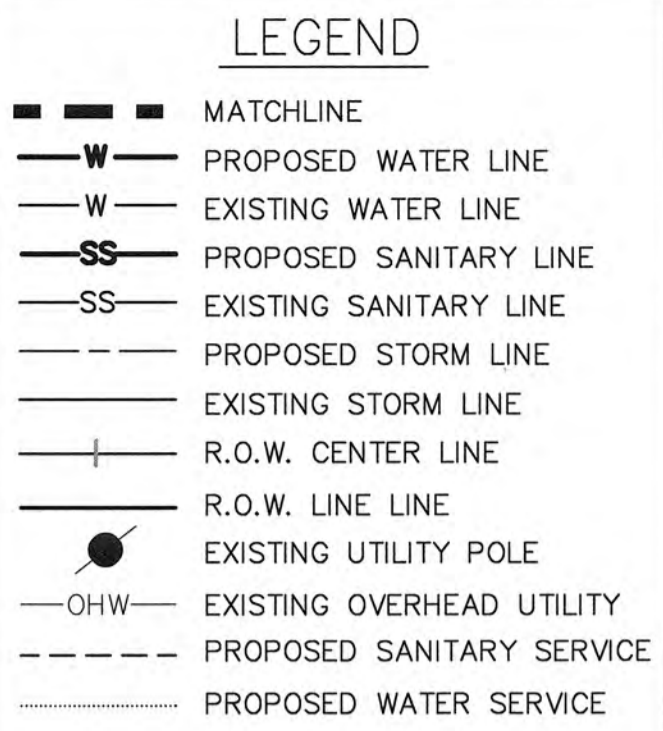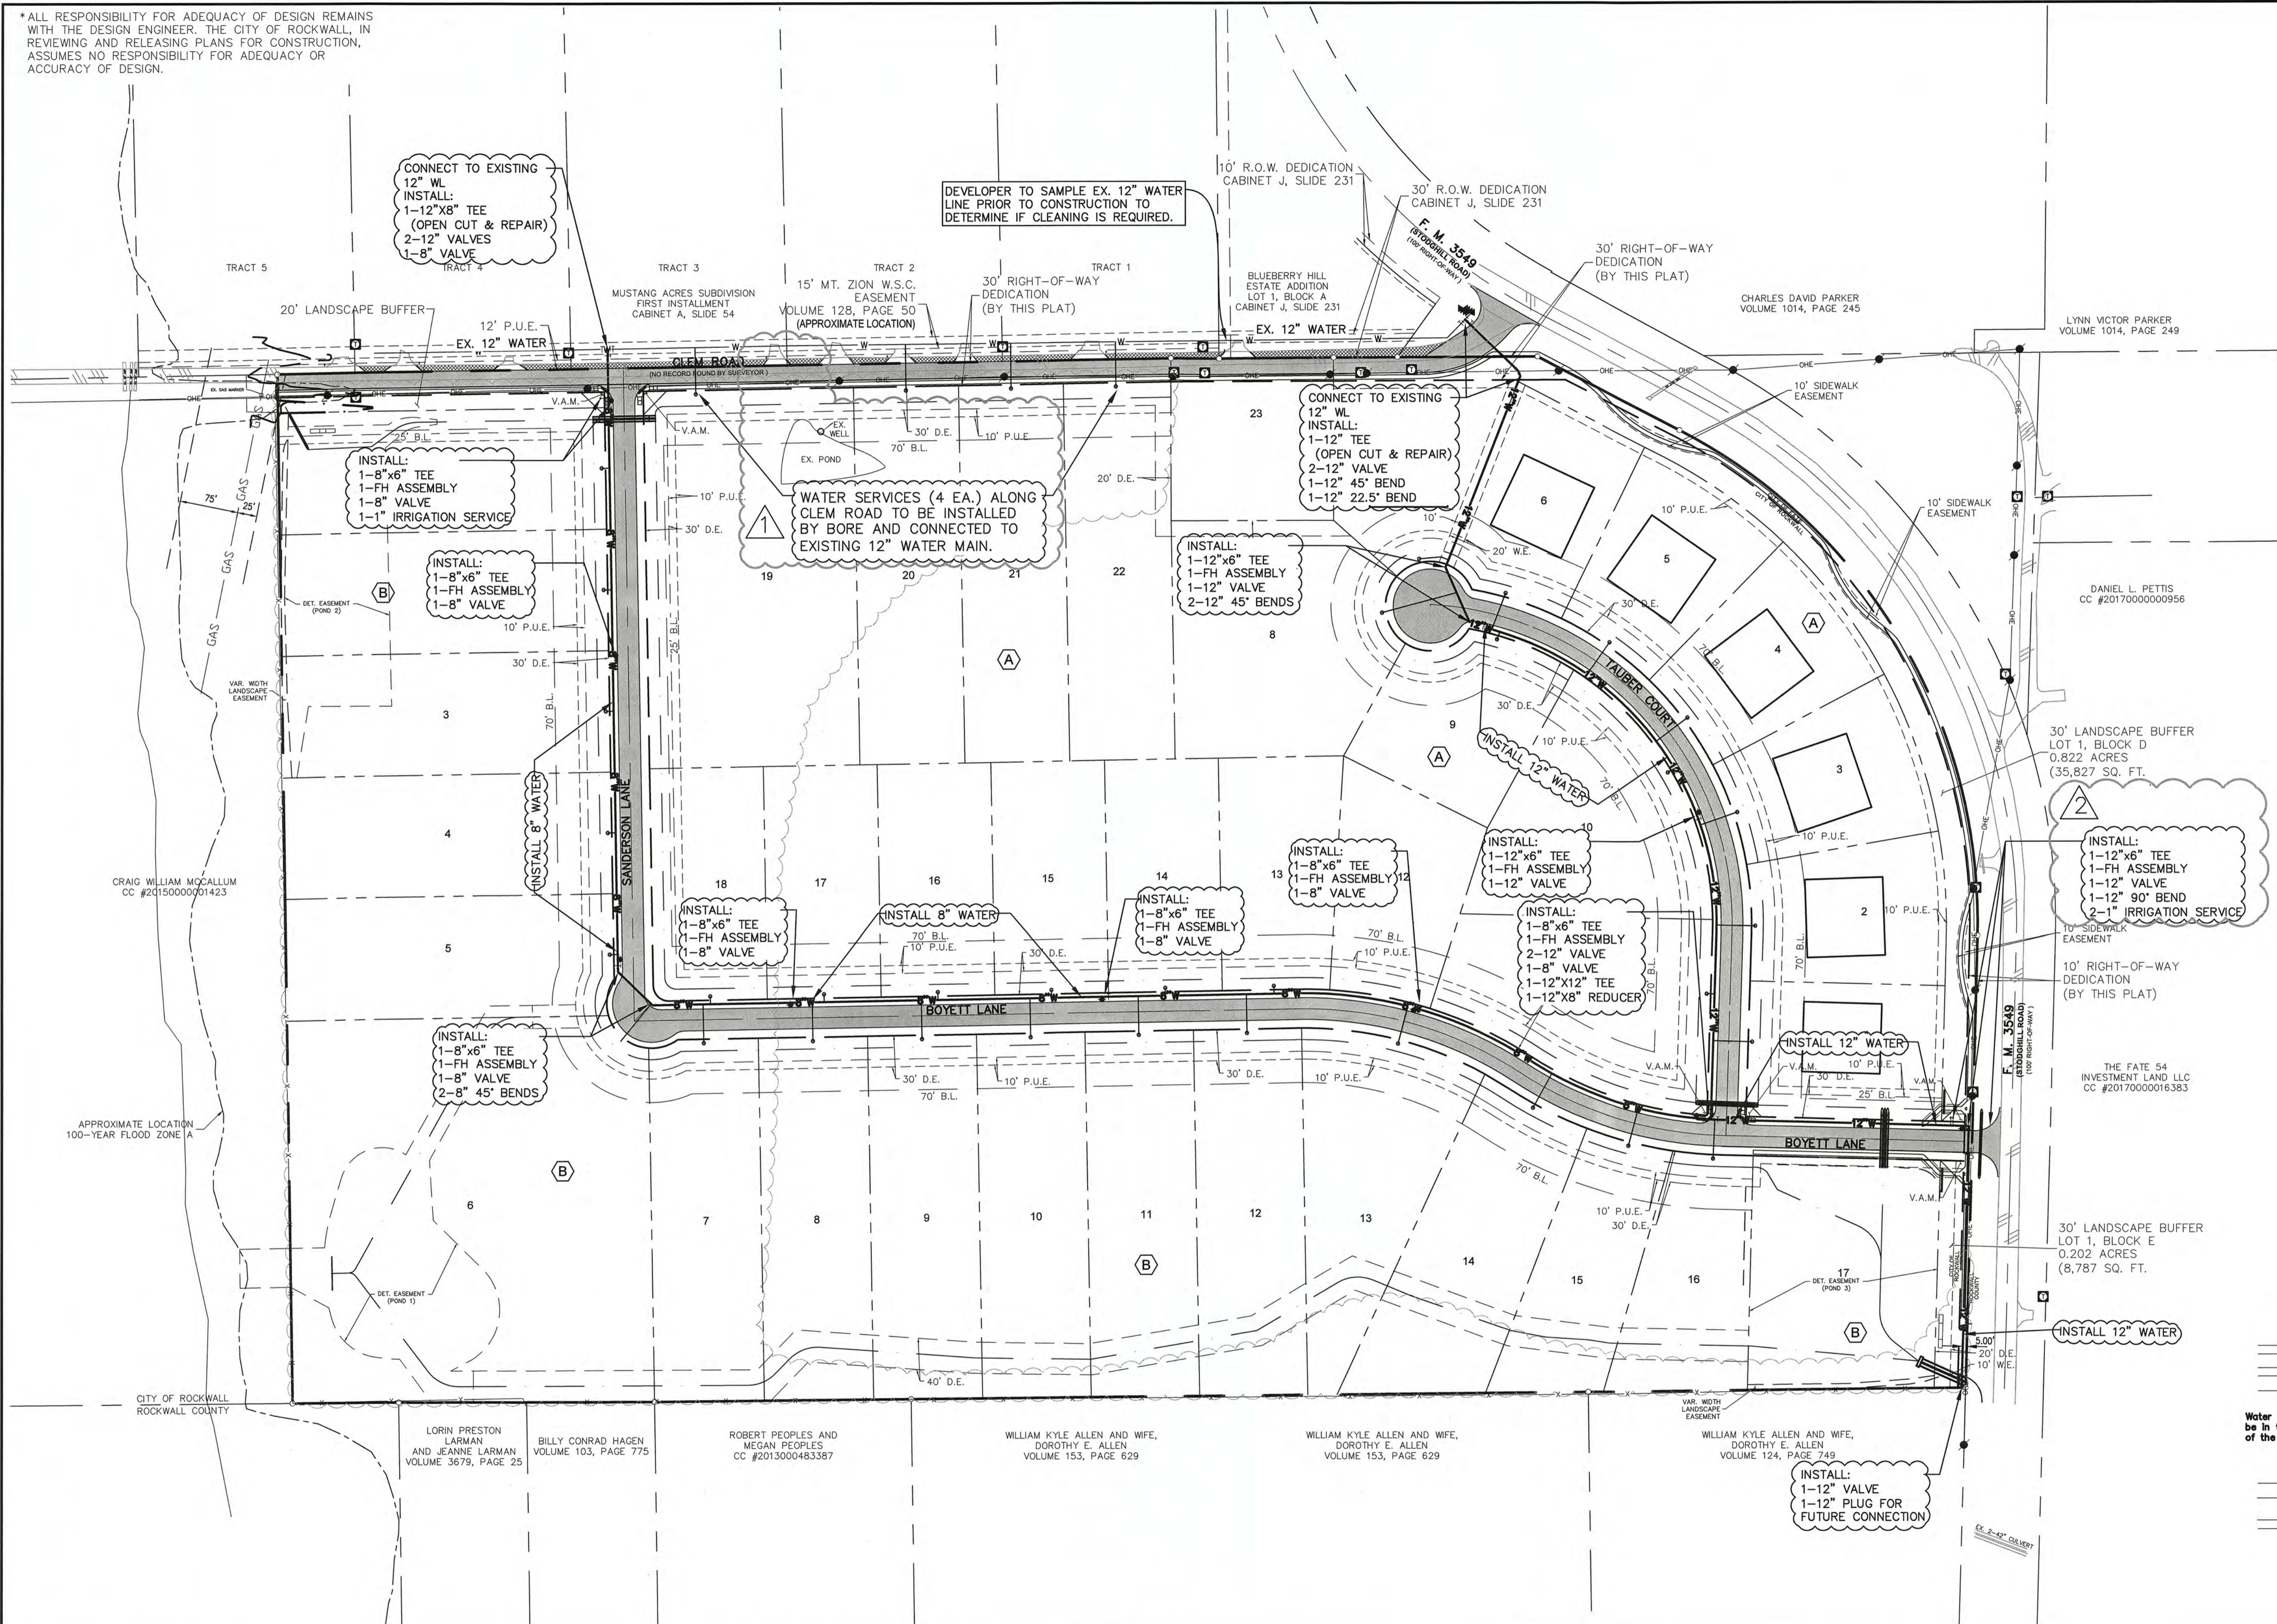


- NOTE:
- ALL LOTS TO BE SERVED SEWER BY SEPTIC SYSTEMS PERMITTED THROUGH 3RD PARTY AND REVIEWED/APPROVED BY ROCKWALL BUILDING DEPARTMENT
  - ALL SERVICES TO BE 1".

**RECORD DRAWINGS**

To the best of our knowledge Engineering Concepts & Design, L.P., hereby states that this plan is As-Built. This information provided is based on surveying at the site and information provided by the contractor.

*Ryan C. King* 1/27/2021  
RYAN C. KING DATE

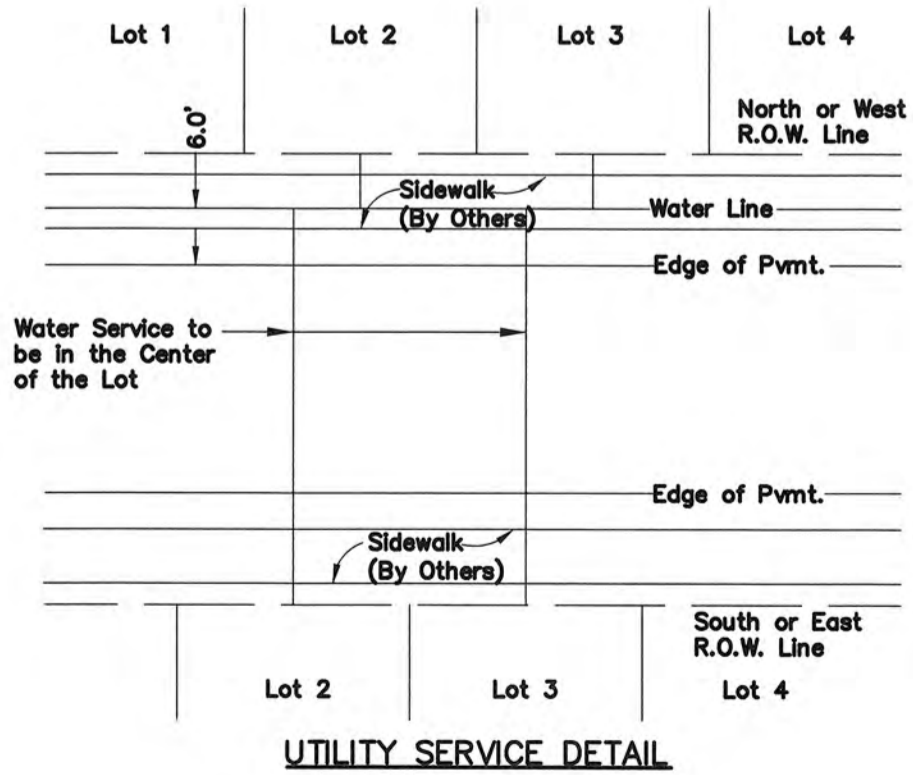

**CAUTION! EXISTING UTILITIES**

CONTRACTOR SHOULD CALL 1-800-DIG-TESS PRIOR TO BEGINNING ANY CONSTRUCTION ACTIVITIES FOR EXISTING UTILITY LOCATIONS. EXISTING UTILITIES AND UNDERGROUND FACILITIES INDICATED ON THESE PLANS HAVE BEEN LOCATED FROM REFERENCE INFORMATION. IT IS THE RESPONSIBILITY OF THE CONTRACTOR TO VERIFY BOTH HORIZONTALLY AND VERTICALLY THE LOCATION OF ALL EXISTING UTILITIES AND UNDERGROUND FACILITIES PRIOR TO CONSTRUCTION AND TO TAKE NECESSARY PRECAUTIONS IN ORDER TO PROTECT ALL FACILITIES ENCOUNTERED. THE CONTRACTOR SHALL PRESERVE AND PROTECT ALL EXISTING UTILITIES FROM DAMAGE DURING CONSTRUCTION.

BM-1: "PK" Nail on the south side of Clem Road, approximately 2275' west of the centerline intersection of Clem Road and FM 3549 Elev.: 559.07'

BM-2: "PK" Nail in Clem Road, approximately 175' west of the centerline intersection of Clem Road and FM 3549 Elev.: 584.83'

**ENGINEERINGCONCEPTS & DESIGN, L.P.**

ENGINEERING / PROJECT MANAGEMENT / CONSTRUCTION SERVICES - FIRM REG. #F-001145  
201 WINDCO CIR, STE 200, WYLIE, TX 75098  
972-941-8400 FAX: 972-941-8401 WWW.ECDLP.COM

REVISIONS:	
1/25/2021	COMBINED LOTS A19 & A20
1/26/2021	2-1" IRRIGATION METERS
DRAWN: MJH	DATE:
CHECKED: RCK	DATE: 6/1/2020
PROJECT NO.: 08838	
DWG FILE NAME: 08838 UT.DWG	

THIS DOCUMENT IS RELEASED FOR THE PURPOSE OF CONSTRUCTION. THE SEAL APPEARING ON THIS DOCUMENT WAS AUTHORIZED BY RYAN C. KING, P.E. 123635





**WATER PLAN**

**NORTHGATE**

CITY OF ROCKWALL, ROCKWALL COUNTY, TEXAS


SHEET  
30  
OF  
40

\*ALL RESPONSIBILITY FOR ADEQUACY OF DESIGN REMAINS WITH THE DESIGN ENGINEER. THE CITY OF ROCKWALL, IN REVIEWING AND RELEASING PLANS FOR CONSTRUCTION, ASSUMES NO RESPONSIBILITY FOR ADEQUACY OR ACCURACY OF DESIGN.

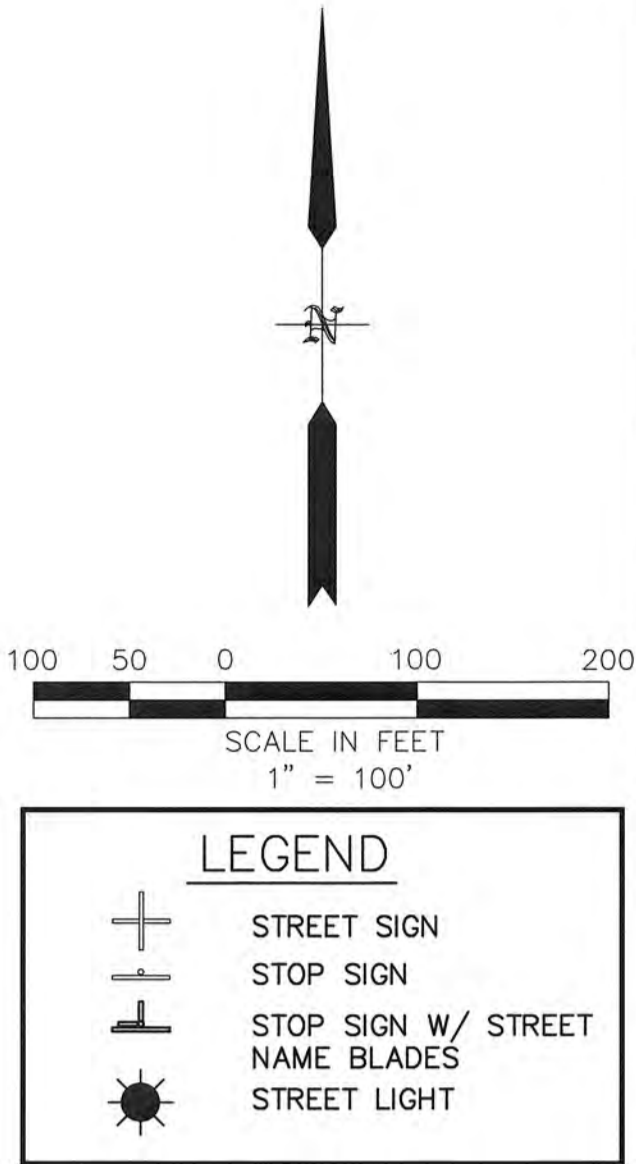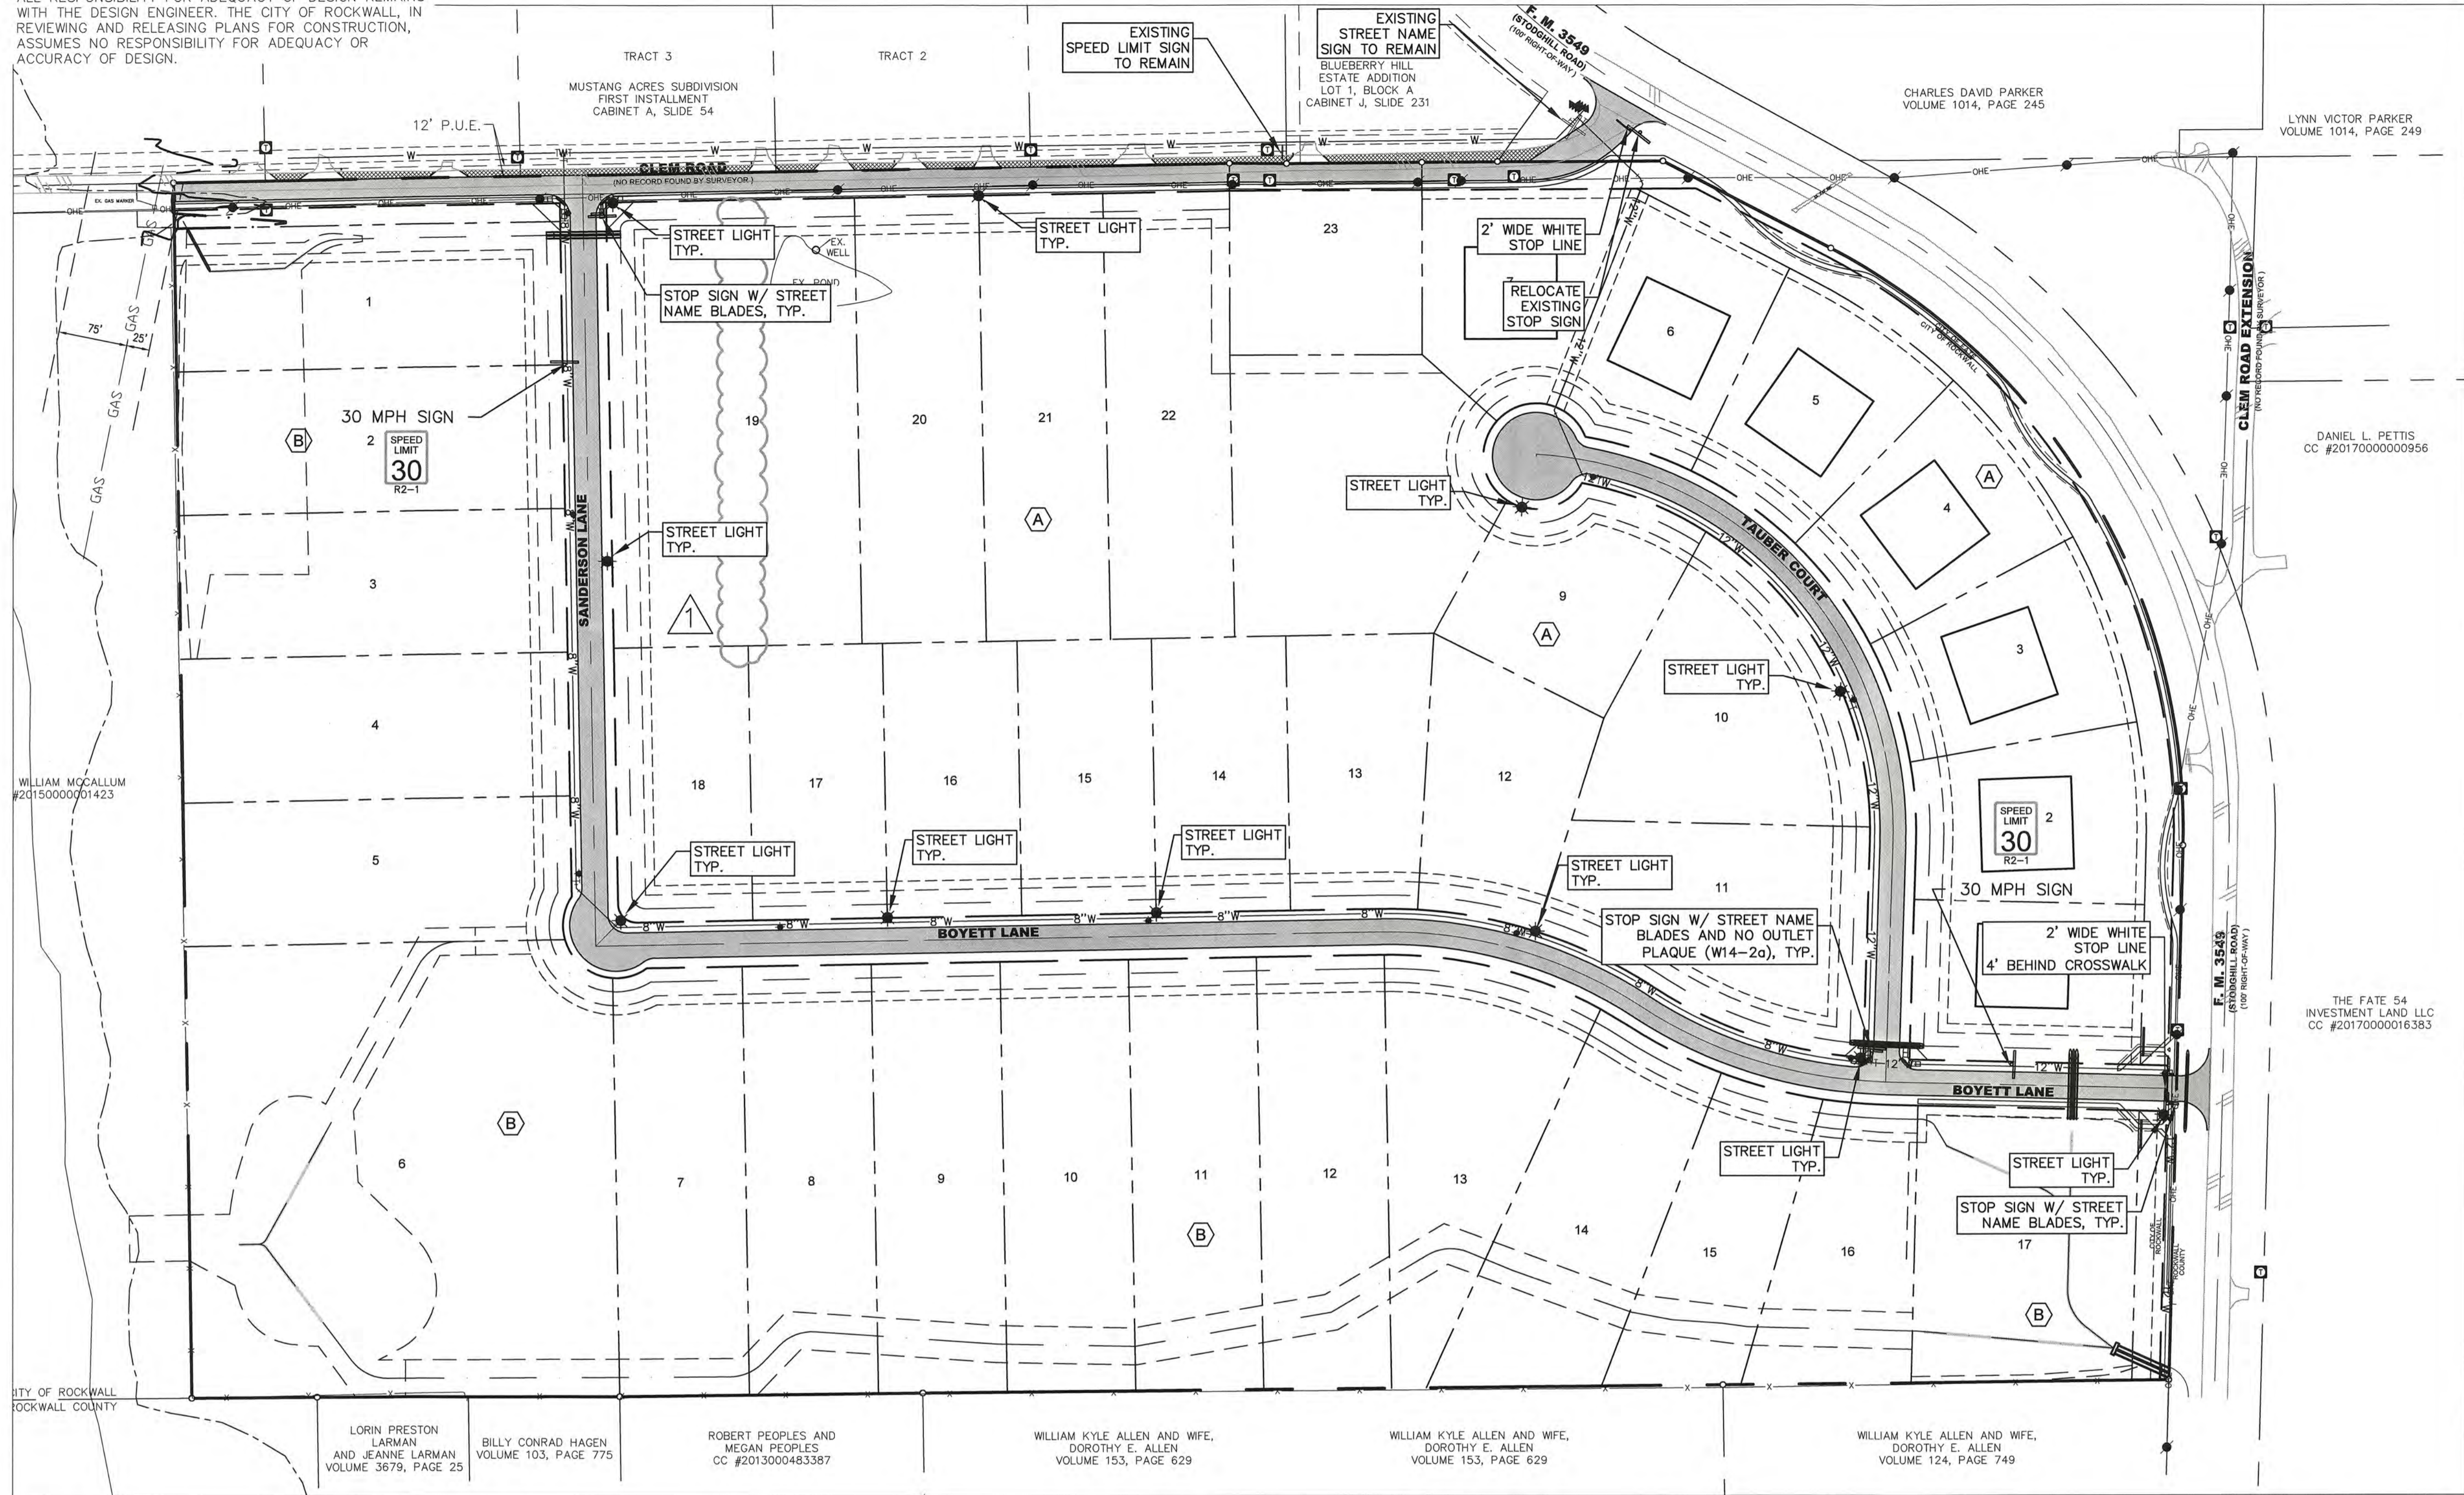

NOTE:  
IF THE DEVELOPER ELECTS TO INSTALL DECORATIVE SIGN POLES AND FIXTURES:  
-HOMEOWNERS ASSOCIATION WILL BE RESPONSIBLE FOR ALL CARE AND MAINTENANCE FOR ANY DECORATIVE SIGN POLES INSTALLED.  
-PLAT SHALL HAVE ITEM NOTE "HOA MUST MAINTAIN, REPAIR, AND REPLACE ALL NON-STANDARD STREET AND REGULATORY SIGN POLES AND FIXTURES OR OTHER APPROVED NON-STANDARD ITEMS."  
-THE CITY OF ROCKWALL WILL NOT BE RESPONSIBLE TO STORE OR HANDLE ANY DECORATIVE SIGN POST OR FIXTURES.  
-THE CITY OF ROCKWALL RESERVES THE RIGHT TO APPROVE OR DISAPPROVE ANY DECORATIVE NON-STANDARD STREET SIGN AND REGULATES SIGN POLES/POSTS AND FIXTURES.  
-STANDARD STREET AND REGULATORY 2' 8" GALVANIZED STEEL ROUND POST WITH ASSOCIATED FIXTURES TO BE USED.

A SAMPLE SIGN MUST BE SUBMITTED FOR APPROVAL BY THE CITY PRIOR TO FABRICATION OF ALL STREET SIGNS.

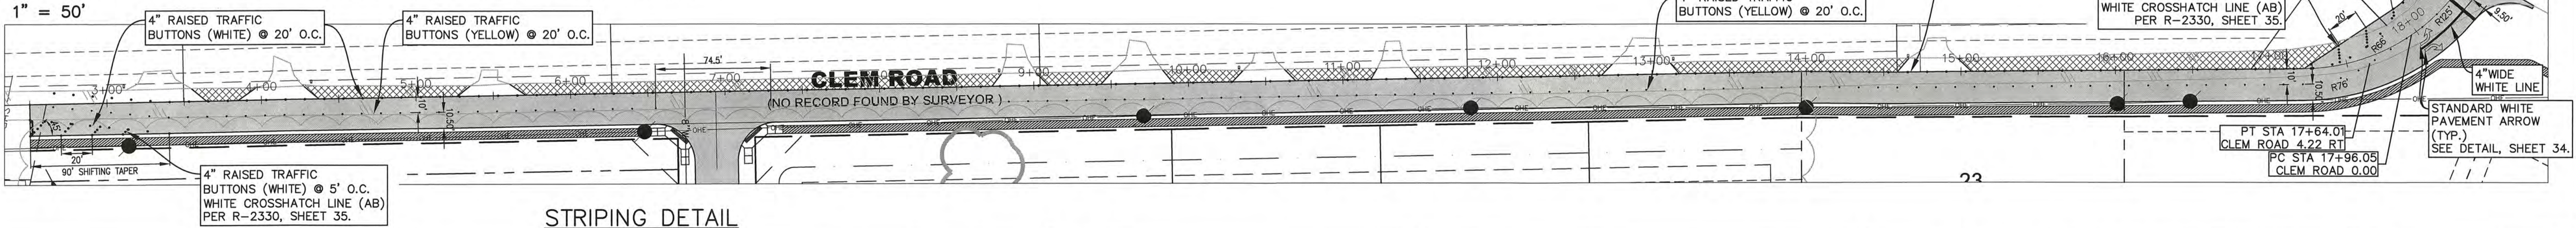

**CAUTION! EXISTING UTILITIES**  
CONTRACTOR SHOULD CALL 1-800-DIG-TESS PRIOR TO BEGINNING ANY CONSTRUCTION ACTIVITIES FOR EXISTING UTILITY LOCATIONS. EXISTING UTILITIES AND UNDERGROUND FACILITIES INDICATED ON THESE PLANS HAVE BEEN LOCATED FROM REFERENCE INFORMATION. IT IS THE RESPONSIBILITY OF THE CONTRACTOR TO VERIFY BOTH HORIZONTALLY AND VERTICALLY THE LOCATION OF ALL EXISTING UTILITIES AND UNDERGROUND FACILITIES PRIOR TO CONSTRUCTION AND TO TAKE NECESSARY PRECAUTIONS IN ORDER TO PROTECT ALL FACILITIES ENCOUNTERED. THE CONTRACTOR SHALL PRESERVE AND PROTECT ALL EXISTING UTILITIES FROM DAMAGE DURING CONSTRUCTION.

BM-1: "PK" Nail on the south side of Clem Road, approximately 2275' west of the centerline intersection of Clem Road and FM 3549  
Elev.: 559.07'

BM-2: "PK" Nail in Clem Road, approximately 175' west of the centerline intersection of Clem Road and FM 3549  
Elev.: 584.83'

**ENGINEERINGCONCEPTS**  
& DESIGN, L.P.  
ENGINEERING / PROJECT MANAGEMENT /  
CONSTRUCTION SERVICES - FIRM REG. #F-001145  
201 WINDCO CIR, STE 200, WYLIE, TX 75098  
972-941-8400 FAX: 972-941-8401 WWW.ECDLP.COM


REVISIONS:	
A 1/25/2021 COMBINED LOTS A19 & A20	
DRAWN: MJH	DATE:
CHECKED: RCK	DATE: 6/1/2020
PROJECT NO.: 08838	
DWG FILE NAME: 08838 SL.DWG	

THIS DOCUMENT IS RELEASED FOR THE PURPOSE OF CONSTRUCTION. THE SEAL APPEARING ON THIS DOCUMENT WAS AUTHORIZED BY RYAN C. KING, P.E. 123635




**STREET LIGHT AND SIGNAGE PLAN**  
**NORTHGATE**  
CITY OF ROCKWALL, ROCKWALL COUNTY, TEXAS

SHEET  
31  
OF  
40

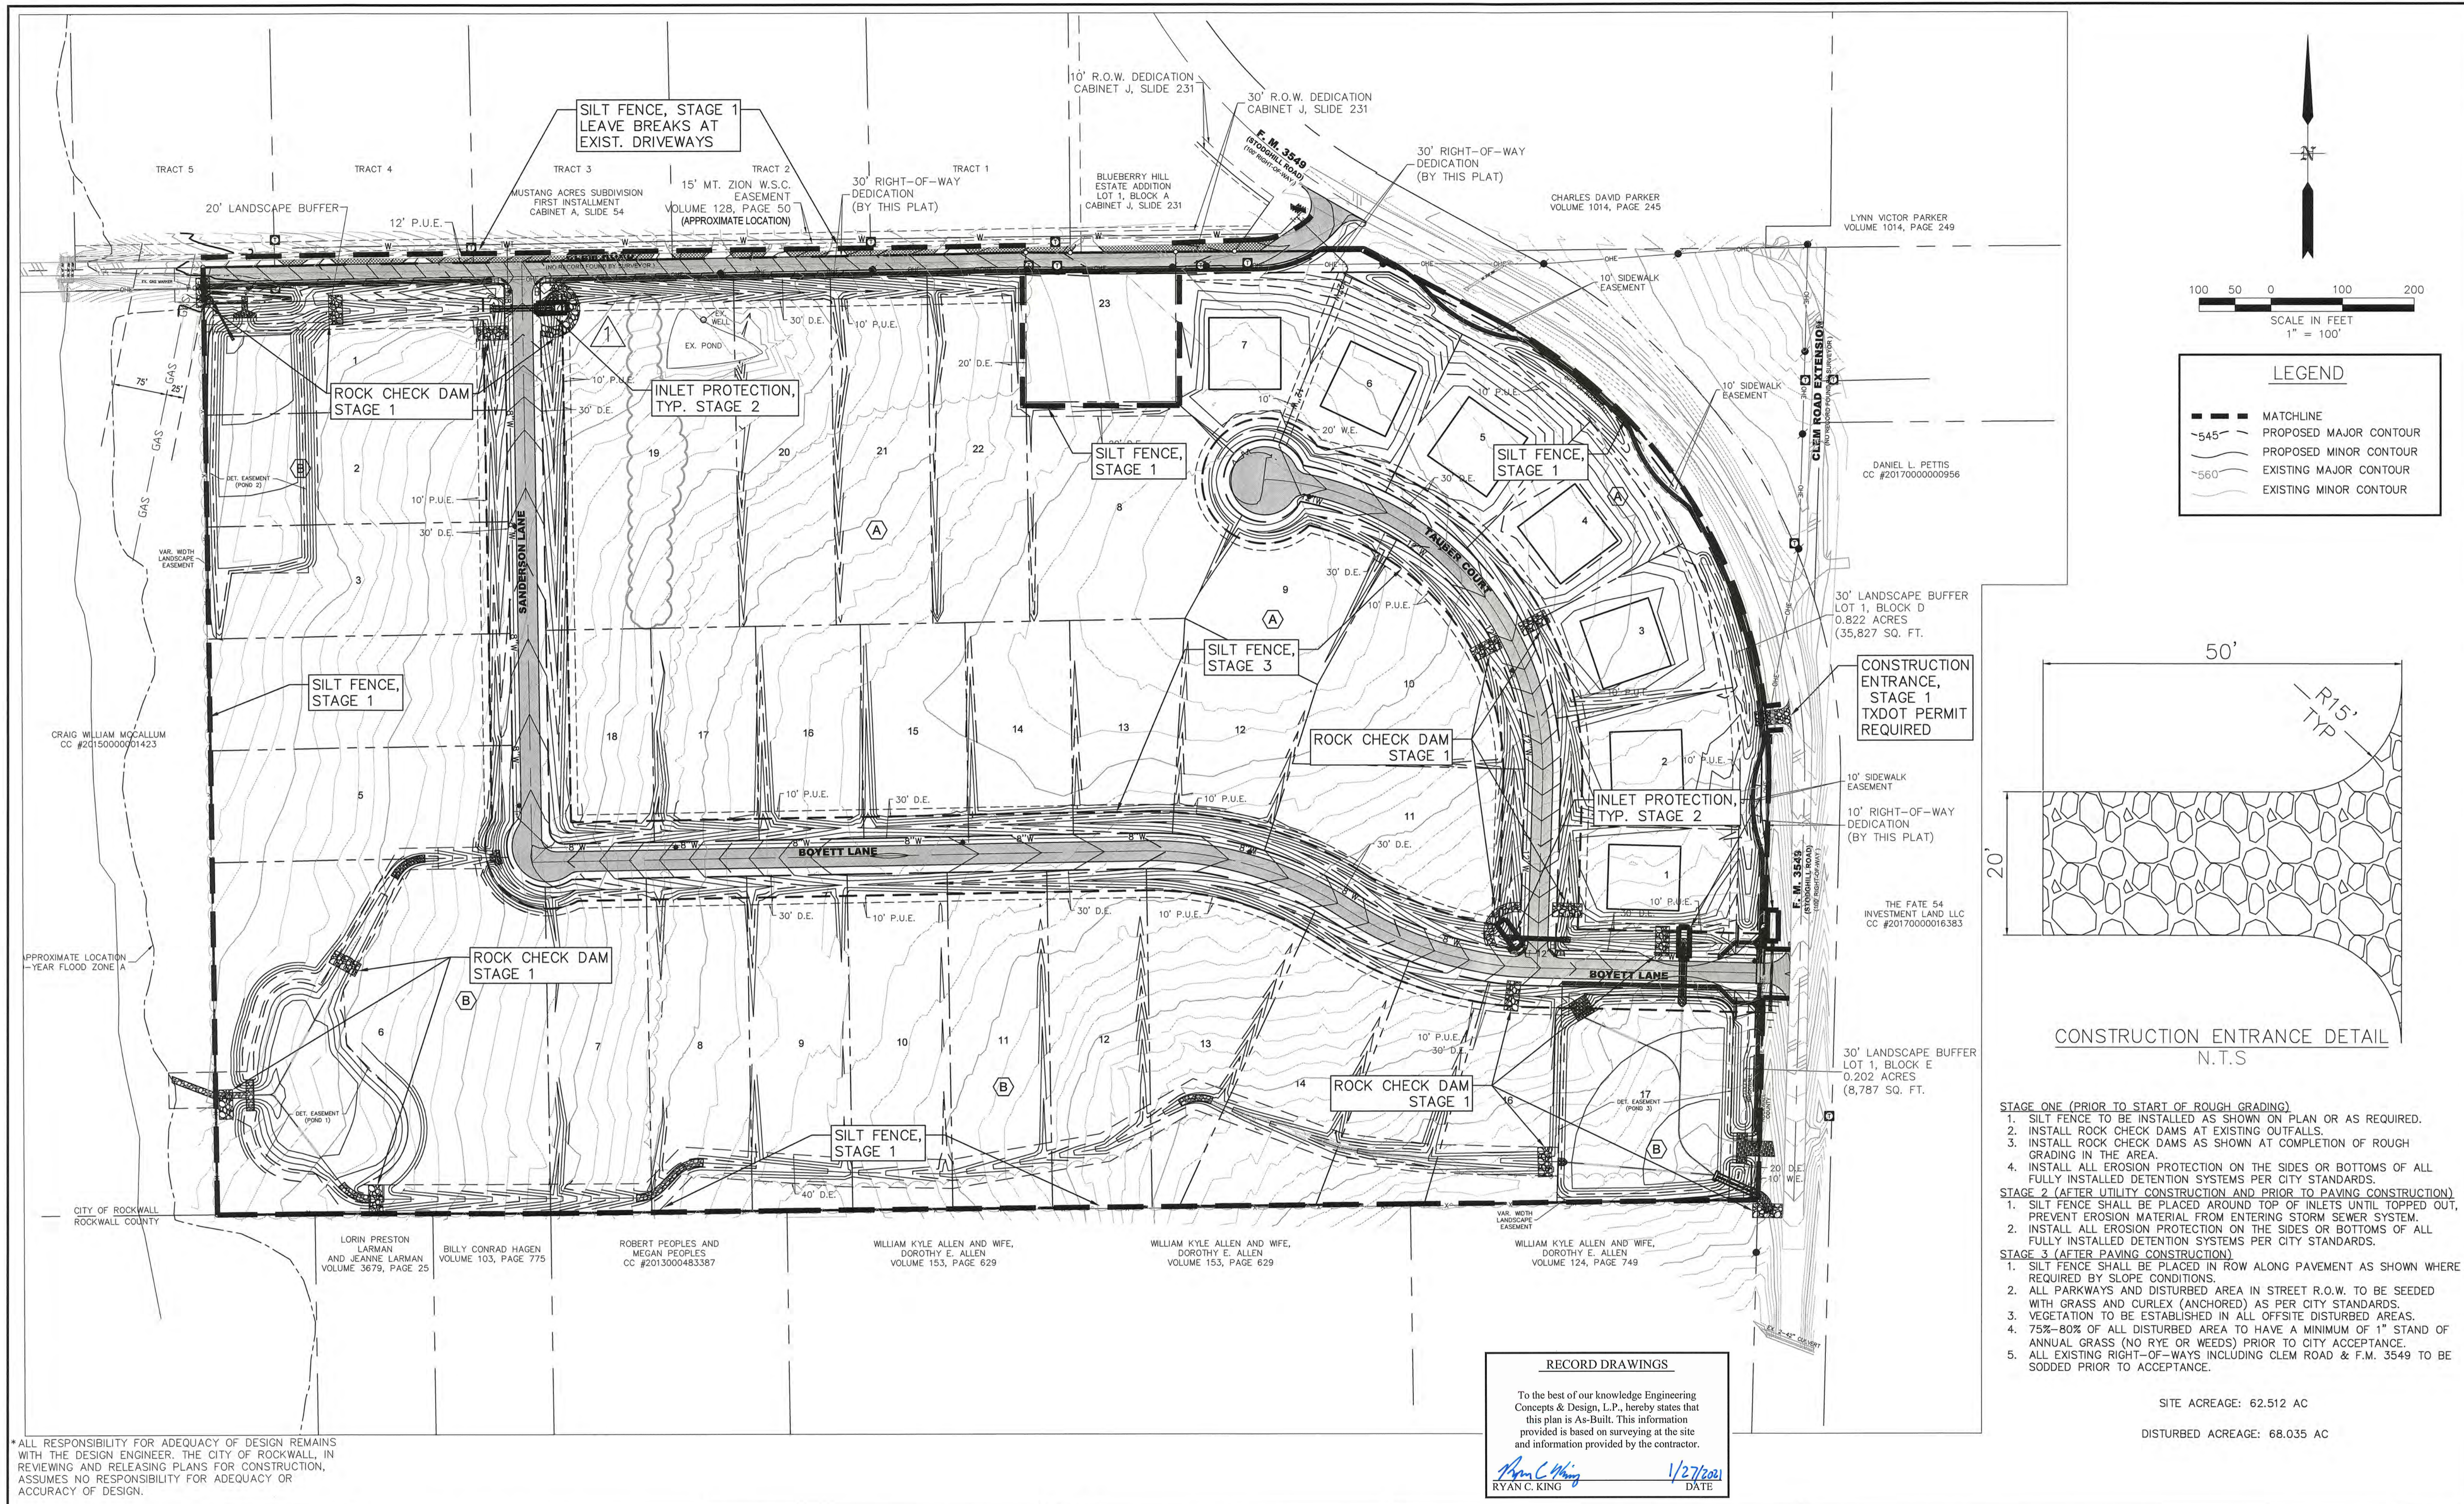

**LEGEND**

- MATCHLINE
- PROPOSED MAJOR CONTOUR
- PROPOSED MINOR CONTOUR
- EXISTING MAJOR CONTOUR
- EXISTING MINOR CONTOUR

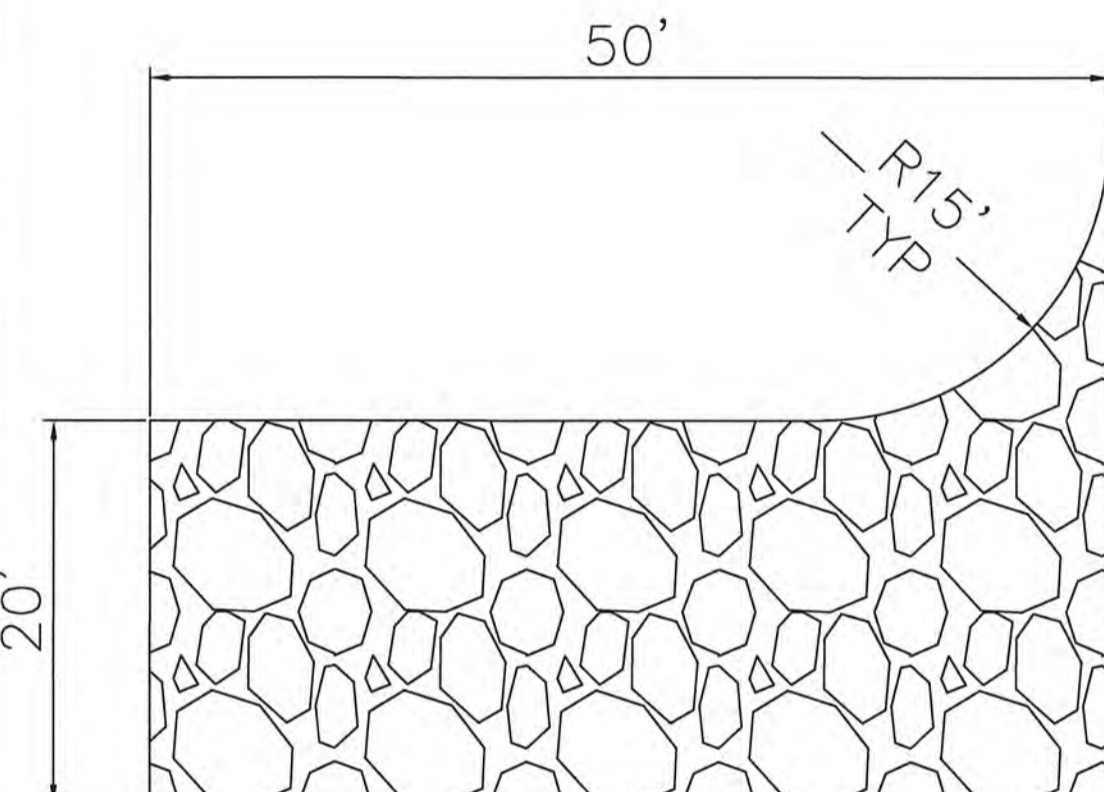

CONSTRUCTION ENTRANCE DETAIL  
N.T.S.

- STAGE ONE (PRIOR TO START OF ROUGH GRADING)**
1. SILT FENCE TO BE INSTALLED AS SHOWN ON PLAN OR AS REQUIRED.
  2. INSTALL ROCK CHECK DAMS AT EXISTING OUTFALLS.
  3. INSTALL ROCK CHECK DAMS AS SHOWN AT COMPLETION OF ROUGH GRADING IN THE AREA.
  4. INSTALL ALL EROSION PROTECTION ON THE SIDES OR BOTTOMS OF ALL FULLY INSTALLED DETENTION SYSTEMS PER CITY STANDARDS.
- STAGE TWO (AFTER UTILITY CONSTRUCTION AND PRIOR TO PAVING CONSTRUCTION)**
1. SILT FENCE SHALL BE PLACED AROUND TOP OF INLETS UNTIL TOPPED OUT, PREVENT EROSION MATERIAL FROM ENTERING STORM SEWER SYSTEM.
  2. INSTALL ALL EROSION PROTECTION ON THE SIDES OR BOTTOMS OF ALL FULLY INSTALLED DETENTION SYSTEMS PER CITY STANDARDS.
- STAGE THREE (AFTER PAVING CONSTRUCTION)**
1. SILT FENCE SHALL BE PLACED IN ROW ALONG PAVEMENT AS SHOWN WHERE REQUIRED BY SLOPE CONDITIONS.
  2. ALL PARKWAYS AND DISTURBED AREA IN STREET R.O.W. TO BE SEEDED WITH GRASS AND CURLEX (ANCHORED) AS PER CITY STANDARDS.
  3. VEGETATION TO BE ESTABLISHED IN ALL OFFSITE DISTURBED AREAS.
  4. 75%-80% OF ALL DISTURBED AREA TO HAVE A MINIMUM OF 1" STAND OF ANNUAL GRASS (NO RYE OR WEEDS) PRIOR TO CITY ACCEPTANCE.
  5. ALL EXISTING RIGHT-OF-WAYS INCLUDING CLEM ROAD & F.M. 3549 TO BE SODDED PRIOR TO ACCEPTANCE.

SITE ACREAGE: 62.512 AC  
DISTURBED ACREAGE: 68.035 AC

\*ALL RESPONSIBILITY FOR ADEQUACY OF DESIGN REMAINS WITH THE DESIGN ENGINEER. THE CITY OF ROCKWALL, IN REVIEWING AND RELEASING PLANS FOR CONSTRUCTION, ASSUMES NO RESPONSIBILITY FOR ADEQUACY OR ACCURACY OF DESIGN.

**RECORD DRAWINGS**

To the best of our knowledge Engineering Concepts & Design, L.P., hereby states that this plan is As-Built. This information provided is based on surveying at the site and information provided by the contractor.

*Ryan C. King*  
RYAN C. KING  
1/27/2021  
DATE

**CAUTION! EXISTING UTILITIES**

CONTRACTOR SHOULD CALL 1-800-DIG-TESS PRIOR TO BEGINNING ANY CONSTRUCTION ACTIVITIES FOR EXISTING UTILITY LOCATIONS. EXISTING UTILITIES AND UNDERGROUND FACILITIES INDICATED ON THESE PLANS HAVE BEEN LOCATED FROM REFERENCE INFORMATION. IT IS THE RESPONSIBILITY OF THE CONTRACTOR TO VERIFY BOTH HORIZONTALLY AND VERTICALLY THE LOCATION OF ALL EXISTING UTILITIES AND UNDERGROUND FACILITIES PRIOR TO CONSTRUCTION AND TO TAKE NECESSARY PRECAUTIONS IN ORDER TO PROTECT ALL FACILITIES ENCOUNTERED. THE CONTRACTOR SHALL PRESERVE AND PROTECT ALL EXISTING UTILITIES FROM DAMAGE DURING CONSTRUCTION.

BM-1: "PK" Nail on the south side of Clem Road, approximately 2275' west of the centerline intersection of Clem Road and FM 3549  
Elev.: 559.07'

BM-2: "PK" Nail in Clem Road, approximately 175' west of the centerline intersection of Clem Road and FM 3549  
Elev.: 584.83'

**ENGINEERINGCONCEPTS & DESIGN, L.P.**

ENGINEERING / PROJECT MANAGEMENT /  
CONSTRUCTION SERVICES - FIRM REG. #F-001145  
201 WINDCO CIR, STE 200, WYLIE, TX 75098  
972-941-8400 FAX: 972-941-8401 WWW.ECDLP.COM

REVISIONS:	
1/25/2021 COMBINED LOTS A19 & A20	
DRAWN: MJH	DATE:
CHECKED: RCK	DATE: 6/1/2020
PROJECT NO.: 08838	
DWG FILE NAME: 08838 EC.DWG	

THIS DOCUMENT IS RELEASED FOR THE PURPOSE OF CONSTRUCTION. THE SEAL APPEARING ON THIS DOCUMENT WAS AUTHORIZED BY RYAN C. KING, P.E. 123635


*Ryan C. King*  
RYAN C. KING  
1/25/2021  
DATE

**EROSION CONTROL PLAN**

**NORTHGATE**

CITY OF ROCKWALL, ROCKWALL COUNTY, TEXAS

SHEET  
32  
OF  
40

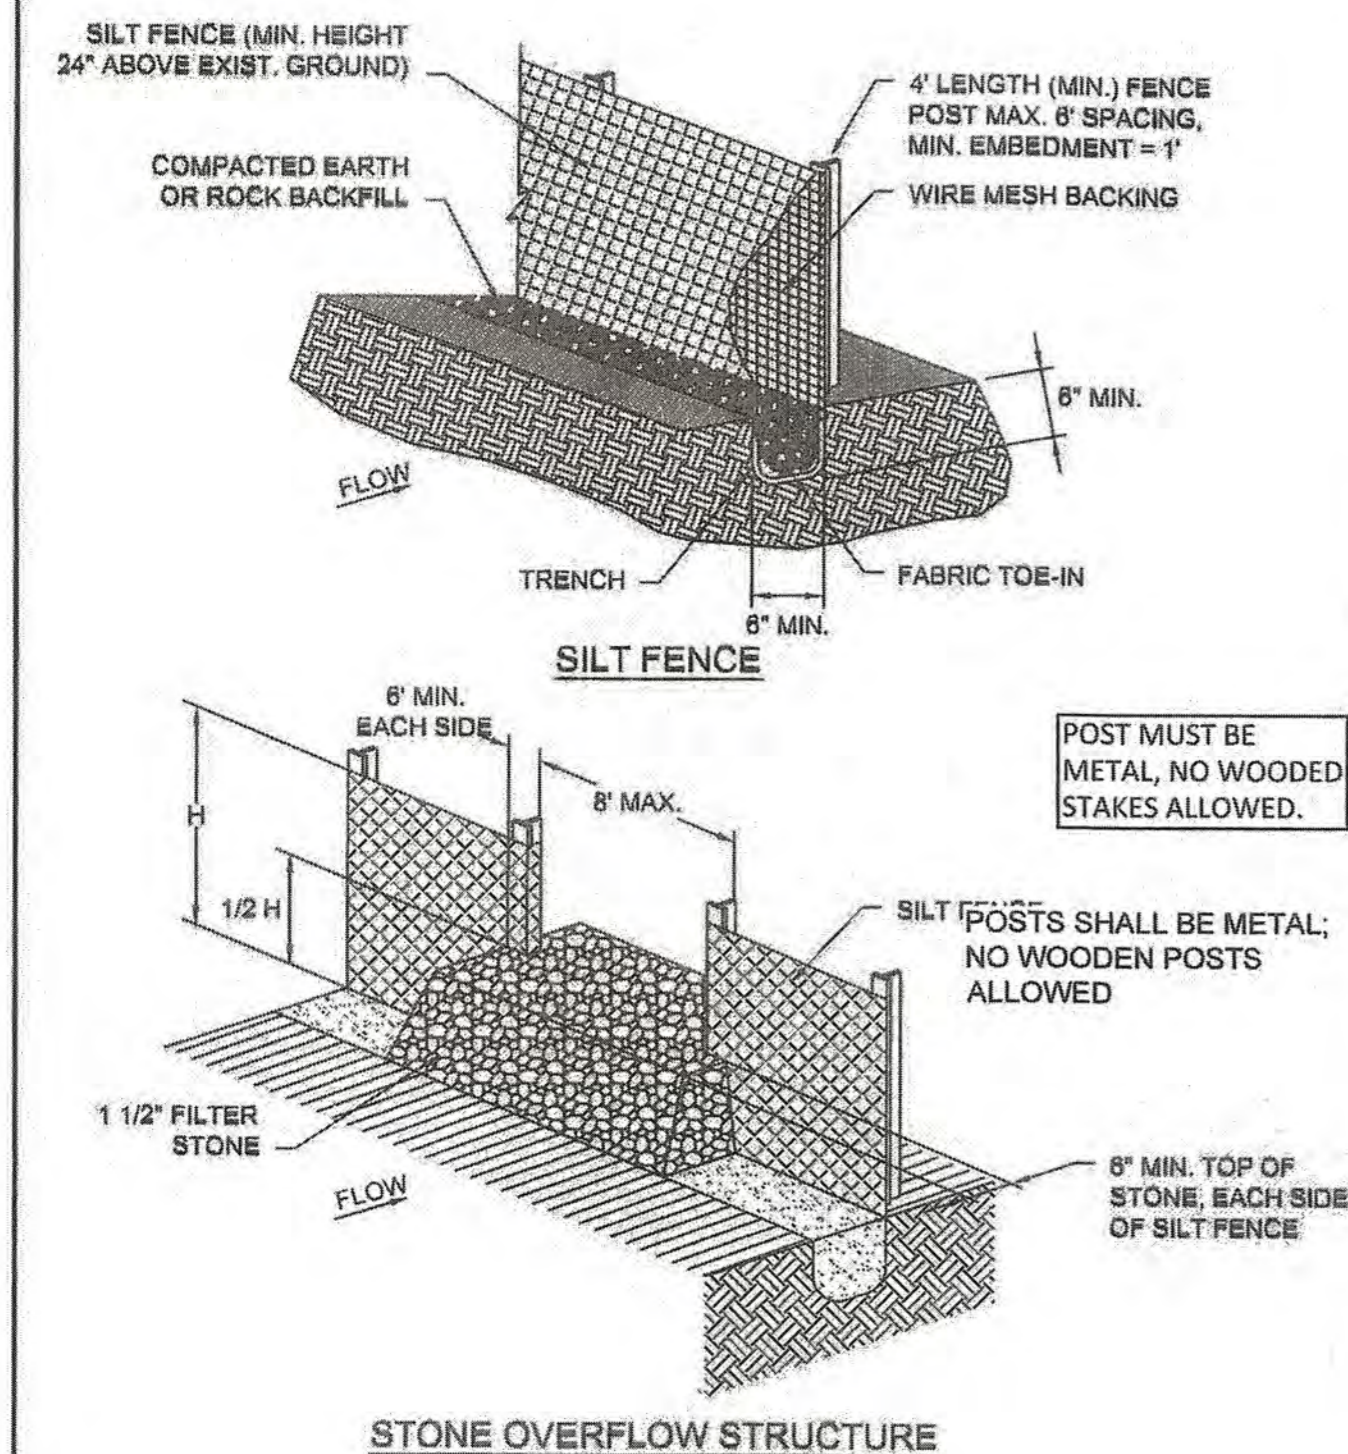

SILT FENCE	CITY OF ROCKWALL	STANDARD SPECIFICATION REFERENCE 202.5 *
		DATE Mar. 2018
		STANDARD DRAWING NO. R-1020A


\*Section II Standard Drawings as of October 2004. Reference number only has been updated for Fifth Edition Specifications. Public Works Construction Standards North Central Texas, Fifth Edition.

#### SILT FENCE GENERAL NOTES:

1. POSTS WHICH SUPPORT THE SILT FENCE SHALL BE INSTALLED ON A SLIGHT ANGLE TOWARD THE ANTICIPATED RUNOFF SOURCE. POST MUST BE EMBEDDED A MINIMUM OF ONE FOOT.
2. THE TOE OF THE SILT FENCE SHALL BE TRENCHED IN WITH A SPADE OR MECHANICAL TRENCHER, SO THAT THE DOWNSLOPE FACE OF THE TRENCH IS FLAT AND PERPENDICULAR TO THE LINE OF FLOW. WHERE FENCE CANNOT BE TRENCHED IN (e.g. PAVEMENT), WEIGHT FABRIC FLAP WITH ROCK ON UPHILL SIDE TO PREVENT FLOW FROM SEEPING UNDER FENCE.
3. THE TRENCH MUST BE A MINIMUM OF 6 INCHES DEEP AND 6 INCHES WIDE TO ALLOW FOR THE SILT FENCE FABRIC TO BE LAID IN THE GROUND AND BACKFILLED WITH COMPACTED MATERIAL.
4. SILT FENCE SHOULD BE SECURELY FASTENED TO EACH SUPPORT POST OR TO WIRE BACKING, WHICH IN TURN IS ATTACHED TO THE FENCE POST. THERE SHALL BE A 3 FOOT OVERLAP, SECURELY FASTENED WHERE ENDS OF FABRIC MEET.
5. INSPECTION SHALL BE AS SPECIFIED IN THE SWPPP. REPAIR OR REPLACEMENT SHALL BE MADE PROMPTLY AS NEEDED.
6. SILT FENCE SHALL BE REMOVED WHEN FINAL STABILIZATION IS ACHIEVED OR ANOTHER EROSION OR SEDIMENT CONTROL DEVICE IS EMPLOYED.
7. ACCUMULATED SILT SHALL BE REMOVED WHEN IT REACHES A DEPTH OF HALF THE HEIGHT OF THE FENCE. THE SILT SHALL BE DISPOSED OF AT AN APPROVED SITE AND IN SUCH A MANNER AS TO NOT CONTRIBUTE TO ADDITIONAL SILTATION.
8. FILTER STONE SHALL BE WRAPPED IN FILTER FABRIC AND BURIED SIX (6") INCHES MINIMUM.

SILT FENCE	CITY OF ROCKWALL	STANDARD SPECIFICATION REFERENCE 202.5 *
		DATE Mar. 2018
		STANDARD DRAWING NO. R-1020B

\*Section II Standard Drawings as of October 2004. Reference number only has been updated for Fifth Edition Specifications. Public Works Construction Standards North Central Texas, Fifth Edition.

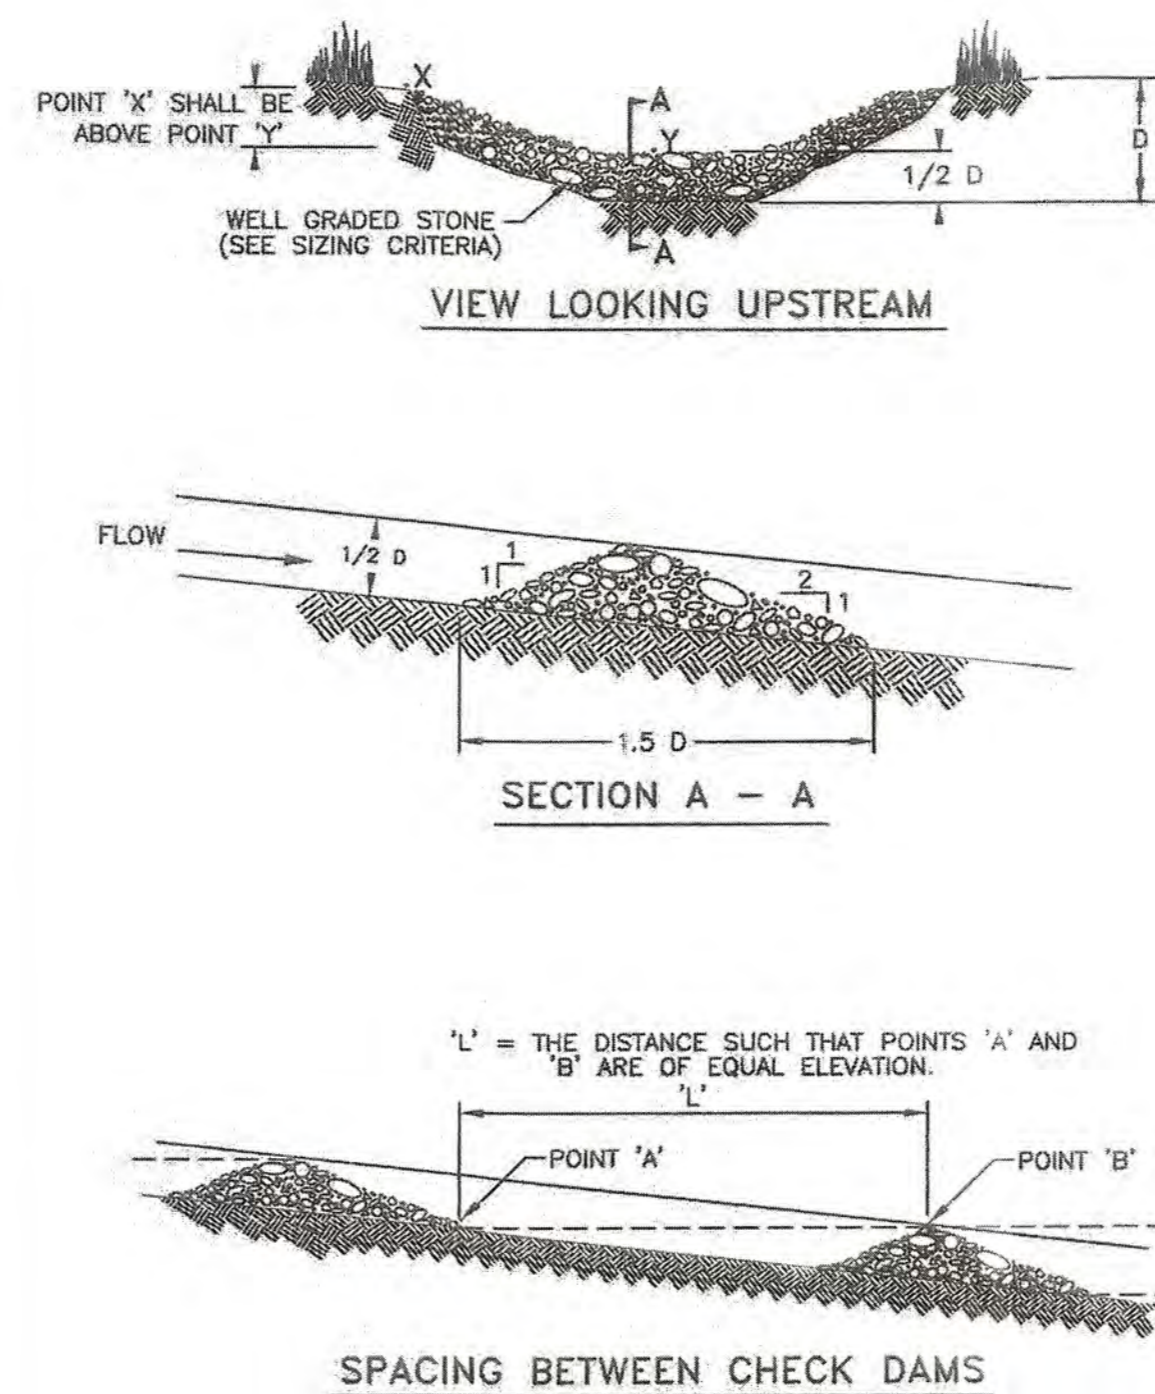


ROCK CHECK DAM	CITY OF ROCKWALL	STANDARD SPECIFICATION REFERENCE 201.9
		DATE OCT. '04
		STANDARD DRAWING NO. 1060A

#### ROCK CHECK DAM GENERAL NOTES:

1. STONE SHALL BE WELL GRADED WITH SIZE RANGE FROM 1 1/2 TO 3 1/2 INCHES IN DIAMETER DEPENDING ON EXPECTED FLOWS.
2. THE CHECK DAM SHALL BE INSPECTED AS SPECIFIED IN THE SWPPP AND SHALL BE REPLACED WHEN THE STRUCTURE CEASES TO FUNCTION AS INTENDED DUE TO SILT ACCUMULATION AMONG THE ROCKS, WASHOUT, CONSTRUCTION TRAFFIC DAMAGE, ETC.
3. WHEN SILT REACHES A DEPTH EQUAL TO ONE-THIRD OF THE HEIGHT OF THE CHECK DAM OR ONE FOOT, WHICHEVER IS LESS, THE SILT SHALL BE REMOVED AND DISPOSED OF PROPERLY.
4. WHEN THE SITE HAS ACHIEVED FINAL STABILIZATION OR ANOTHER EROSION OR SEDIMENT CONTROL DEVICE IS EMPLOYED, THE CHECK DAM AND ACCUMULATED SILT SHALL BE REMOVED AND DISPOSED OF IN AN APPROVED MANNER.
5. FILTER STONE SHALL BE WRAPPED IN APPROPRIATE SIZED WIRE MESH TO CONTAIN STONE AND BURIED SIX (6") INCHES MINIMUM.

ROCK CHECK DAM	CITY OF ROCKWALL	STANDARD SPECIFICATION REFERENCE 202.9 *
		DATE Mar. 2018
		STANDARD DRAWING NO. R-1060B

\*Section II Standard Drawings as of October 2004. Reference number only has been updated for Fifth Edition Specifications. Public Works Construction Standards North Central Texas, Fifth Edition.

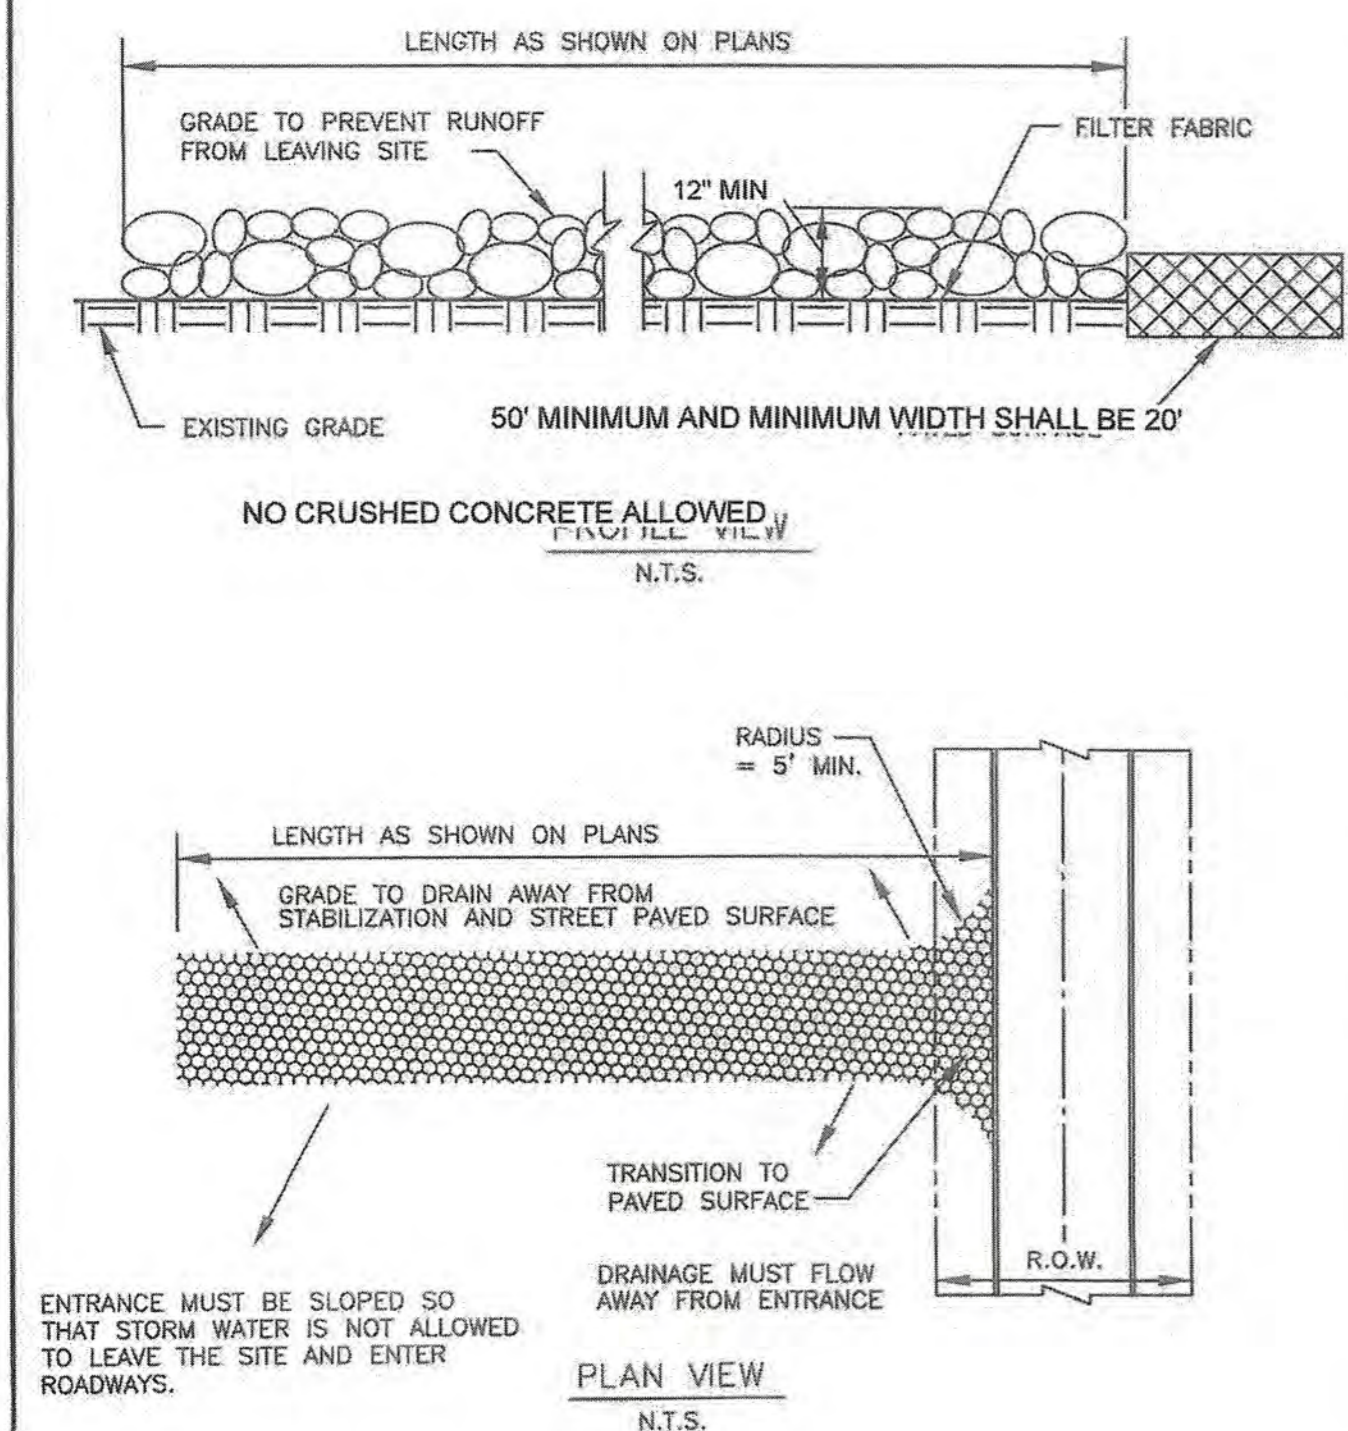

STABILIZED CONSTRUCTION ENTRANCE	CITY OF ROCKWALL	STANDARD SPECIFICATION REFERENCE 201.10
		DATE OCT. '04
		STANDARD DRAWING NO. 1070A

#### STABILIZED CONSTRUCTION ENTRANCE GENERAL NOTES:

1. STONE SHALL BE 4 TO 6 INCH DIAMETER COARSE AGGREGATE.
2. MINIMUM LENGTH SHALL BE 50 FEET AND WIDTH SHALL BE 20 FEET.
3. THE THICKNESS SHALL NOT BE LESS THAN 12 INCHES.
4. THE WIDTH SHALL BE NO LESS THAN THE FULL WIDTH OF ALL POINTS OF INGRESS OR EGRESS.
5. WHEN NECESSARY, VEHICLES SHALL BE CLEANED TO REMOVE SEDIMENT PRIOR TO ENTRANCE ONTO A PUBLIC ROADWAY. WHEN WASHING IS REQUIRED, IT SHALL BE DONE ON AN AREA STABILIZED WITH CRUSHED STONE WITH DRAINAGE FLOWING AWAY FROM BOTH THE STREET AND THE STABILIZED ENTRANCE. ALL SEDIMENT SHALL BE PREVENTED FROM ENTERING ANY STORM DRAIN, DITCH OR WATERCOURSE USING APPROVED METHODS.
6. THE ENTRANCE SHALL BE MAINTAINED IN A CONDITION WHICH WILL PREVENT TRACKING OR FLOWING OF SEDIMENT ONTO PAVED SURFACES. THIS MAY REQUIRE PERIODIC TOP DRESSING WITH ADDITIONAL STONE AS CONDITIONS DEMAND. ALL SEDIMENT SPILLED, DROPPED, WASHED, OR TRACKED ONTO PAVED SURFACES MUST BE REMOVED IMMEDIATELY.
7. THE ENTRANCE MUST BE PROPERLY GRADED OR INCORPORATE A DRAINAGE SWALE TO PREVENT RUNOFF FROM LEAVING THE CONSTRUCTION SITE.
8. PREVENT SHORTCUTTING OF THE FULL LENGTH OF THE CONSTRUCTION ENTRANCE BY INSTALLING BARRIERS AS NECESSARY.
9. INSPECTION SHALL BE AS SPECIFIED IN THE SWPPP.
10. NO CRUSHED OR RECYCLED CONCRETE ALLOWED.

STABILIZED CONSTRUCTION ENTRANCE	CITY OF ROCKWALL	STANDARD SPECIFICATION REFERENCE 202.11 *
		DATE Mar. 2018
		STANDARD DRAWING NO. R-1070B

\*Section II Standard Drawings as of October 2004. Reference number only has been updated for Fifth Edition Specifications. Public Works Construction Standards North Central Texas, Fifth Edition.

#### RECORD DRAWINGS

To the best of our knowledge Engineering Concepts & Design, L.P., hereby states that this plan is As-Built. This information provided is based on surveying at the site and information provided by the contractor.

RYAN C. KING  
DATE: 1/27/2021

RELEASED FOR CONSTRUCTION  
ALL RESPONSIBILITY FOR ADEQUACY OF DESIGN  
REMAINS WITH THE DESIGN ENGINEER. THE CITY  
OF ROCKWALL, IN REVIEWING AND RELEASING  
PLANS FOR CONSTRUCTION, ASSUMES NO  
RESPONSIBILITY FOR ADEQUACY OR ACCURACY OF  
DESIGN.

CITY: \_\_\_\_\_ DATE: \_\_\_\_\_



ENGINEERING / PROJECT MANAGEMENT /  
CONSTRUCTION SERVICES - FIRM REG. #F-001145  
201 WINDCO CIR, STE 200, WYLIE, TX 75098  
972-941-8400 FAX: 972-941-8401 WWW.ECDLP.COM

REVISIONS:	
DRAWN: MJH	DATE:
CHECKED: RCK	DATE: 6/1/2020
PROJECT NO.: 08838	
DWG FILE NAME: 08838 DT.DWG	

THIS DOCUMENT IS RELEASED FOR  
THE PURPOSE OF CONSTRUCTION.  
THE SEAL APPEARING ON THIS DOCUMENT WAS  
AUTHORIZED BY RYAN C. KING, P.E. 123635













EROSION CONTROL DETAILS  
NORTHGATE  
CITY OF ROCKWALL, ROCKWALL COUNTY, TEXAS

SHEET  
33  
OF  
40

**CAUTION! EXISTING UTILITIES**  
CONTRACTOR SHOULD CALL 1-800-895-1111 PRIOR TO BEGINNING ANY  
CONSTRUCTION ACTIVITIES FOR EXISTING UTILITY LOCATIONS. EXISTING UTILITIES  
AND UNDERGROUND FACILITIES INDICATED ON THESE PLANS HAVE BEEN LOCATED  
FROM REFERENCE INFORMATION. IT IS THE RESPONSIBILITY OF THE CONTRACTOR  
TO VERIFY BOTH HORIZONTALLY AND VERTICALLY THE LOCATION OF ALL EXISTING  
UTILITIES AND UNDERGROUND FACILITIES PRIOR TO CONSTRUCTION AND TO TAKE  
NECESSARY PRECAUTIONS IN ORDER TO PROTECT ALL FACILITIES ENCOUNTERED.  
THE CONTRACTOR SHALL PRESERVE AND PROTECT ALL EXISTING UTILITIES FROM  
DAMAGE DURING CONSTRUCTION.

BM-1: "PK" Nail on the south side of Clem Road,  
approximately 2275' west of the centerline intersection  
of Clem Road and FM 3549  
Elev.: 559.07'

BM-2: "PK" Nail in Clem Road,  
approximately 175' west of the centerline intersection  
of Clem Road and FM 3549  
Elev.: 584.83'

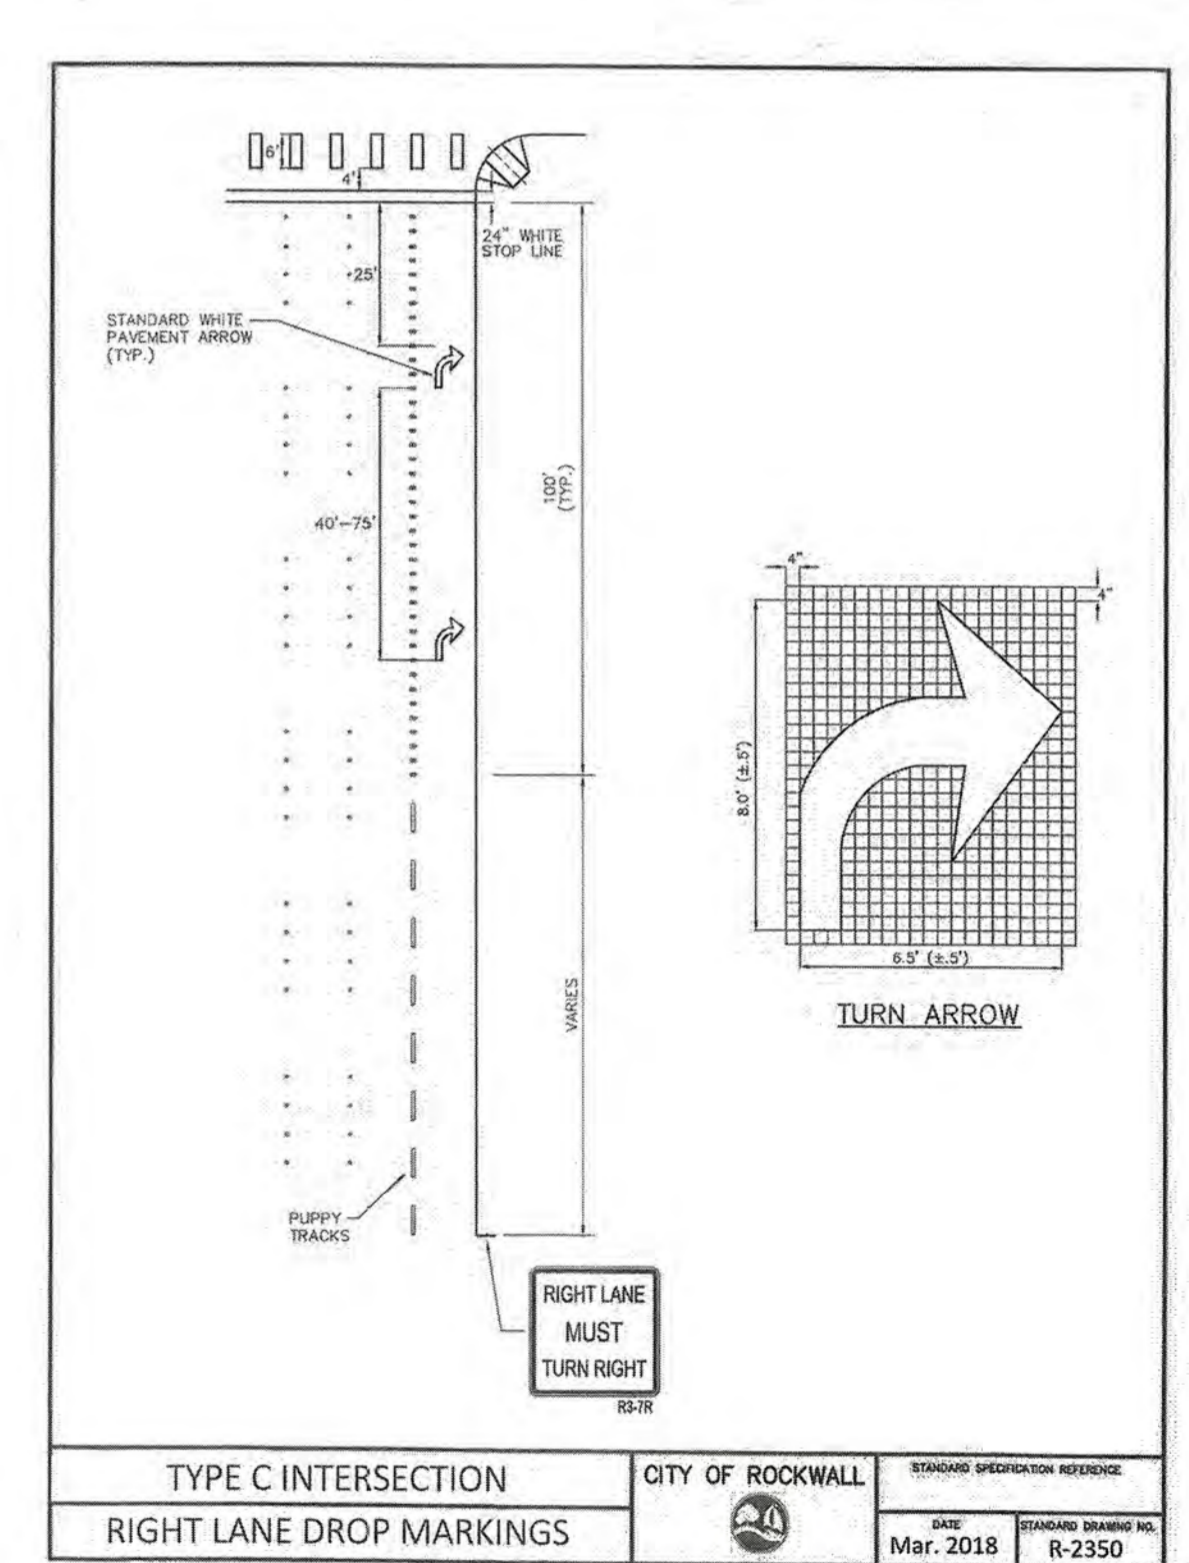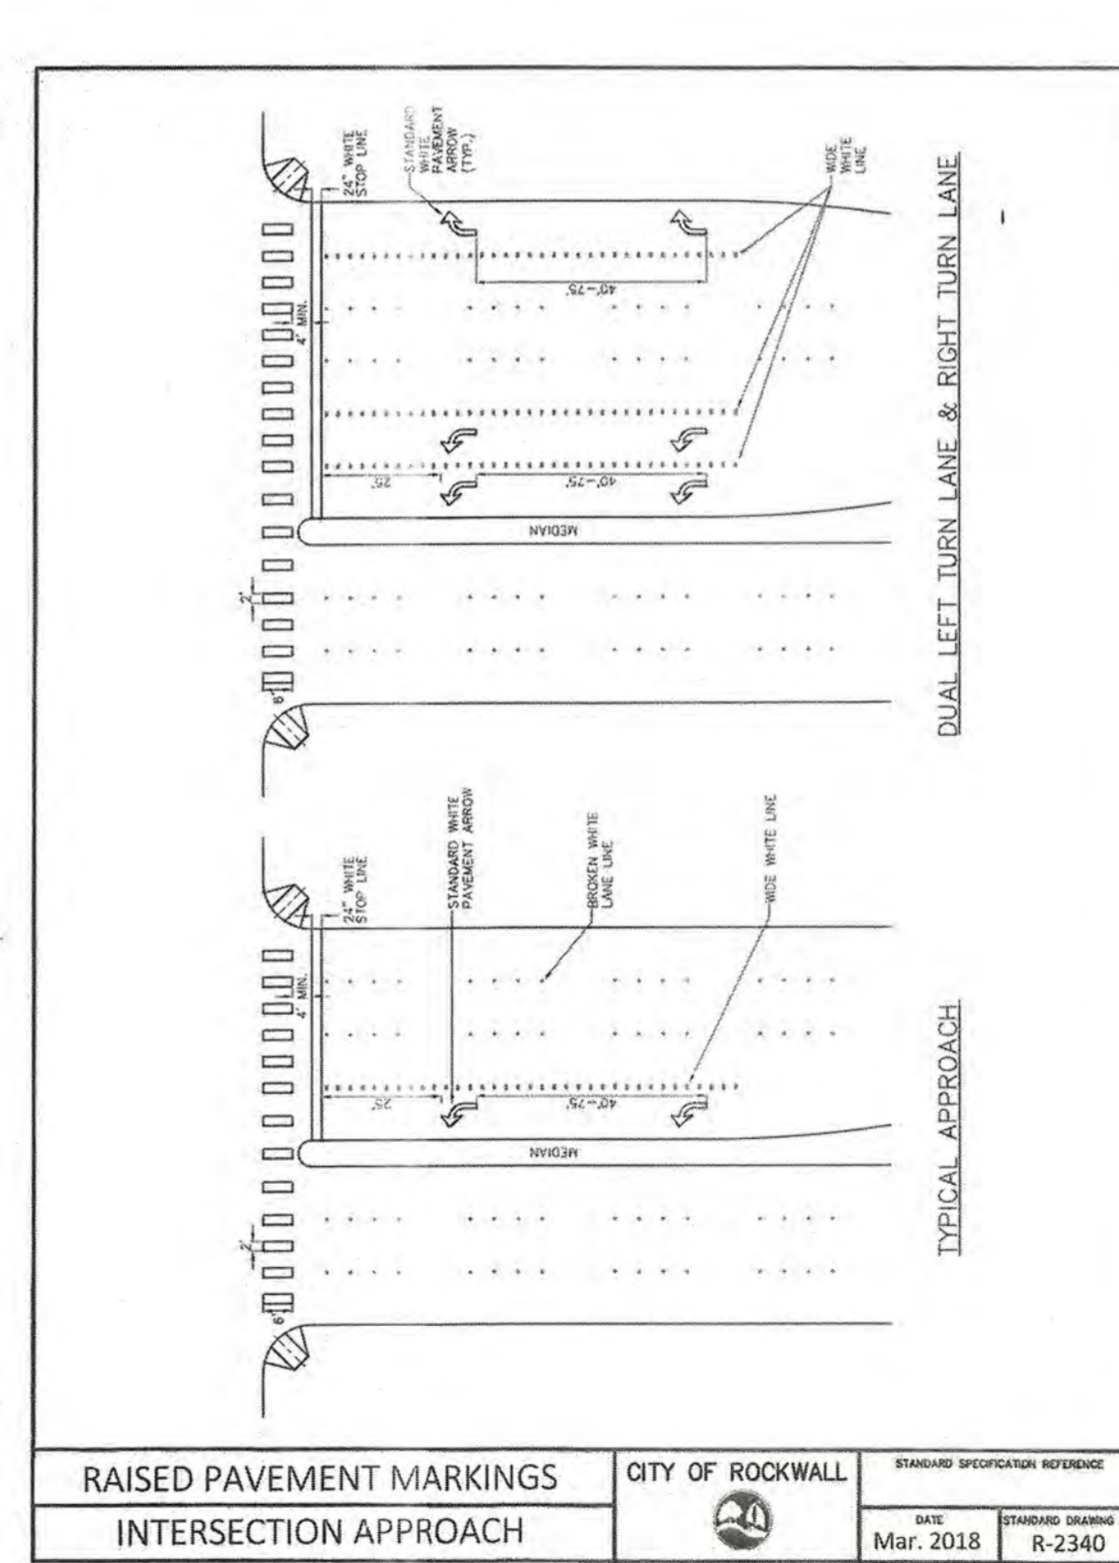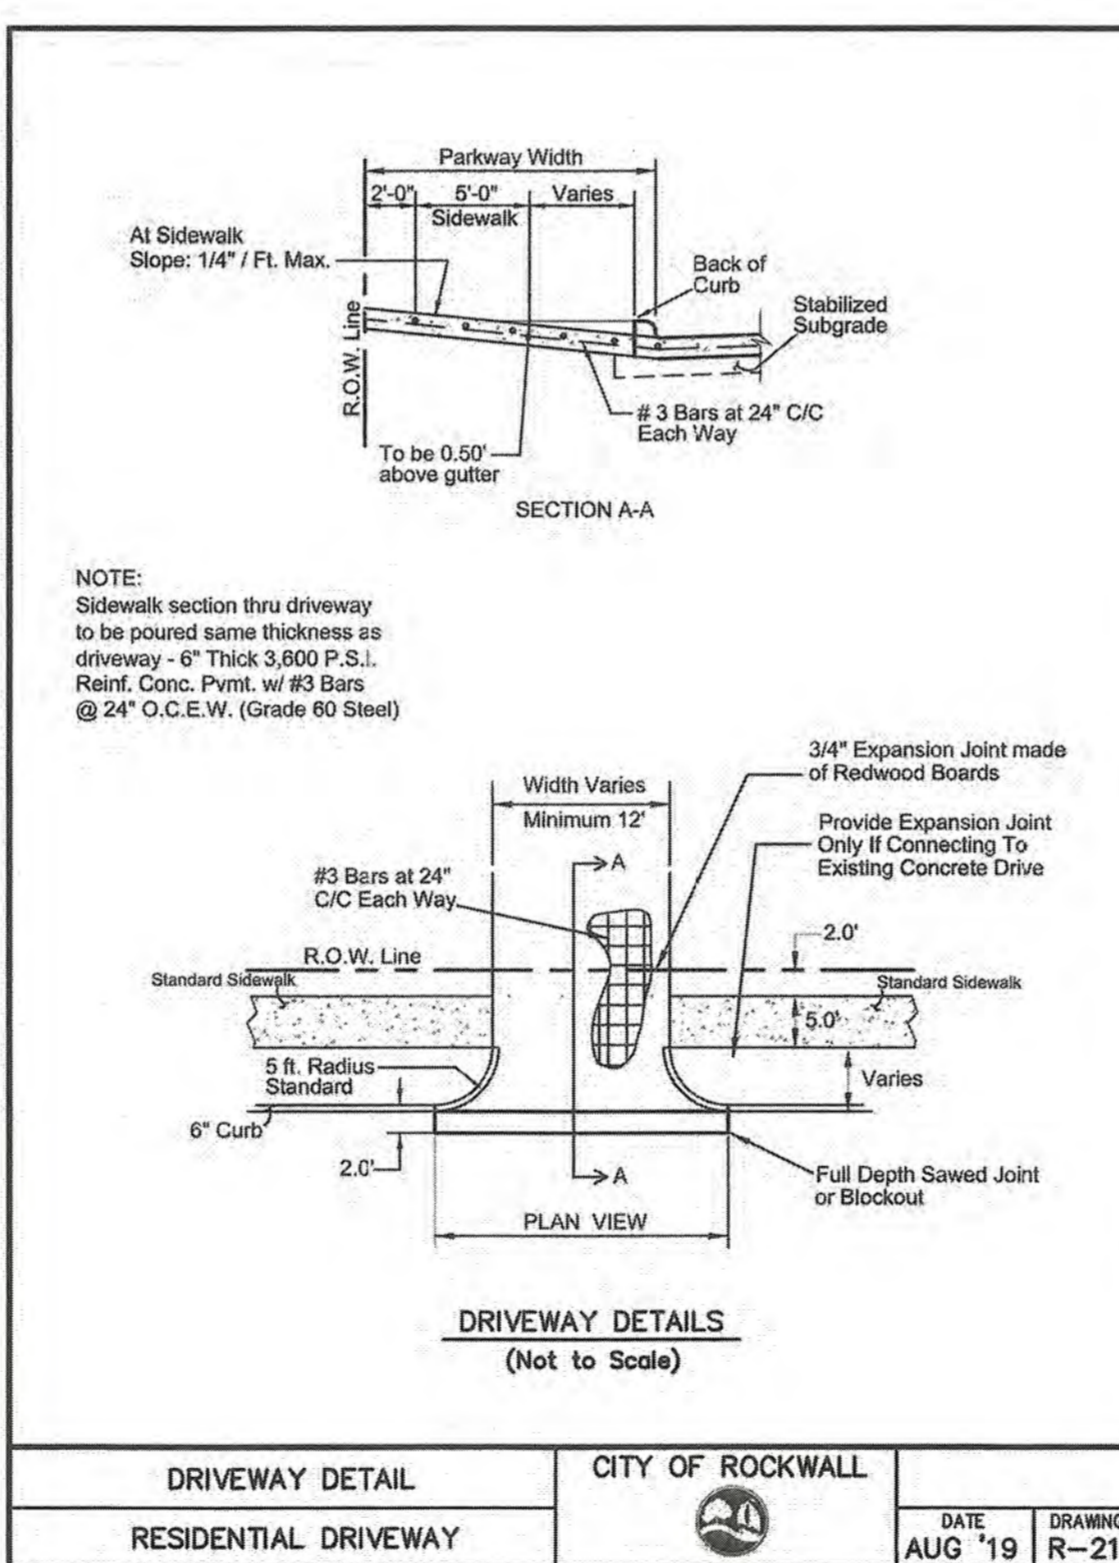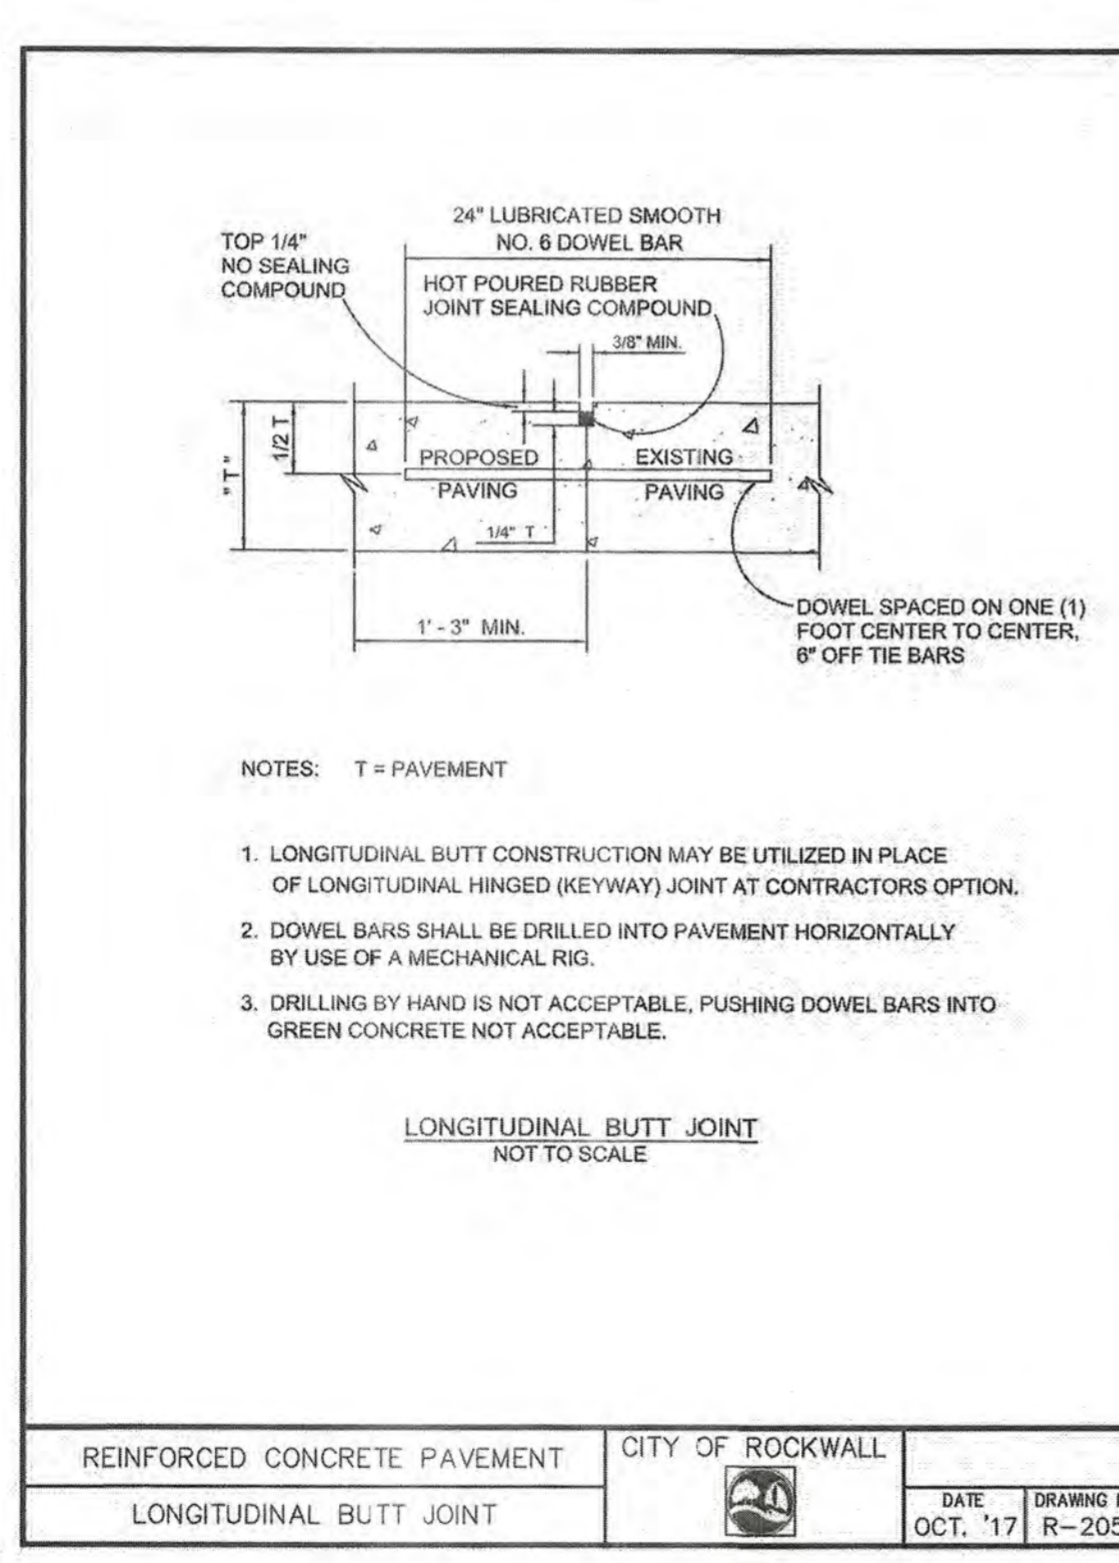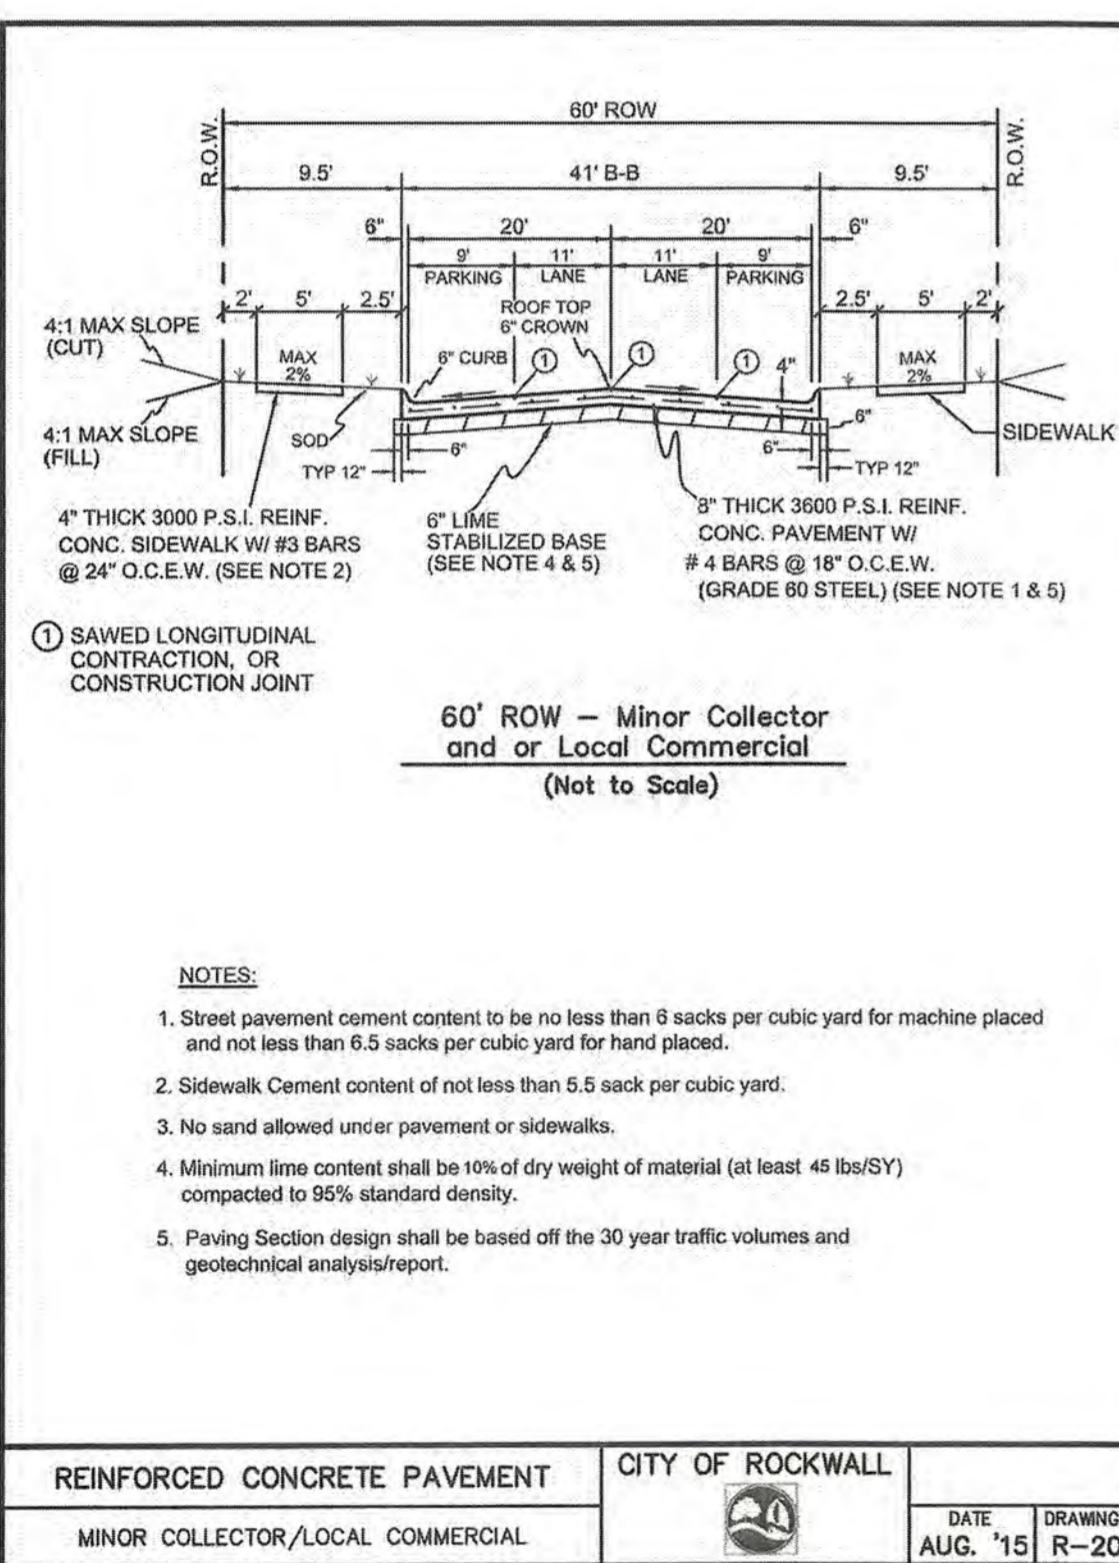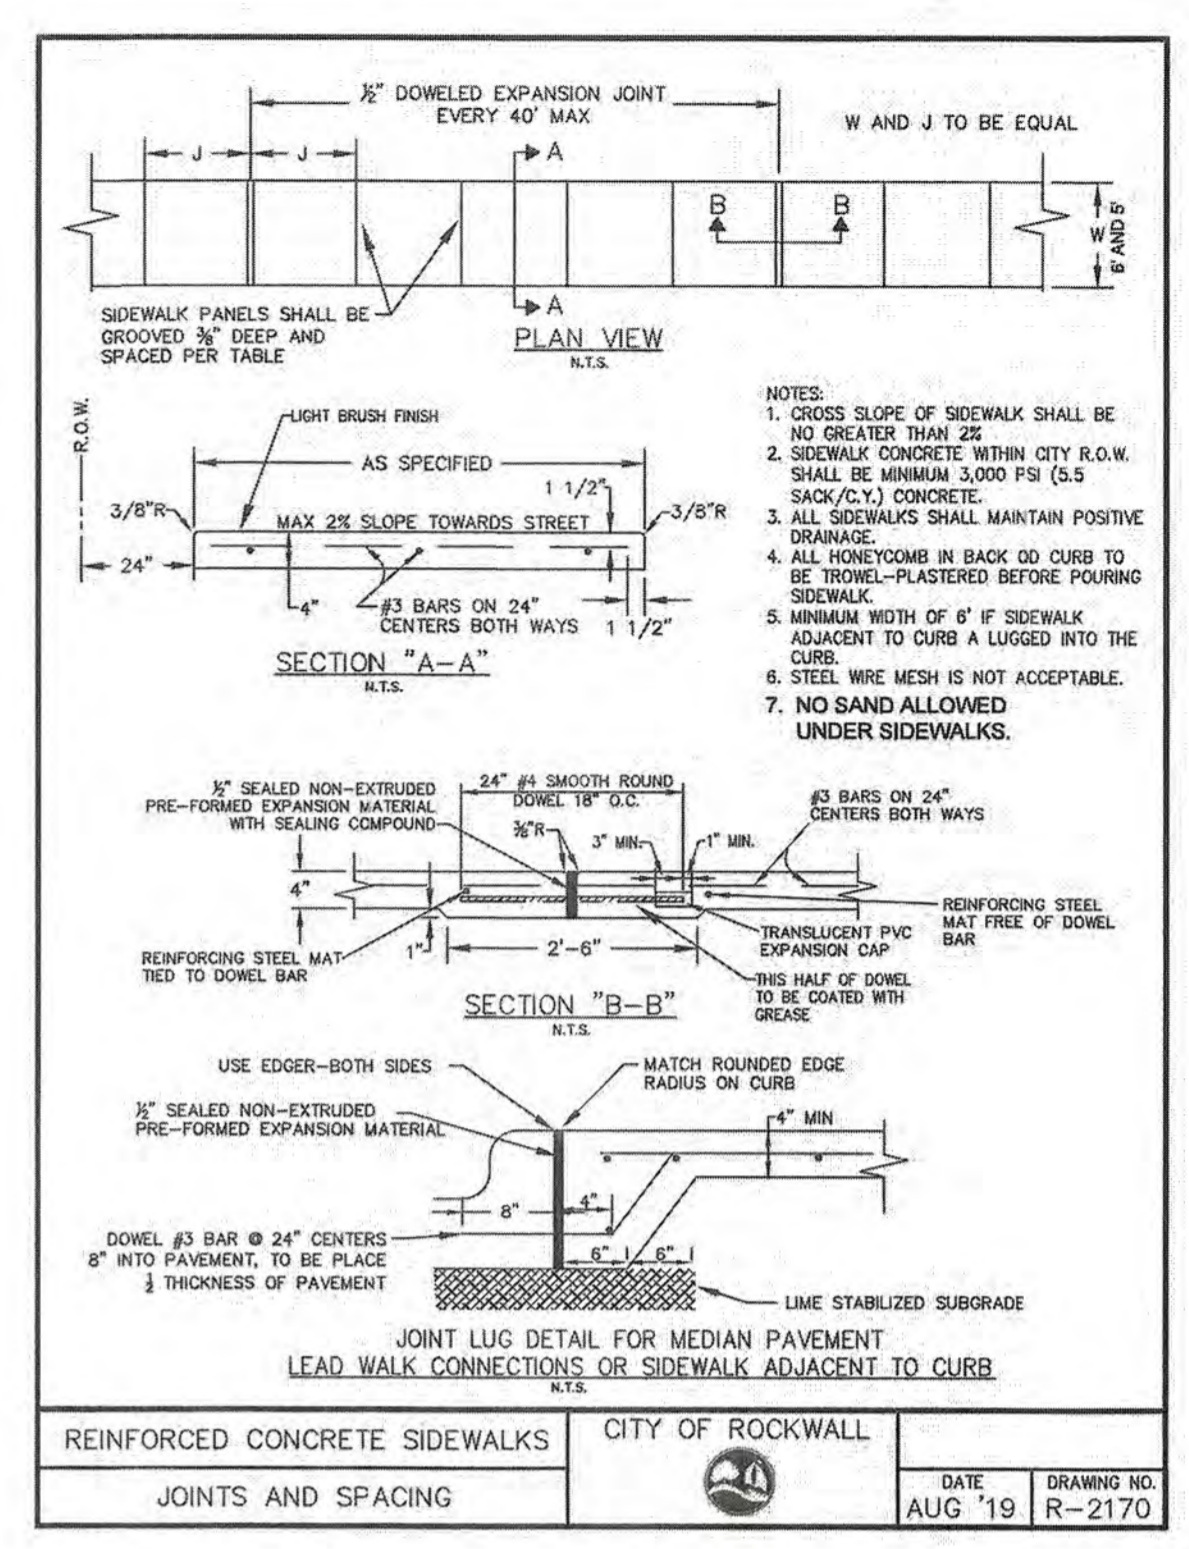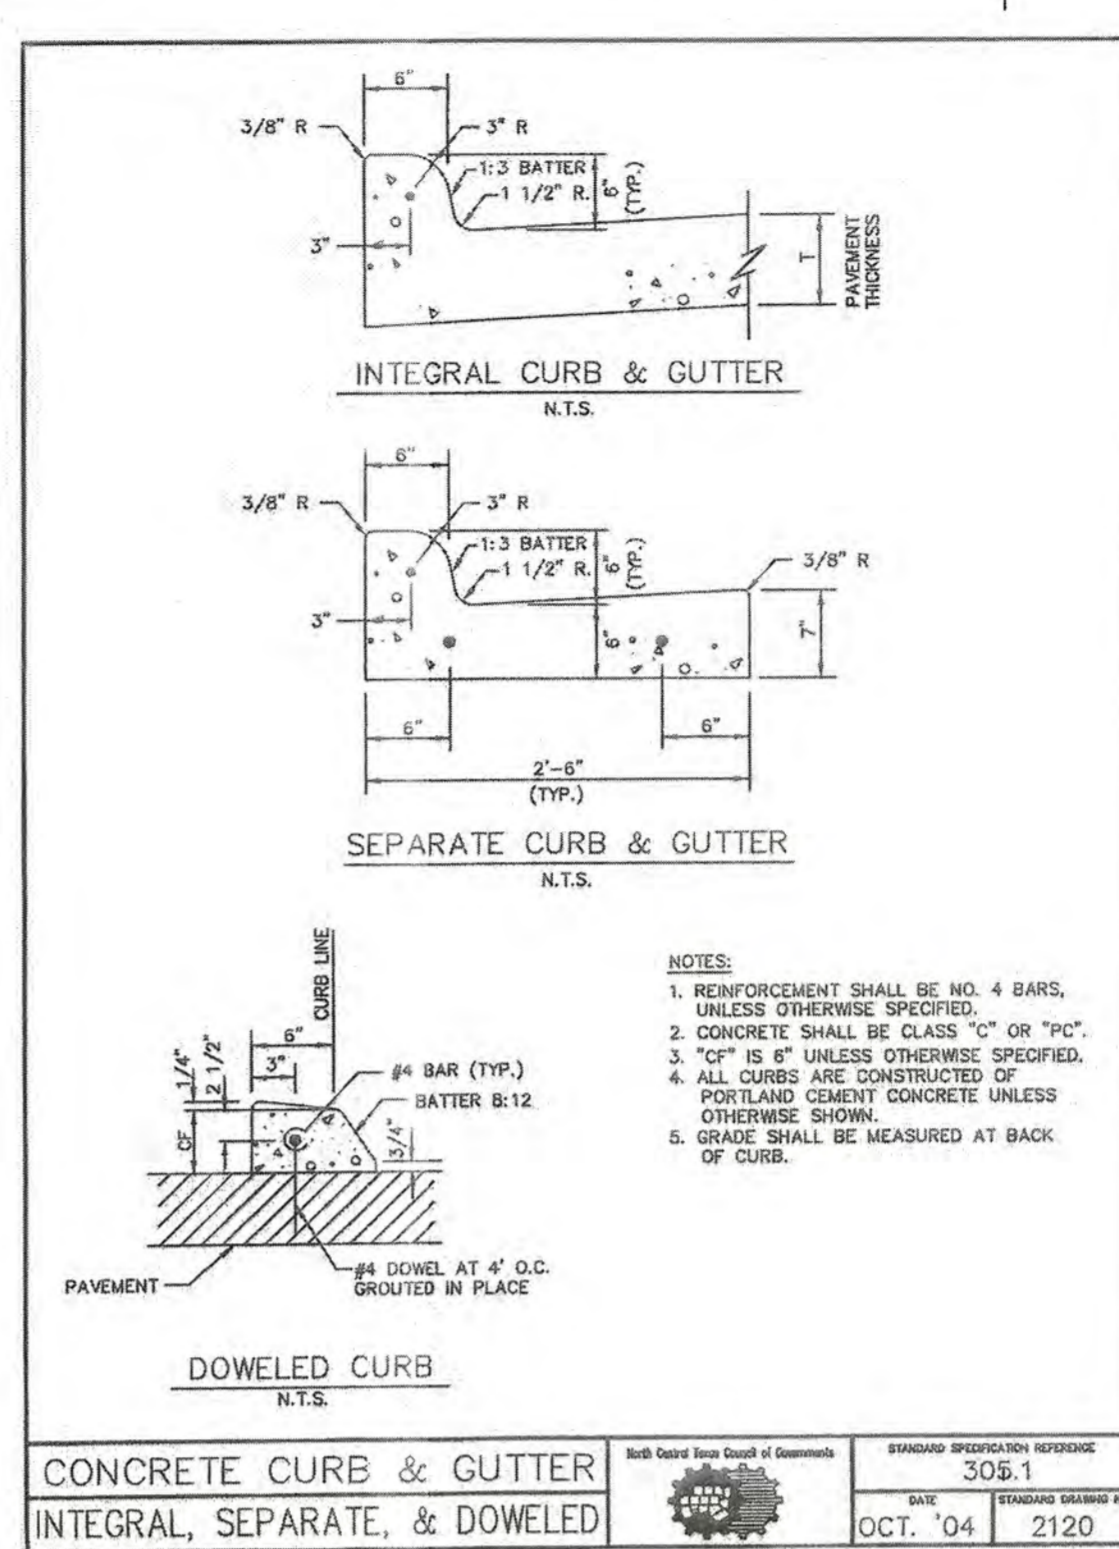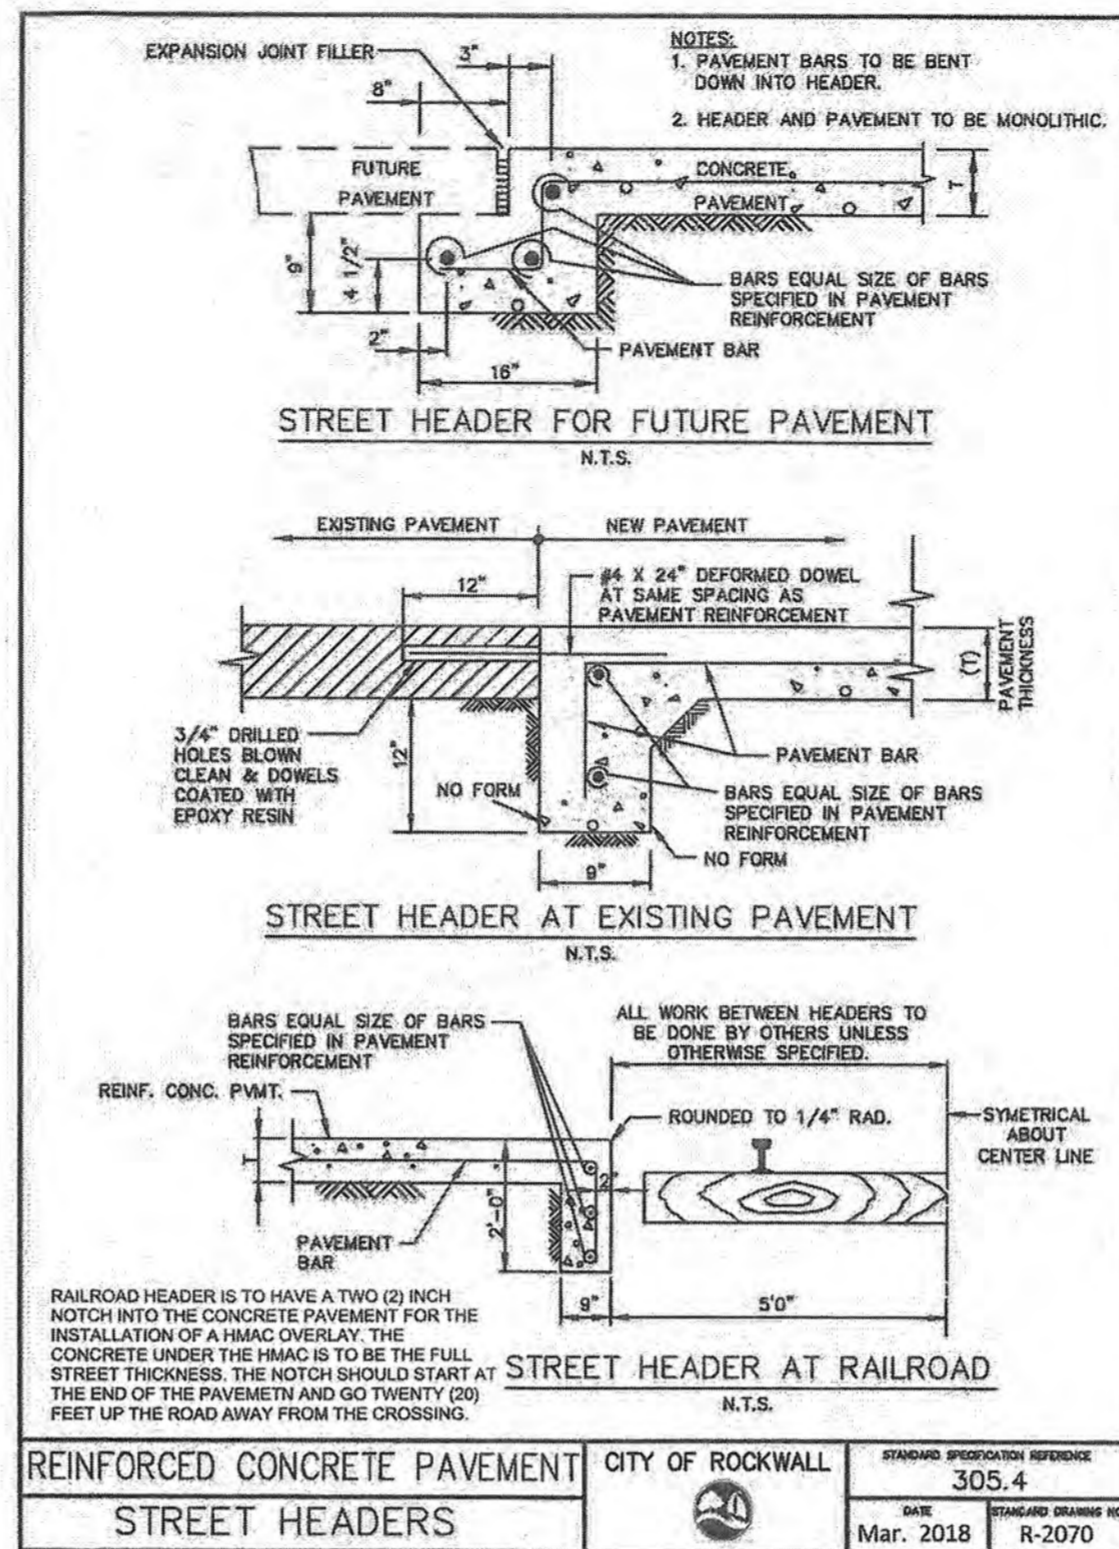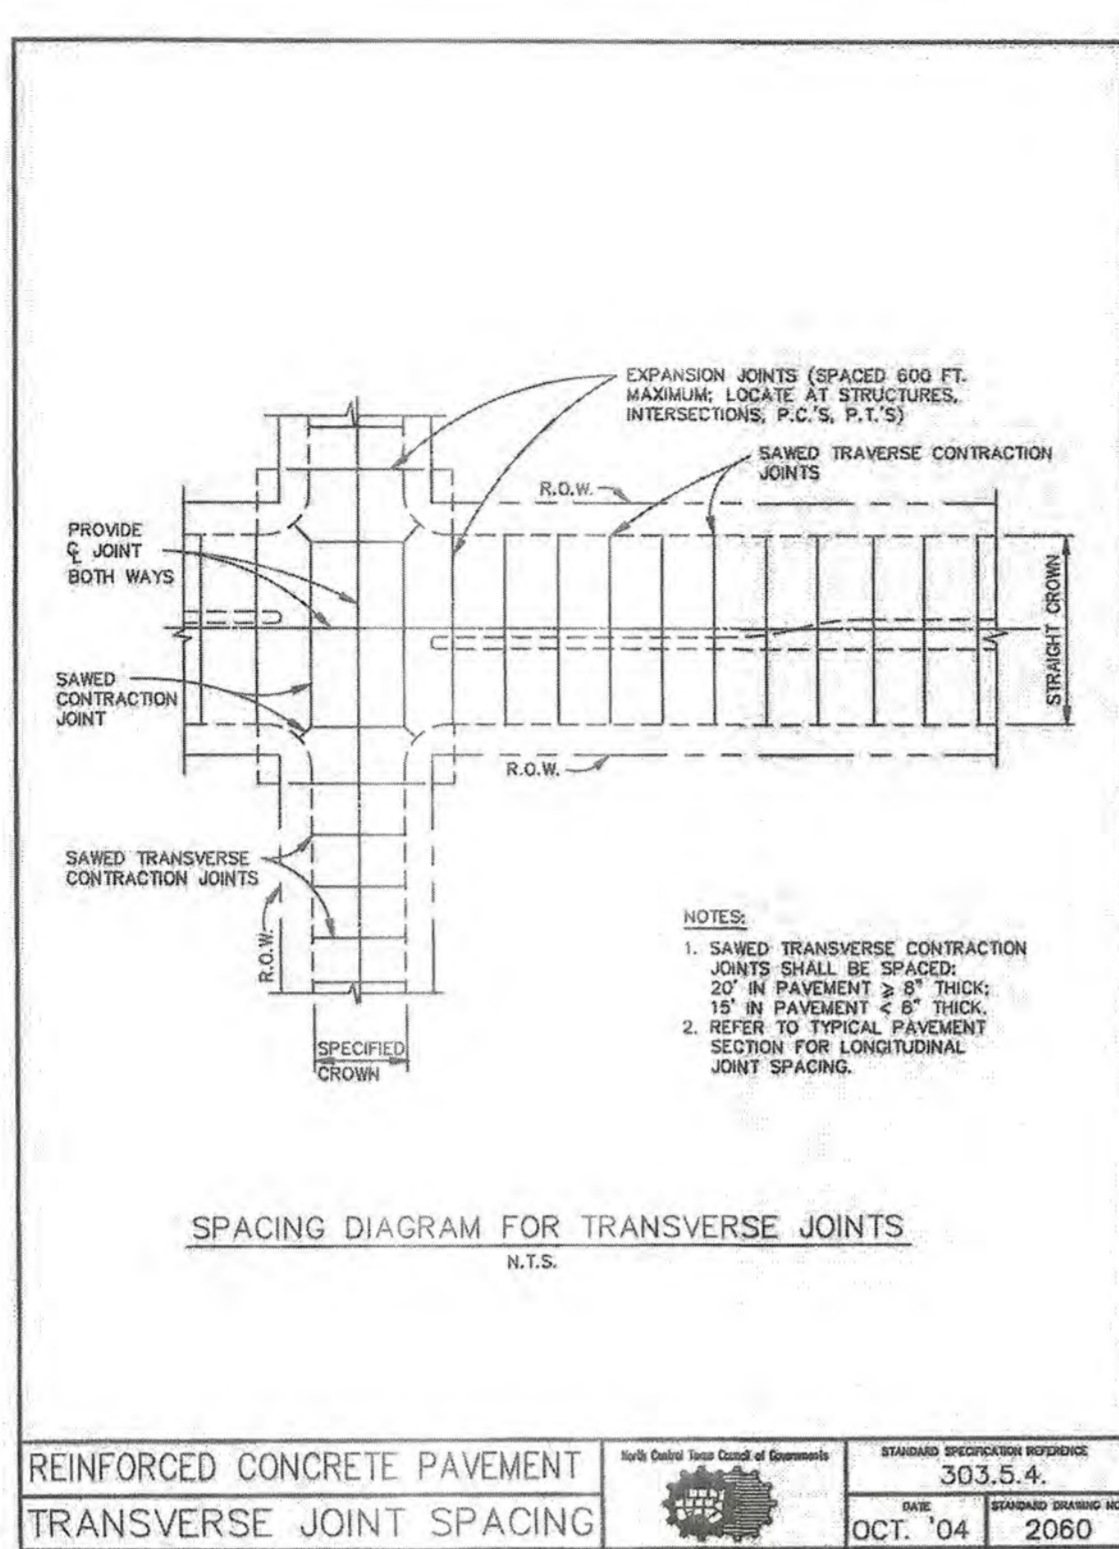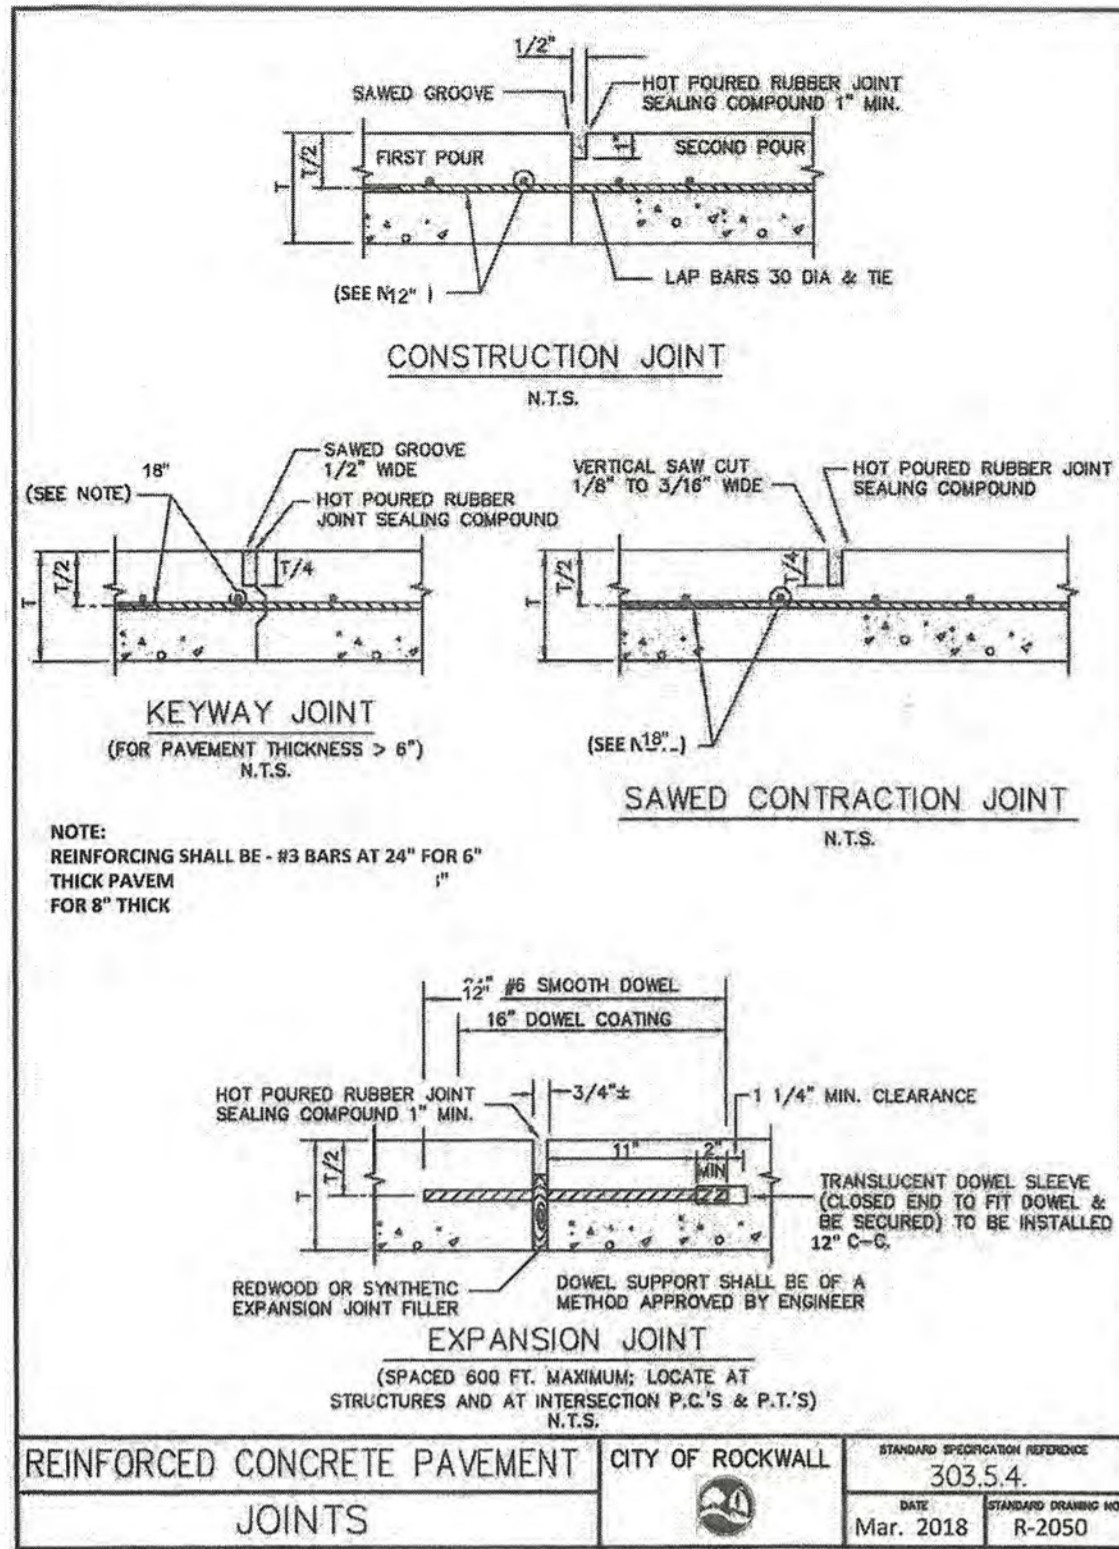

**RECORD DRAWINGS**

To the best of our knowledge Engineering Concepts & Design, L.P., hereby states that this plan is As-Built. This information provided is based on surveying at the site and information provided by the contractor.

*Ryan C. King*  
RYAN C. KING  
1/27/2021  
DATE

**CAUTION! EXISTING UTILITIES**

CONTRACTOR SHOULD CALL 1-800-GO-TESS PRIOR TO BEGINNING ANY CONSTRUCTION ACTIVITIES FOR EXISTING UTILITY LOCATIONS. EXISTING UTILITIES AND UNDERGROUND FACILITIES INDICATED ON THESE PLANS HAVE BEEN LOCATED FROM REFERENCE INFORMATION. IT IS THE RESPONSIBILITY OF THE CONTRACTOR TO VERIFY BOTH HORIZONTALLY AND VERTICALLY THE LOCATION OF ALL LOCATED UTILITIES AND UNDERGROUND FACILITIES PRIOR TO CONSTRUCTION AND TO TAKE NECESSARY PRECAUTIONS IN ORDER TO PROTECT ALL FACILITIES ENCOUNTERED. THE CONTRACTOR SHALL PRESERVE AND PROTECT ALL EXISTING UTILITIES FROM DAMAGE DURING CONSTRUCTION.

BM-1: "PK" Nail on the south side of Clem Road, approximately 2275' west of the centerline intersection of Clem Road and FM 3549  
Elev.: 559.07'

BM-2: "PK" Nail in Clem Road, approximately 175' west of the centerline intersection of Clem Road and FM 3549  
Elev.: 584.83'

**ENGINEERINGCONCEPTS & DESIGN, L.P.**

ENGINEERING / PROJECT MANAGEMENT / CONSTRUCTION SERVICES - FIRM REG. #F-001145  
201 WINDCO CIR, STE 200, WYLIE, TX 75098  
972-941-8400 FAX: 972-941-8401 WWW.ECDLP.COM

**REVISIONS:**

DRAWN: MJH  
CHECKED: RCK  
PROJECT NO.: 08838  
DWG FILE NAME: 08838 DT.DWG

DATE: 6/1/2020

THIS DOCUMENT IS RELEASED FOR THE PURPOSE OF CONSTRUCTION. THE SEAL APPEARING ON THIS DOCUMENT WAS AUTHORIZED BY RYAN C. KING, P.E. 123635





**PAVING DETAILS 1**

**NORTHGATE**

CITY OF ROCKWALL, ROCKWALL COUNTY, TEXAS

SHEET  
34  
OF  
40



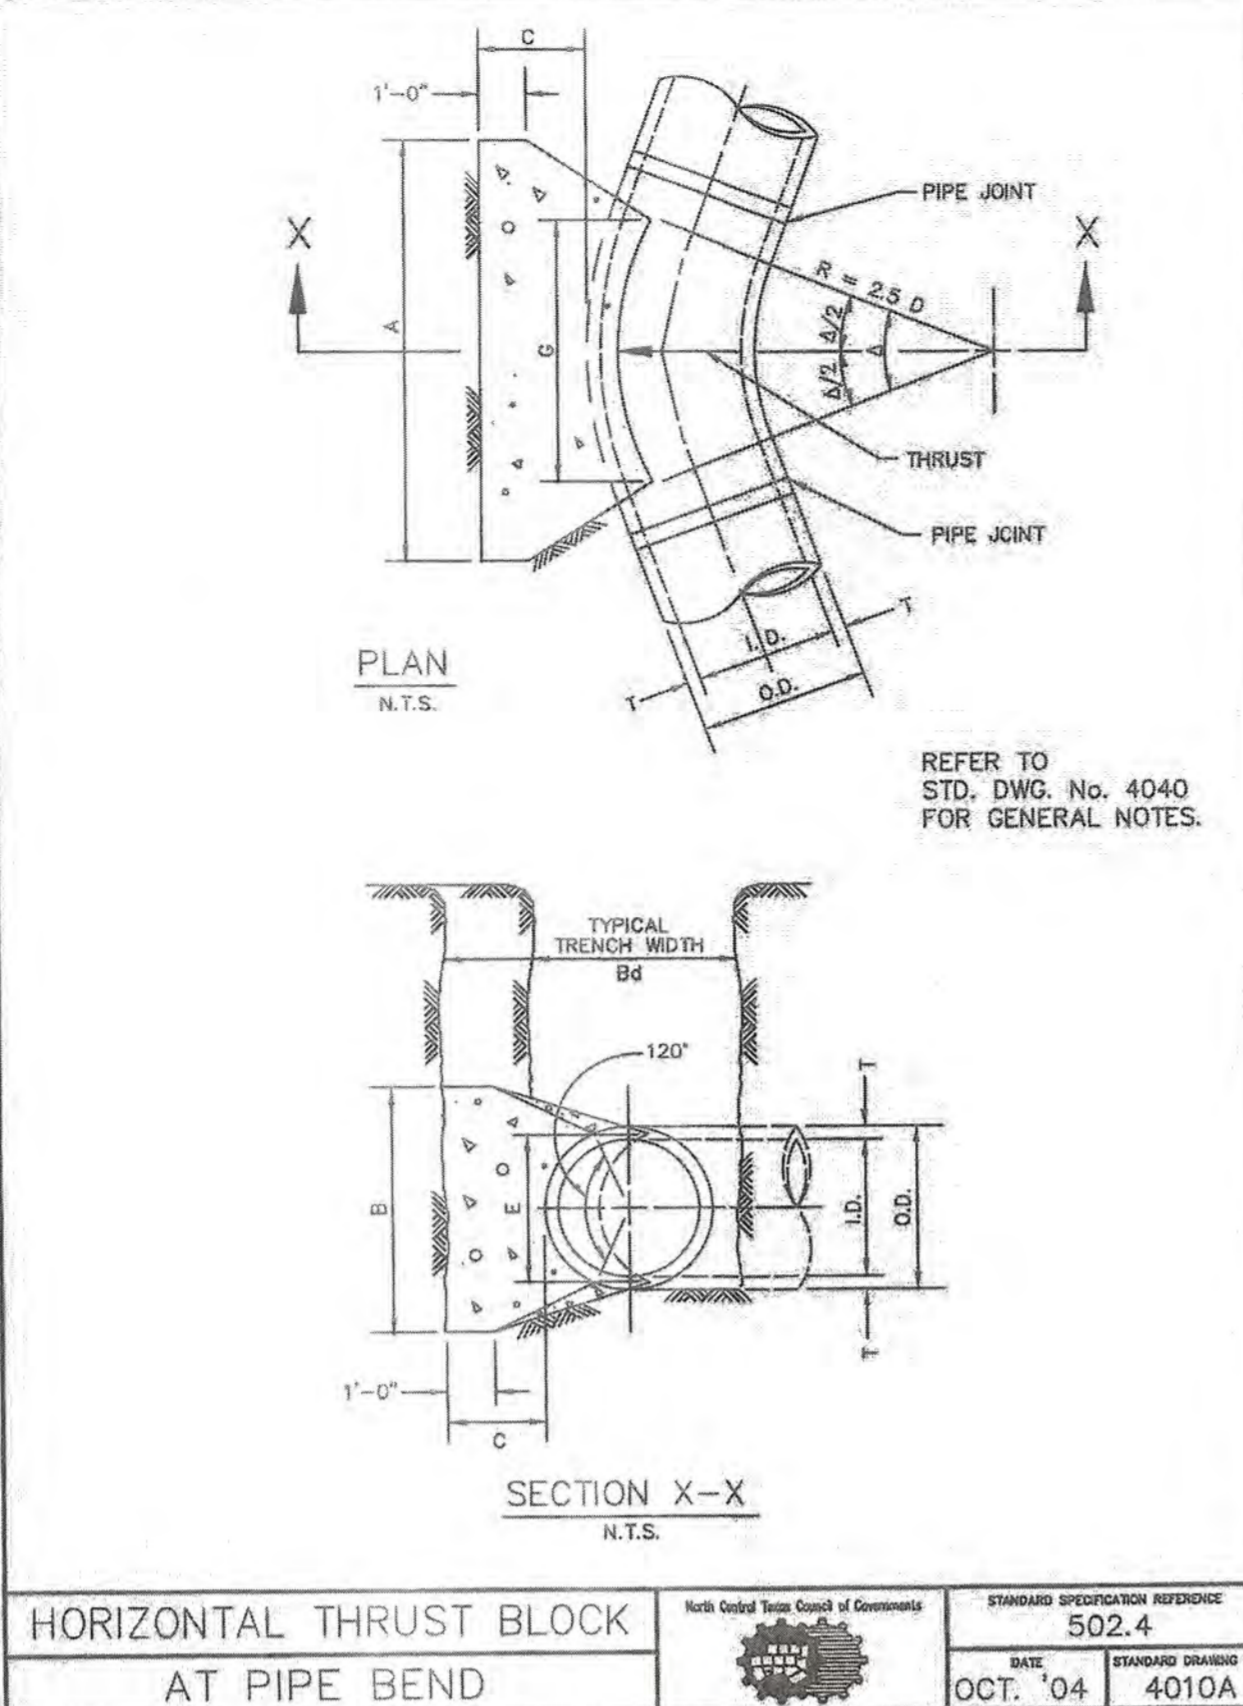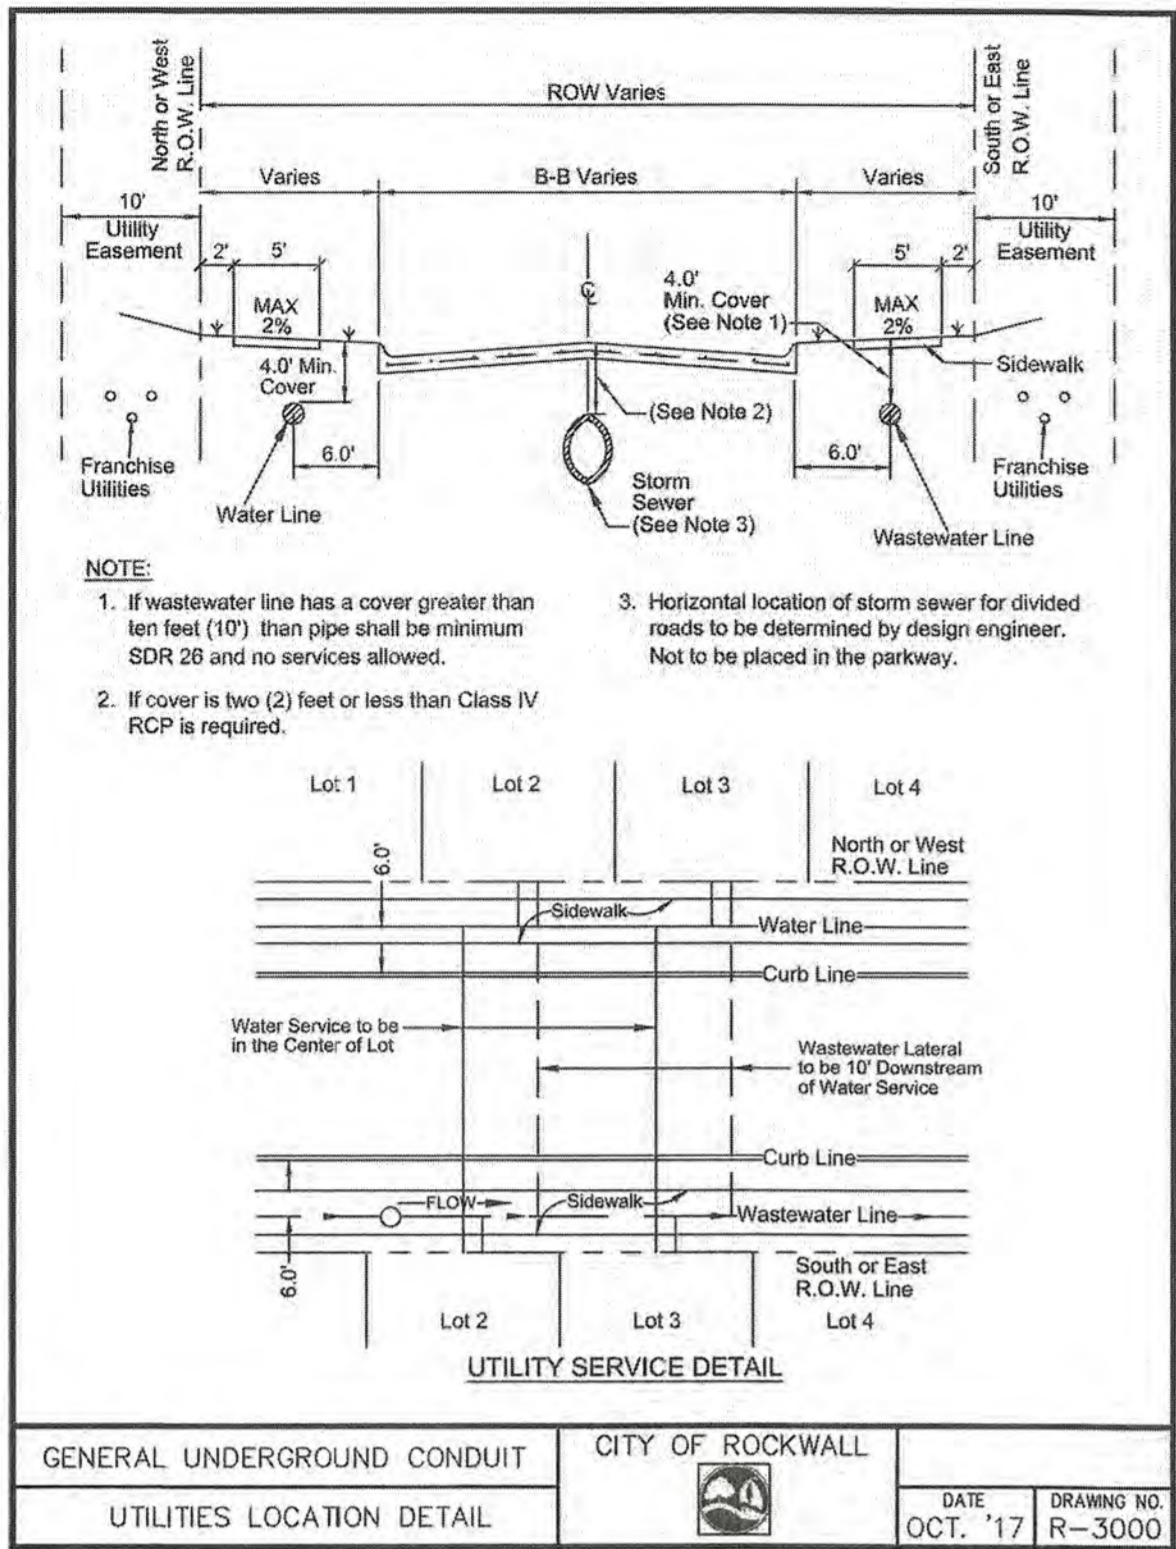

Δ = 11.25°										Δ = 22.50°											
EARTH					ROCK					EARTH					ROCK						
I.D. (IN.)	G (FT.)	THRUST (TONS)	A (FT.)	B (FT.)	I.D. (IN.)	G (FT.)	THRUST (TONS)	A (FT.)	B (FT.)	I.D. (IN.)	G (FT.)	THRUST (TONS)	A (FT.)	B (FT.)	I.D. (IN.)	G (FT.)	THRUST (TONS)	A (FT.)	B (FT.)		
4.6,8	0.4	1.0	1.0	1.5	0.1	1.0	0.1	4.6,8	0.8	2.0	1.5	1.5	0.1	1.0	1.0	0.1	4.6,8	1.5	3.9	2.0	2.0
10,12	0.6	2.2	1.5	1.5	0.1	1.0	1.5	0.1	10,12	1.1	4.4	2.0	2.5	0.3	1.5	1.5	0.1	10,12	2.2	8.7	3.5
16,18	0.8	5.0	2.0	2.5	0.3	1.5	2.0	0.2	16,18	1.6	9.9	3.0	3.5	0.6	2.0	2.5	0.3	16,18	3.5	19.5	4.5
20	0.9	6.2	2.0	3.5	0.4	1.5	3.0	0.3	20	1.8	12.3	3.5	3.5	0.7	2.0	3.0	0.4	20	4.5	23.5	5.0
24	1.1	9.9	3.0	3.5	0.5	1.5	3.0	0.3	24	2.2	17.7	4.0	4.5	1.0	3.0	3.5	0.5	24	5.5	28.5	5.5
30	1.4	10.4	3.0	3.5	0.6	2.0	3.5	0.4	30	2.7	20.7	5.0	4.5	1.5	3.0	4.0	0.8	30	6.5	33.5	6.0
36	1.7	15.0	3.5	4.5	0.9	2.0	4.0	0.5	36	3.3	29.8	5.5	5.5	2.3	4.0	4.0	1.3	36	7.5	38.5	6.5
42	1.8	20.4	4.5	5.0	1.5	2.5	5.0	0.8	42	3.8	40.5	7.0	6.0	3.9	4.5	5.0	2.1	42	8.5	43.5	7.0
48	2.2	28.6	4.5	6.0	2.0	2.5	6.0	1.1	48	4.4	52.9	8.0	7.0	5.7	4.5	6.0	2.8	48	9.5	48.5	7.5
54	2.5	33.7	6.0	6.0	3.0	3.0	6.0	1.4	54	4.9	67.0	9.0	8.0	8.0	6.0	6.0	4.1	54	10.5	53.5	8.0
60	2.7	41.6	6.0	7.0	3.8	3.0	7.0	1.8	60	5.5	82.7	9.5	9.0	10.8	6.0	7.0	5.3	60	11.5	58.5	8.5
66	3.0	50.3	6.5	8.0	5.1	3.5	8.0	2.7	66	6.0	100.1	10.5	10.0	14.1	6.5	8.0	7.2	66	12.5	63.5	9.0
72	3.3	59.9	7.5	8.0	6.3	4.0	8.0	3.3	72	6.6	119.1	11.0	11.0	17.8	7.5	8.0	9.1	72	13.5	68.5	9.5
78	3.6	70.2	8.0	9.0	8.1	4.0	9.0	3.9	78	7.1	139.8	12.0	12.0	22.5	8.0	9.0	11.7	78	14.5	73.5	10.0
84	3.8	81.5	8.5	10.0	10.3	4.5	10.0	4.5	84	7.8	162.1	13.0	12.8	27.2	8.5	10.0	14.8	84	15.5	78.5	10.5
90	4.1	93.5	9.5	10.0	12.2	5.0	10.0	6.3	90	8.2	186.1	14.0	13.5	33.7	9.5	10.0	17.7	90	16.5	83.5	11.0
96	4.4	106.4	10.0	11.0	15.0	5.0	11.0	7.4	96	8.7	211.7	15.0	14.8	41.2	10.0	11.0	21.8	96	17.5	88.5	11.5

TABLES OF DIMENSIONS AND QUANTITIES

**HORIZONTAL THRUST BLOCK**

AT PIPE BEND

North Texas Council of Governments

STANDARD SPECIFICATION REFERENCE: 502.4

DATE: OCT. '04 STANDARD DRAWING NO: 4010B

$\Delta = 30^\circ$										$\Delta = 45^\circ$										
EARTH					ROCK					EARTH					ROCK					
I.D. (IN.)	G (FT.)	THRUST (TONS)	A (FT.)	B (FT.)	I.D. (IN.)	G (FT.)	THRUST (TONS)	A (FT.)	B (FT.)	I.D. (IN.)	G (FT.)	THRUST (TONS)	A (FT.)	B (FT.)	I.D. (IN.)	G (FT.)	THRUST (TONS)	A (FT.)	B (FT.)	
4.6,8	1.0	2.6	2.0	1.5	0.2	1.0	1.5	0.1	4.6,8	1.5	3.9	2.0	2.0	0.2	1.5	1.5	0.1	4.6,8	2.5	8.7
10,12	1.5	5.9	2.5	2.5	0.3	2.0	1.5	0.2	10,12	2.2	8.7	3.5	2.5	0.5	2.0	2.5	0.3	10,12	3.5	19.5
16,18	2.2	13.2	3.5	4.0	0.8	2.5	3.0	0.4	16,18	3.2	19.5	4.5	4.5	1.2	3.0	3.5	0.6	16,18	4.5	23.5
20	2.4	16.3	4.5	4.0	1.0	3.0	3.0	0.5	20	3.8	24.1	5.5	4.5	1.5	3.5	3.5	0.7	20	5.5	28.5
24	2.9	23.4	6.0	4.0	1.4	3.5	3.5	0.7	24	4.3	34.6	6.0	4.5	2.3	4.5	4.0	1.1	24	6.5	33.5
30	3.6	27.5	6.5	6.0	1.9	3.5	4.0	0.9	30	5.0	40.6	6.5	6.0	3.2	5.5	4.0	1.6	30	7.5	38.5
36	4.4	39.5	7.0	6.0	3.4	4.5	4.5	1.8	36	6.5	55.5	10.0	6.0	5.3	6.5	4.5	2.8	36	8.5	43.5
42	5.1	53.8	8.0	7.0	3.1	5.5	6.0	2.5	42	7.5	79.8	11.5	7.0	8.1	8.0	5.0	4.2	42	9.5	48.5
48	5.8	70.3	9.0	8.0	7.4	6.0	6.0	3.7	48	8.8	104.0	13.0	8.0	11.9	9.0	6.0	6.3	48	10.5	53.5
54	6.5	89.0	10.0	9.0	10.3	7.0	6.5	5.3	54	9.7	131.5	15.0	9.0	17.1	10.5	6.5	8.9	54	11.5	58.5
60	7.3	110.0	11.0	10.0	13.9	7.5	7.5	7.3	60	10.7	162.4	16.5	10.0	23.1	11.0	7.5	12.0	60	12.5	63.5
66	8.0	132.9	12.5	11.0	18.9	8.5	8.0	9.6	66	11.8	196.5	18.0	11.0	30.1	12.0	8.5	16.2	66	13.5	68.5
72	8.7	158.2	13.5	12.0	24.0	9.0	9.0	12.3	72	12.9	233.9	19.5	12.0	38.6	14.0	9.5	20.7	72	14.5	73.5
78	9.4	185.6	14.5	13.0	30.0	10.0	9.5	15.6	78	13.8	271.5	21.5	13.0	49.8	14.5	9.5	25.9	78	15.5	78.5
84	10.1	215.3	15.5	14.0	37.1	10.5	10.5	19.5	84	15.0	318.4	23.0	14.0	61.2	15.5	10.5	32.6	84	16.5	83.5
90	10.9	247.1	16.5	15.0	45.0	11.5	11.0	23.9	90	16.1	365.5	24.5	15.0	74.5	17.5	10.5	39.6	90	17.5	88.5
96	11.6	281.2	18.0	16.0	55.5	12.5	11.5	28.9	96	17.1	415.8	26.0	16.0	89.5	18.5	11.5	48.5	96	18.5	93.5

$\Delta = 67.50^\circ$										$\Delta = 90^\circ$										
EARTH					ROCK					EARTH					ROCK					
I.D. (IN.)	G (FT.)	THRUST (TONS)	A (FT.)	B (FT.)	I.D. (IN.)	G (FT.)	THRUST (TONS)	A (FT.)	B (FT.)	I.D. (IN.)	G (FT.)	THRUST (TONS)	A (FT.)	B (FT.)	I.D. (IN.)	G (FT.)	THRUST (TONS)	A (FT.)	B (FT.)	
4.6,8	2.1	5.6	3.0	2.0	0.5	2.0	1.5	0.2	4.6,8	2.7	7.1	5.0	1.5	0.4	2.0	2.0	0.2	4.6,8	4.5	12.5
10,12	3.1	12.6	5.5	2.5	0.8	3.0	2.0	0.4	10,12	4.0	16.0	8.5	2.5	1.0	3.5	2.5	0.5	10,12	6.5	21.5
16,18	4.7	28.3	7.5	4.0	1.9	5.5	3.0	0.9	16,18	6.0	36.0	9.0	4.0	2.4	4.5	4.0	1.0	16,18	9.5	38.5
20	5.2	34.9	8.0	4.0	2.3	5.5	3.5	1.2	20	6.6	44.4	10.0	4.5	3.1	6.0	4.0	1.5	20	10.5	45.5
24	6.2	50.3	11.5	4.5	3.5	6.5	4.0	1.6	24	7.9	64.0	14.5	4.5	5.0	8.0	4.0	2.0	24	12.5	53.5
30	7.8	58.9	12.0	5.0	4.8	7.5	4.0	2.2	30	9.8	75.0	15.0	5.0	5.7	10.0	4.5	2.5	30	15.5	61.5
36	9.4	84.9	14.5	6.0	8.2	9.5	4.5	3.6	36	11.9	108.0	18.0	6.0	11.4	12.0	4.5	5.3	36	18.5	70.5
42	10.9	115.5	17.0	7.0	12.8	11.5	5.5	6.3	42	13.8	147.0	21.0	7.0	17.8	14.0	5.5	8.7	42	21.5	80.5
48	12.5	150.9	19.0	8.0	18.4	13.0	6.5	8.2	48	15.9	192.0	24.0	8.0	28.2	16.0	6.0	12.4	48	24.5	90.5
54	14.0	191.0	21.5	9.0	28.0	15.0	8.5	12.9	54	17.9	243.0	27.0	9.0	36.9	18.0	7.0	18.1	54	27.5	100.5
60	15.6	235.8	24.0	10.0	35.6	16.0	9.5	17.6	60	19.9	298.8	30.0	10.0	50.3	20.0	7.5	24.0	60	30.5	111.5
66	17.1	285.3	26.0	11.0	48.0	18.0	8.0	23.0	66	21.8	362.8	33.0	11.0	66.2	22.5	8.5	32.5	66	33.5	122.5
72	18.7	339.5	28.5	12.0	57.8	19.0	9.0	28.4	72	23.8	431.8	36.0	12.0	85.6	24.0	9.0	41.0	72	36.5	133.5
78	20.2	398.5	31.0	13.0	75.7	21.0	9.5	37.4	78	25.7	508.7	39.0	13.0	108.2	26.0	10.0	53.2	78	39.5	144.5
84	21.8	462.1	33.5	14.0	94.7	22.0	10.5	46.5	84	27.7	587.7	42.0	14.0	134.4	28.0	10.5	62.8	84	42.5	155.5
90	23.3	530.5	35.5	15.0	114.4	24.5	11.0	58.2	90	29.8	674.5	45.0	15.0	164.9	30.0	11.5	81.7	90	45.5	166.5
96	24.8	603.6	38.0	16.0	138.9	25.5	12.0	70.0	96	31.6	767.5	48.0	16.0	195.9	32.0	12.0	95.1	96	48.5	177.5

TABLES OF DIMENSIONS AND QUANTITIES

HORIZONTAL THRUST BLOCK


AT PIPE BEND

North Central Texas Council of Governments

STANDARD SPECIFICATION REFERENCE: 502.4

DATE: OCT. '04

STANDARD DRAWING NO: 4010C

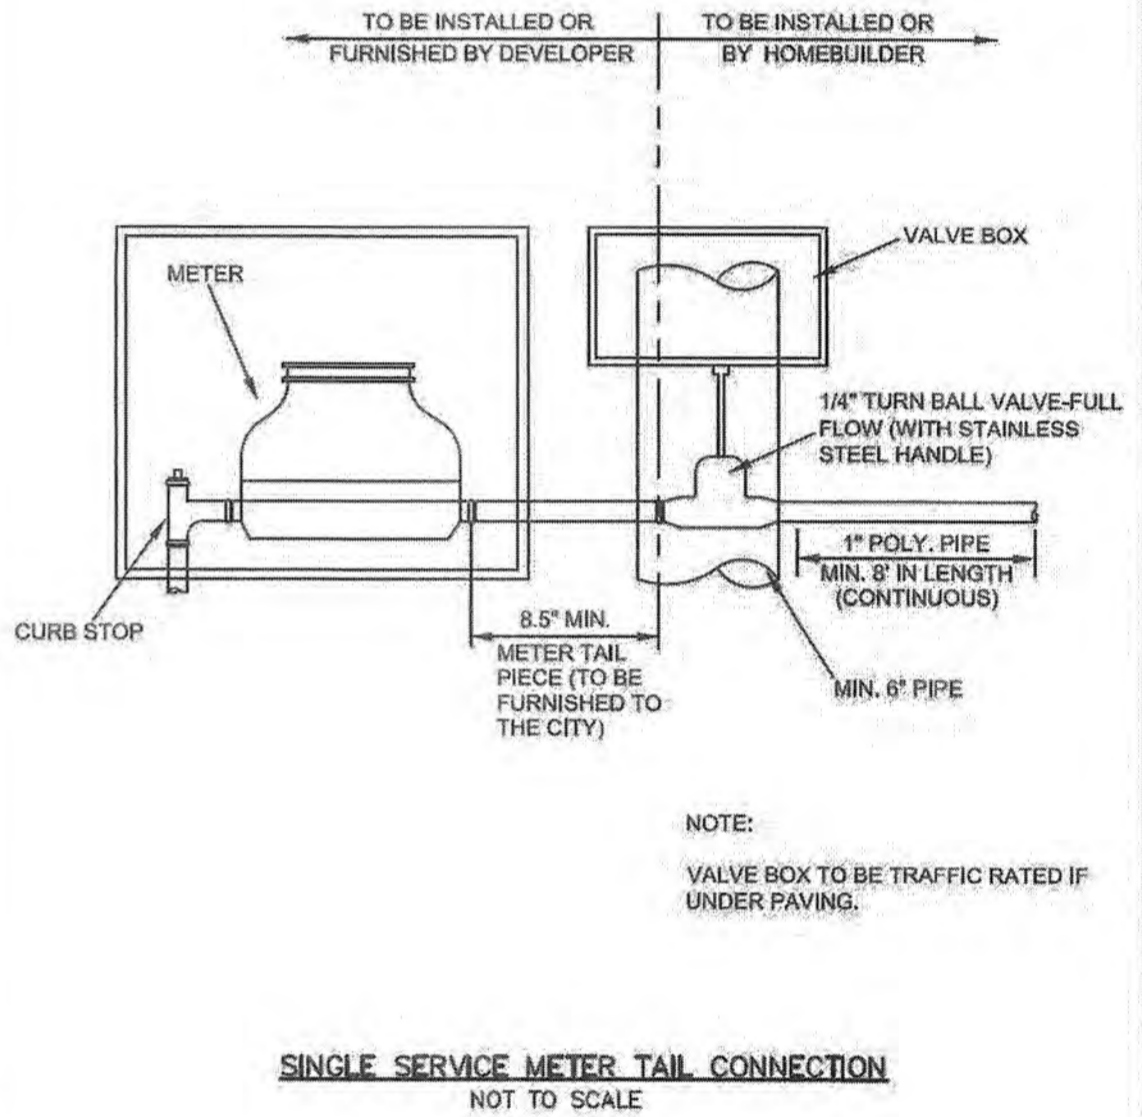



**RECORD DRAWINGS**

To the best of our knowledge Engineering Concepts & Design, L.P., hereby states that this plan is As-Built. This information provided is based on surveying at the site and information provided by the contractor.

*Ryan C. King* 1/27/2021  
DATE

RELEASED FOR CONSTRUCTION  
ALL RESPONSIBILITY FOR ADEQUACY OF DESIGN REMAINS WITH THE DESIGN ENGINEER. THE CITY PLANS FOR CONSTRUCTION, ASSUMES NO RESPONSIBILITY FOR ADEQUACY OR ACCURACY OF DESIGN.

CITY \_\_\_\_\_ DATE \_\_\_\_\_

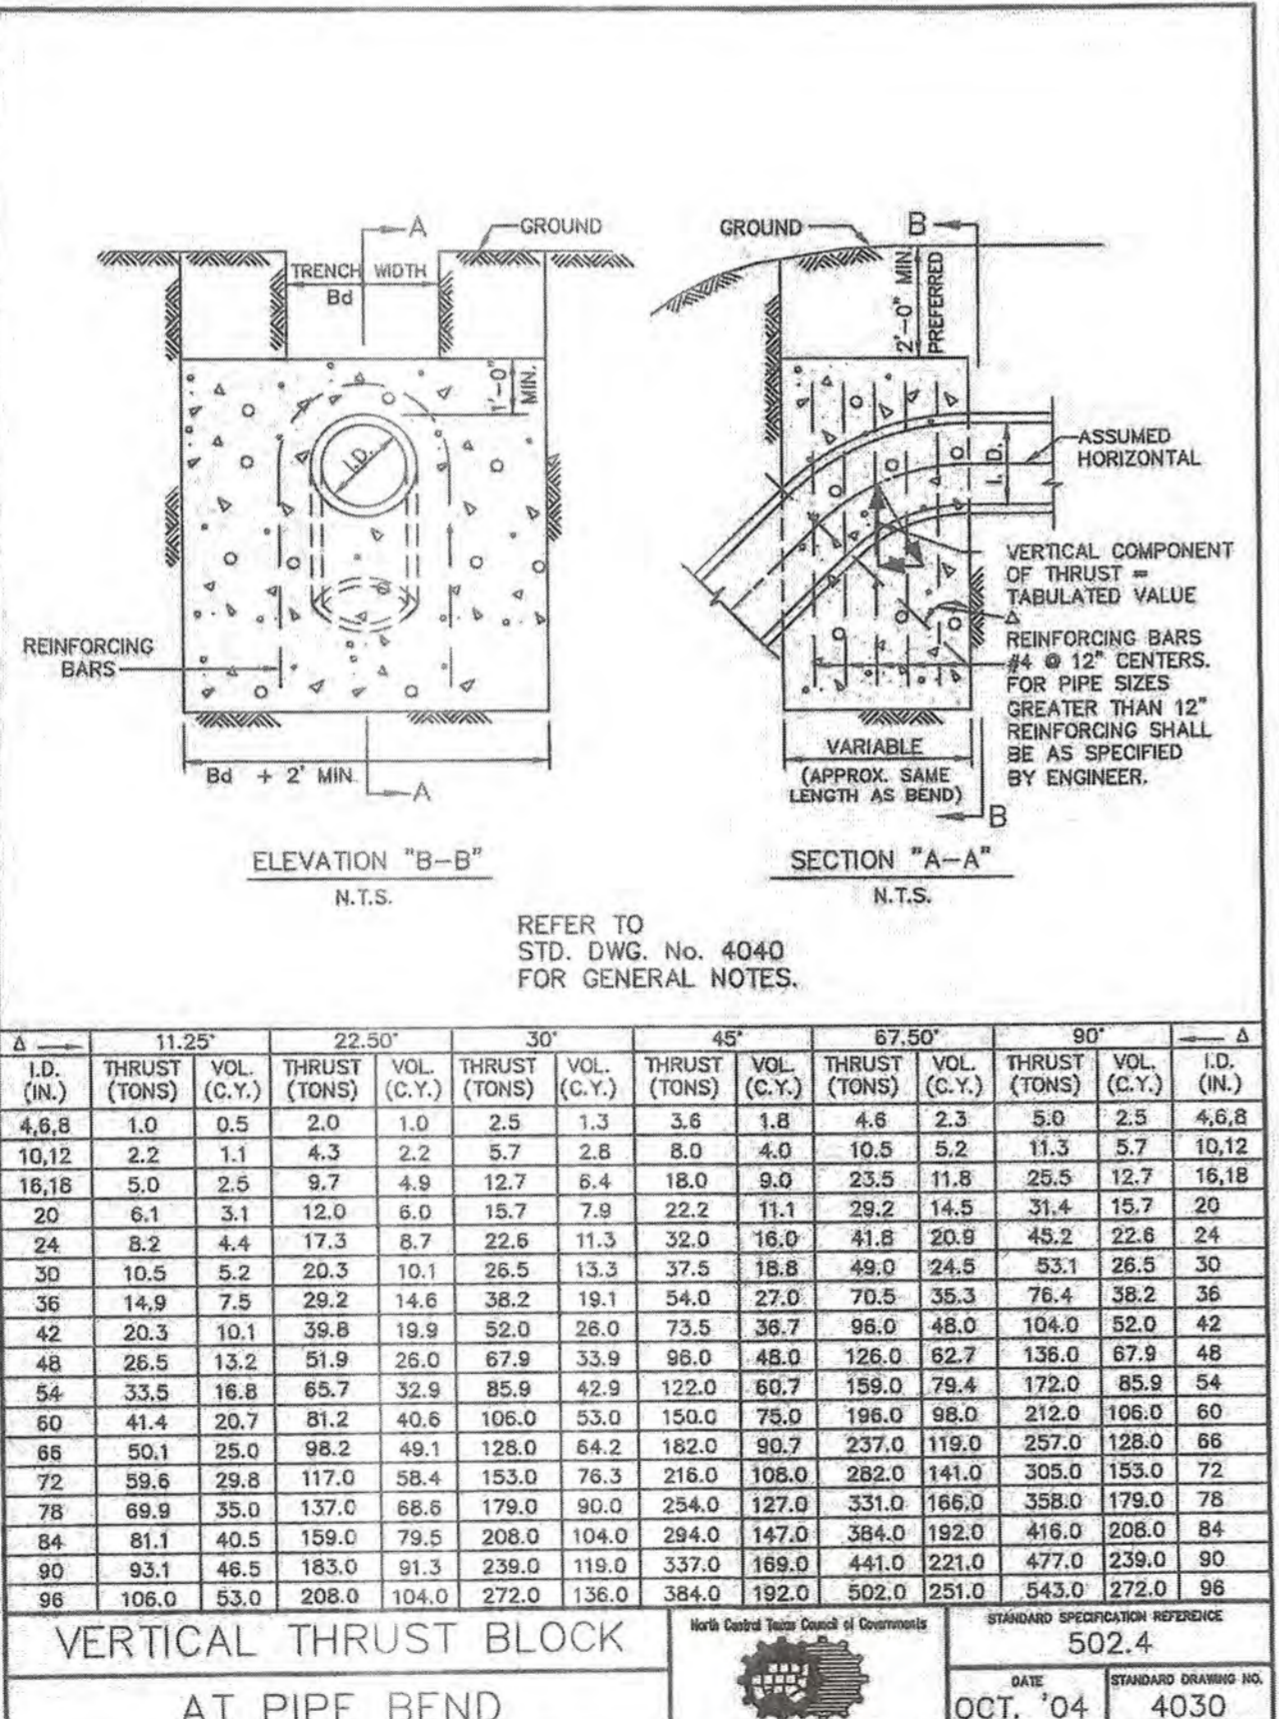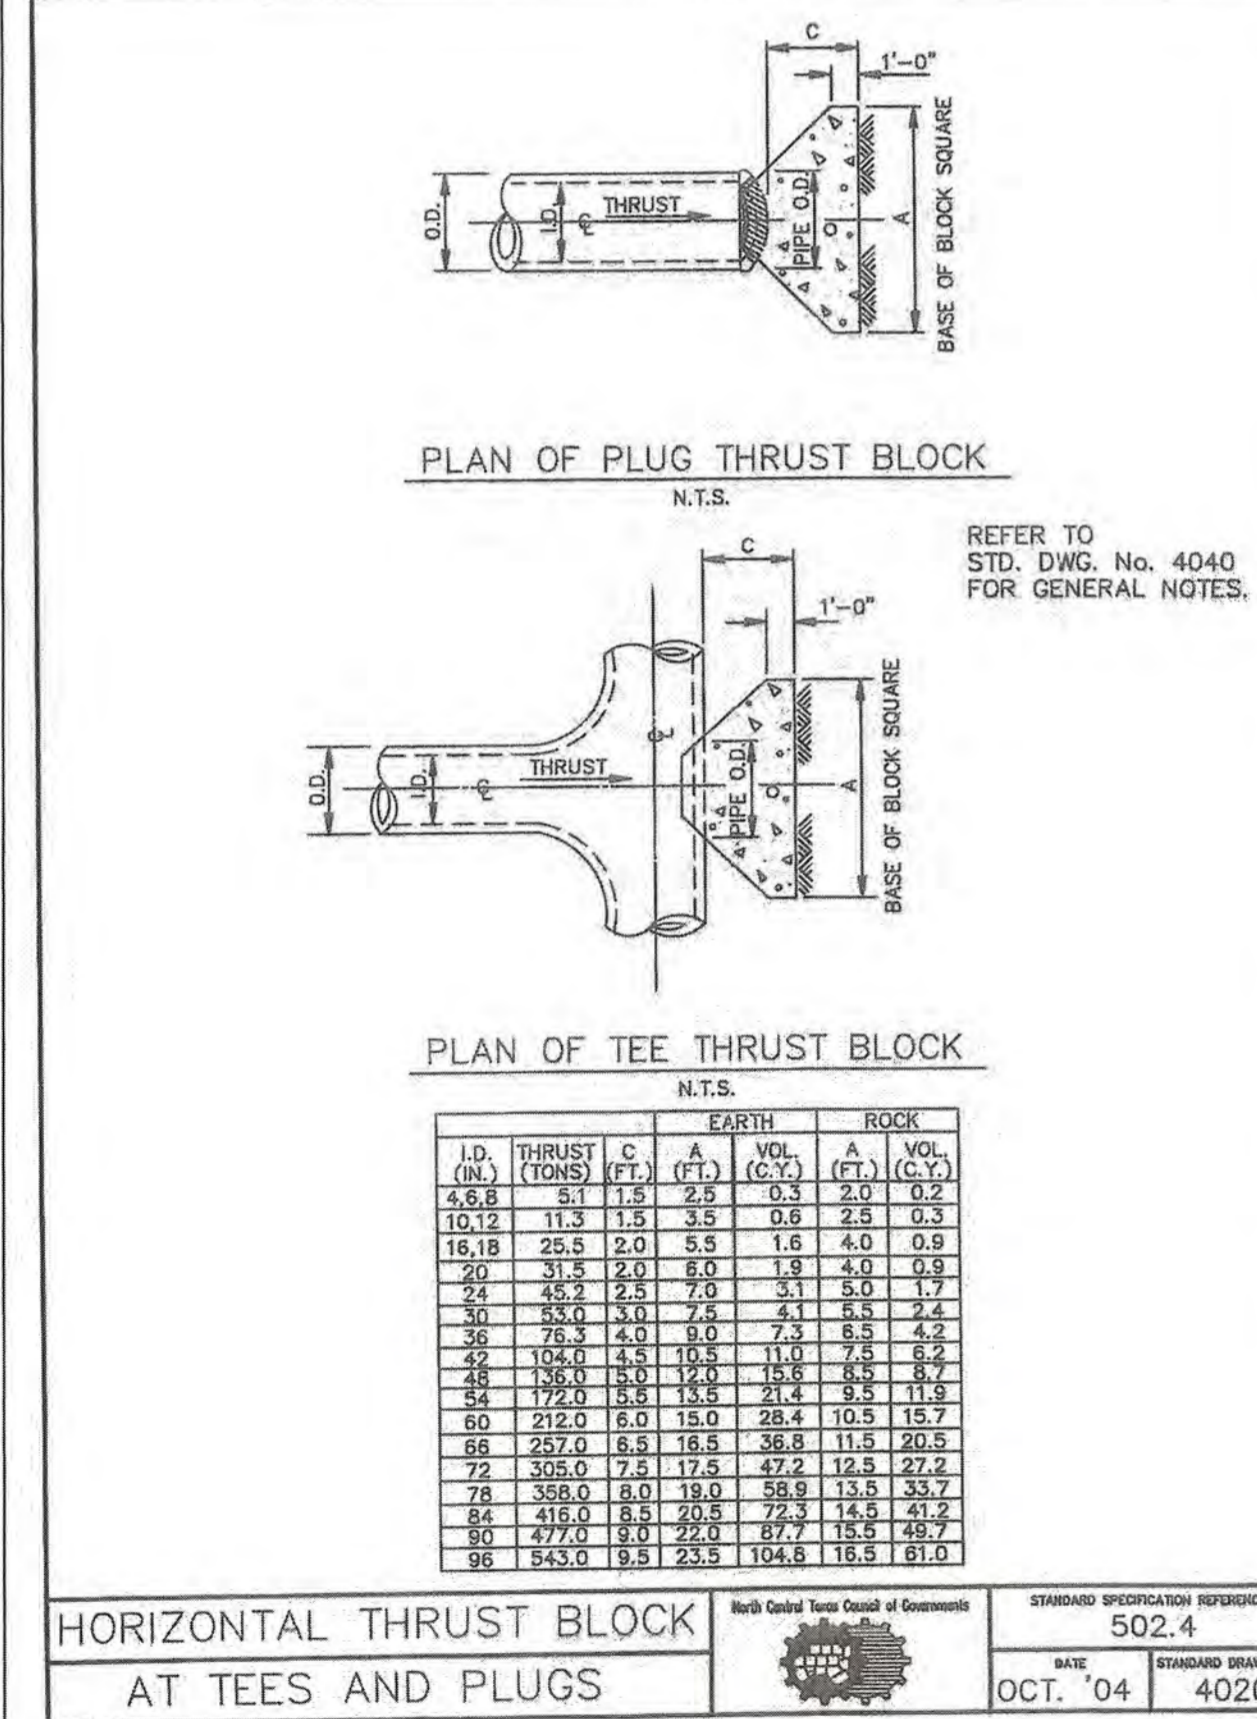

**GENERAL NOTES FOR ALL THRUST BLOCKS:**


- CONCRETE FOR BLOCKING SHALL BE CLASS "B".
- ALL CALCULATIONS ARE BASED ON INTERNAL PRESSURE OF 200 PSI FOR DUCTILE IRON, P.V.C., AND 150 PSI FOR CONCRETE PIPE.
- VOLUMES OF THRUST BLOCKS ARE NET VOLUMES OF CONCRETE TO BE FURNISHED. THE CORRESPONDING WEIGHT OF THE CONCRETE (CLASS "B") IS EQUAL TO OR GREATER THAN THE VERTICAL COMPONENT OF THE THRUST ON THE VERTICAL BEND.
- WALL THICKNESS (T) ASSUMED HERE FOR ESTIMATING PURPOSES ONLY.
- POUR CONCRETE FOR BLOCK AGAINST UNDISTURBED EARTH.
- DIMENSIONS MAY BE VARIED AS REQUIRED BY FIELD CONDITIONS WHERE AND AS DIRECTED BY THE ENGINEER. THE VOLUME OF CONCRETE BLOCKING SHALL NOT BE LESS THAN SHOWN HERE.
- THE SOIL BEARING PRESSURES ARE BASED ON 1000 LBS./S.F. IN SOIL AND 2000 LBS./S.F. IN ROCK.
- USE POLYETHYLENE WRAP OR EQUAL BETWEEN CONCRETE AND BEND, TEE, OR PLUG TO PREVENT THE CONCRETE FROM STICKING TO IT.
- CONCRETE SHALL NOT EXTEND BEYOND JOINTS.

**THRUST BLOCK GENERAL NOTES**

North Central Texas Council of Governments

STANDARD SPECIFICATION REFERENCE: 502.4

DATE: OCT. '04 STANDARD DRAWING NO: 4040

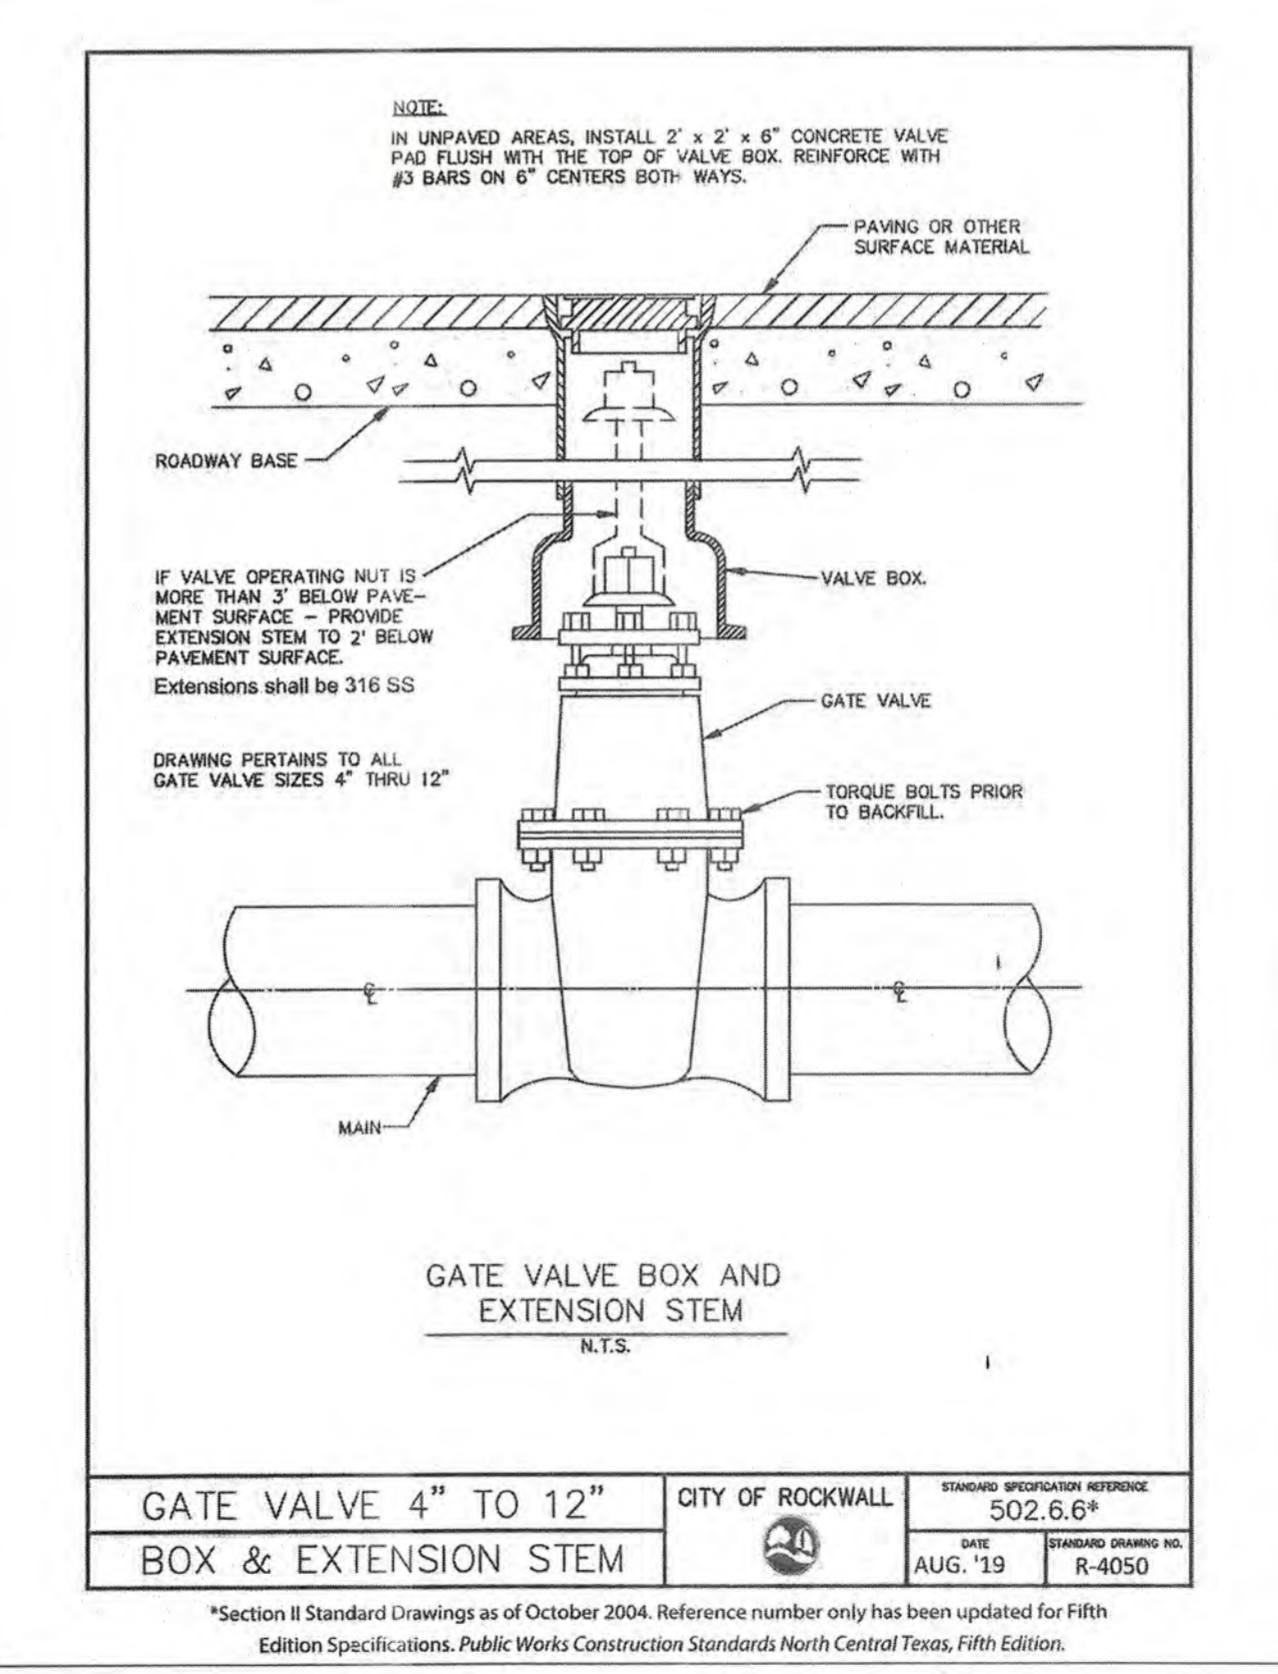

**ENGINEERINGCONCEPTS & DESIGN, L.P.**

ENGINEERING / PROJECT MANAGEMENT / CONSTRUCTION SERVICES - FIRM REG. #F-001145  
201 WINDCO CIR, STE 200, WYLLIE, TX 75098  
972-941-8400 FAX: 972-941-8401 WWW.ECDLP.COM

THIS DOCUMENT IS RELEASED FOR THE PURPOSE OF CONSTRUCTION. THE SEAL APPEARING ON THIS DOCUMENT WAS AUTHORIZED BY RYAN C. KING, P.E. 123635






**WATER DETAILS 1**

**NORTHGATE**

CITY OF ROCKWALL, ROCKWALL COUNTY, TEXAS

SHEET  
36  
OF  
40

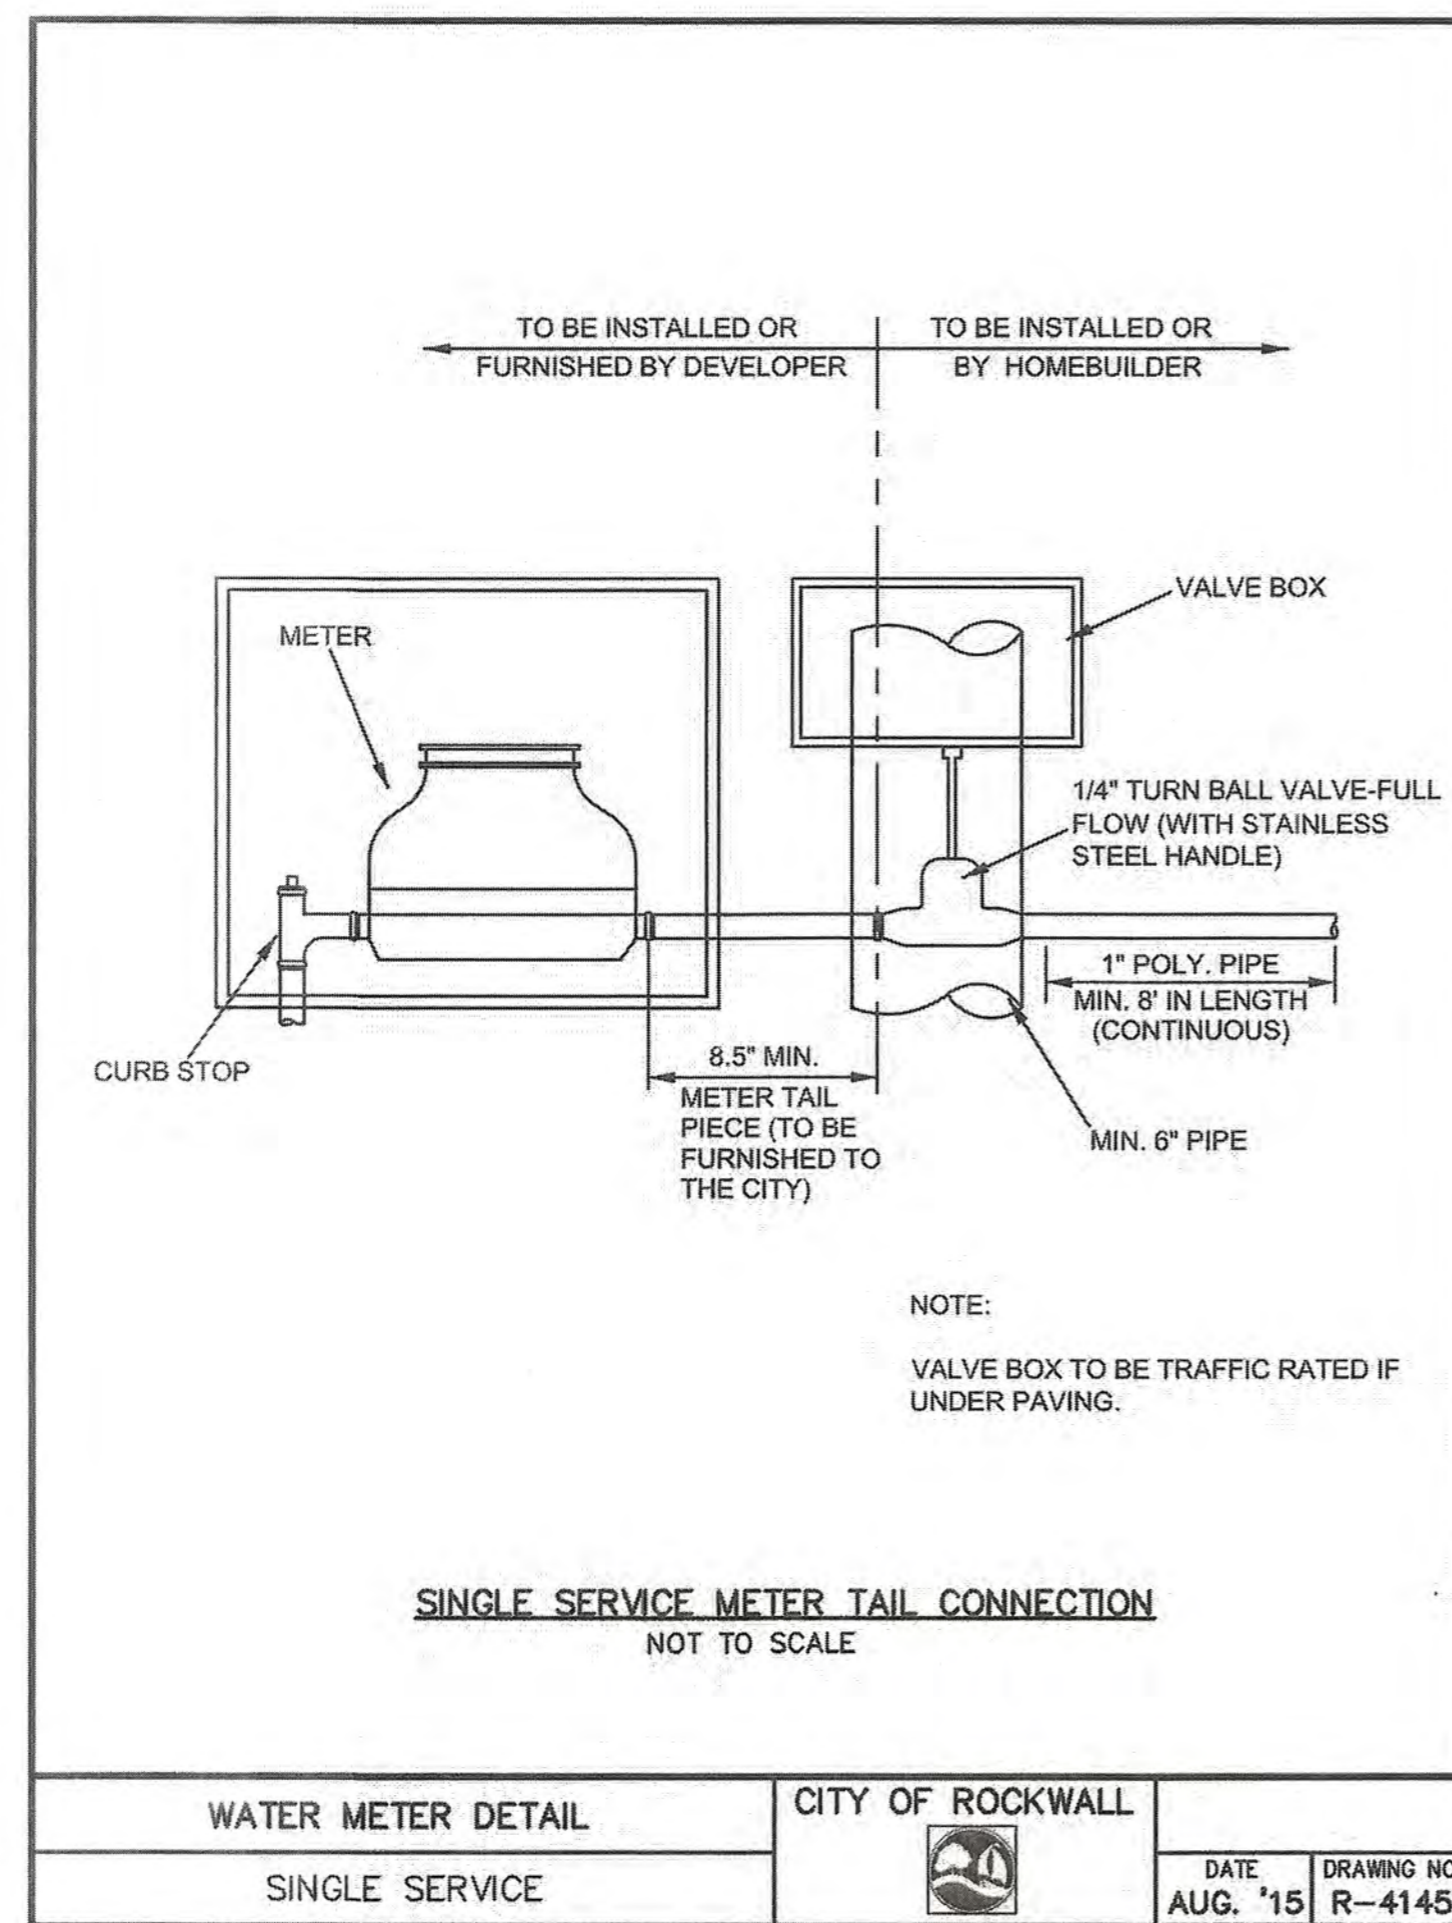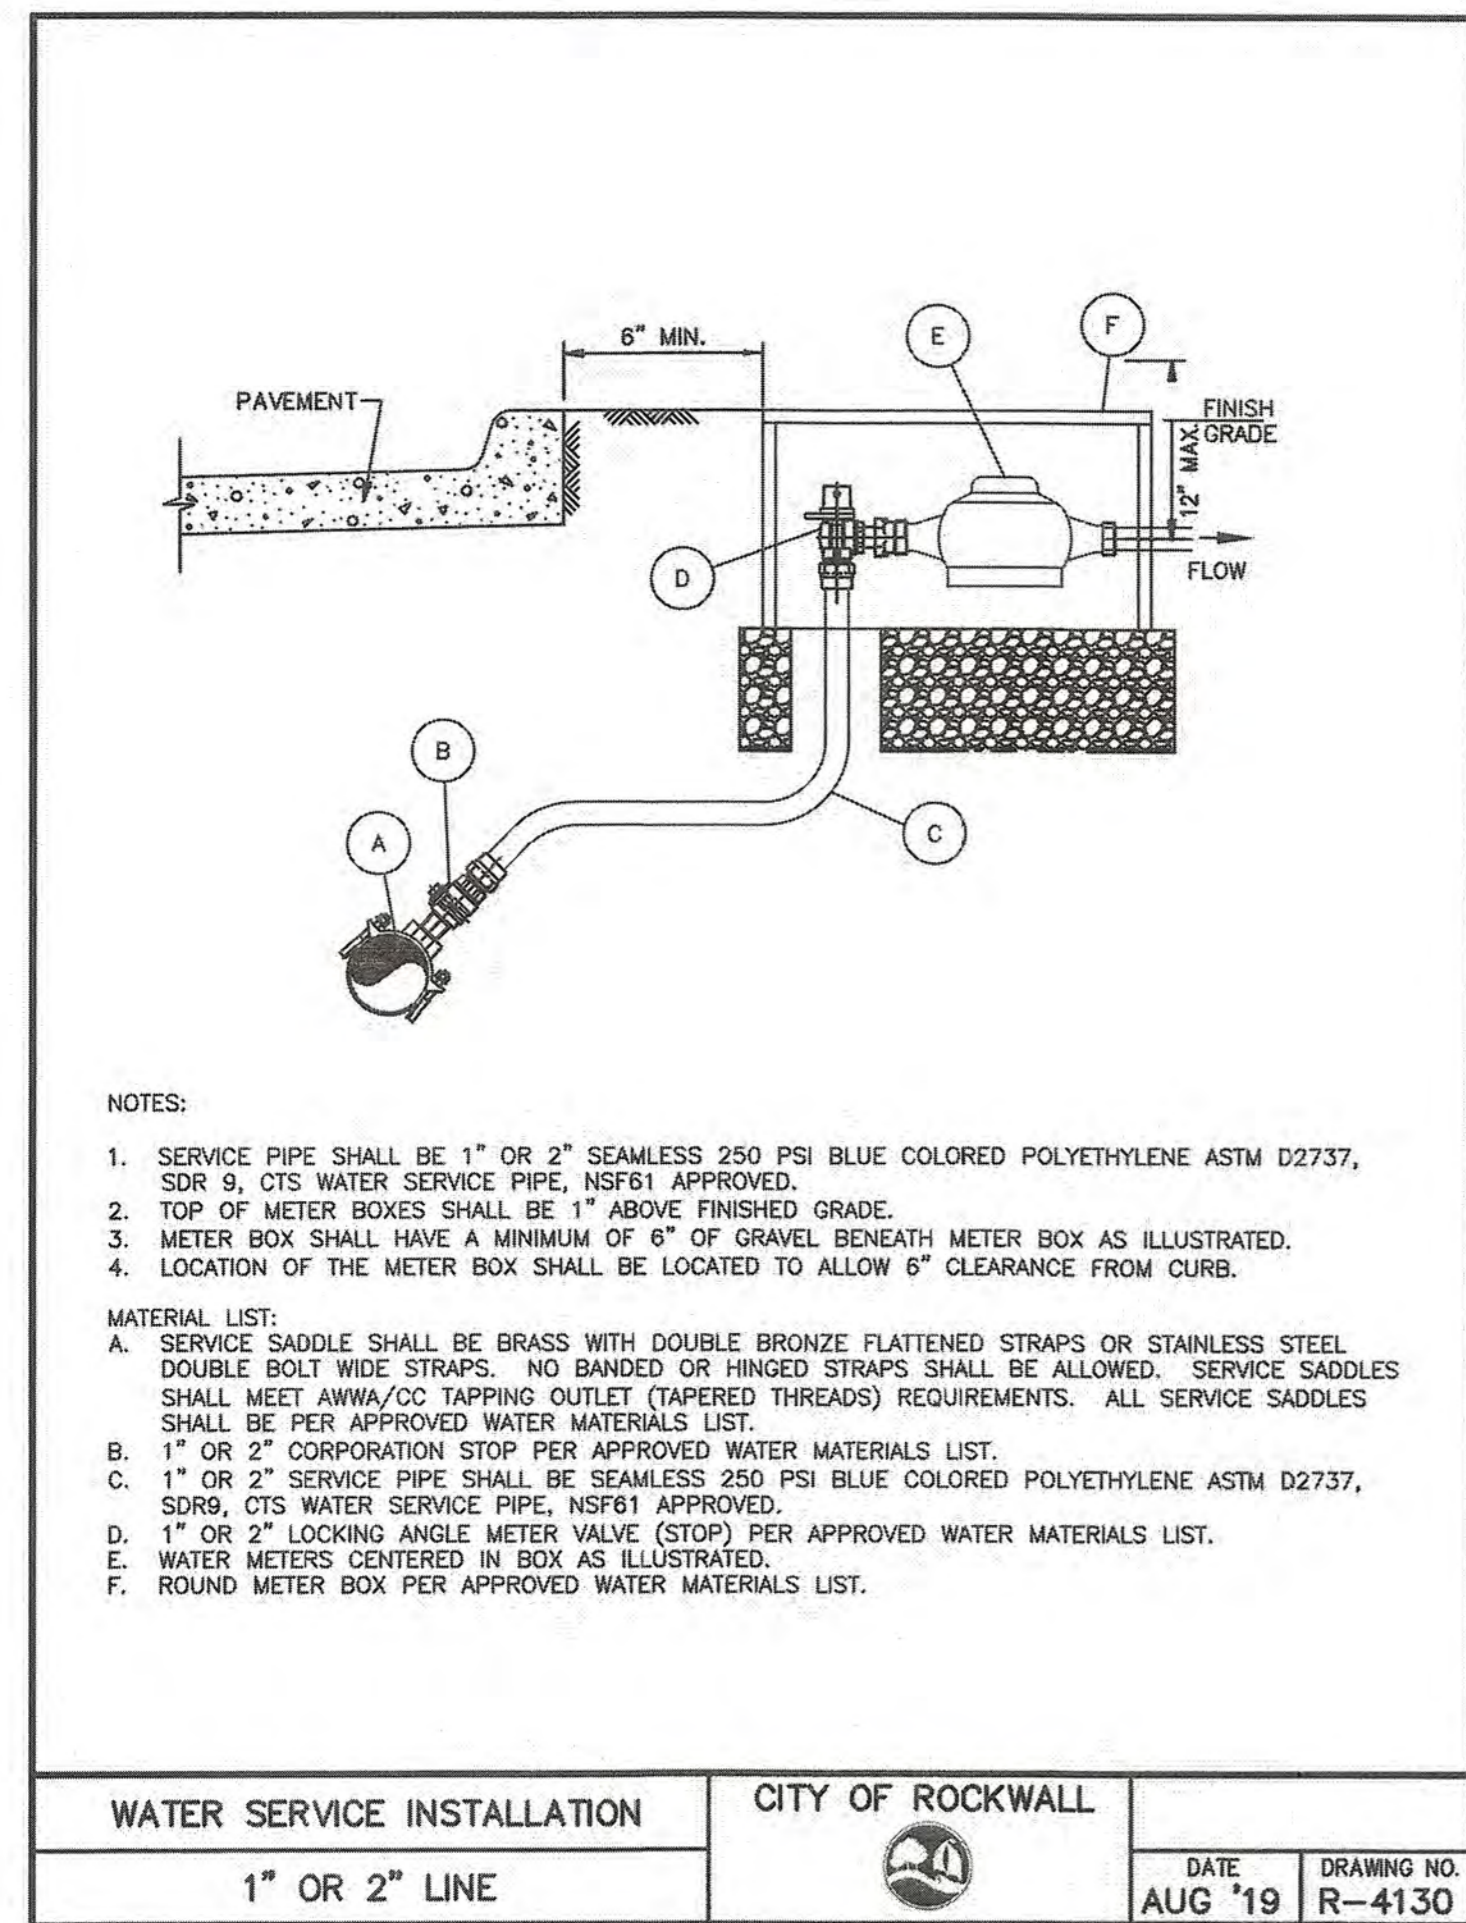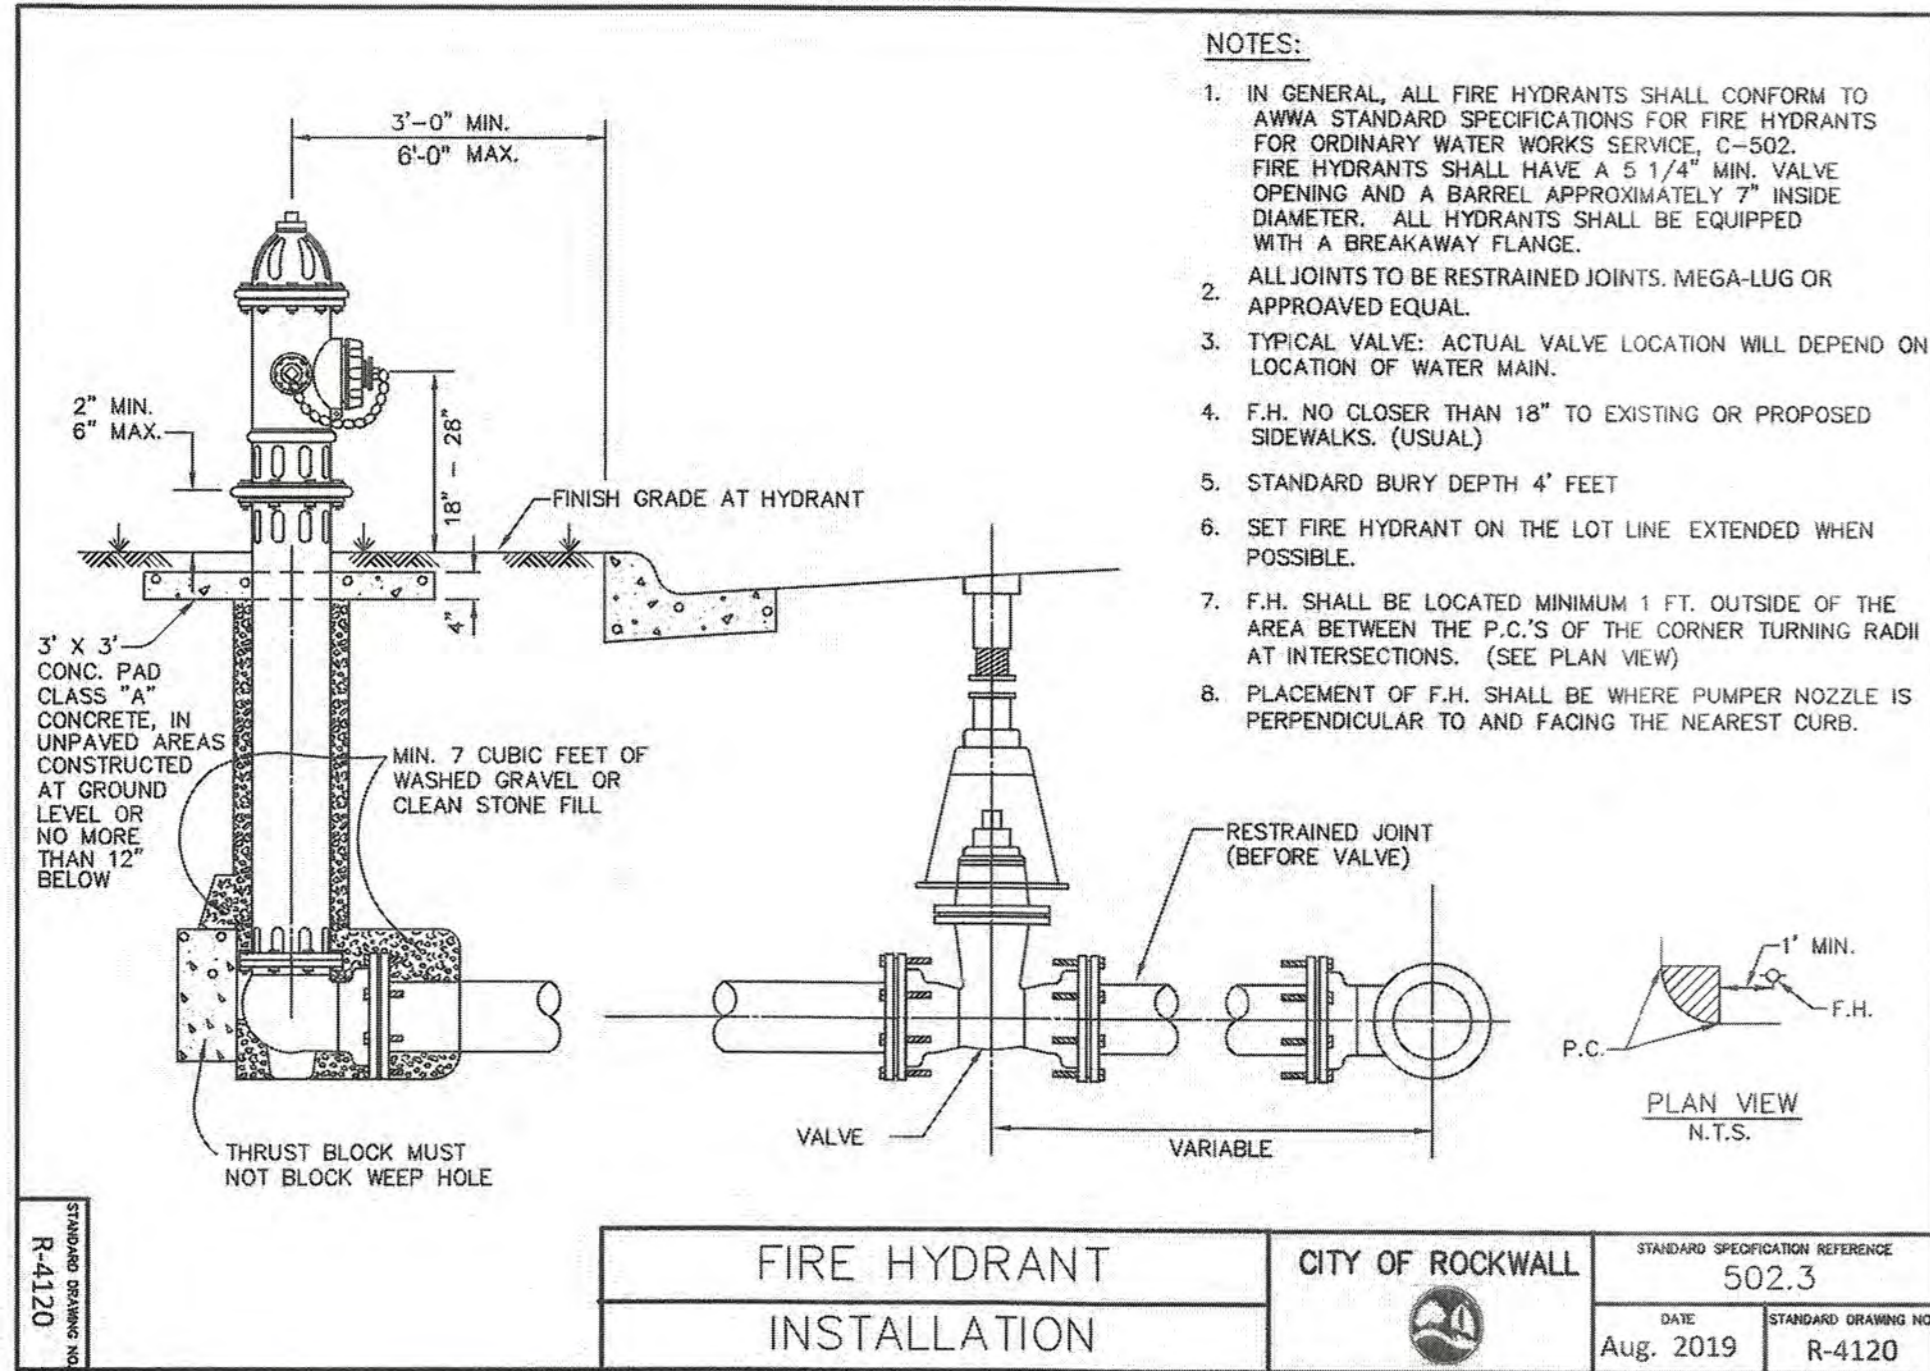

**RECORD DRAWINGS**

To the best of our knowledge Engineering Concepts & Design, L.P., hereby states that this plan is As-Built. This information provided is based on surveying at the site and information provided by the contractor.

*Ryan C. King*  
RYAN C. KING

1/27/2021  
DATE

RELEASED FOR CONSTRUCTION  
ALL RESPONSIBILITY FOR ADEQUACY OF DESIGN REMAINS WITH THE DESIGN ENGINEER. THE CITY OF ROCKWALL, IN REVIEWING AND RELEASING PLANS FOR CONSTRUCTION, ASSUMES NO RESPONSIBILITY FOR ADEQUACY OR ACCURACY OF DESIGN.

CITY \_\_\_\_\_ DATE \_\_\_\_\_

**CAUTION! EXISTING UTILITIES**

CONTRACTOR SHOULD CALL 1-800-485-7838 PRIOR TO BEGINNING ANY CONSTRUCTION ACTIVITIES FOR EXISTING UTILITY LOCATIONS. EXISTING UTILITIES AND UNDERGROUND FACILITIES INDICATED ON THESE PLANS HAVE BEEN LOCATED FROM REFERENCE INFORMATION. IT IS THE RESPONSIBILITY OF THE CONTRACTOR TO VERIFY BOTH HORIZONTALLY AND VERTICALLY THE LOCATION OF ALL EXISTING UTILITIES AND UNDERGROUND FACILITIES PRIOR TO CONSTRUCTION AND TO TAKE NECESSARY PRECAUTIONS IN ORDER TO PROTECT ALL FACILITIES ENCOUNTERED. THE CONTRACTOR SHALL PRESERVE AND PROTECT ALL EXISTING UTILITIES FROM DAMAGE DURING CONSTRUCTION.

BM-1: "PK" Nail on the south side of Clem Road, approximately 2275' west of the centerline intersection of Clem Road and FM 3549  
Elev.: 559.07'

BM-2: "PK" Nail in Clem Road, approximately 175' west of the centerline intersection of Clem Road and FM 3549  
Elev.: 584.83'

**ENGINEERINGCONCEPTS**  
& DESIGN, L.P.

ENGINEERING / PROJECT MANAGEMENT /  
CONSTRUCTION SERVICES - FIRM REG. #F-001145  
201 WINDCO CIR, STE 200, WYLIE, TX 75098  
972-941-8400 FAX: 972-941-8401 WWW.ECDLP.COM

**REVISIONS:**

DRAWN: MJH	DATE:
CHECKED: RCK	DATE: 6/1/2020
PROJECT NO.: 08838	
DWG FILE NAME: 08838 DT.DWG	

THIS DOCUMENT IS RELEASED FOR THE PURPOSE OF CONSTRUCTION. THE SEAL APPEARING ON THIS DOCUMENT WAS AUTHORIZED BY RYAN C. KING, P.E. 123635



**WATER DETAILS 2**

**NORTHGATE**

CITY OF ROCKWALL, ROCKWALL COUNTY, TEXAS

SHEET  
37  
OF  
40

TABLE OF VARIABLE DIMENSIONS AND QUANTITIES FOR ONE HEADWALL

Values for One Pipe	Values for One Pipe
W	W
12" 9'-0" 122 1.1 1'-0" 15 0.2	12" 9'-0" 122 1.1 1'-0" 15 0.2
18" 10'-3" 136 1.3 2'-2" 16 0.2	18" 10'-3" 136 1.3 2'-2" 16 0.2
24" 11'-6" 163 1.5 3'-0" 19 0.3	24" 11'-6" 163 1.5 3'-0" 19 0.3
30" 12'-9" 200 1.8 3'-11" 23 0.4	30" 12'-9" 200 1.8 3'-11" 23 0.4
36" 14'-0" 217 2.1 3'-7" 24 0.4	36" 14'-0" 217 2.1 3'-7" 24 0.4
42" 15'-3" 254 2.4 3'-11" 27 0.5	42" 15'-3" 254 2.4 3'-11" 27 0.5
48" 16'-6" 272 2.7 4'-4" 30 0.6	48" 16'-6" 272 2.7 4'-4" 30 0.6
54" 17'-9" 214 3.1 4'-8" 32 0.6	54" 17'-9" 214 3.1 4'-8" 32 0.6
60" 18'-0" 371 3.9 5'-1" 46 0.8	60" 18'-0" 371 3.9 5'-1" 46 0.8
66" 19'-3" 442 4.9 5'-10" 52 1.0	66" 19'-3" 442 4.9 5'-10" 52 1.0
72" 20'-6" 569 6.4 6'-7" 59 1.3	72" 20'-6" 569 6.4 6'-7" 59 1.3
78" 21'-9" 701 7.5 7'-0" 62 1.6	78" 21'-9" 701 7.5 7'-0" 62 1.6
84" 22'-0" 794 8.8 8'-3" 90 1.8	84" 22'-0" 794 8.8 8'-3" 90 1.8
90" 22'-6" 894 10.2 8'-9" 96 2.0	90" 22'-6" 894 10.2 8'-9" 96 2.0
96" 23'-0" 1,055 11.7 9'-4" 103 2.3	96" 23'-0" 1,055 11.7 9'-4" 103 2.3
102" 23'-6" 115 1.6 1'-0" 14 0.2	102" 23'-6" 115 1.6 1'-0" 14 0.2
108" 24'-0" 193 1.9 2'-2" 17 0.2	108" 24'-0" 193 1.9 2'-2" 17 0.2
114" 24'-6" 228 2.2 2'-8" 19 0.3	114" 24'-6" 228 2.2 2'-8" 19 0.3
120" 25'-0" 299 2.6 3'-1" 31 0.4	120" 25'-0" 299 2.6 3'-1" 31 0.4
126" 25'-6" 323 3.0 3'-7" 32 0.4	126" 25'-6" 323 3.0 3'-7" 32 0.4
132" 26'-0" 371 3.5 3'-11" 37 0.5	132" 26'-0" 371 3.5 3'-11" 37 0.5
138" 26'-6" 415 4.0 4'-4" 40 0.6	138" 26'-6" 415 4.0 4'-4" 40 0.6
144" 27'-0" 469 4.6 4'-8" 43 0.6	144" 27'-0" 469 4.6 4'-8" 43 0.6
150" 27'-6" 556 5.9 5'-1" 46 0.8	150" 27'-6" 556 5.9 5'-1" 46 0.8
156" 28'-0" 675 7.1 5'-10" 52 1.0	156" 28'-0" 675 7.1 5'-10" 52 1.0
162" 28'-6" 837 9.2 6'-7" 59 1.3	162" 28'-6" 837 9.2 6'-7" 59 1.3
168" 29'-0" 1,015 11.0 7'-0" 62 1.6	168" 29'-0" 1,015 11.0 7'-0" 62 1.6
174" 29'-6" 1,171 12.9 8'-3" 91 1.8	174" 29'-6" 1,171 12.9 8'-3" 91 1.8
180" 30'-0" 1,298 14.9 8'-9" 96 2.0	180" 30'-0" 1,298 14.9 8'-9" 96 2.0
186" 30'-6" 1,361 17.1 9'-4" 103 2.3	186" 30'-6" 1,361 17.1 9'-4" 103 2.3
192" 31'-0" 229 2.2 1'-0" 14 0.2	192" 31'-0" 229 2.2 1'-0" 14 0.2
198" 31'-6" 266 2.4 2'-2" 17 0.2	198" 31'-6" 266 2.4 2'-2" 17 0.2
204" 32'-0" 308 2.9 2'-8" 19 0.3	204" 32'-0" 308 2.9 2'-8" 19 0.3
210" 32'-6" 382 3.5 3'-1" 31 0.4	210" 32'-6" 382 3.5 3'-1" 31 0.4
216" 33'-0" 444 3.9 3'-7" 32 0.4	216" 33'-0" 444 3.9 3'-7" 32 0.4
222" 33'-6" 496 4.7 3'-11" 37 0.5	222" 33'-6" 496 4.7 3'-11" 37 0.5
228" 34'-0" 539 5.2 4'-4" 40 0.6	228" 34'-0" 539 5.2 4'-4" 40 0.6
234" 34'-6" 603 6.0 4'-8" 42 0.6	234" 34'-6" 603 6.0 4'-8" 42 0.6
240" 35'-0" 738 7.5 5'-1" 46 0.8	240" 35'-0" 738 7.5 5'-1" 46 0.8
246" 35'-6" 881 9.3 5'-10" 52 1.0	246" 35'-6" 881 9.3 5'-10" 52 1.0
252" 36'-0" 1,102 12.1 6'-7" 61 1.3	252" 36'-0" 1,102 12.1 6'-7" 61 1.3
258" 36'-6" 1,364 14.4 7'-0" 62 1.6	258" 36'-6" 1,364 14.4 7'-0" 62 1.6
264" 37'-0" 1,547 16.9 8'-3" 91 1.8	264" 37'-0" 1,547 16.9 8'-3" 91 1.8
270" 37'-6" 1,741 19.5 8'-9" 96 2.0	270" 37'-6" 1,741 19.5 8'-9" 96 2.0
276" 38'-0" 2,017 22.4 9'-4" 103 2.3	276" 38'-0" 2,017 22.4 9'-4" 103 2.3
282" 38'-6" 338 3.0 1'-0" 14 0.2	282" 38'-6" 338 3.0 1'-0" 14 0.2
288" 39'-0" 394 3.6 2'-2" 17 0.2	288" 39'-0" 394 3.6 2'-2" 17 0.2
294" 39'-6" 452 4.2 2'-8" 19 0.3	294" 39'-6" 452 4.2 2'-8" 19 0.3
300" 40'-0" 581 5.1 3'-1" 31 0.4	300" 40'-0" 581 5.1 3'-1" 31 0.4
306" 40'-6" 644 5.8 3'-7" 32 0.4	306" 40'-6" 644 5.8 3'-7" 32 0.4
312" 41'-0" 737 6.9 3'-11" 37 0.5	312" 41'-0" 737 6.9 3'-11" 37 0.5
318" 41'-6" 807 7.7 4'-4" 39 0.6	318" 41'-6" 807 7.7 4'-4" 39 0.6
324" 42'-0" 912 8.9 4'-8" 42 0.6	324" 42'-0" 912 8.9 4'-8" 42 0.6
330" 42'-6" 1,108 11.0 5'-1" 46 0.8	330" 42'-6" 1,108 11.0 5'-1" 46 0.8
336" 43'-0" 1,318 13.7 5'-10" 54 1.0	336" 43'-0" 1,318 13.7 5'-10" 54 1.0
342" 43'-6" 1,482 17.9 6'-7" 59 1.3	342" 43'-6" 1,482 17.9 6'-7" 59 1.3
348" 44'-0" 2,072 21.3 7'-0" 62 1.6	348" 44'-0" 2,072 21.3 7'-0" 62 1.6
354" 44'-6" 2,351 24.9 8'-3" 91 1.8	354" 44'-6" 2,351 24.9 8'-3" 91 1.8
360" 45'-0" 2,643 28.9 8'-9" 96 2.0	360" 45'-0" 2,643 28.9 8'-9" 96 2.0
366" 45'-6" 3,121 33.1 9'-4" 101 2.3	366" 45'-6" 3,121 33.1 9'-4" 101 2.3

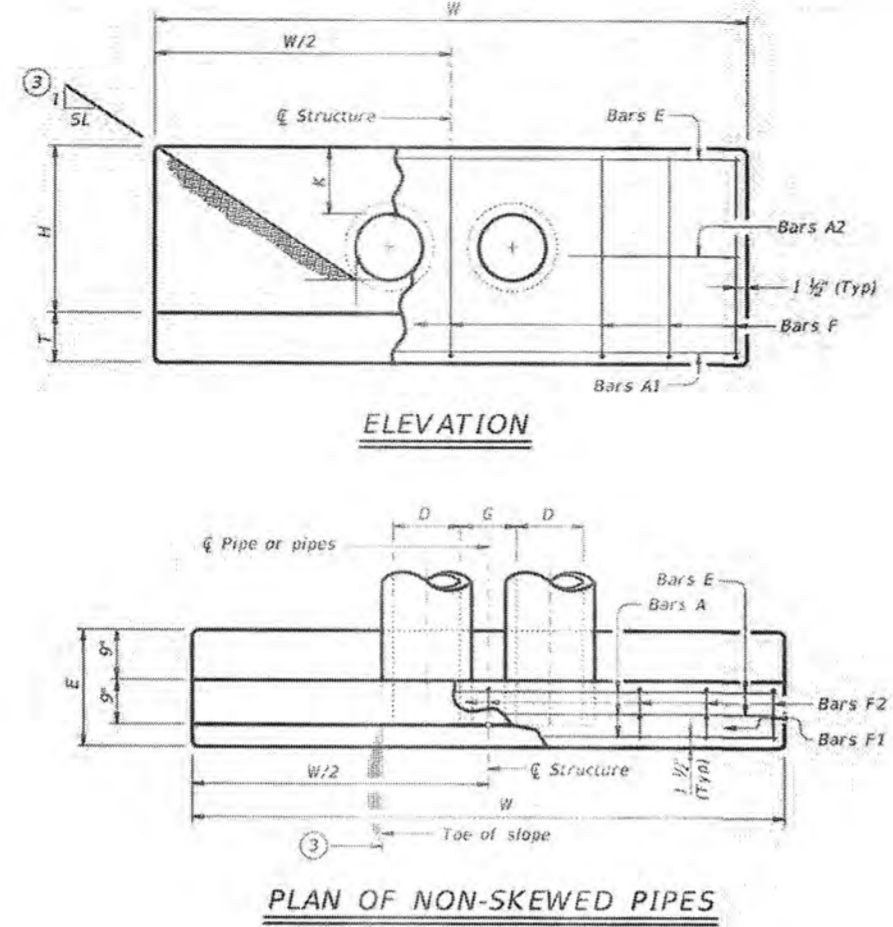


TABLE OF CONSTANT DIMENSIONS

Bar	Size	Spa	No.
A1	#5	-	2
A2	#5	1'-0"	-
E	#5	-	2
F	#5	1'-0"	-

TABLE OF REINFORCING STEEL

Bar	Size	Spa	No.
A1	#5	-	2
A2	#5	1'-0"	-
E	#5	-	2
F	#5	1'-0"	-

MATERIAL NOTES:  
Provide Grade 60 reinforcing steel.  
Provide Class C concrete (FC = 3,000 psi).

GENERAL NOTES:  
Designed according to AASHTO LRFD Bridge Design Specifications.  
Do not mount bridge rails of any type directly to these culvert headwalls.  
This standard may not be used for wall heights, H, exceeding the values shown.

Cover dimensions are clear dimensions, unless noted otherwise.  
Reinforcing dimensions are out-to-out of bars.

TEXAS DEPARTMENT OF TRANSPORTATION

BRIDGE DIVISION

CONCRETE HEADWALLS WITH PARALLEL WINGS FOR NON-SKEWED PIPE CULVERTS

CH-PW-0

REV. 01/2010

REV. 02/2010

REV. 03/2010

REV. 04/2010

REV. 05/2010

REV. 06/2010

REV. 07/2010

REV. 08/2010

REV. 09/2010

REV. 10/2010

REV. 11/2010

REV. 12/2010

REV. 01/2011

REV. 02/2011

REV. 03/2011

REV. 04/2011

REV. 05/2011

REV. 06/2011

REV. 07/2011

REV. 08/2011

REV. 09/2011

REV. 10/2011

REV. 11/2011

REV. 12/2011

REV. 01/2012

REV. 02/2012

REV. 03/2012

REV. 04/2012

REV. 05/2012

REV. 06/2012

REV. 07/2012

REV. 08/2012

REV. 09/2012

REV. 10/2012

REV. 11/2012

REV. 12/2012

REV. 01/2013

REV. 02/2013

REV. 03/2013

REV. 04/2013

REV. 05/2013

REV. 06/2013

REV. 07/2013

REV. 08/2013

REV. 09/2013

REV. 10/2013

REV. 11/2013

REV. 12/2013

REV. 01/2014

REV. 02/2014

REV. 03/2014

REV. 04/2014

REV. 05/2014

REV. 06/2014

REV. 07/2014

REV. 08/2014

REV. 09/2014

REV. 10/2014

REV. 11/2014

REV. 12/2014

REV. 07/2029

REV. 08/2029

REV. 09/2029

REV. 10/2029

REV. 11/2029

REV. 12/2029

REV. 01/2030

REV. 02/2030

REV. 03/2030

REV. 04/2030

REV. 05/2030

REV. 06/2030

REV. 07/2030


REV. 08/2030

REV. 09/2030



REV. 10/2030

REV. 11/2030

REV. 12/2030

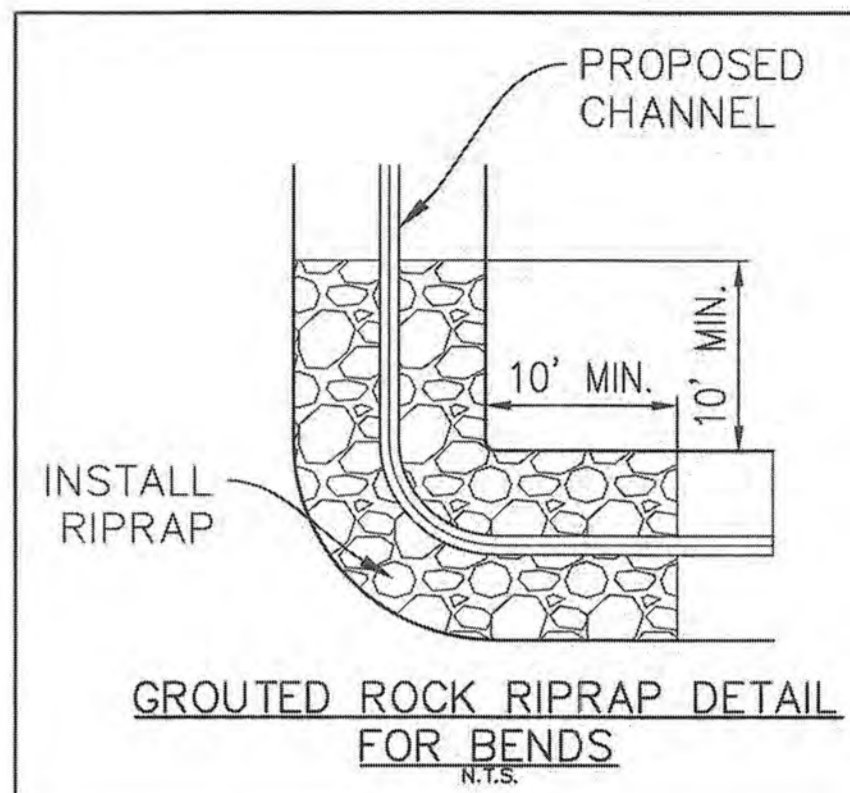

NOTE:  
GROUT WILL BE PLACED FIRST AND ROCK PLACED INTO "WET" GROUT

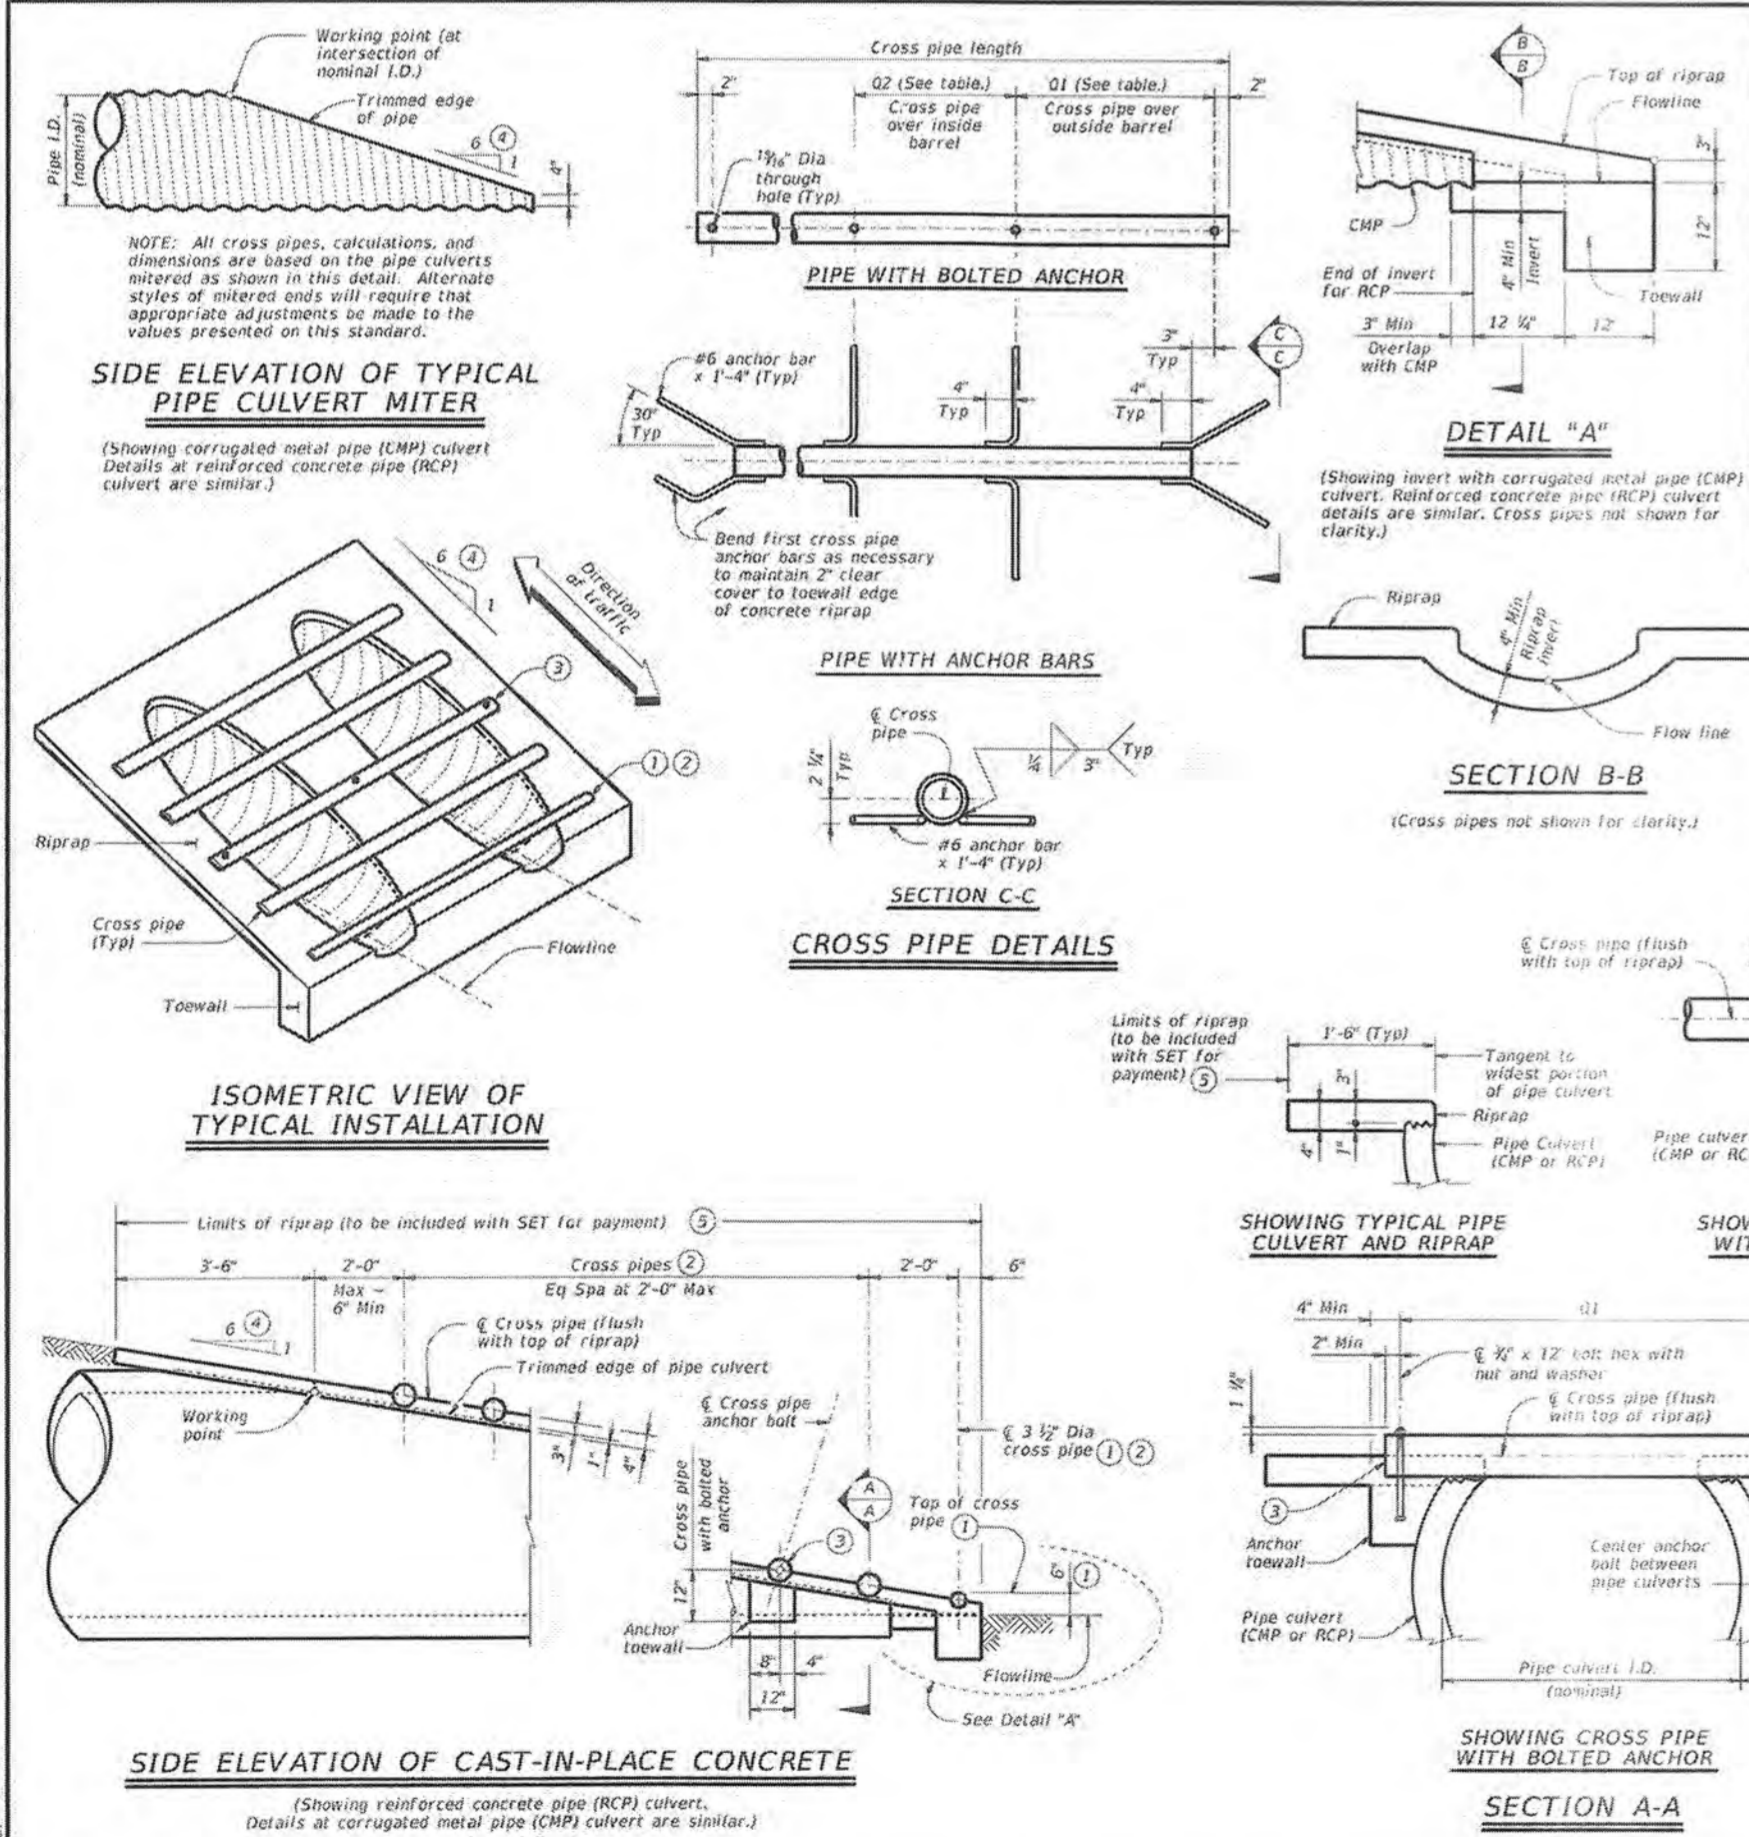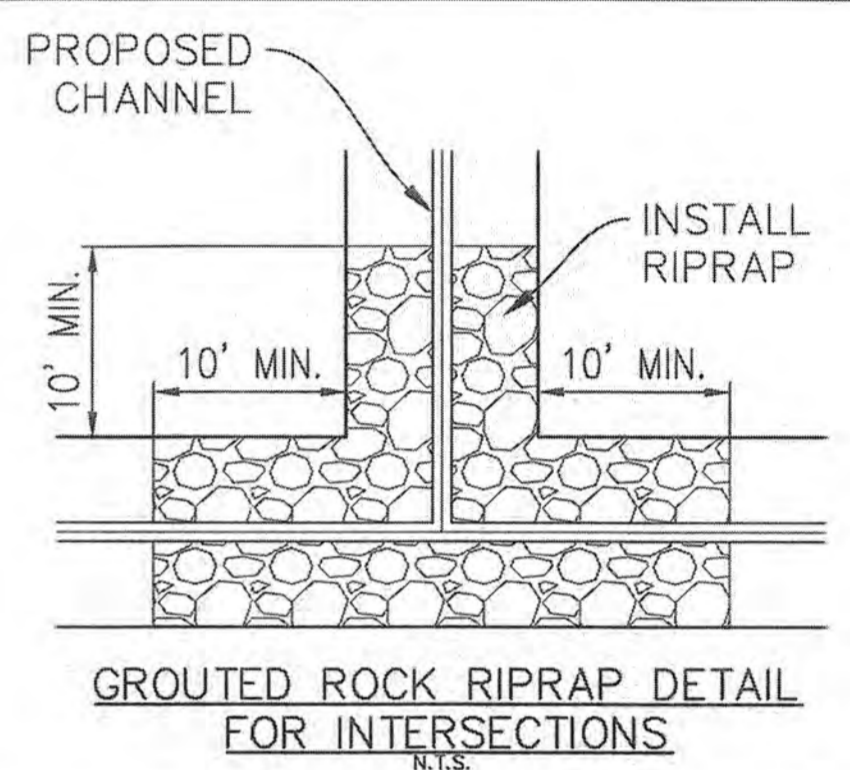

CROSS PIPE LENGTHS, REQUIRED PIPE SIZES, AND RIPRAP QUANTITIES

Nominal Culvert (in.)	Conc. Riprap (in.)	Single Barrel	Multi-Barrel	Q2	Conditions for Use of Cross Pipes	Cross Pipe Sizes
12"	0.6	0'-0"	N/A	2'-1"	1'-9"	3' Sid (1,500' O.D.)
18"	0.7	0'-11"	N/A	2'-5"	2'-2"	3' Sid (1,500' O.D.)
24"	0.8	1'-2"	N/A	2'-10"	2'-8"	3' Sid (1,500' O.D.)
30"	0.9	1'-7"	N/A	3'-2"	3'-1"	3' Sid (1,500' O.D.)
36"	1.0	1'-8"	N/A	3'-10"	3'-11"	3' Sid (1,500' O.D.)
42"	1.1	1'-10"	N/A	4'-2"	4'-4"	3' Sid (1,500' O.D.)
48"	1.2	1'-11"	N/A	4'-5"	4'-9"	3' Sid (1,500' O.D.)
54"	1.3	2'-1"	N/A	4'-9"	5'-1"	3' Sid (1,500' O.D.)
60"	1.5	2'-4"	N/A	5'-5"	5'-10"	3' Sid (1,500' O.D.)
66"	1.7	2'-7"	N/A	6'-0"	6'-7"	3' Sid (1,500' O.D.)
72"	2.0	3'-0"	N/A	6'-11"	6'-9"	3' Sid (1,500' O.D.)
78"	2.2	3'-3"	N/A	7'-4"	7'-8"	3' Sid (1,500' O.D.)
84"	2.4	3'-6"	N/A	7'-10"	8'-9"	3' Sid (1,500' O.D.)
90"	2.7	3'-9"	N/A	8'-5"	9'-4"	3' Sid (1,500' O.D.)

1. The proper installation of the first cross pipe is critical for vehicle safety. Place the top of the first cross pipe no more than 6" above the flow line.

2. Provide cross pipes, except the first bottom pipe, of the size shown in the table. Provide a 3 1/2" standard pipe (4" O.D.) for the first bottom pipe.

3. Install the third cross pipe from the bottom of the culvert using a bolted connection. Ensure that riprap concrete does not flow into the cross pipe so as to permit dissipation of the bolted connection to allow cleanout access. At the Contractor's option, install all other cross pipes using the bolted connection details.

4. Match cross slope as shown elsewhere in the plans. Cross slope of 8:1 or flatter is required for vehicle safety.

5. Riprap placed beyond the limits shown will be paid for as concrete riprap in accordance with Item 432, "Riprap".

6. Quantities shown are for one reinforced concrete pipe (RCP) culvert. For multiple pipe culverts or for corrugated metal pipe (CMP) culverts, quantities will need to be adjusted. Riprap quantities are for contractor's information only.

MATERIAL NOTES:  
Synthetic fibers listed on the "Fibers for Concrete" Material Producer List (MPL) may be used in lieu of steel reinforcing for riprap concrete unless noted otherwise.  
Provide cross pipes that meet the requirements of ASTM A53 (Type E or S, or B), ASTM A500 for RCP or API 5LX55.  
Provide ASTM A307 bolts and nuts.  
Galvanize all steel components, except concrete reinforcing, after fabrication. Riprap galvanized during transport or construction in accordance with the specifications.

GENERAL NOTES:  
Cross pipes are designed for a traversing load of 10,000 pounds as yield as recommended by Research Report 380-37, "Safety Treatment of Roadside Parallel-Drainage Structures", Texas Transportation Institute, March 1981.  
Safety and treatment (SET) shown herein are intended for use in those installations where out of control vehicles are likely to traverse the openings approximately perpendicular to the cross pipes.  
Consider concrete riprap and all necessary inverts in accordance with the requirements of Item 432, "Riprap".  
Pay item for riprap and tonnage is included in the Price Bid for each Safety End Treatment.

TEXAS DEPARTMENT OF TRANSPORTATION

BRIDGE DIVISION

SAFETY END TREATMENT FOR 12" DIA TO 72" DIA PIPE CULVERTS TYPE II - PARALLEL DRAINAGE

SETP-PD

REV. 01/2010

REV. 02/2010

REV. 03/2010

REV. 04/2010

REV. 05/2010

REV. 06/2010

REV. 07/2010

REV. 08/2010

REV. 09/2010

REV. 10/2010

REV. 11/2010

REV. 12/2010

REV. 01/2011

REV. 02/2011

REV. 03/2011

REV. 04/2011

REV. 05/2011

REV. 06/2011

REV. 07/2011

REV. 08/2011

REV. 09/2011

REV. 10/2011

REV. 11/2011

REV. 12/2011

REV. 01/2012

REV. 02/2012

REV. 03/2012

REV. 04/2012

REV. 05/2012

REV. 06/2012

REV. 07/2012

REV. 08/2012

REV. 09/2012

REV. 10/2012

REV. 11/2012

REV. 12/2012

REV. 01/2013

REV. 02/2013

REV. 03/2013

REV. 04/2013

REV. 05/2013

REV. 06/2013



REV. 07/2013


REV. 08/2013

REV. 09/2013


REV. 10/2013

REV. 11/2013

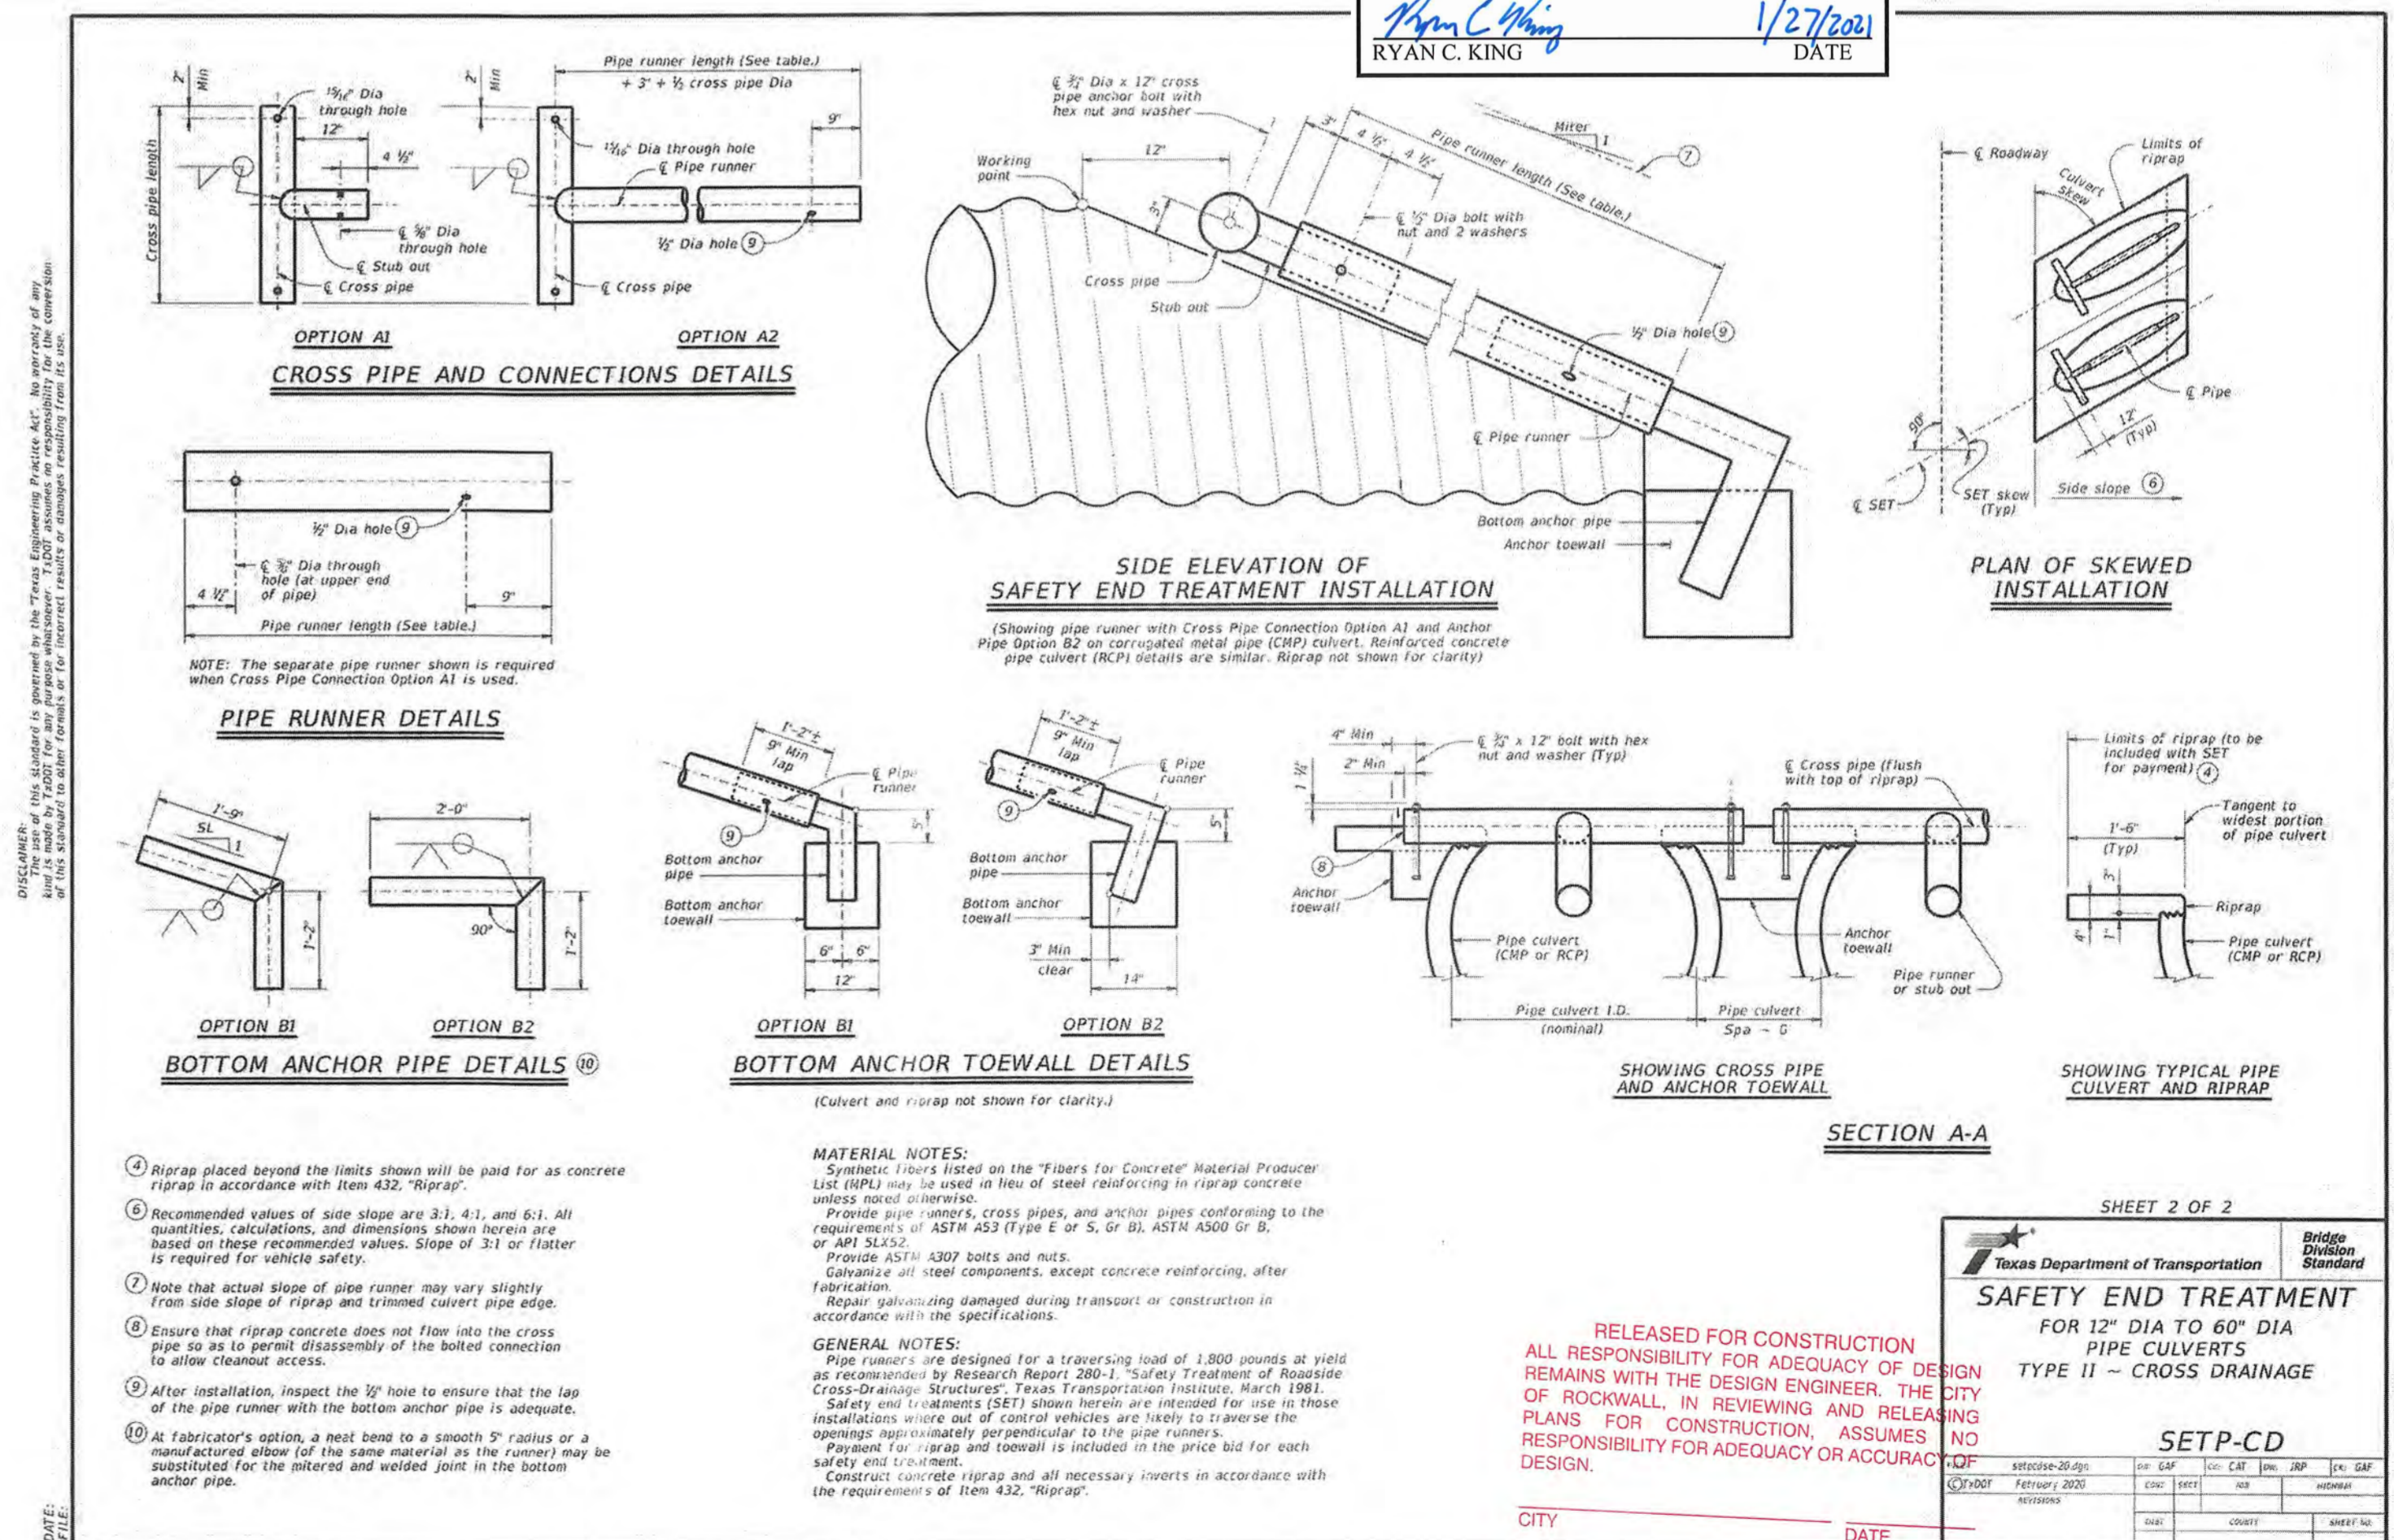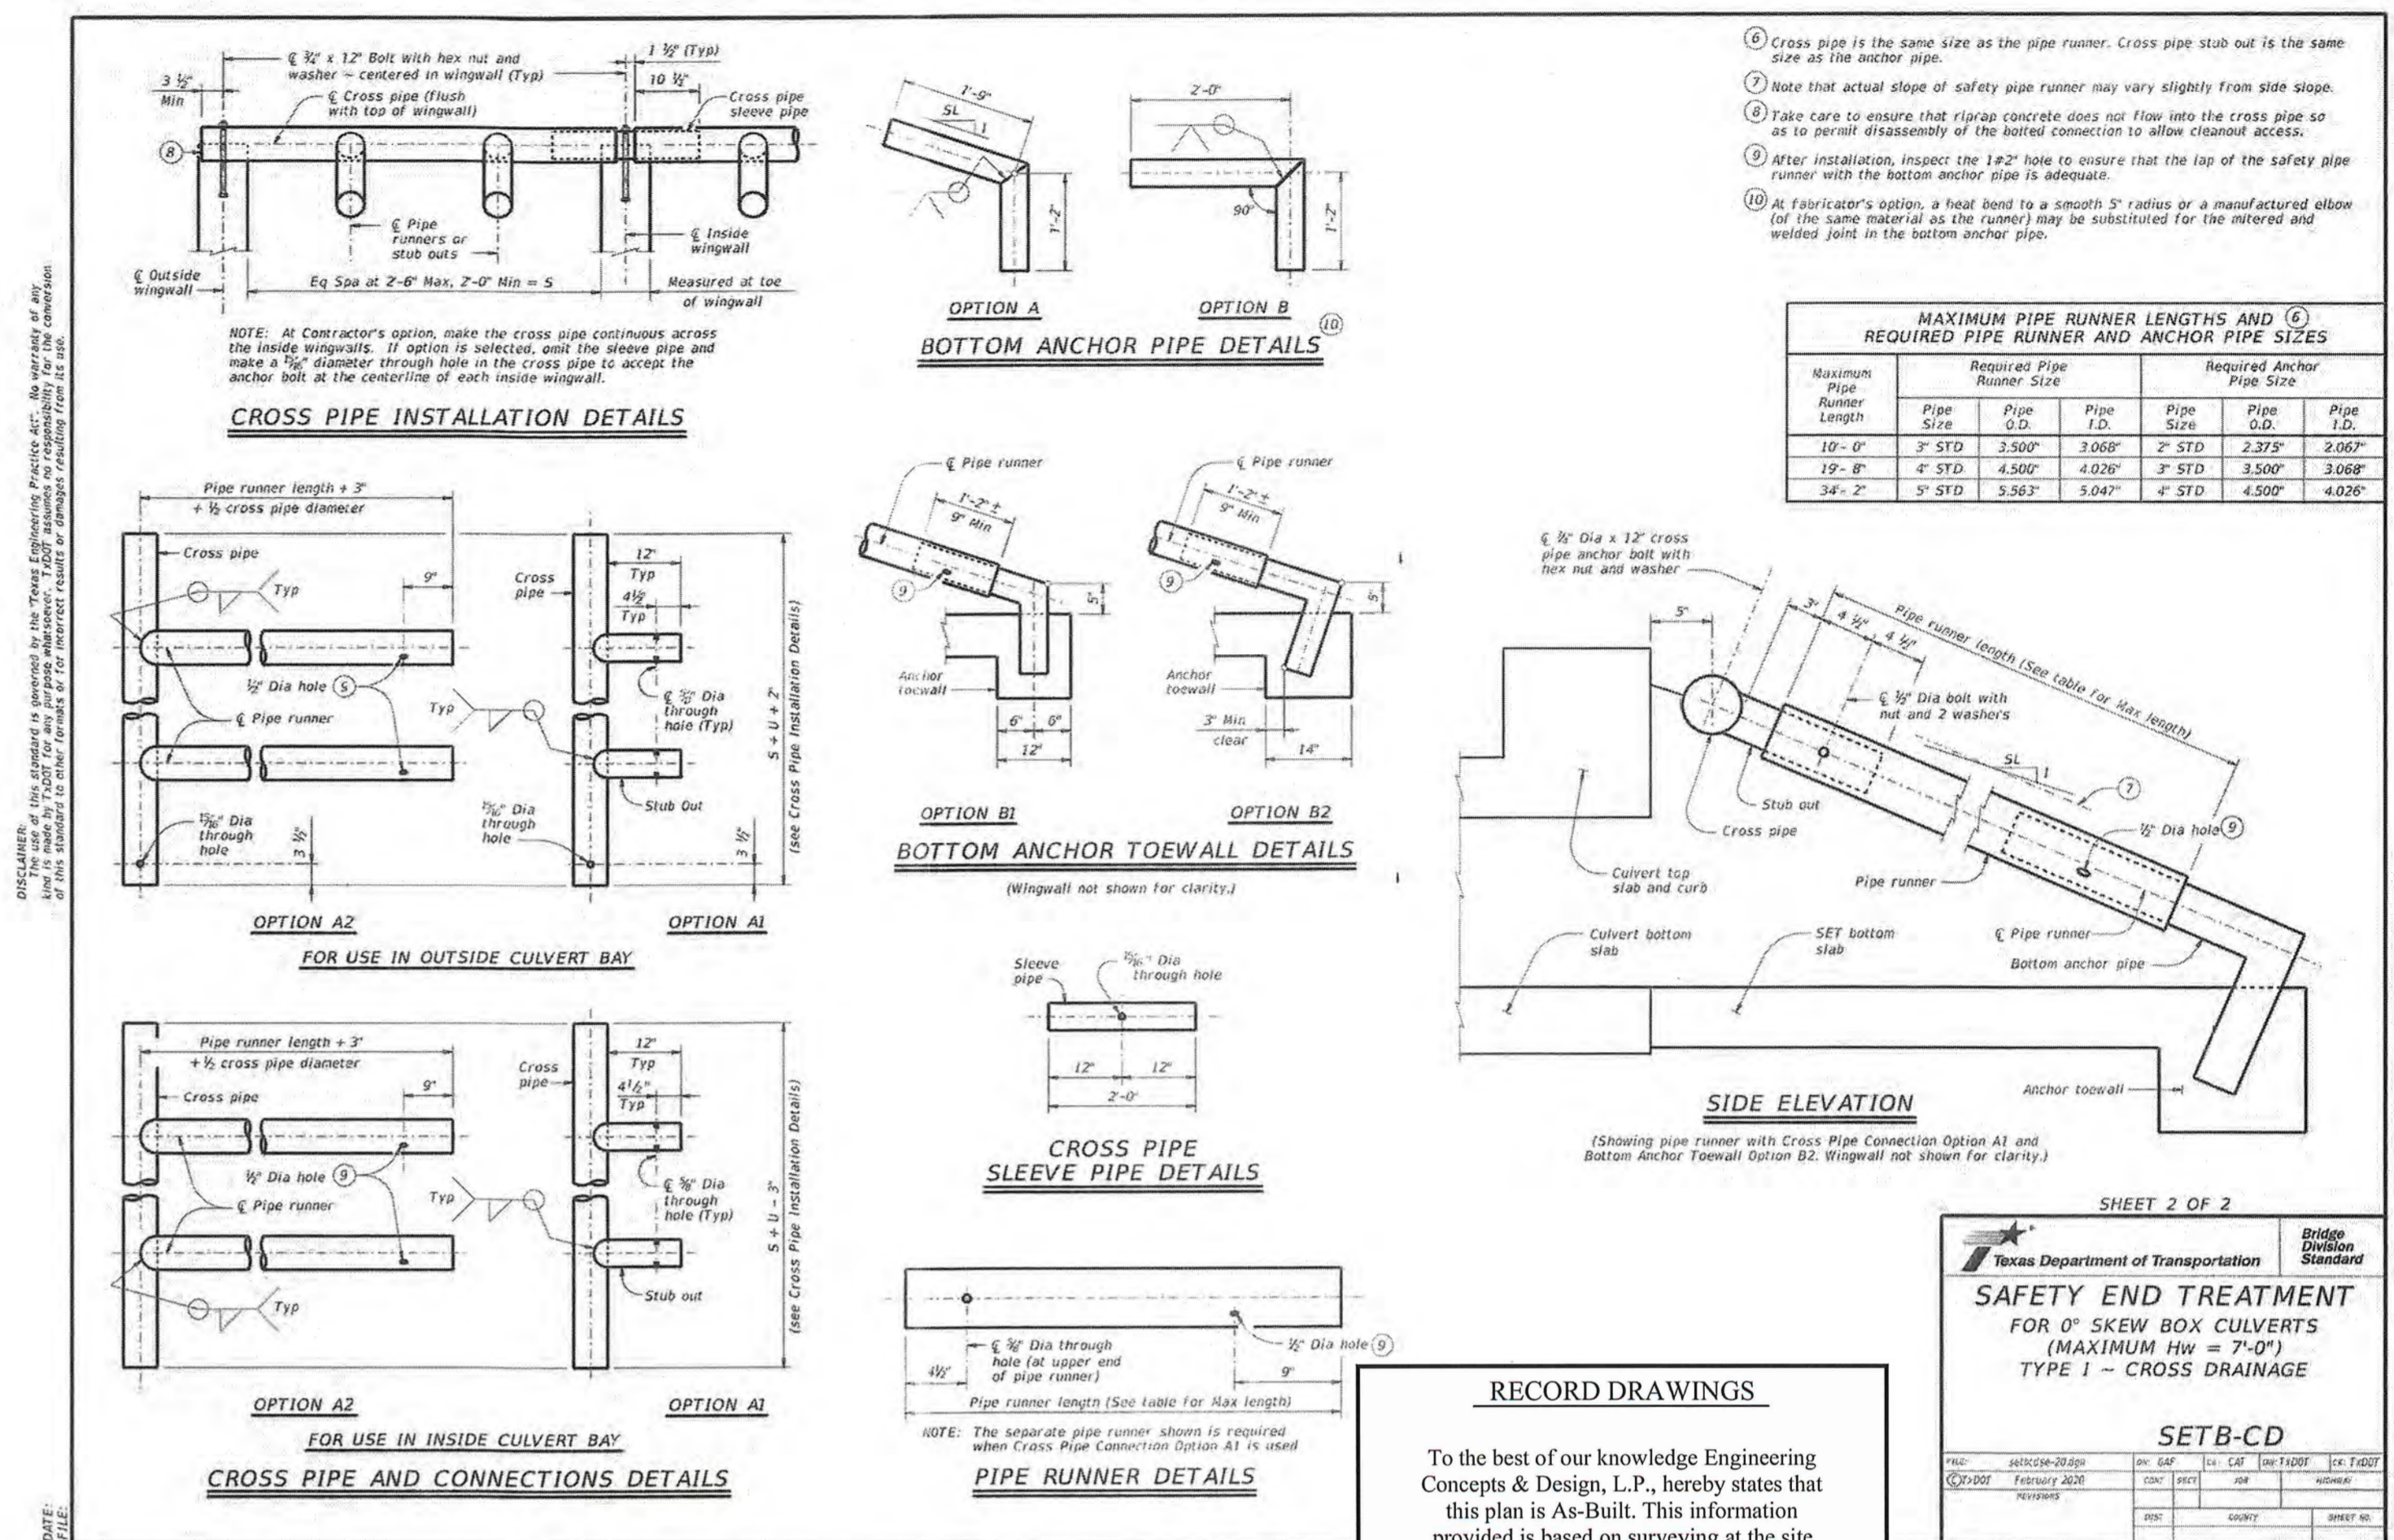


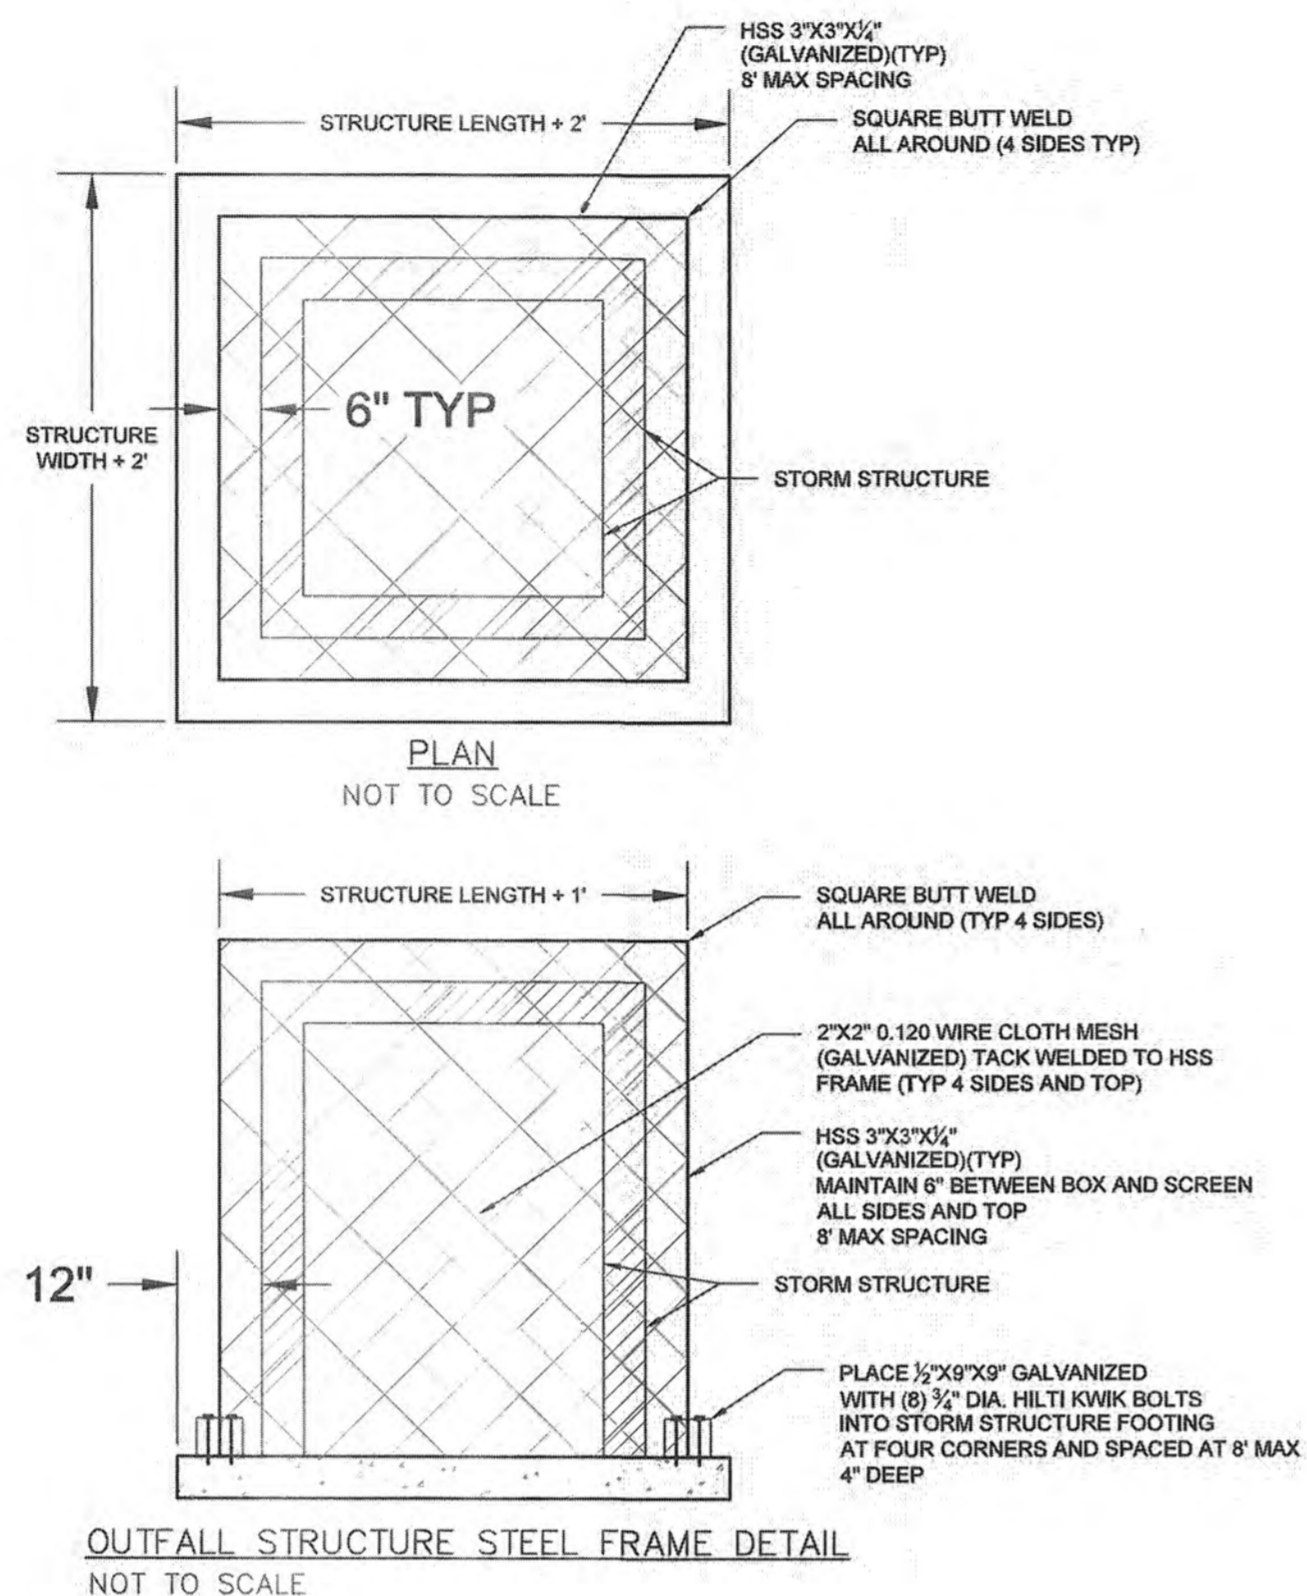

TRASH RACK DETAIL FOR OUTFALL STRUCTURE  
NOT TO SCALE

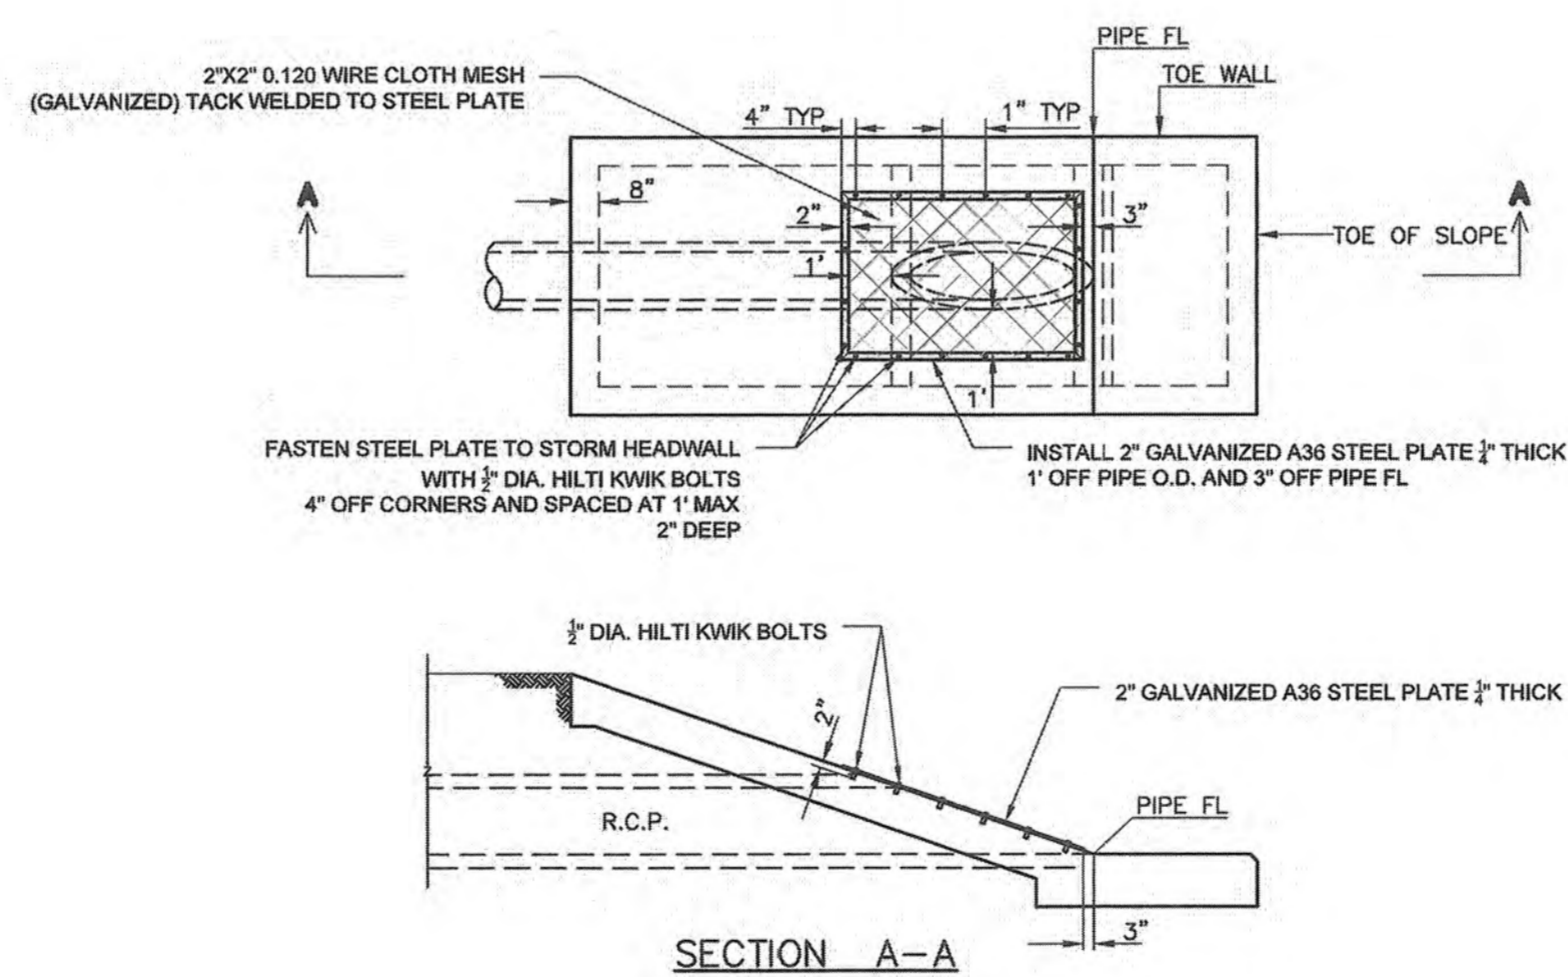

TRASH RACK DETAIL FOR SLOPED HEADWALL  
N.T.S.

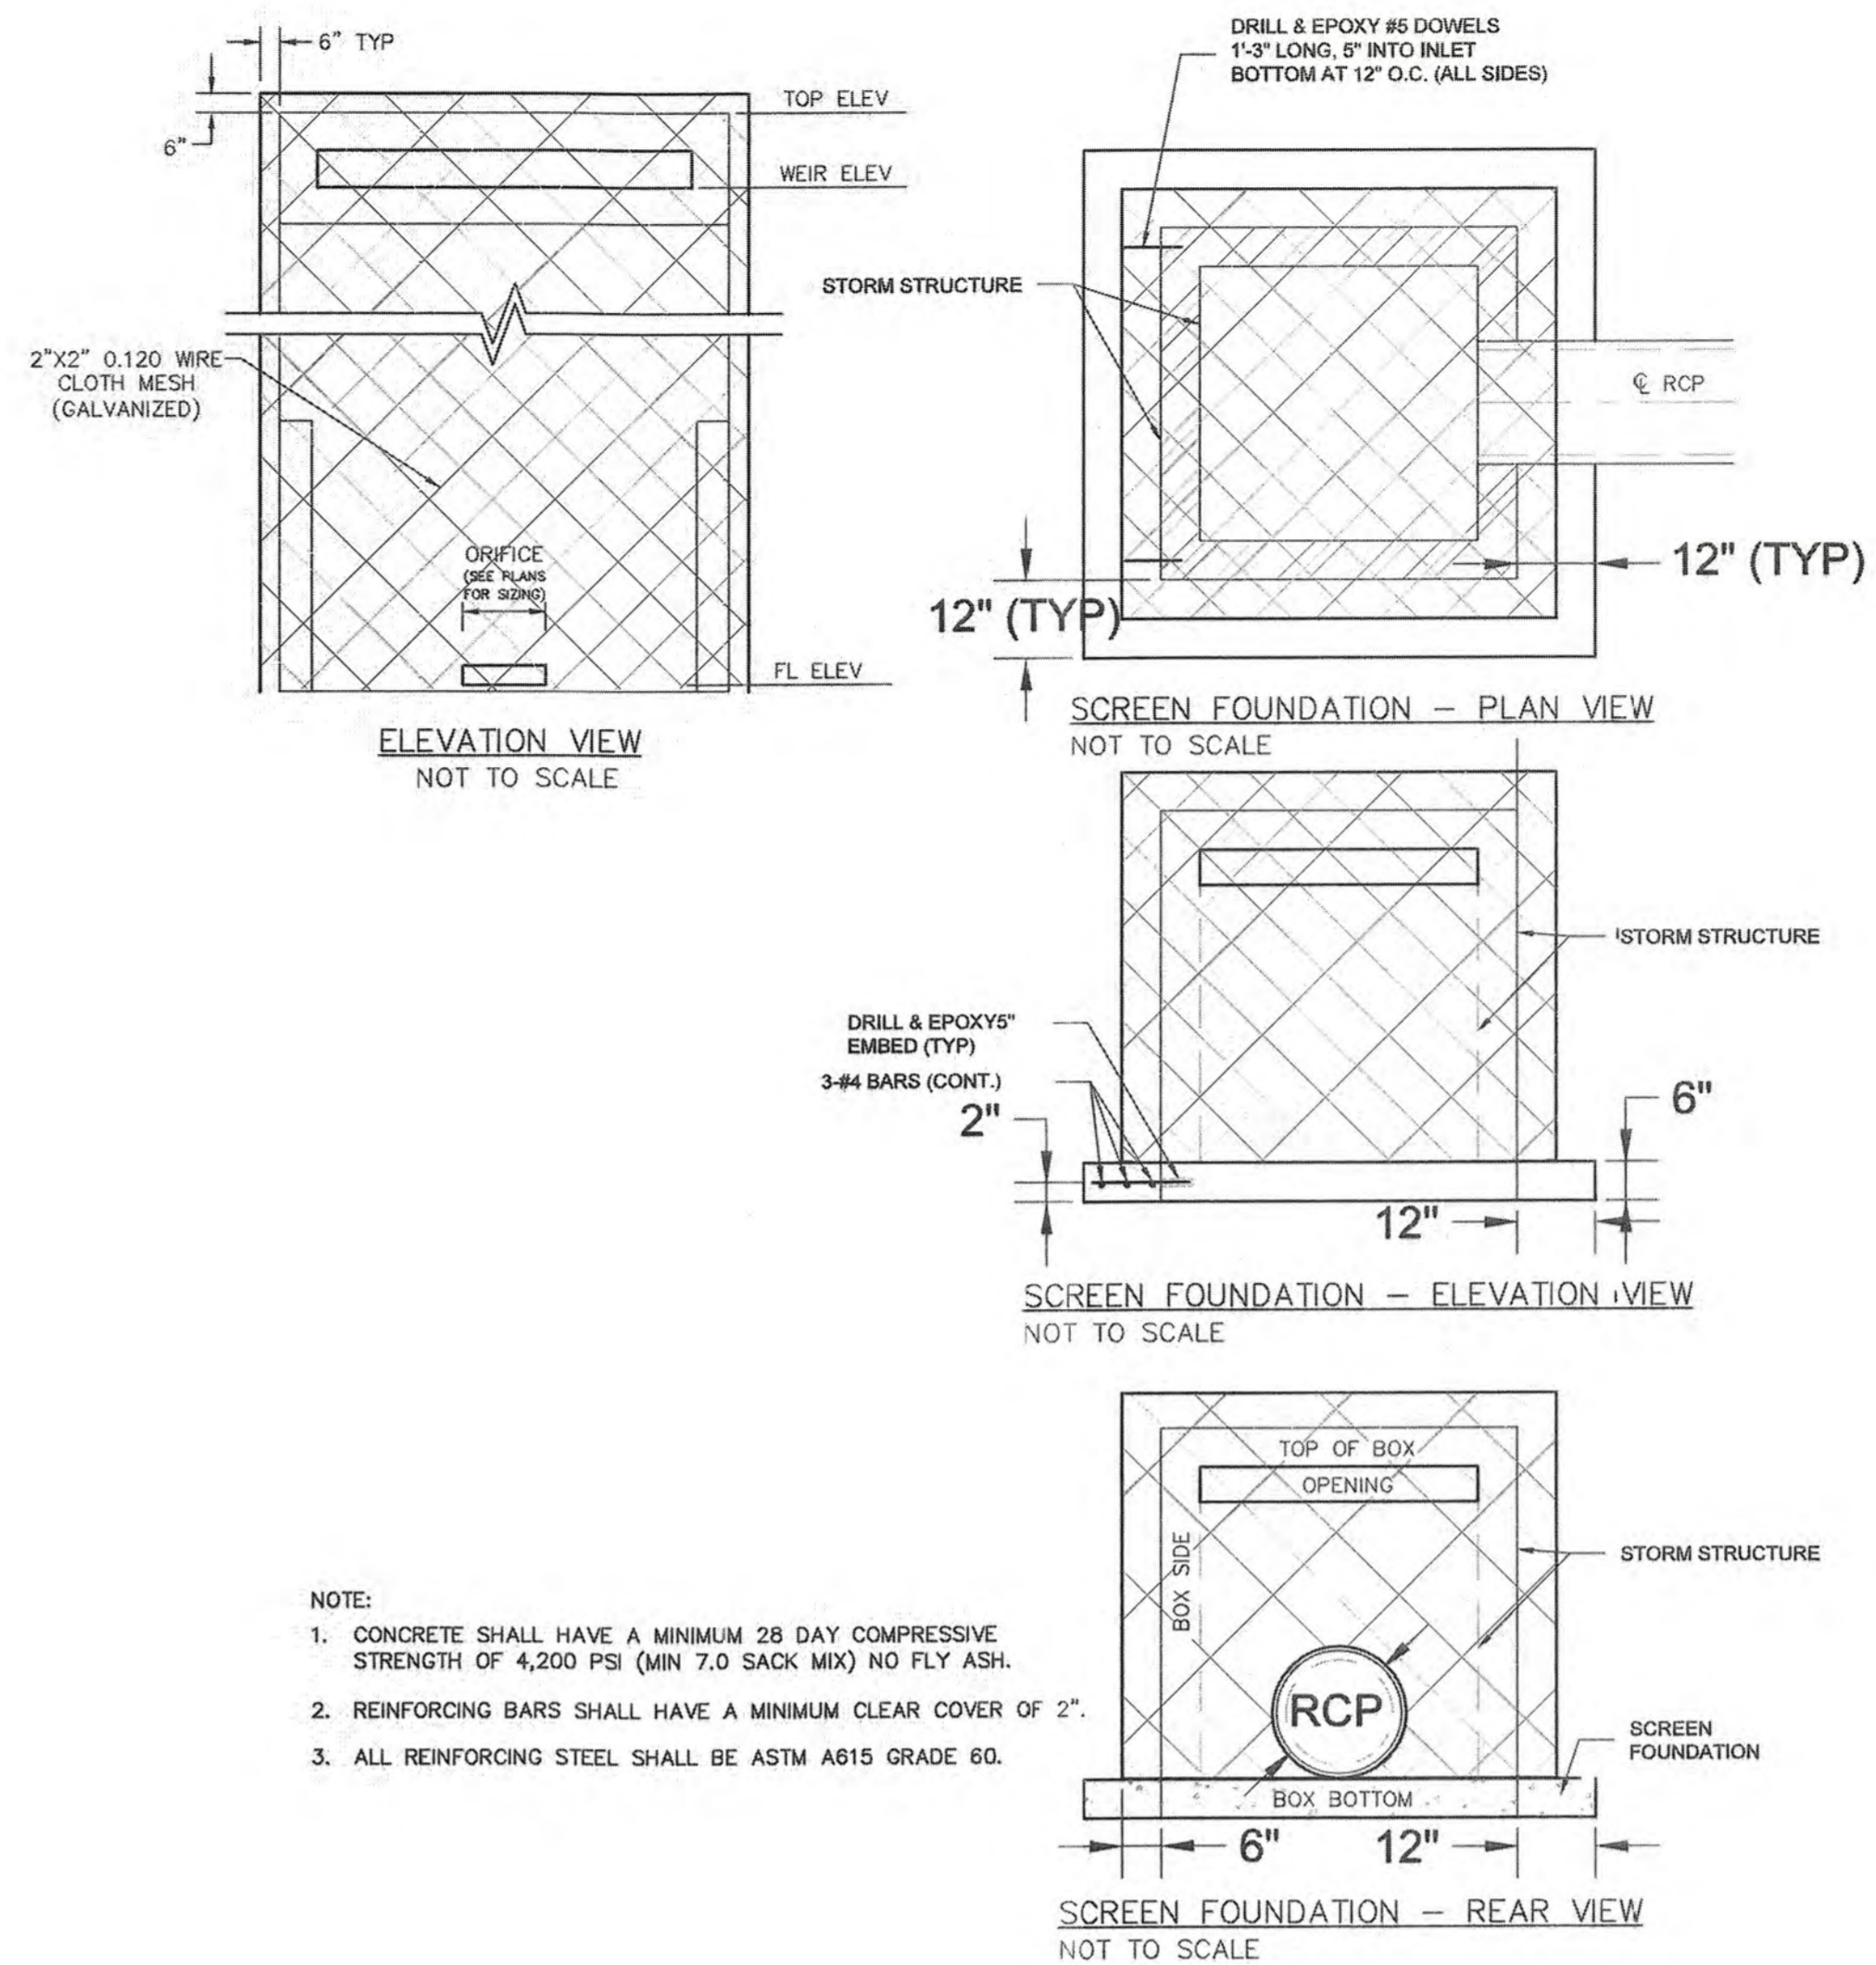

RECORD DRAWINGS  
To the best of our knowledge Engineering Concepts & Design, L.P., hereby states that this plan is As-Built. This information provided is based on surveying at the site and information provided by the contractor.  
Ryan C. King  
1/27/2021  
DATE

RELEASED FOR CONSTRUCTION  
ALL RESPONSIBILITY FOR ADEQUACY OF DESIGN REMAINS WITH THE DESIGN ENGINEER. THE CITY OF ROCKWALL, IN REVIEWING AND RELEASING PLANS FOR CONSTRUCTION, ASSUMES NO RESPONSIBILITY FOR ADEQUACY OR ACCURACY OF DESIGN.  
CITY  
DATE

CAUTION! EXISTING UTILITIES  
CONTRACTOR SHOULD CALL 1-800-895-TEST PRIOR TO BEGINNING ANY CONSTRUCTION ACTIVITIES FOR EXISTING UTILITY LOCATIONS. EXISTING UTILITIES AND UNDERGROUND FACILITIES INDICATED ON THESE PLANS HAVE BEEN LOCATED FROM REFERENCE INFORMATION. IT IS THE RESPONSIBILITY OF THE CONTRACTOR TO VERIFY BOTH HORIZONTALLY AND VERTICALLY THE LOCATION OF ALL EXISTING UTILITIES AND UNDERGROUND FACILITIES PRIOR TO CONSTRUCTION AND TO TAKE NECESSARY PRECAUTIONS IN ORDER TO PROTECT ALL FACILITIES ENCOUNTERED. THE CONTRACTOR SHALL PRESERVE AND PROTECT ALL EXISTING UTILITIES FROM DAMAGE DURING CONSTRUCTION.

BM-1: "PK" Nail on the south side of Clem Road, approximately 2275' west of the centerline intersection of Clem Road and FM 3549  
Elev.: 559.07'

BM-2: "PK" Nail in Clem Road, approximately 175' west of the centerline intersection of Clem Road and FM 3549  
Elev.: 584.83'

ENGINEERINGCONCEPTS  
& DESIGN, L.P.

ENGINEERING / PROJECT MANAGEMENT /  
CONSTRUCTION SERVICES - FIRM REG. #F-001145  
201 WINDCO CIR, STE 200, WYLIE, TX 75098  
972-941-8400 FAX: 972-941-8401 WWW.ECDLP.COM

REVISIONS:	
DRAWN: MJH	DATE: 6/1/2020
CHECKED: RCK	
PROJECT NO.: 08838	
DWG FILE NAME: 08838 DT.DWG	

THIS DOCUMENT IS RELEASED FOR THE PURPOSE OF CONSTRUCTION. THE SEAL APPEARING ON THIS DOCUMENT WAS AUTHORIZED BY RYAN C. KING, P.E. 123635



DETENTION POND DETAILS  
NORTHGATE  
CITY OF ROCKWALL, ROCKWALL COUNTY, TEXAS

SHEET  
40  
OF  
40

GENERAL CONSTRUCTION NOTES

1. ALL CONSTRUCTION, TESTING, AND MATERIALS SHALL BE IN ACCORDANCE WITH THE CITY'S CURRENT STANDARDS, DETAILS, AND SPECIFICATIONS.
2. PRIOR TO ANY CONSTRUCTION ACTIVITIES, THE CONTRACTOR SHALL BE FAMILIAR WITH THE PLANS INCLUDING ALL NOTES, STANDARD SPECIFICATIONS, DETAILS, AND CITY STANDARDS.
3. TESTING AND INSPECTION OF MATERIALS SHALL BE PERFORMED BY A COMMERCIAL TESTING LABORATORY APPROVED BY THE CLIENT AND CITY. CONTRACTOR SHALL FURNISH MATERIALS OR SPECIMENS FOR TESTING, AND SHALL FURNISH SUITABLE EVIDENCE THAT THE MATERIALS PROPOSED TO BE INCORPORATED INTO THE WORK ARE IN ACCORDANCE WITH THE SPECIFICATIONS.
4. CONTRACTOR SHALL NOTIFY THE CITY AT LEAST 48 HOURS PRIOR TO BEGINNING ANY CONSTRUCTION.
5. CONTRACTOR IS RESPONSIBLE FOR OBTAINING ALL NECESSARY PERMITS AND APPROVALS PRIOR TO BEGINNING ANY CONSTRUCTION.
6. CONTRACTOR MUST KEEP AVAILABLE ON-SITE AT ALL TIMES APPROVED CONSTRUCTION PLANS AND COPIES OF ANY REQUIRED PERMITS ALONG WITH THE CURRENT VERSIONS OF THE FOLLOWING REFERENCES: CITY OF ROCKWALL ENGINEERING STANDARDS, NCTCOG SPECIFICATIONS, TXDOT SPECIFICATIONS, TXDOT STANDARD DRAWINGS.
7. ALL SHOP DRAWINGS, WORKING DRAWINGS OR OTHER DOCUMENTS WHICH REQUIRE REVIEW BY THE CITY SHALL BE SUBMITTED BY THE CONTRACTOR SUFFICIENTLY IN ADVANCE OF SCHEDULED CONSTRUCTION TO ALLOW NO LESS THAN 14 CALENDAR DAYS FOR REVIEW AND RESPONSE BY THE CITY.
8. THE CONTRACTOR SHALL BE RESPONSIBLE FOR ALL REQUIRED CONSTRUCTION SURVEYING AND STAKING AND SHALL NOTIFY THE CLIENT AND CITY OF ANY DISCREPANCIES PRIOR TO PROCEEDING WITH ANY WORK.
9. CONTRACTOR SHALL BE RESPONSIBLE FOR PROTECTING ALL SURVEY MARKERS INCLUDING IRON RODS, PROPERTY CORNERS, OR SURVEY MONUMENTS WITHIN THE LIMITS OF CONSTRUCTION AND OUTSIDE ROW DURING CONSTRUCTION. ANY SURVEY MARKERS DISTURBED DURING CONSTRUCTION SHALL BE REPLACED BY THE CONTRACTOR AT NO COST TO THE CLIENT.
10. CONTRACTOR IS RESPONSIBLE FOR KEEPING STREETS AND DRIVEWAYS ADJACENT TO THE PROJECT FREE OF MUD AND DEBRIS AT ALL TIMES. CONTRACTOR SHALL CLEAN UP AND REMOVE ALL LOOSE MATERIAL RESULTING FROM CONSTRUCTION OPERATIONS. THE CONTRACTOR SHALL TAKE ALL AVAILABLE PRECAUTIONS TO CONTROL DUST.
11. THE EXISTENCE AND LOCATIONS OF THE PUBLIC AND FRANCHISE UTILITIES SHOWN ON THE DRAWINGS WERE OBTAINED FROM AVAILABLE RECORDS AND ARE APPROXIMATE. THE CONTRACTOR SHALL DETERMINE THE DEPTH AND LOCATION OF EXISTING UNDERGROUND UTILITIES PRIOR TO EXCAVATING, TRENCHING, OR DRILLING AND SHALL BE REQUIRED TO TAKE ANY PRECAUTIONARY MEASURES TO PROTECT ALL LINES SHOWN AND / OR ANY OTHER UNDERGROUND UTILITIES NOT OF RECORD OR NOT SHOWN ON THE PLANS. THE CONTRACTOR SHALL BE RESPONSIBLE FOR CONTACTING ALL PUBLIC AGENCIES AND FRANCHISE UTILITIES 48 HOURS PRIOR TO CONSTRUCTION. (DIG-TESS 1-800-344-8377) THE CONTRACTOR MAY BE REQUIRED EXPOSE THESE FACILITIES AT NO COST TO THE CITY. THE CONTRACTOR WILL BE RESPONSIBLE FOR DAMAGES TO UTILITIES IF THE DAMAGE IS CAUSED BY NEGLIGENCE OR FAILURE TO HAVE LOCATES PERFORMED.
12. THE CONTRACTOR SHALL BE RESPONSIBLE FOR ANY DAMAGE TO EXISTING FACILITIES OR ADJACENT PROPERTIES DURING CONSTRUCTION. ANY REMOVAL OR DAMAGE TO EXISTING FACILITIES SHALL BE REPLACED OR REPAIRED TO EQUAL OR BETTER CONDITION BY THE CONTRACTOR.
13. CONTRACTOR SHALL BE RESPONSIBLE FOR FURNISHING AND INSTALLING ALL TEMPORARY AND PERMANENT TRAFFIC CONTROL IN ACCORDANCE WITH THE MINIMUM REQUIREMENTS OF THE LATEST REVISION OF THE TEXAS MANUAL ON UNIFORM TRAFFIC CONTROL DEVICES (TMUTCD) AND TXDOT BARRICADE AND CONSTRUCTION STANDARDS.
14. CONTRACTOR SHALL NOT IMPEDE TRAFFIC ON EXISTING STREETS, DRIVEWAYS, ALLEYS, OR FIRE LANES OPEN TO THE PUBLIC. IN THE EVENT THE CONSTRUCTION WORK REQUIRES THE CLOSURE OF AN EXISTING STREET, ALLEY, OR FIRE LANE, THE CONTRACTOR SHALL REQUEST THE ROAD CLOSURE THROUGH THE CITY TRAFFIC DIVISION.
15. CONTRACTOR SHALL NOT STORE MATERIALS, EQUIPMENT OR OTHER CONSTRUCTION ITEMS ON ADJACENT PROPERTIES OR RIGHT-OF-WAY WITHOUT THE PRIOR WRITTEN CONSENT OF THE PROPERTY OWNER AND THE CITY.
16. TEMPORARY FENCING SHALL BE INSTALLED PRIOR TO THE REMOVAL OF EXISTING FENCING. TEMPORARY FENCING SHALL BE REMOVED AFTER PROPOSED FENCING IS APPROVED BY THE CITY. ALL TEMPORARY AND PROPOSED FENCING LOCATIONS SHALL BE SUBJECT TO FIELD REVISIONS AS DIRECTED BY THE CITY.
17. UNUSABLE EXCAVATED MATERIAL, OR CONSTRUCTION DEBRIS SHALL BE REMOVED AND DISPOSED OF OFF-SITE AT AN APPROVED DISPOSAL FACILITY BY THE CONTRACTOR AT HIS EXPENSE.
18. CONTRACTOR SHALL AVOID DAMAGE TO EXISTING TREES. WHEN NECESSARY, TREES AND SHRUB TRIMMING FOR CONSTRUCTION SHALL BE PERFORMED BY CERTIFIED TREE WORKER OR UNDER THE DIRECTION OF A REGISTERED LANDSCAPE ARCHITECT OR CERTIFIED ARBORIST.
19. EROSION CONTROL DEVICES SHALL BE INSTALLED ON ALL PROJECTS PRIOR TO BEGINNING CONSTRUCTION AND SHALL BE MAINTAINED THROUGHOUT THE PROJECT IN A CONDITION ACCEPTABLE TO THE CITY.
20. CONTRACTOR SHALL LOCATE AND PROTECT ALL EXISTING LANDSCAPE IRRIGATION SYSTEMS. DAMAGE TO EXISTING IRRIGATION SYSTEMS AND LANDSCAPE MATERIALS SHALL BE RESTORED TO EQUAL OR BETTER CONDITION AT NO COST TO CITY OR CLIENT.
21. IT IS THE CONTRACTOR'S RESPONSIBILITY TO MAINTAIN A NEAT AND ACCURATE RECORD OF CONSTRUCTION FOR THE CLIENT'S AND CITY'S RECORDS.

CONSTRUCTION PLANS  
FOR  
SCREENING AND BUFFERING

~NORTHGATE PH. 1~  
CITY OF ROCKWALL  
ROCKWALL COUNTY, TEXAS

SUBMITTAL DATE: June 1, 2020



LOCATION MAP  
NOT TO SCALE

SHEET INDEX	
HS1	OVERALL LAYOUT PLAN
HS2-HS6	HARDSCAPE PLANS
HS7-HS10	HARDSCAPE DETAILS
EX1	LIGHTING EXHIBIT
L1-L5	LANDSCAPE PLANS
L6	LANDSCAPE DETAILS

RECORD DRAWINGS

To the best of our knowledge Engineering Concepts & Design, L.P., hereby states that this plan is As-Built. This information provided is based on surveying at the site and information provided by the contractor.

Ryan C. King  
RYAN C. KING

1/27/2021  
DATE

GENERAL LANDSCAPE NOTES:

INSPECTIONS:

1. NO EXCAVATION SHALL OCCUR IN CITY R.O.W. WITHOUT A R.O.W. PERMIT-CONTACT THE PUBLIC WORKS DEPARTMENT.
2. THE CONTRACTOR SHALL MARK ALL WATER LINES, SEWER LINES, AND TREE LOCATIONS PRIOR TO CALLING FOR ROW INSPECTION AND PERMIT.
3. THE LANDSCAPE INSTALLATION SHALL COMPLY WITH APPROVED LANDSCAPE DRAWINGS PRIOR TO FINAL ACCEPTANCE BY THE CITY AND ISSUANCE OF A CERTIFICATE OF OCCUPANCY.
4. WATER METERS, CLEANOUTS AND OTHER APPURTENANCES, SHALL BE ACCESSIBLE, ADJUSTED TO GRADE, CLEARLY MARKED WITH FLAGGING AND COMPLIANT WITH PUBLIC WORKS DEPARTMENT STANDARDS PRIOR TO CALLING FOR FINAL LANDSCAPE AND ROW INSPECTIONS.

LANDSCAPE STANDARDS:

1. PLANTINGS AND LANDSCAPE ELEMENTS SHALL COMPLY WITH THE CITY'S ENGINEERING DESIGN STANDARDS, PUBLIC R.O.W. VISIBILITY REQUIREMENTS.
2. UNLESS OTHERWISE SPECIFIED, TREES SHALL BE PLANTED NO LESS THAN 4' FROM CURBS, SIDEWALKS, UTILITY LINES, SCREENING WALLS AND OTHER STRUCTURES. THE CITY HAS FINAL APPROVAL FOR ALL TREE PLACEMENTS.
3. A MINIMUM THREE FEET (3') RADIUS AROUND A FIRE HYDRANT MUST REMAIN CLEAR OF LANDSCAPE PURSUANT TO THE FIRE CODE.
4. STREET TREES, WHERE REQUIRED, SHALL BE (10') MINIMUM FROM THE EDGE OF A STORM SEWER CURB INLET BOX AND THE EDGE OF THE ROOT BALL SHALL BE (4') MINIMUM FROM THE WATER METER.
5. THE AMERICAN STANDARD FOR NURSERY STOCK (ANSI Z60.1-2014) SPECIFICATIONS SHALL GOVERN PLANT QUALIFICATIONS, GRADES, AND STANDARDS.
6. TREE PLANTING SHALL COMPLY WITH DETAILS HEREIN AND THE INTERNATIONAL SOCIETY OF ARBORICULTURE (ISA) STANDARDS.
7. A 2-3" LAYER OF MULCH SHALL BE PROVIDED AROUND THE BASE OF THE PLANTED TREE. THE MULCH SHALL BE PULLED BACK 4" FROM THE TRUNK OF THE TREE.
8. TREE PITS SHALL BE TESTED FOR WATER PERCOLATION. IF WATER DOES NOT DRAIN OUT OF TREE PIT WITHIN 24-HOURS, THE TREE SHALL BE MOVED OR DRAINAGE SHALL BE PROVIDED.
9. ALL BEDS TO HAVE 3" OF COMPOSTED SOIL, LIVING EARTH TECHNOLOGY, OR APPROVED EQUAL FILLED AND TURNED TO A DEPTH OF 8" MINIMUM.
10. ALL PLANT BEDS SHALL BE TOP-DRESSED WITH A MINIMUM OF 3 INCHES OF HARDWOOD MULCH.
11. NATIVE SITE TOPSOIL IS TO BE PROTECTED FROM EROSION OR STOCKPILED. NATIVE SITE TOPSOIL SHALL BE LABORATORY TESTED BY AND ACCREDITED LABORATORY AND AMENDED PER SAID LABORATORY'S RECOMMENDATIONS.

IRRIGATION STANDARDS:

1. ANY CHANGES TO THESE APPROVED IRRIGATION DRAWINGS SHALL BE AUTHORIZED BY THE CITY.
2. CONTACT DEVELOPMENT SERVICES FOR AN IRRIGATION PERMIT PRIOR TO INSTALLING THE IRRIGATION SYSTEM.
3. IRRIGATION OVER-SPRAY ON STREETS AND WALKS IS PROHIBITED.
4. MAINLINES, VALVES, OR CONTROL WIRES SHALL NOT BE LOCATED IN THE CITY'S ROW.
5. ET IRRIGATION CONTROLLERS SHALL BE PROGRAMMED AND ADJUSTED TO NOT EXCEED THE LANDSCAPE WATER ALLOWANCE (LWA) PRIOR TO APPROVAL OF LANDSCAPE INSTALLATION.
6. VALVES SHALL BE LOCATED A MINIMUM OF (3') AWAY FROM STORM SEWERS, AND SANITARY SEWER LINES AND 5 FEET FROM CITY FIRE HYDRANTS AND WATER VALVES.
7. THE BORE DEPTH UNDER STREETS, DRIVE AISLES, AND FIRE LANES SHALL PROVIDE (2') OF CLEARANCE (MINIMUM).
8. IRRIGATION HEADS THAT RUN PARALLEL AND NEAR PUBLIC WATER AND SANITARY SEWER LINES; SHALL BE FED FROM STUBBED LATERALS OR BULL-BEADS. A MINIMUM FIVE FOOT (5') SEPARATION IS REQUIRED BETWEEN IRRIGATION MAIN LINES AND LATERALS THAT RUN PARALLEL TO PUBLIC WATER AND SANITARY SEWER LINES.
9. NO VALVES, BACKFLOW PREVENTION ASSEMBLIES, QUICK COUPLERS ETC. SHALL BE LOCATED CLOSER THAN 10' FROM THE CURB AT STREET OR DRIVE INTERSECTION.

MAINTENANCE STANDARDS:

1. THE OWNER SHALL BE RESPONSIBLE FOR THE ESTABLISHMENT, MAINTENANCE, AND VIGOR OF PLANT MATERIAL IN ACCORDANCE WITH THE DESIGN INTENT AND AS APPROPRIATE FOR THE SEASON OF THE YEAR.
2. LANDSCAPE AND OPEN AREAS SHALL BE FREE OF TRASH, LITTER AND WEEDS.
3. NO PLANT MATERIAL SHALL BE ALLOWED TO ENCROACH ON R.O.W., SIDEWALKS OR EASEMENTS TO THE EXTENT THAT VISION OR ROUTE OF TRAVEL FOR VEHICULAR, PEDESTRIAN, OR BICYCLE TRAFFIC IS IMPEDED.
4. TREE MAINTENANCE SHALL BE IN ACCORDANCE WITH THE STANDARDS OF THE INTERNATIONAL SOCIETY OF ARBORICULTURE.
5. TREE STAKING MATERIALS, IF USED, SHALL BE REMOVED AFTER (1) GROWING SEASON, NO MORE THAN (1) YEAR AFTER INSTALLATION (STEEL TREE STAKES, WIRES, AND HOSES ARE PROHIBITED).

TREE PROTECTION NOTES:

1. CONTACT DEVELOPMENT SERVICES FOR A TREE REMOVAL PERMIT PRIOR TO REMOVAL OR TRANSPLANTING OF ANY TREES.
2. ALL TREES WHICH ARE TO REMAIN ON SITE SHALL BE PROTECTED WITH A (4") TALL BRIGHTLY COLORED PLASTIC FENCE, OR SILT FENCE, PLACED AT THE DRIP LINE OF THE TREES.
3. PRIOR TO THE PRE-CONSTRUCTION MEETING OR OBTAINING A GRADING PERMIT, ALL TREE MARKINGS AND PROTECTIVE FENCING SHALL BE INSTALLED BY THE OWNER AND BE INSPECTED BY DEVELOPMENT SERVICES.
4. NO EQUIPMENT SHALL BE CLEANED, OR HARMFUL LIQUIDS DEPOSITED WITHIN THE LIMITS OF THE ROOT ZONE OF TREES WHICH REMAIN ON SITE.
5. NO SIGNS, WIRES, OR OTHER ATTACHMENTS SHALL BE ATTACHED TO ANY TREE TO REMAIN ON SITE.
6. VEHICULAR AND CONSTRUCTION EQUIPMENT SHALL NOT PARK OR DRIVE WITHIN THE LIMITS OF THE DRIP LINE.
7. GRADE CHANGES IN EXCESS OF 3 INCHES (CUT OR FILL) SHALL NOT BE ALLOWED WITHIN A ROOT ZONE, UNLESS ADEQUATE TREE PRESERVATION METHODS ARE APPROVED BY THE CITY.
8. NO TRENCHING SHALL BE ALLOWED WITHIN THE DRIP-LINE OF A TREE, UNLESS APPROVED BY THE CITY.
9. ALL REMOVED TREES SHALL BE CHIPPED AND USED FOR MULCH ON SITE OR HAULED OFF-SITE.
10. ALL TREE MAINTENANCE TECHNIQUES SHALL BE IN CONFORMANCE WITH INDUSTRY IDENTIFIED STANDARDS. IMPROPER OR MALICIOUS PRUNING TECHNIQUES ARE STRICTLY PROHIBITED.

OWNER / DEVELOPER:


NORTHGATE ROCKWALL, LP  
1189 WATERS EDGE DRIVE  
ROCKWALL, TEXAS 75087  
PH. (512) 965-6280  
CONTACT: RYAN JOYCE

CIVIL ENGINEER:


ENGINEERING CONCEPTS & DESIGN, LP  
201 WINDCO CIRCLE  
SUITE 200  
WYLIE, TEXAS 75098  
PH. (972) 941-8400  
CONTACT: RYAN KING

LANDSCAPE ARCHITECT:

CODY JOHNSON STUDIO, LLC  
9720 COIT ROAD SUITE 220-333  
PLANO, TEXAS 75025  
PH. (903) 570-0162  
CONTACT: CODY JOHNSON, RLA, ASLA, LI

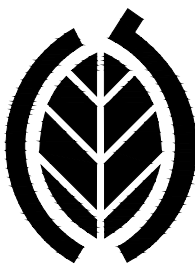

CODY JOHNSON  
s · t · u · d · i · o

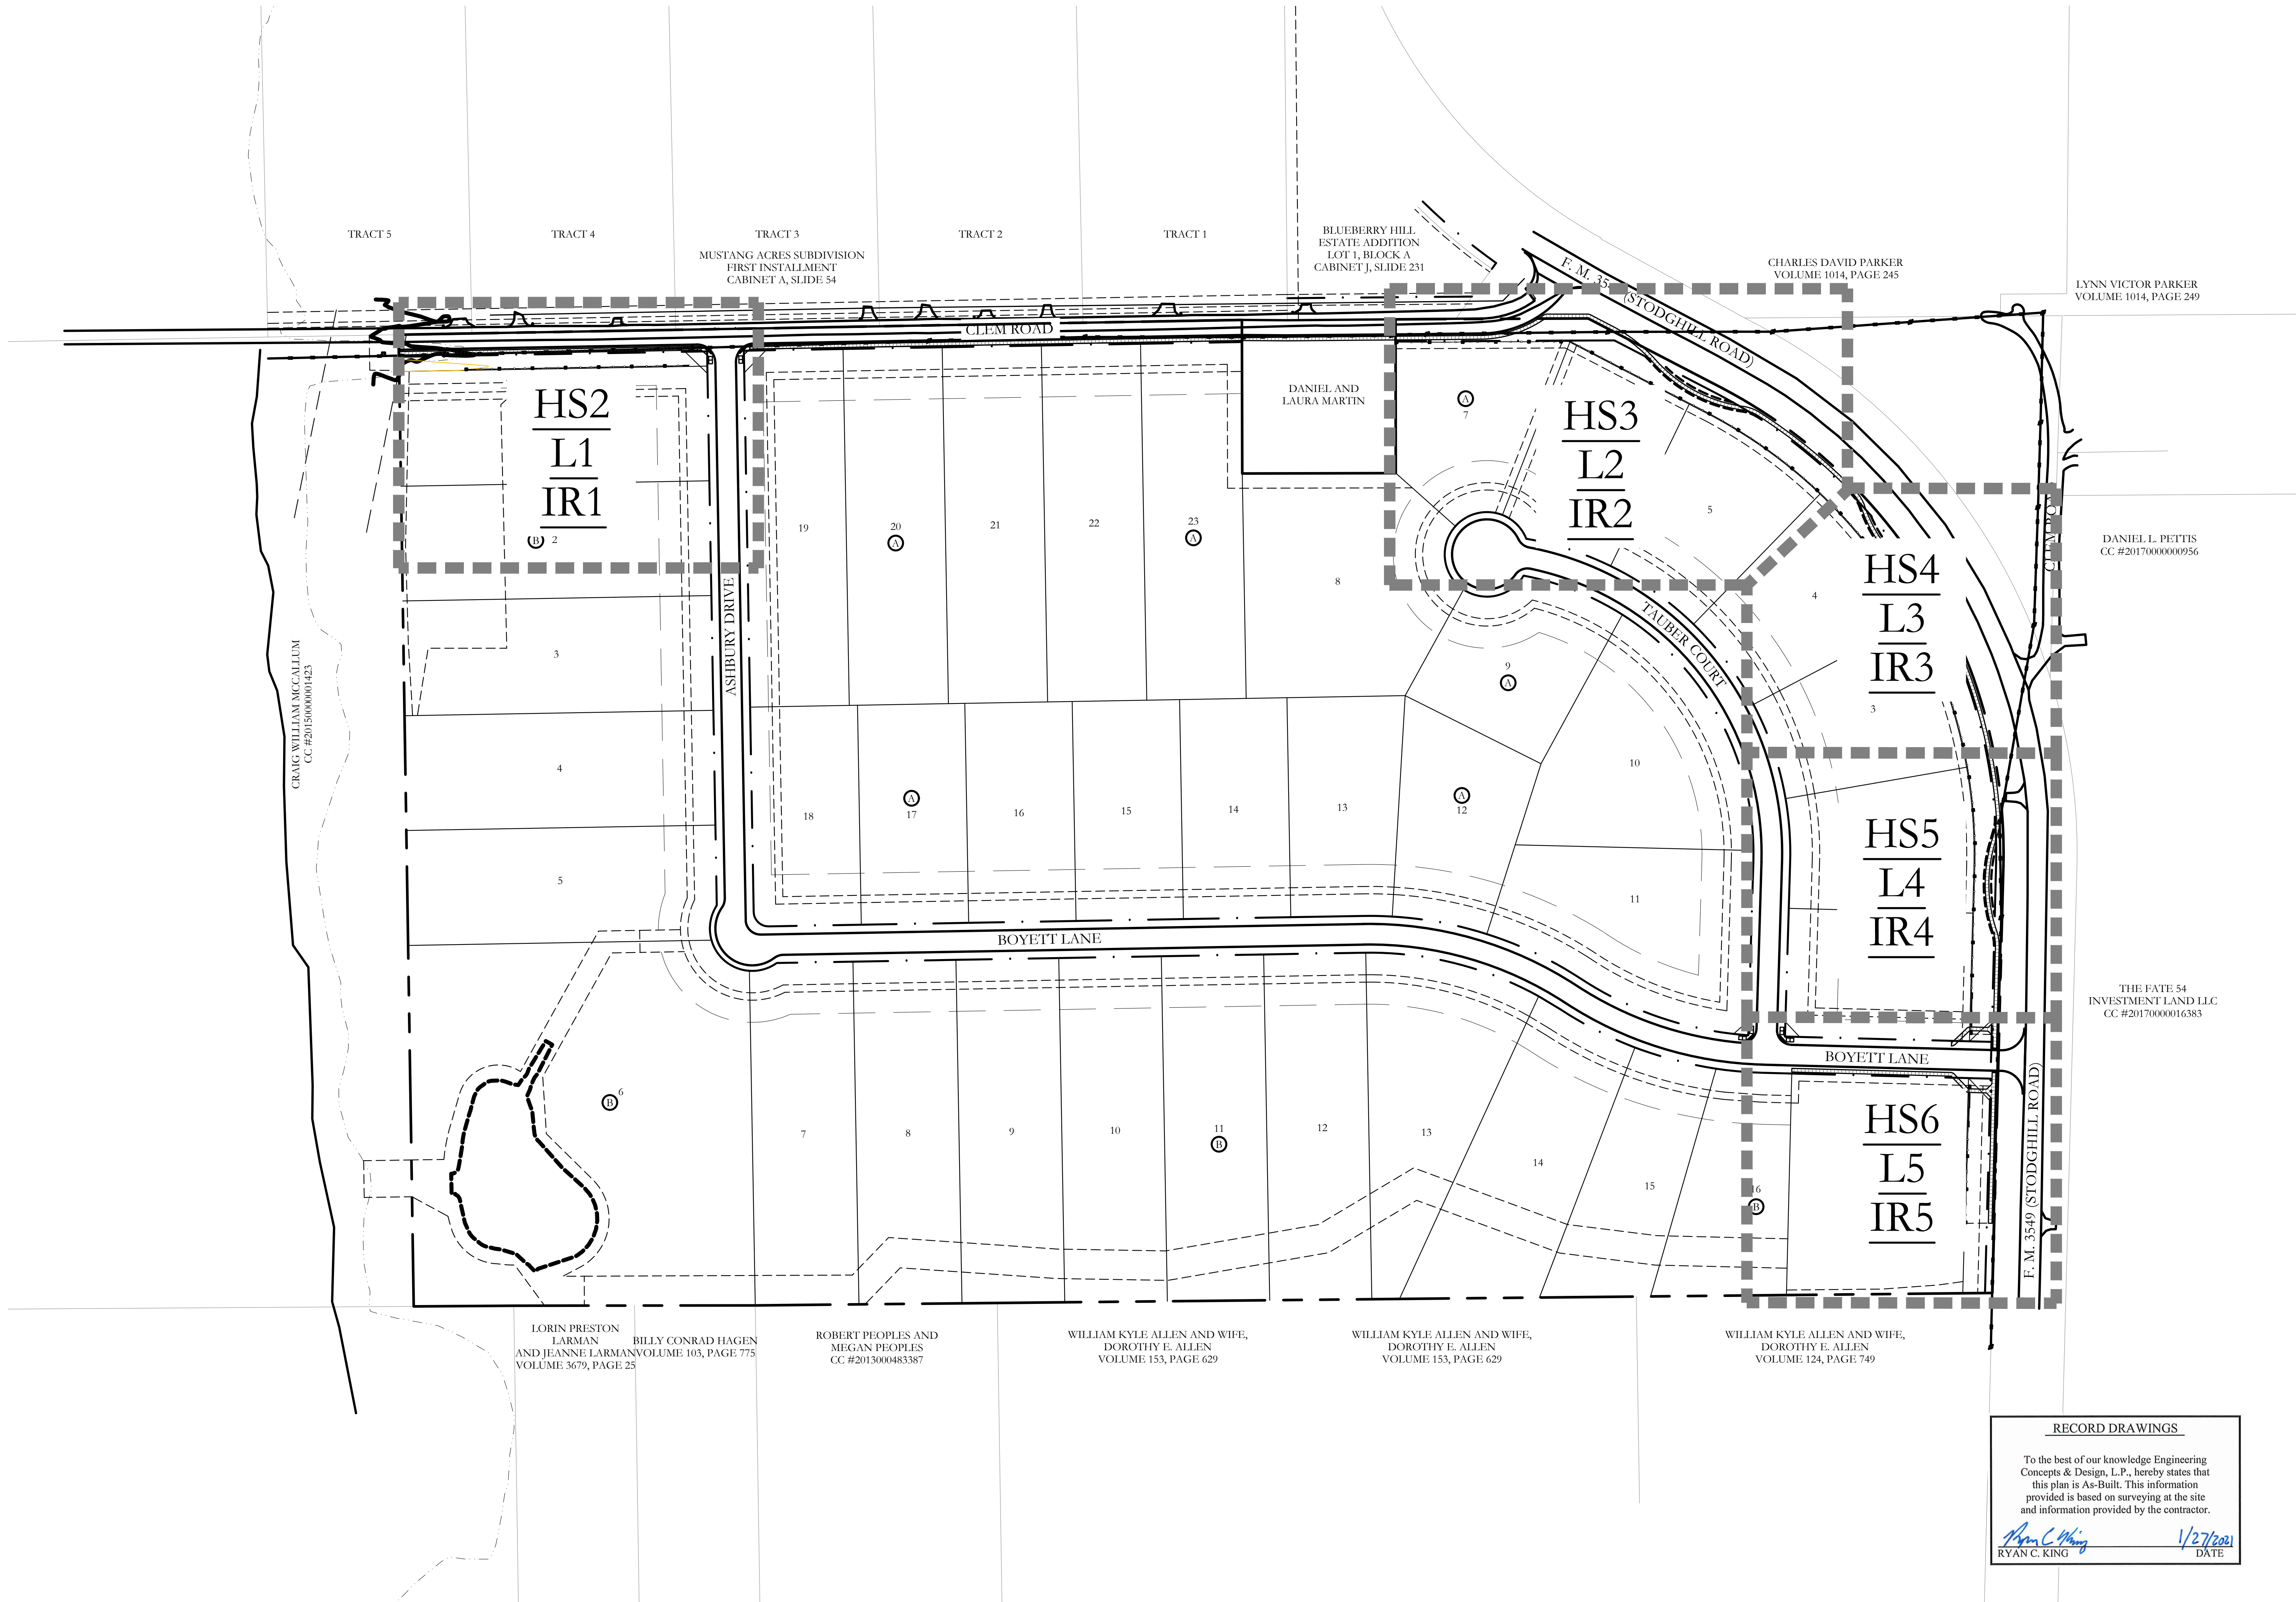


RECORD DRAWINGS

To the best of our knowledge Engineering Concepts & Design, L.P., hereby states that this plan is As-Built. This information provided is based on surveying at the site and information provided by the contractor.

*Ryan C. King*  
RYAN C. KING

1/27/2021  
DATE

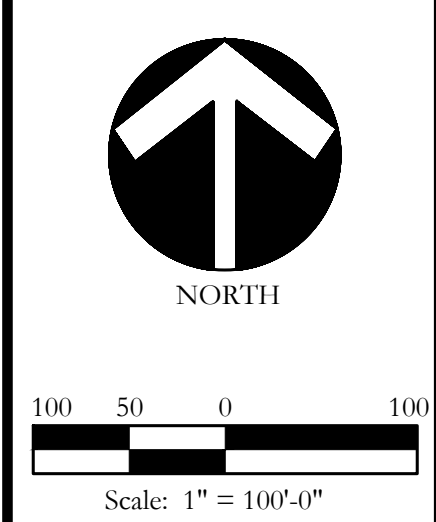

Bar is one inch on original drawing. If not one inch on this sheet, adjust scale as necessary.


One Inch

SCREENING AND BUFFERING		
Overall Layout Plan		
Northgate Phase 1		
City of Rockwall, Tarrant County, Texas		

▲	
CJS PROJECT NO.	
MJP001	
SHEET NO.	
HS1 of 10	





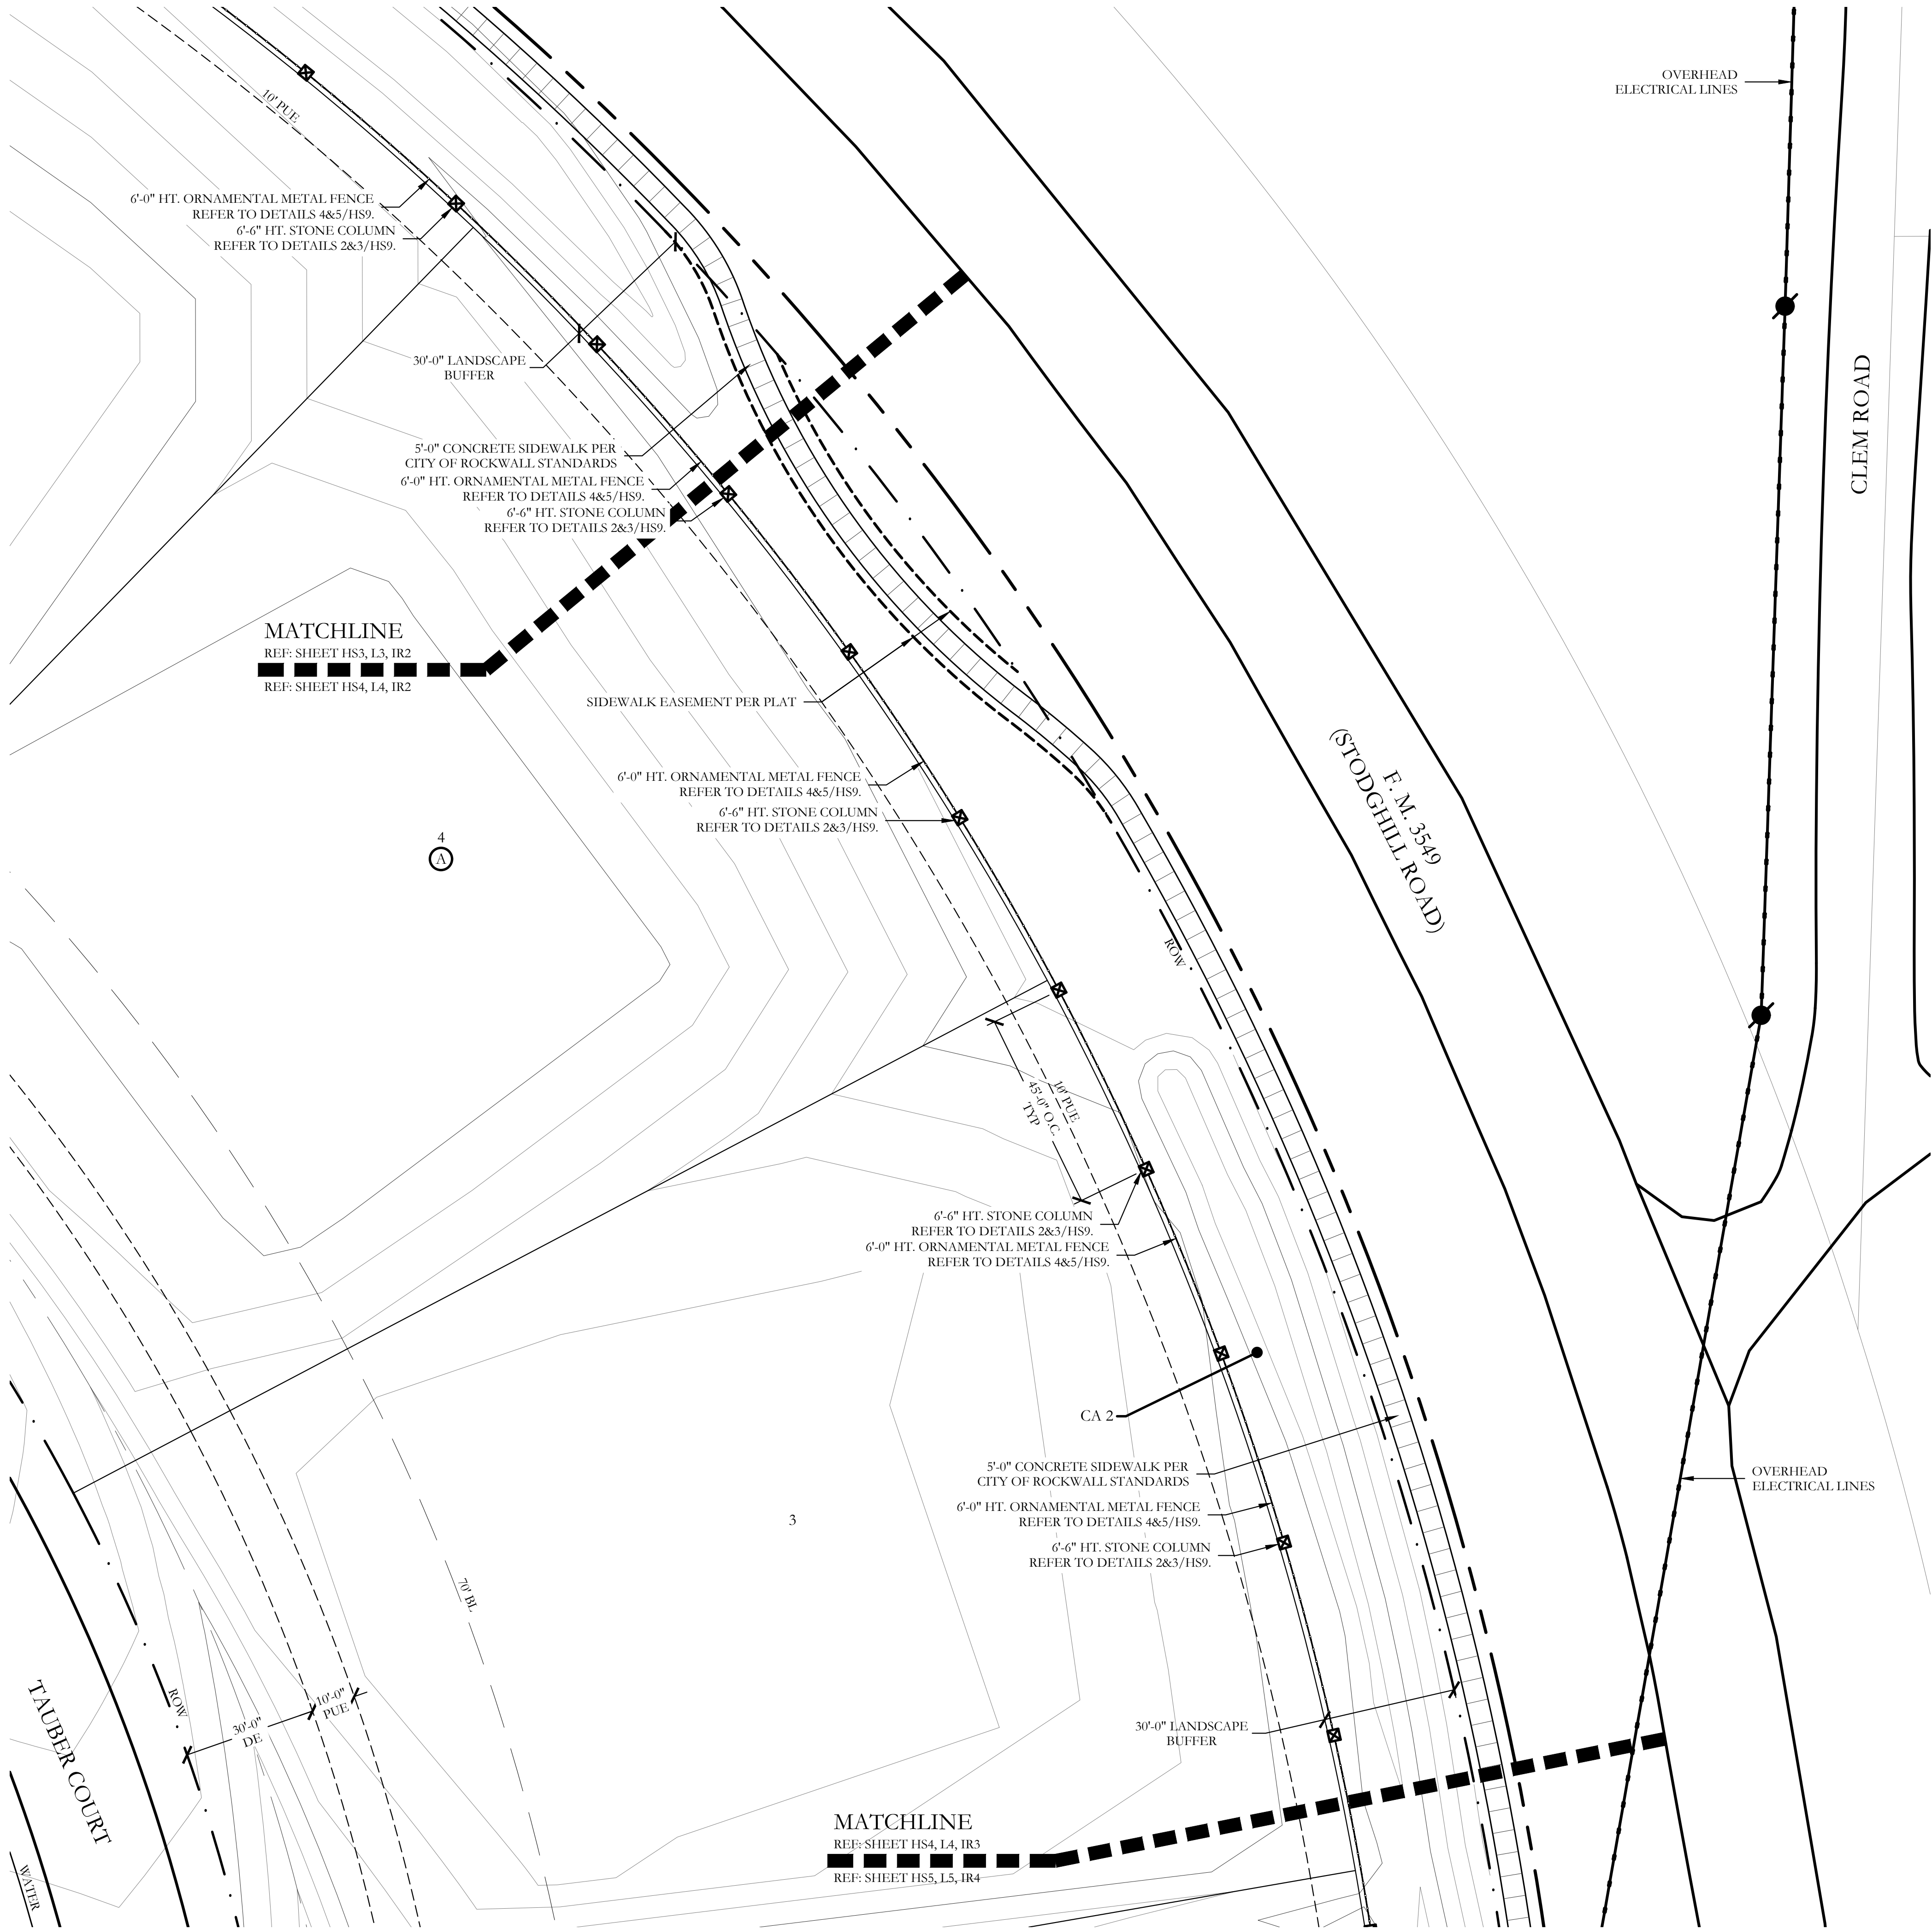

### HARDSCAPE LEGEND

	4'-0" HT. STONE WALL. REFER TO DETAILS 2&3/HS8.
	6'-6" HT. STONE COLUMN. REFER TO DETAILS 2&3/HS9.
	OVERHEAD CEDAR BEAMS. REFER TO DETAILS 1/HS7 & 1&2/HS8.
	9'-0" HT. STONE SIGN PANEL. REFER TO DETAILS 1&3/HS7 & 1/HS8.
	6'-0" HT. STONE MINOR WALL WALL. REFER TO DETAILS 1/HS7 & 1/HS9.
	8'-0" HT. STONE LOGO PANEL. REFER TO DETAILS 1&2/HS7.
	6'-0" HT. ORNAMENTAL METAL FENCE. REFER TO DETAILS 4&5/HS9.

REFER TO CIVIL PLANS FOR SIDEWALK AND BARRIER  
FREE RAMP ALIGNMENT AND DETAILS.

### RECORD DRAWINGS

To the best of our knowledge Engineering Concepts & Design, L.P., hereby states that this plan is As-Built. This information provided is based on surveying at the site and information provided by the contractor.

RYAN C. KING

1/27/2021  
DATE

# CODY JOHNSON

s · t · u · d · i · o

9720 COTT ROAD SUITE 220-333 PLANO, TEXAS 75025  
PH: (909) 570-0162  
EMAIL: CODY@CODYJOHNSONSTUDIO.COM

NORTH

Scale: 1" = 20'-0"

Bar is one inch on original drawing. If not one inch on this sheet, adjust scale as necessary.  
One Inch

SCREENING AND BUFFERING

Hardscape Plans

Northgate Phase 1

City of Rockwall, Tarrant County, Texas


CJS PROJECT NO.


MJP001

SHEET NO.

HS4 of 10






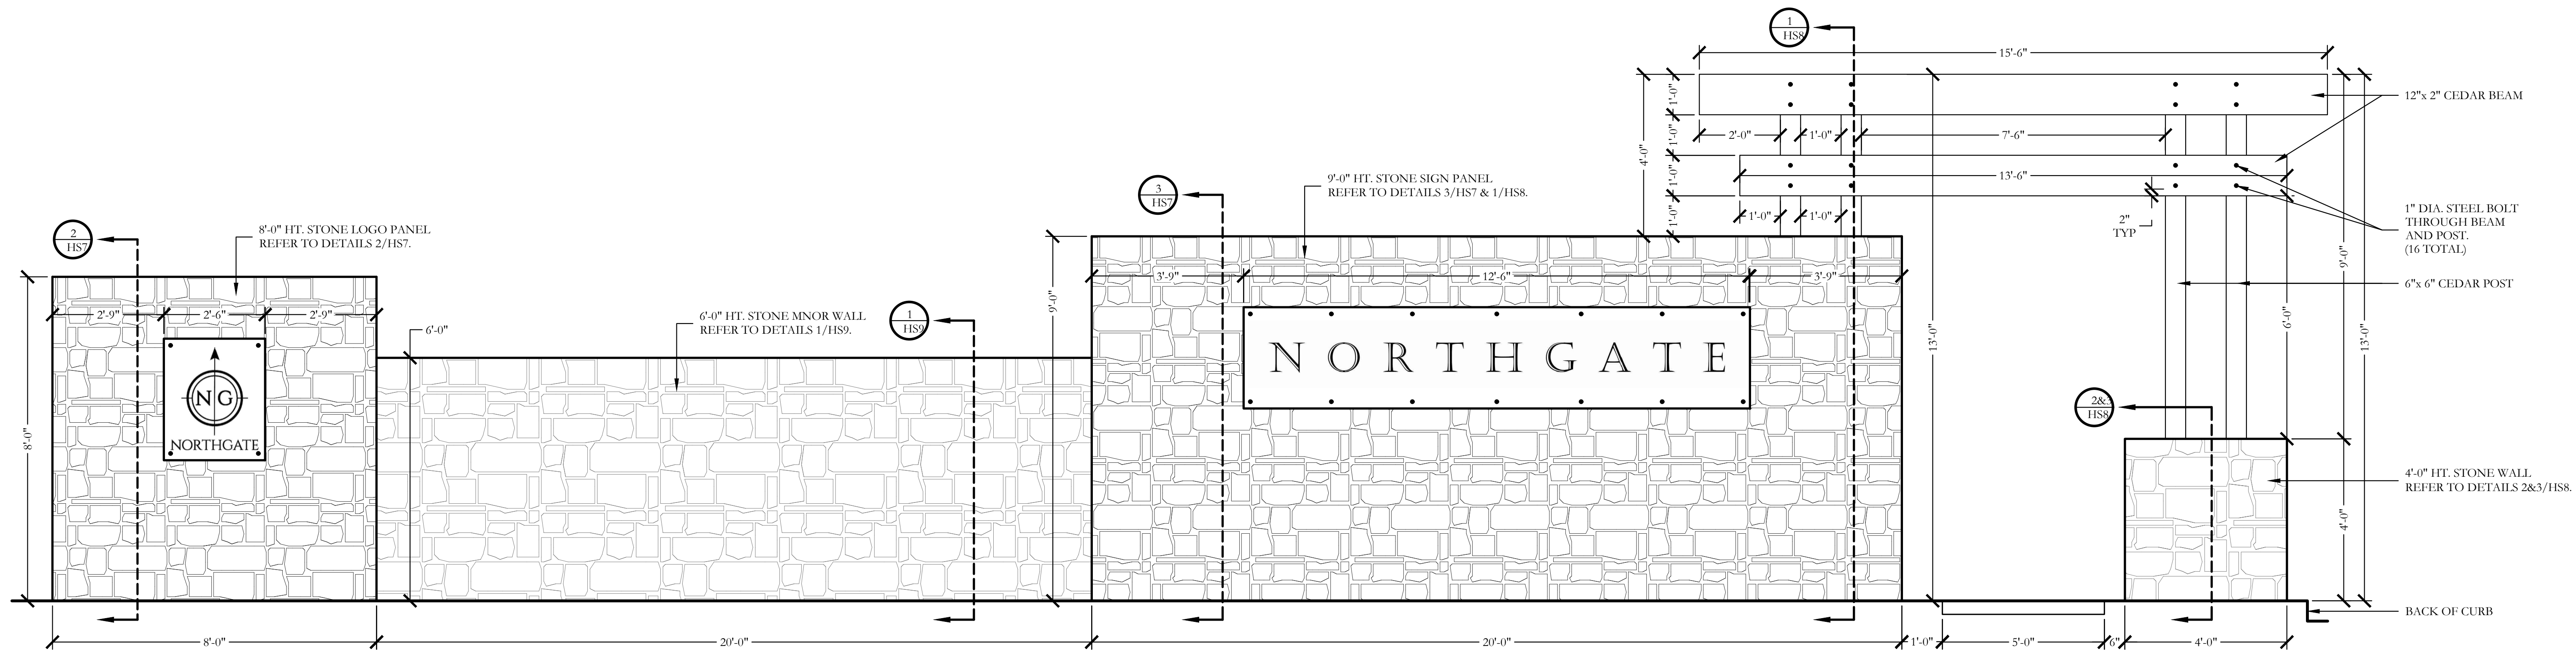


1 MAIN ENTRY SEQUENCE  
ELEVATION

SCALE: 1/2"=1'-0"

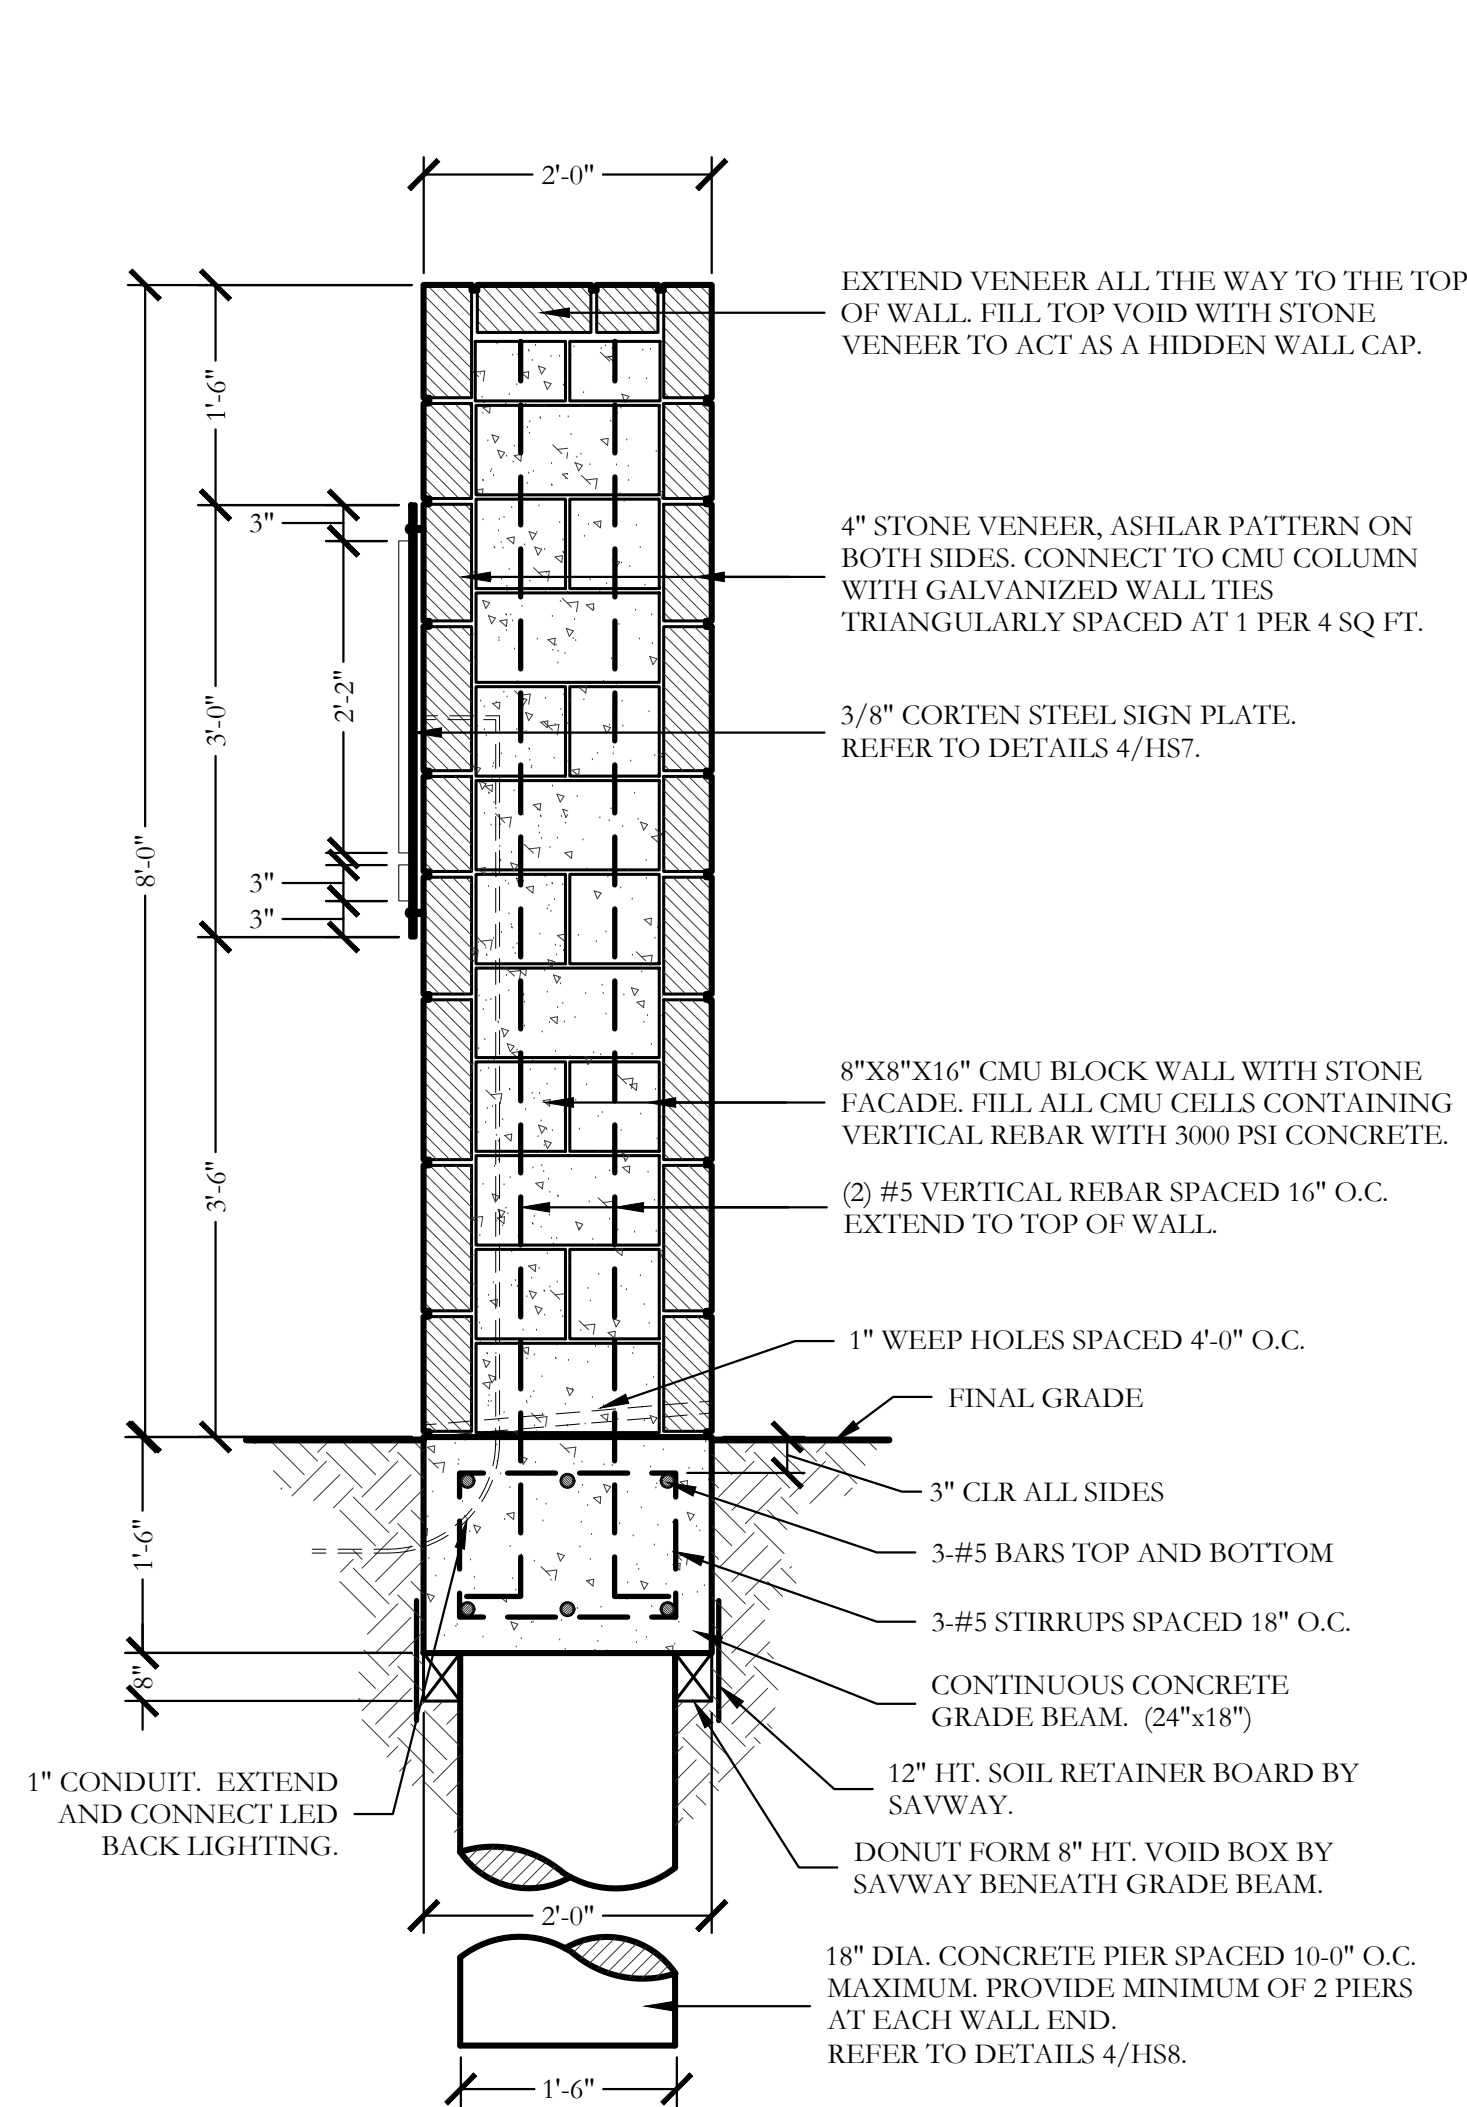

2 8'-0" HT. STONE LOGO PANEL  
SECTION


SCALE: 3/4"=1'-0"

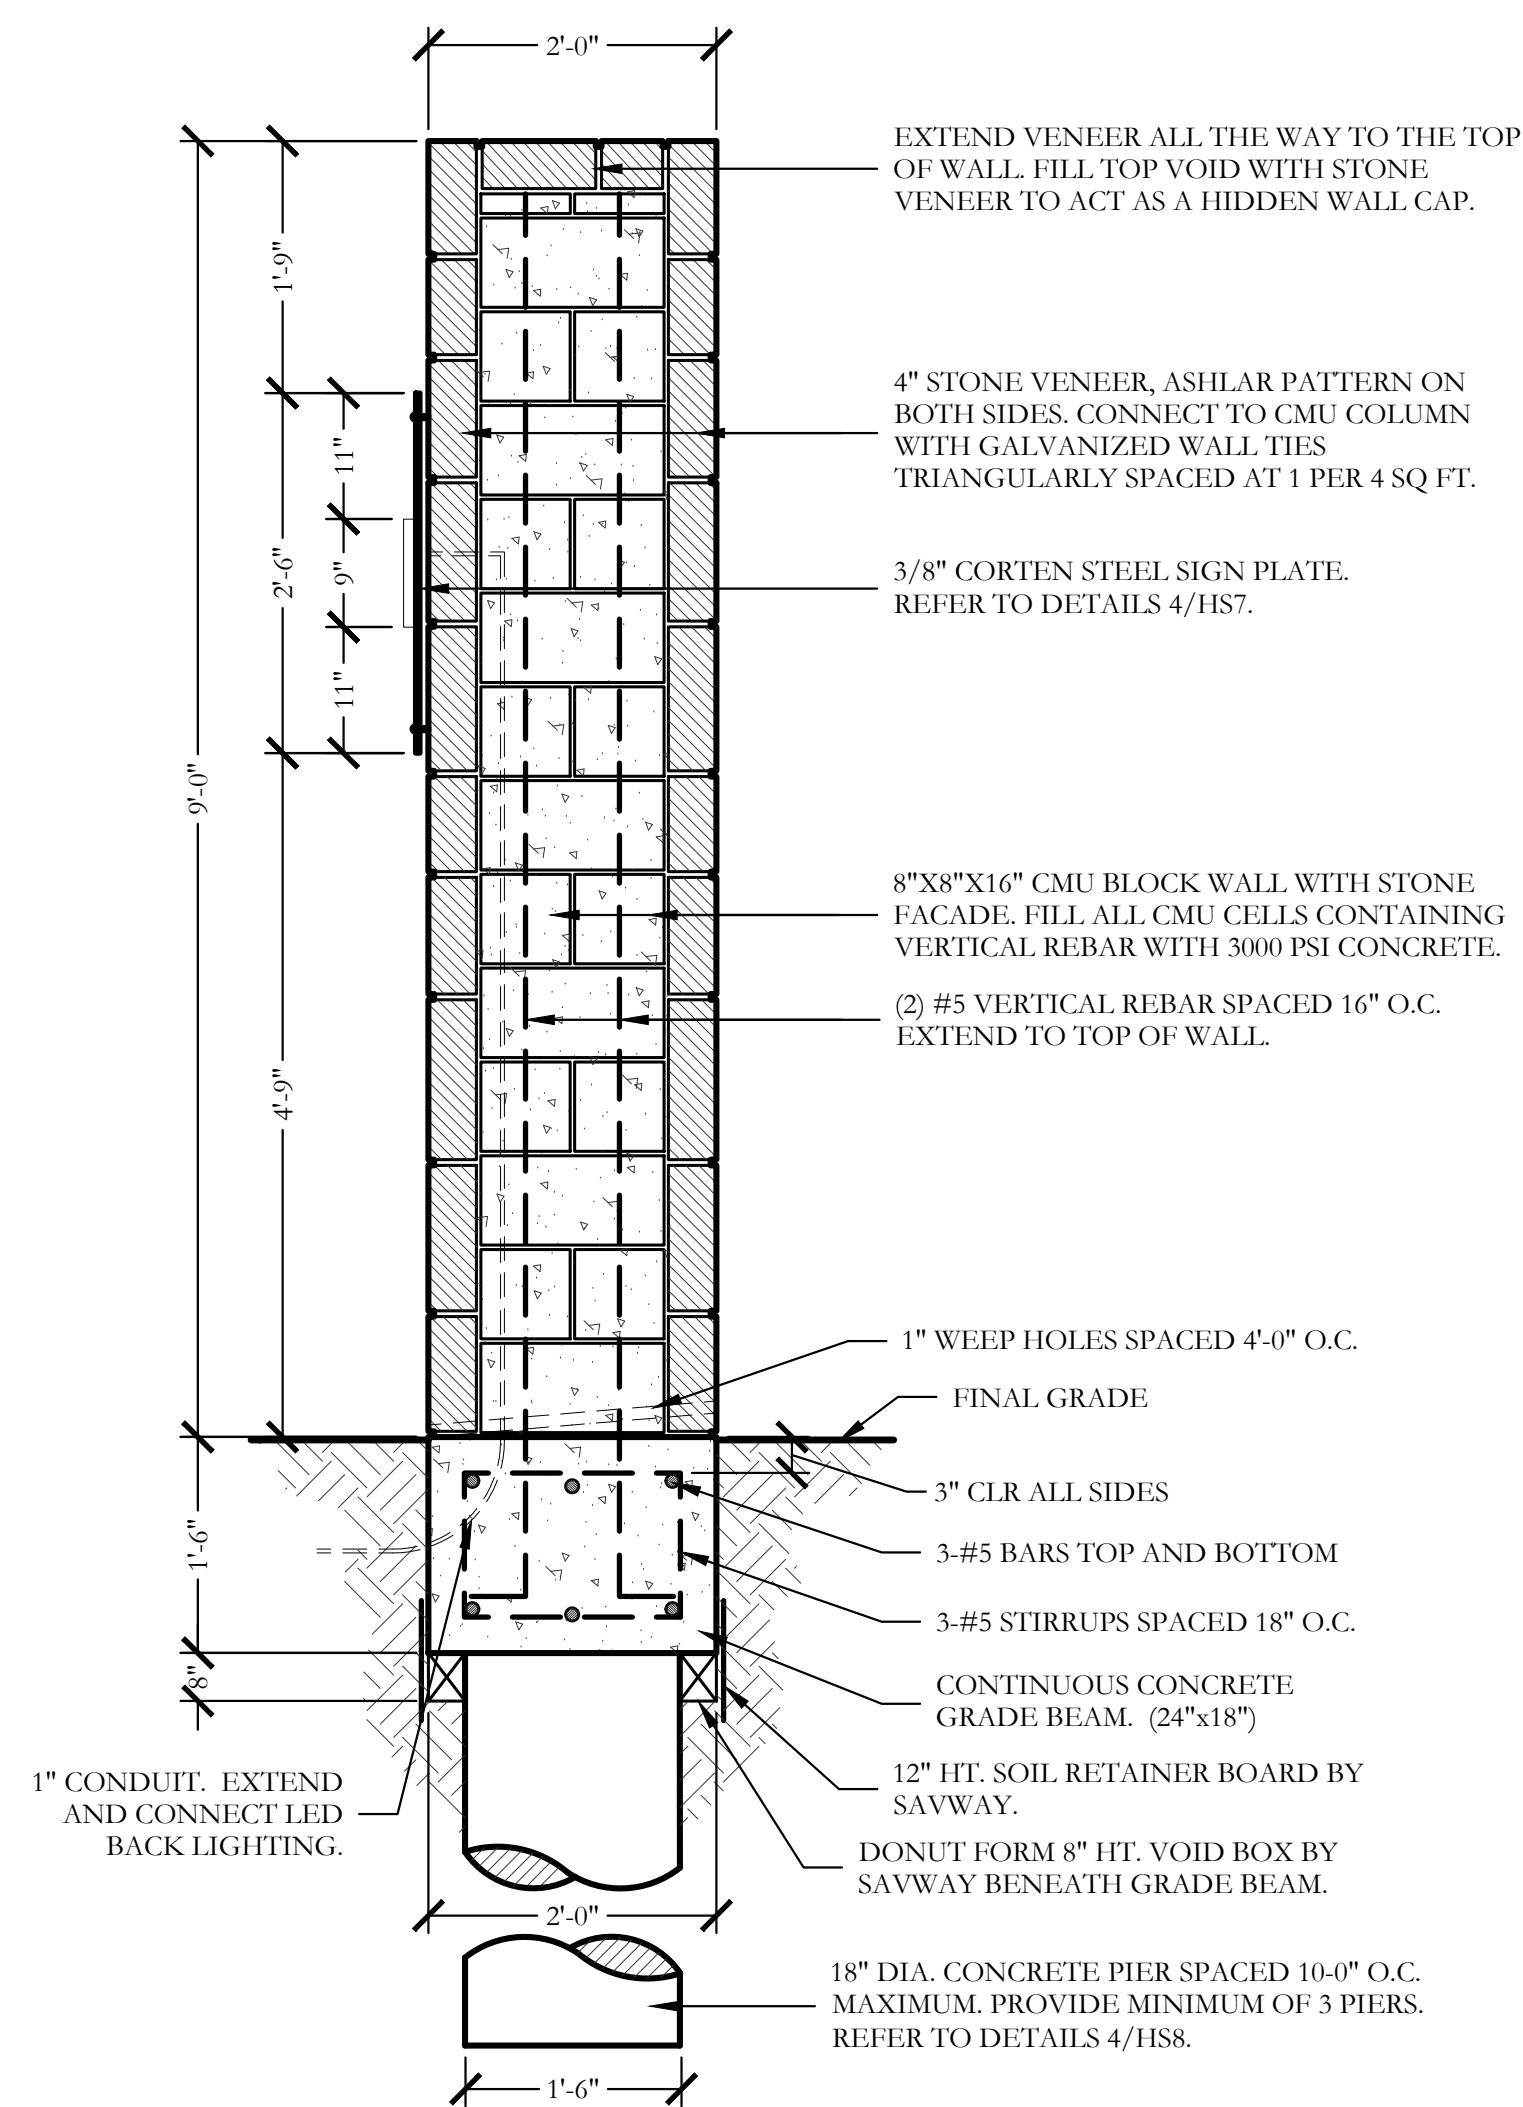


3 9'-0" HT. STONE SIGN PANEL  
SECTION

SCALE: 3/4"=1'-0"

NOTE:  
DESIGN BASED ON PRELIMINARY  
GEOTECHNICAL REPORT (ALPHA NO. G190837).  
FINAL GEOTECHNICAL REPORT NOT  
AVAILABLE AT TIME OF DESIGN. FINAL  
REPORT SHALL BE PROVIDED TO ENGINEER  
FOR REVIEW PRIOR TO CONSTRUCTION  
TAKING PLACE.

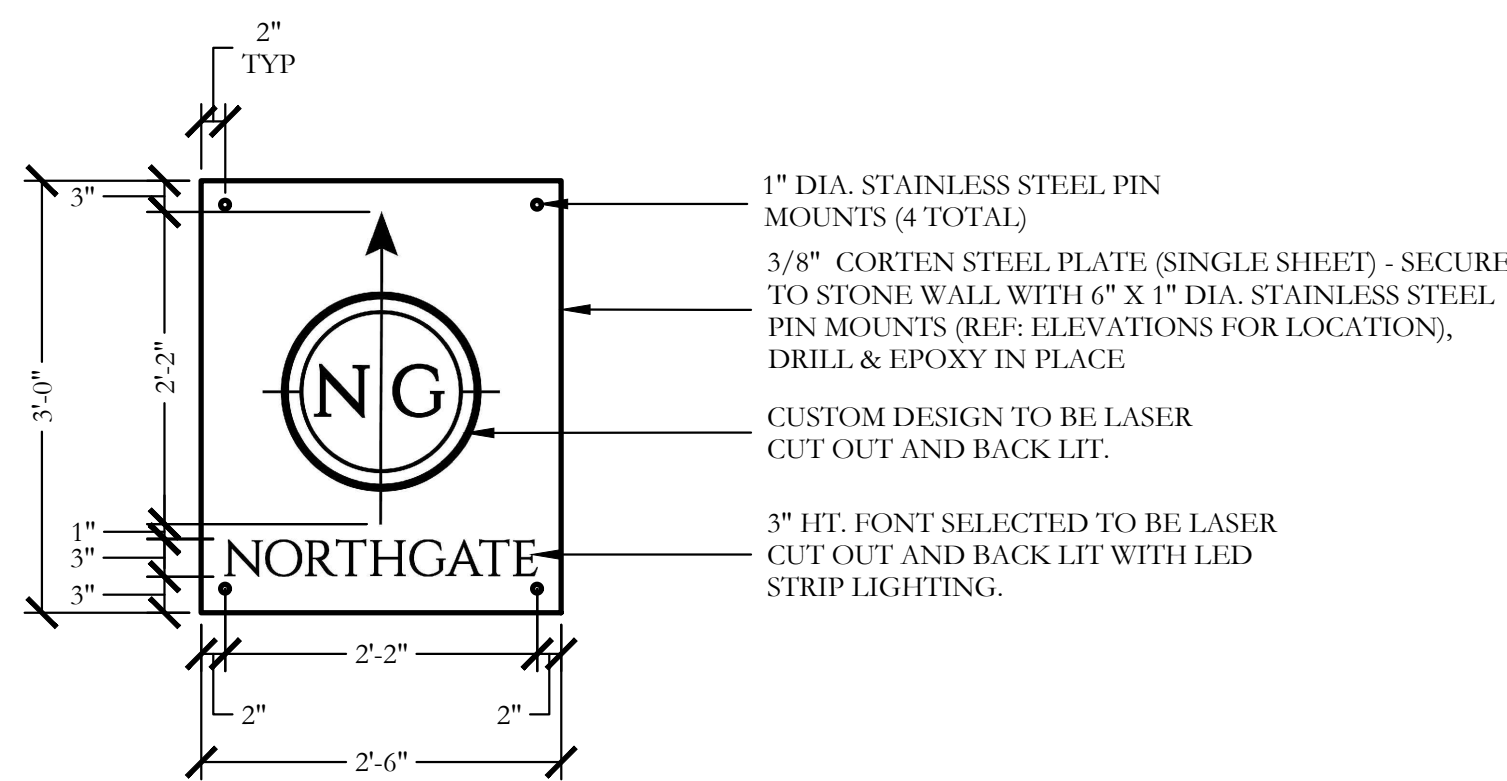

8'-0" HT STONE SIGN PANEL

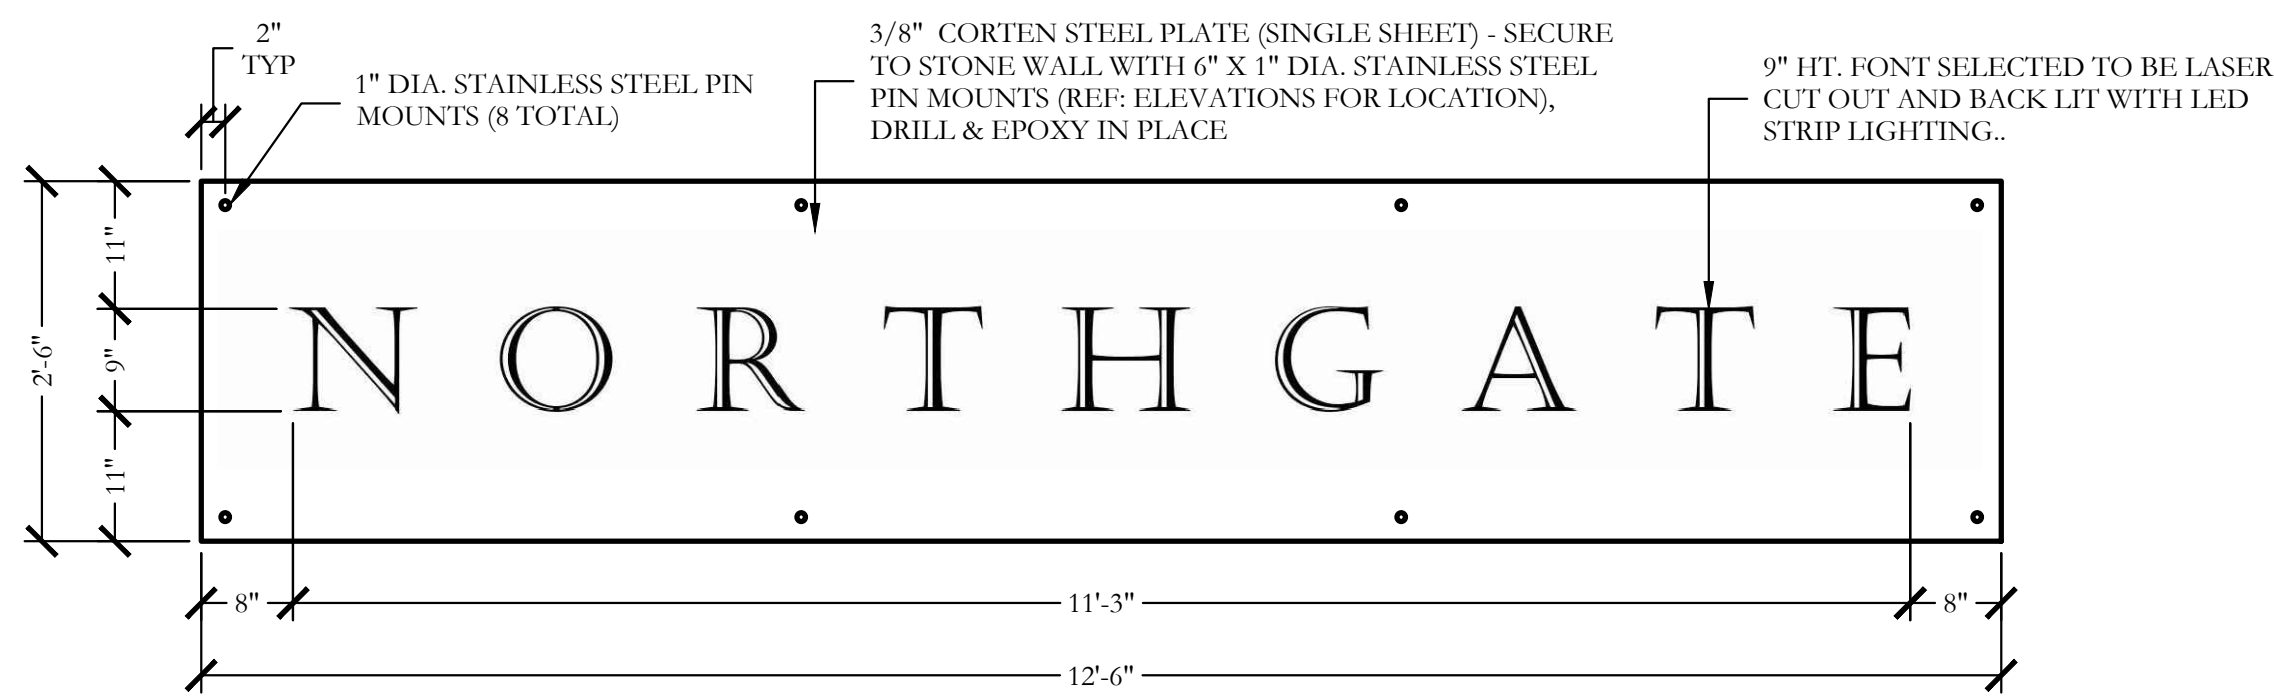

9'-0" HT STONE SIGN PANEL

4 CORTEN STEEL SIGN PANELS  
ELEVATION

SCALE: 3/4"=1'-0"

RECORD DRAWINGS

To the best of our knowledge Engineering Concepts & Design, L.P., hereby states that this plan is As-Built. This information provided is based on surveying at the site and information provided by the contractor.

*Ryan C. King*  
RYAN C. KING  
1/27/2021  
DATE

CODY JOHNSON  
s.t.u.d.i.o

9720 COTT ROAD SUITE 220-333 PLANO, TEXAS 75025  
PH: (972) 570-0162  
EMAIL: CODY@CODYJOHNSONSTUDIO.COM

RICHARD REEVES  
91128  
LICENSED PROFESSIONAL ENGINEER  
April 1, 2020

REAVES CONSULTING  
831 ARROWHEAD DRIVE  
FROESCHER, TEXAS 75076  
972.347.3908  
RICHARD@REAVESCONSULTINGLLC.COM  
F-10826

Bar is one inch on original drawing. If not one inch on this sheet, adjust scale as necessary.

One Inch

SCREENING AND BUFFERING

Hardscape Details

Northgate Phase 1


City of Rockwall, Tarrant County, Texas

CJS PROJECT NO.  
MJP001


SHEET NO.  
HS7 of 10

WALL NOTES


- THESE DETAILS AND SPECIFICATIONS ARE APPLICABLE ONLY FOR THE SITE CONDITIONS AND HEIGHTS SHOWN HEREIN. IF CONDITIONS CHANGE FROM THOSE DESCRIBED HEREIN, THE ENGINEER SHOULD BE NOTIFIED IMMEDIATELY TO DETERMINE THE EFFECT, IF ANY, ON THE STRUCTURAL DESIGN AND LAYOUT.
- THE CONTRACTOR IS RESPONSIBLE FOR MAKING HIMSELF FAMILIAR WITH ALL UNDERGROUND UTILITIES, PIPES, AND STRUCTURES EITHER SHOWN OR NOT SHOWN ON THE PLANS. THE CONTRACTOR WILL BE RESPONSIBLE FOR ANY COST INCURRED DUE TO DAMAGE OR REPLACEMENT OF SAID UTILITIES AND STRUCTURES CAUSED BY HIS FORCES.
- ALL EARTHWORK SHALL BE PERFORMED AS INDICATED IN THE GEOTECHNICAL INVESTIGATION. PROPER EXECUTION OF EARTHWORK SHALL BE VERIFIED BY AN INDEPENDENT TESTING LAB.
- PRE-POUR OBSERVATION OF FOOTINGS, BEAMS, AND PIERS IS RECOMMENDED BY OR UNDER THE DIRECTION OF A LICENSED PROFESSIONAL ENGINEER.
- ALL CONCRETE USED IN FOOTINGS AND PIERS SHALL HAVE A MINIMUM COMPRESSIVE STRENGTH OF 3000 PSI @ 28 DAYS. CONCRETE USED IN COLUMNS SHALL HAVE A MINIMUM COMPRESSIVE STRENGTH OF 3000 PSI @ 28 DAYS.
- ALL REINFORCING SHALL BE NEW BILLET STEEL, ASTM A615, GRADE 60 EXCEPT STIRRUPS SHALL BE GRADE 40 AND SPIRALS SHALL BE ASTM A82, GRADE 60.
- CONCRETE FOR DRILLED PIERS SHALL BE POURED WITHIN 8 HOURS OF DRILLING PIER HOLES.
- REFER TO DETAILS FOR TYPE AND SIZE OF BRICK AND STONE WALL REINFORCING.
- ALL MORTAR TO BE TYPE S; MORTAR COLOR TO BE SELECTED BY OWNER. MASONRY CEMENT WILL NOT BE ALLOWED.
- ALL MORTAR JOINTS ARE TO BE 3/8" CONCAVE TOOLED JOINTS.
- STONE VENEER MATERIAL SHALL BE SELECTED BY OWNER.
- VERIFY ALL DIMENSIONS IN THE FIELD BEFORE MANUFACTURING CAST-STONE.
- THE CONTRACTOR IS RESPONSIBLE FOR ALL REQUIRED PERMITS, APPLICABLE FEES, AND CITY INSPECTIONS.
- LAYOUT OF THE PROPOSED SCREENING WALL SHALL BE PERFORMED IN THE FIELD BY THE OWNER'S REPRESENTATIVE AND THE CONTRACTOR PRIOR TO BEGINNING CONSTRUCTION.
- THE WALL STONE MATERIAL & PATTERN SHALL BE SELECTED BY OWNER AS NOTED ON LAY STONE COURSES LEVEL AND PLUMB. DO NOT EXCEED 1/4" VARIATION FROM LEVEL IN 20 FEET MAXIMUM.
- CLEAN STONEWORK PROMPTLY AFTER COMPLETION WITH FIBER BRUSHES, CLEAN WATER OR APPROVED CLEANING AGENT. DO NOT USE WIRE BRUSHES OR ACID TYPE CLEANING AGENTS.
- THE CONTRACTOR SHALL PROVIDE A 4' X 4' MOCKUP OF THE STONE AND BRICK SCREEN WALL FOR THE OWNERS REVIEW PRIOR TO BEGINNING THE STONE WORK. THE APPROVED "MOCKUP" SHALL SERVE AS THE STANDARD FOR THE STONE WORK ON THE PROJECT.
- THE CONTRACTOR SHALL OBTAIN A PERMIT FOR ALL WALL CONSTRUCTION AND SECURE ALL NECESSARY INSPECTIONS AND CERTIFICATIONS REQUIRED.

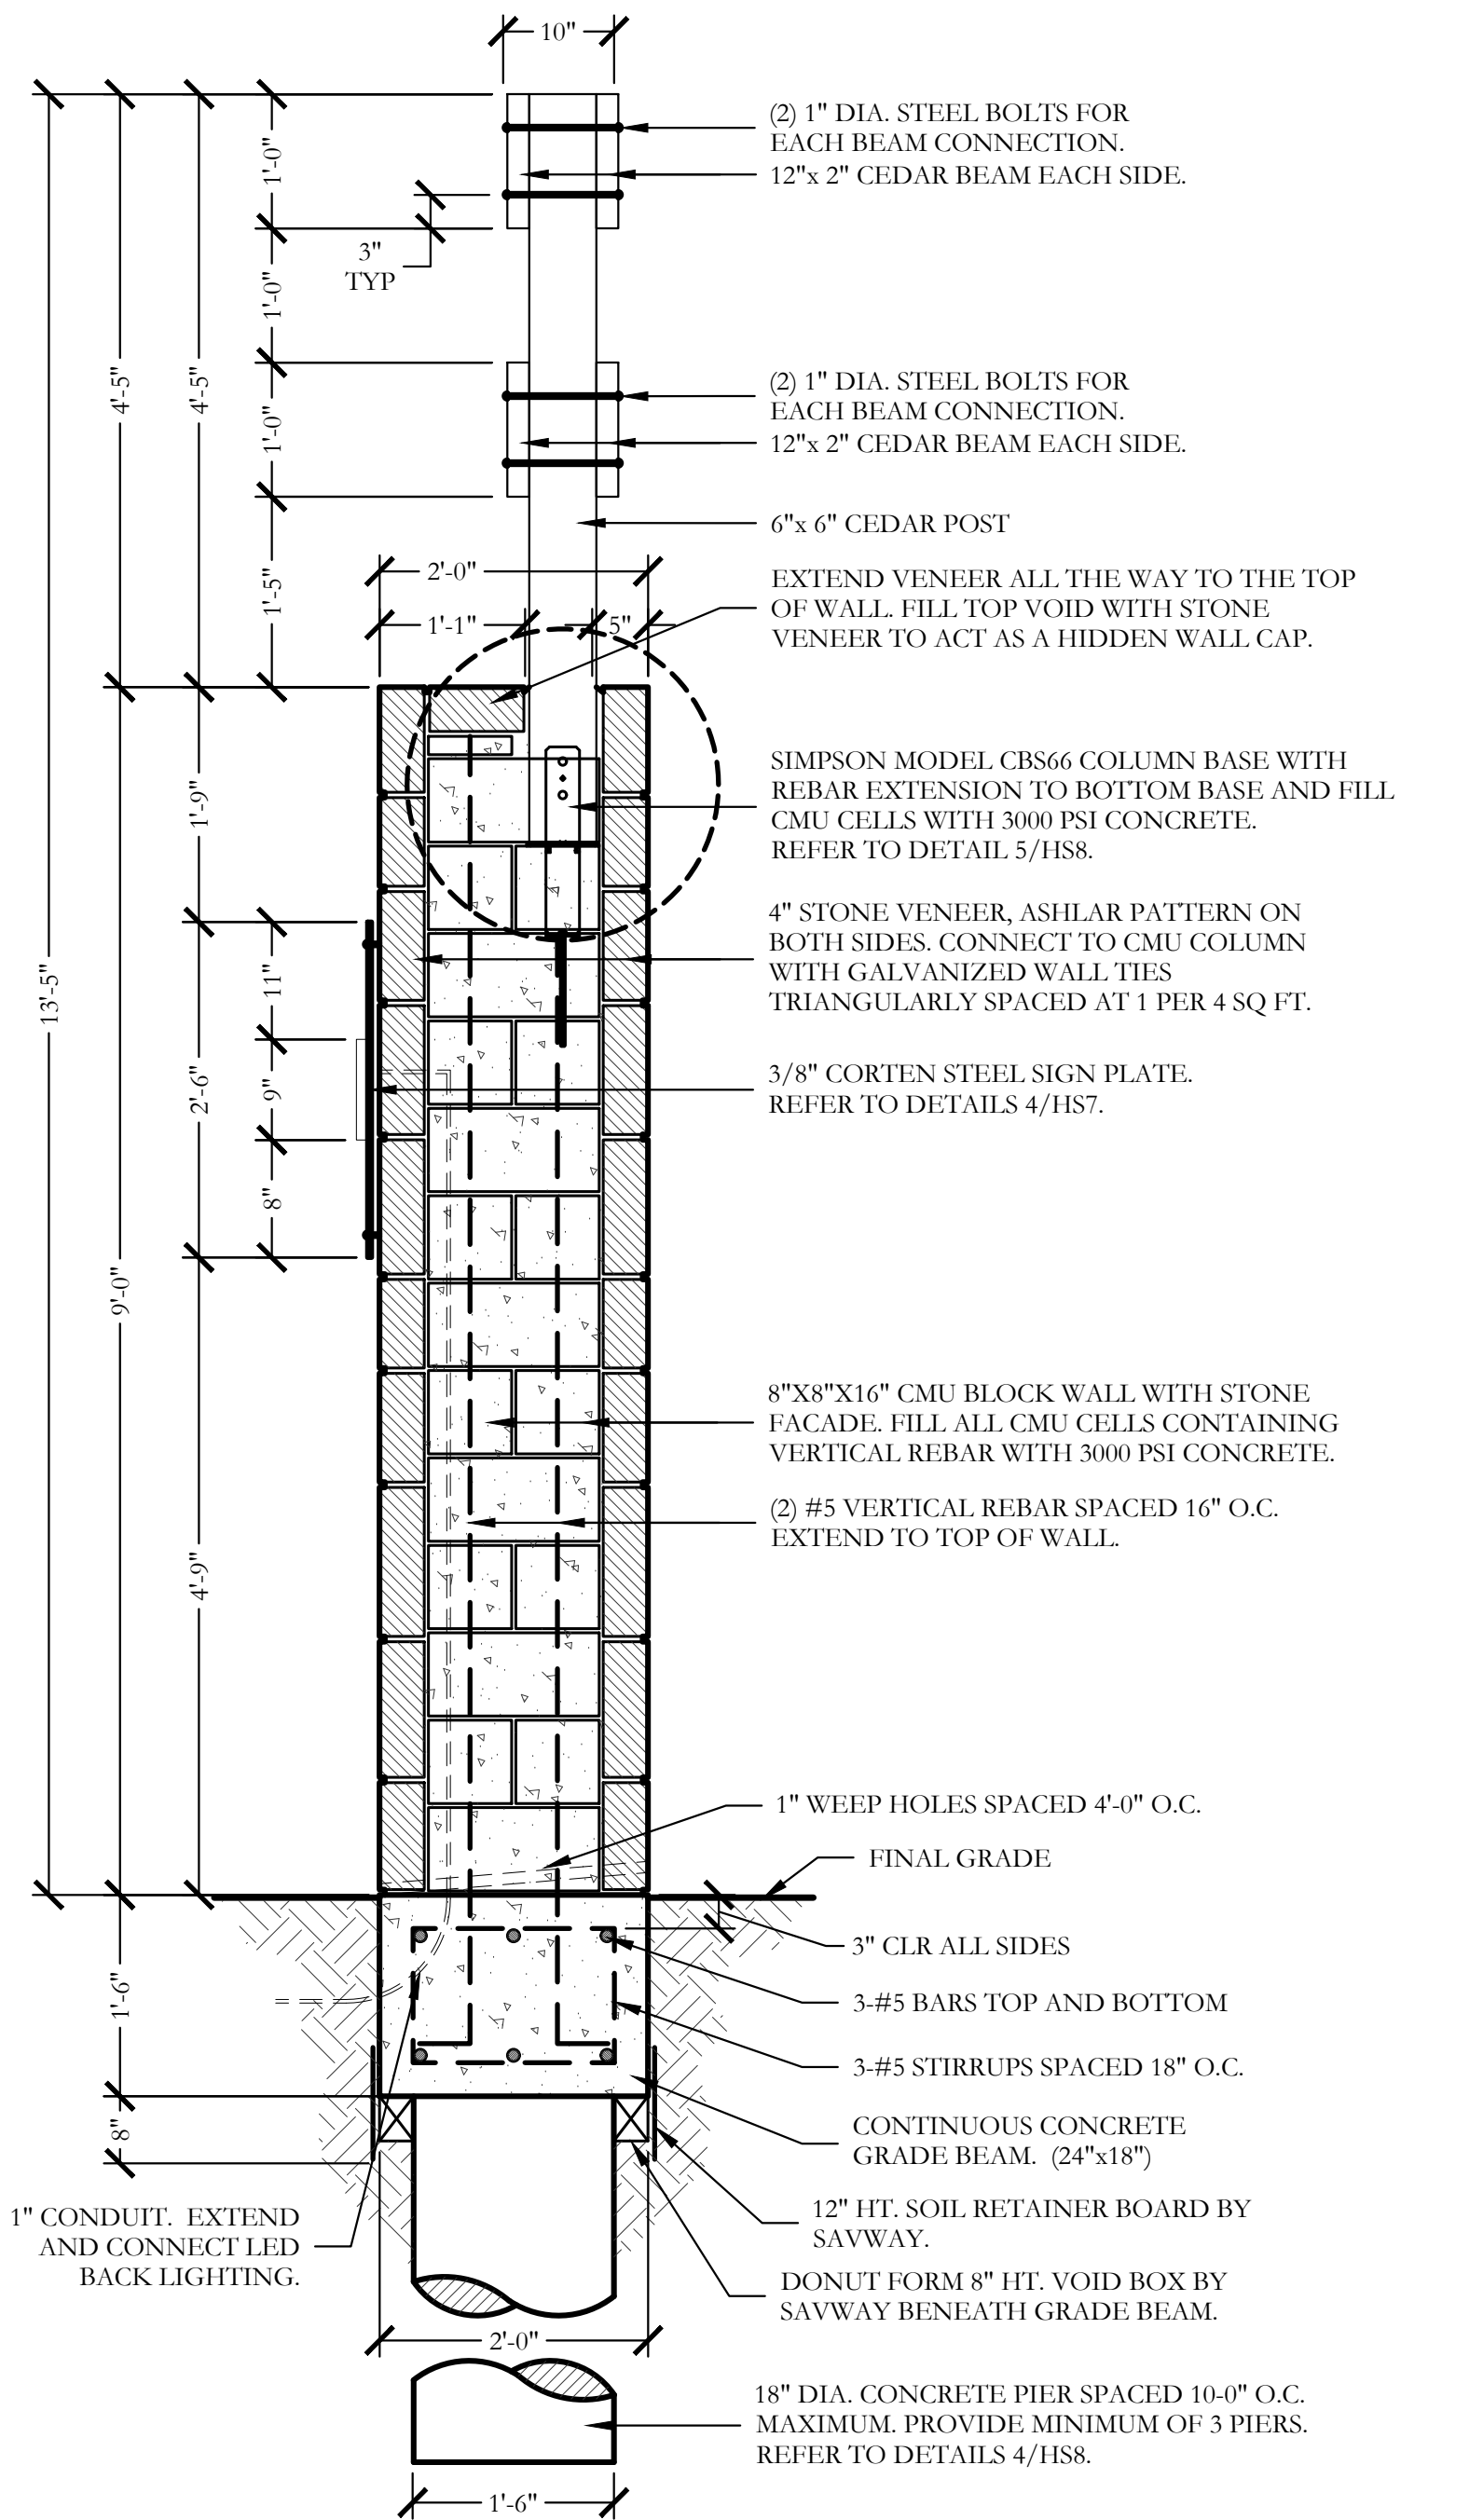


1 9'-0" HT. STONE SIGN PANEL W/ CEDAR OVERHEAD SECTION SCALE: 3/4"=1'-0"

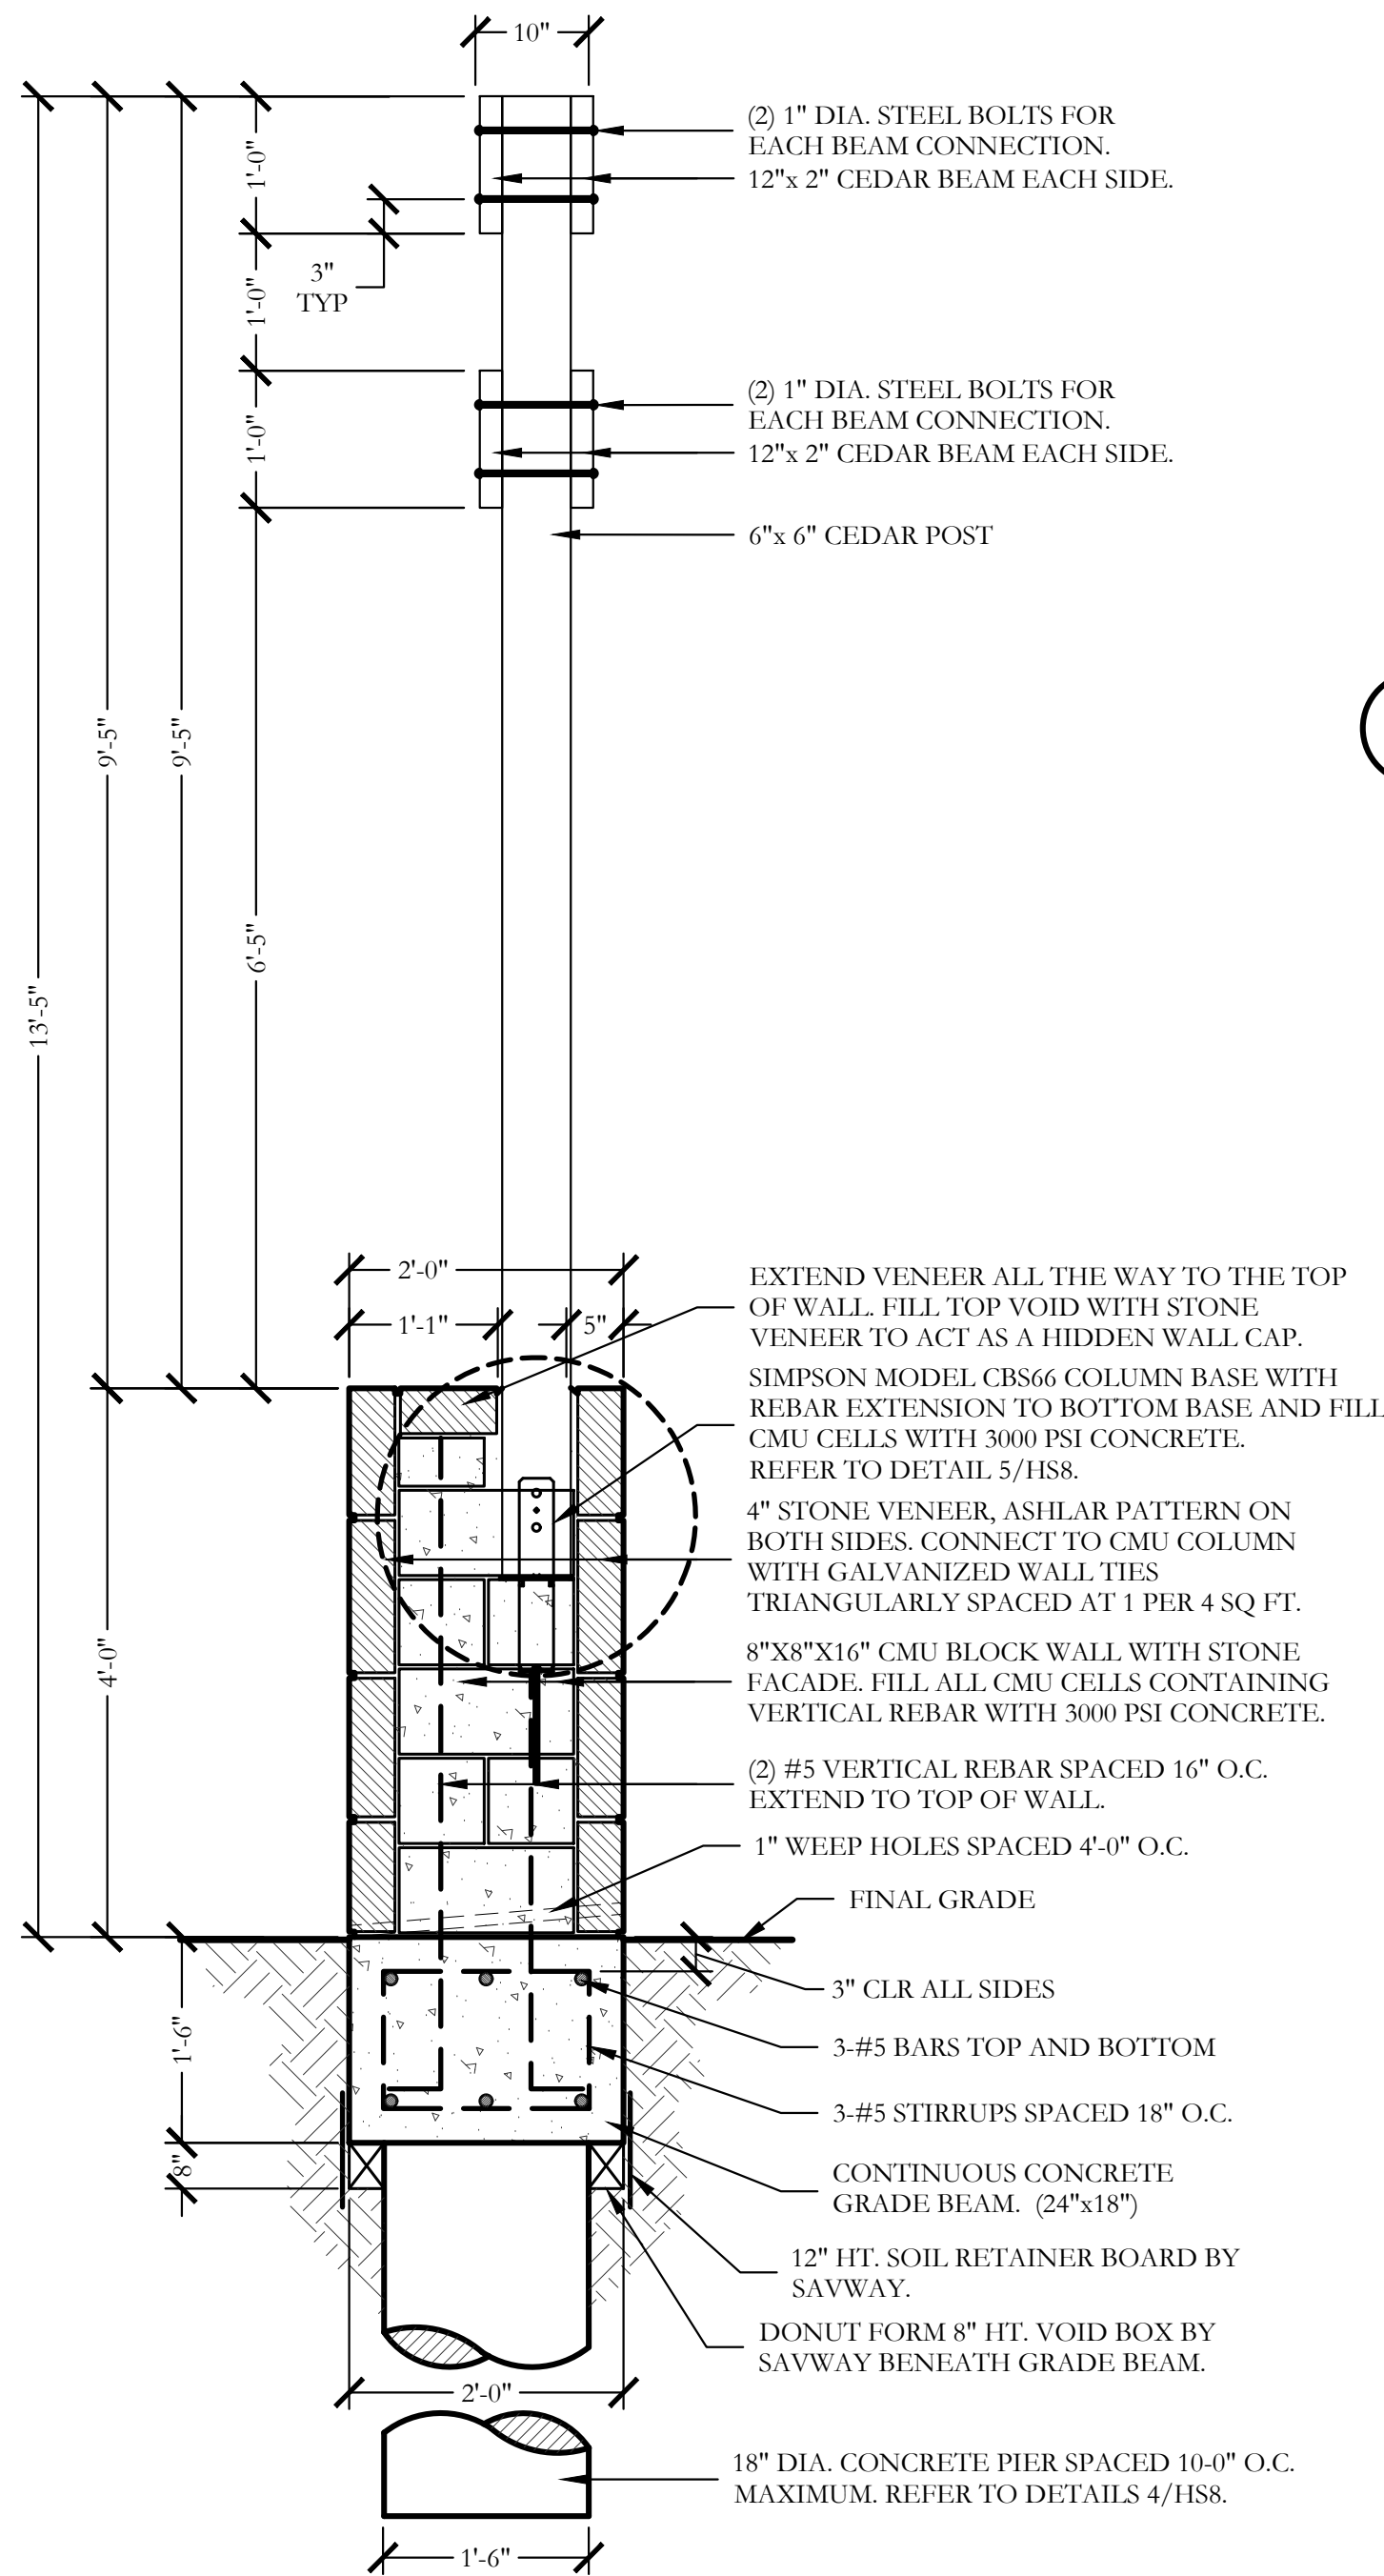

2 4'-0" HT. STONE WALL W/ CEDAR OVERHEAD SECTION SCALE: 3/4"=1'-0"

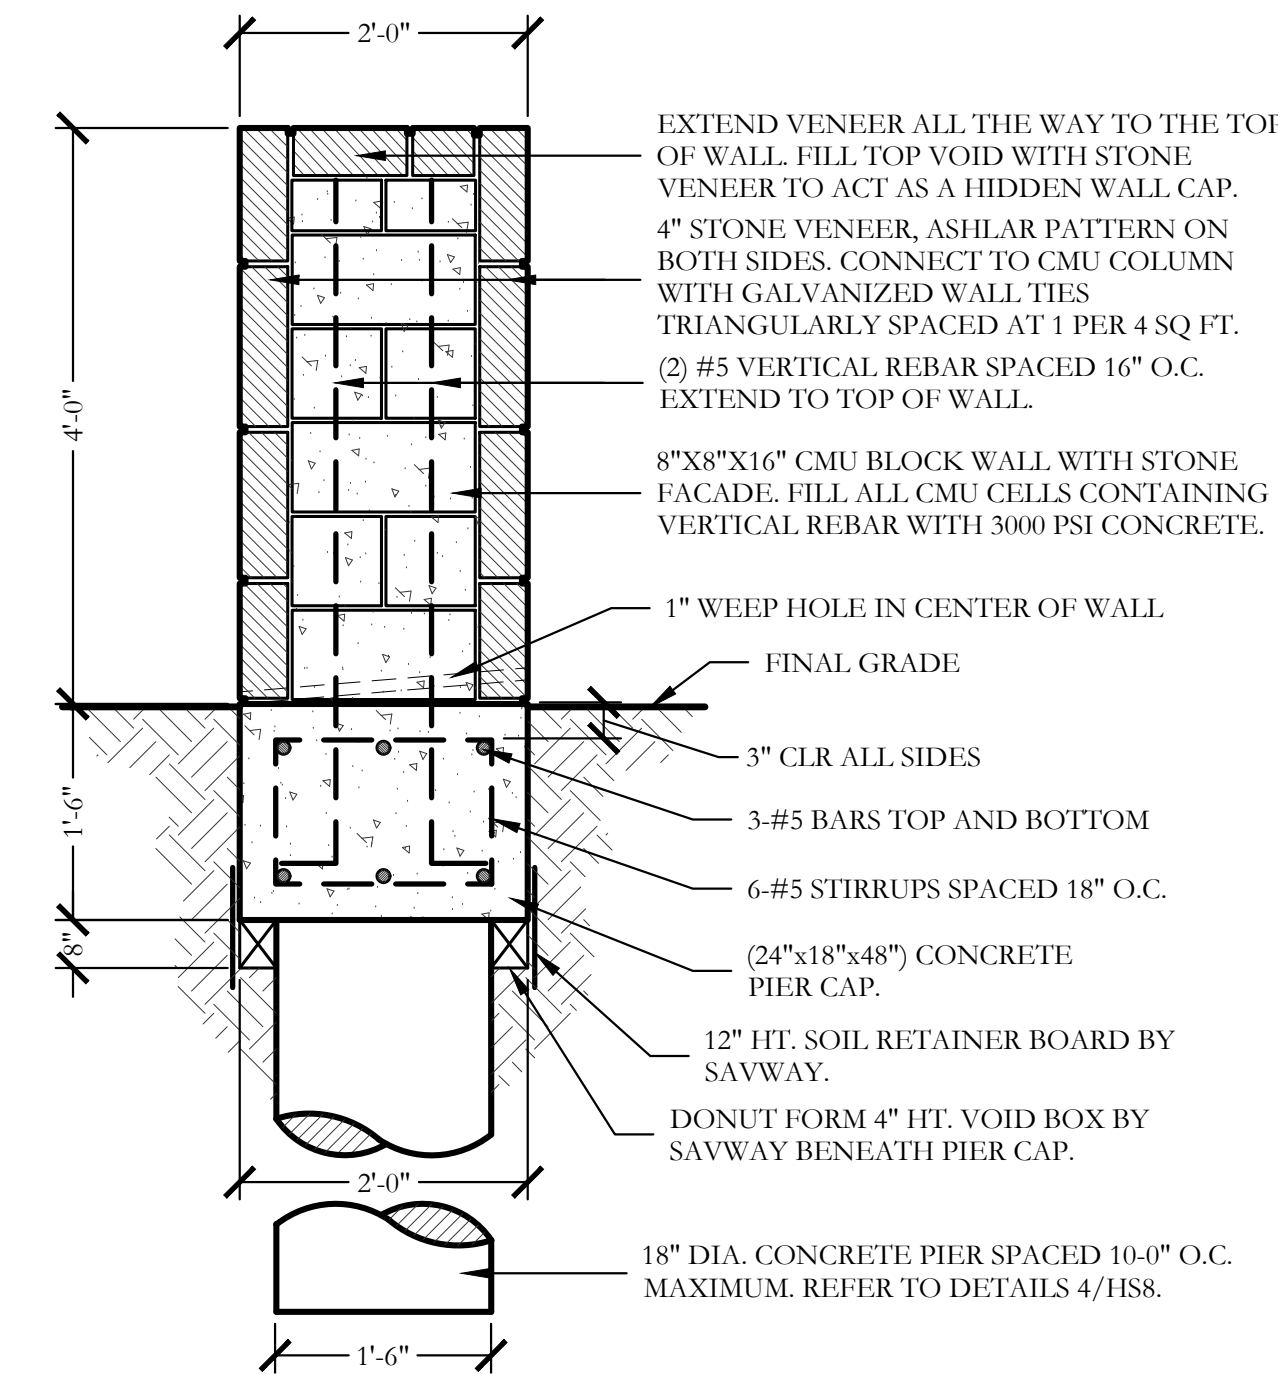

3 4'-0" HT. STONE WALL SECTION SCALE: 3/4"=1'-0"

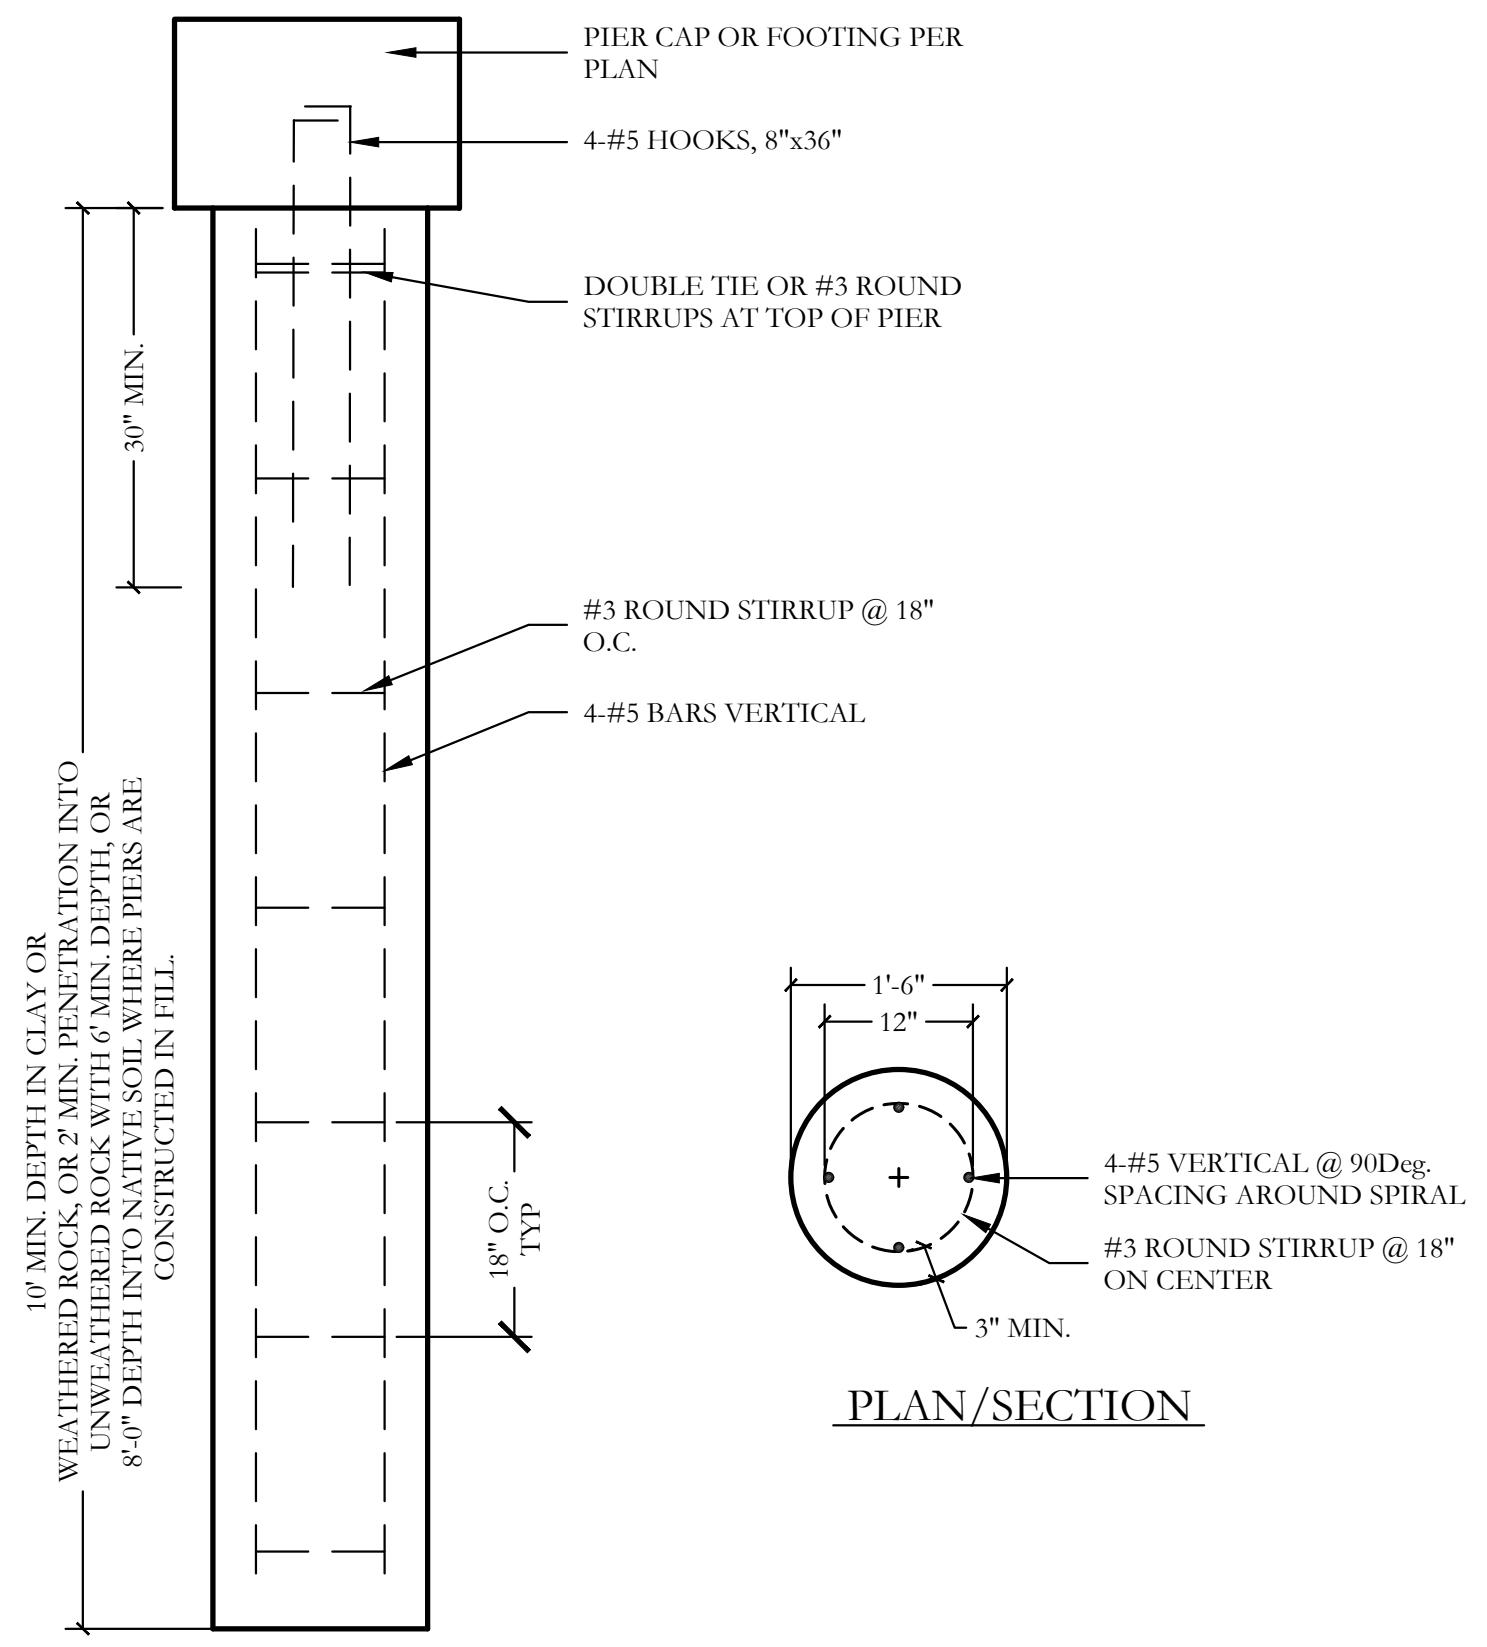


4 PIER (18" DIA.) PLAN/SECTION SCALE: 3/4"=1'-0"

RECORD DRAWINGS

To the best of our knowledge Engineering Concepts & Design, L.P., hereby states that this plan is As-Built. This information provided is based on surveying at the site and information provided by the contractor.

*Ryan C. King* 1/27/2021  
RYAN C. KING DATE

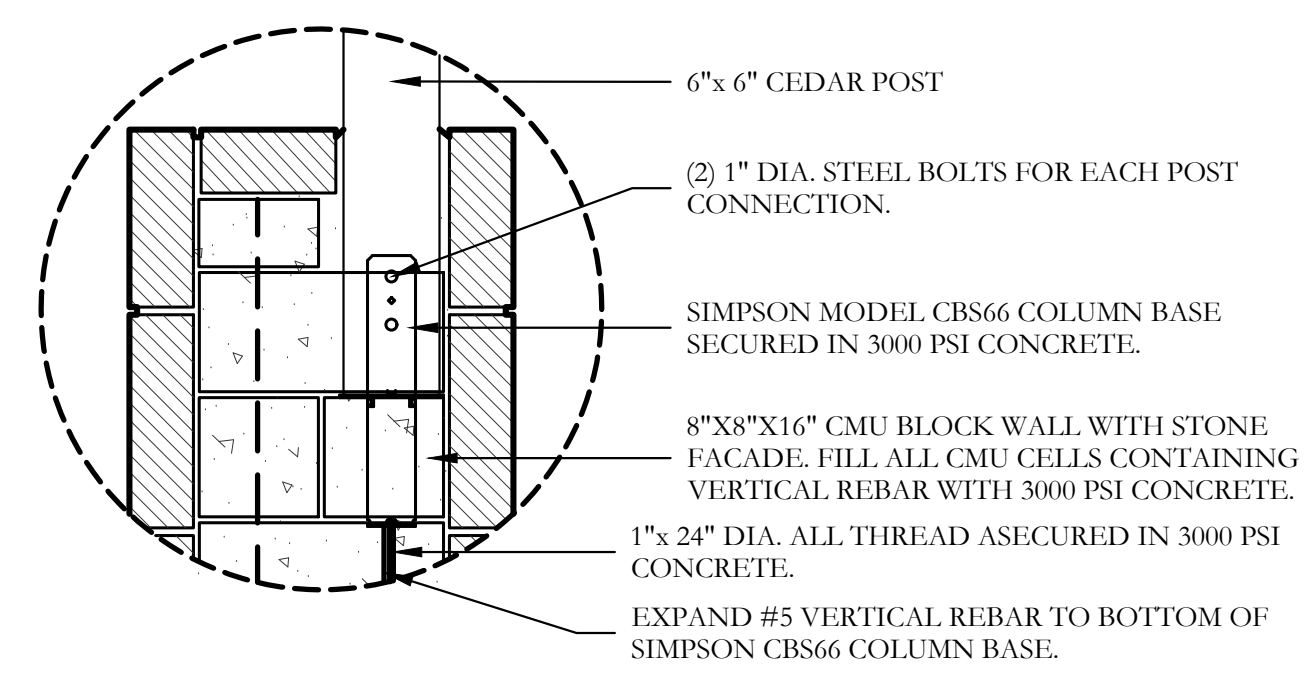

5 SIMPSON COLUMN BASE CONNECTION SECTION SCALE: 1"=1'-0"

NOTE:  
DESIGN BASED ON PRELIMINARY  
GEOTECHNICAL REPORT (ALPHA NO. G190837).  
FINAL GEOTECHNICAL REPORT NOT  
AVAILABLE AT TIME OF DESIGN. FINAL  
REPORT SHALL BE PROVIDED TO ENGINEER  
FOR REVIEW PRIOR TO CONSTRUCTION  
TAKING PLACE.

CODY JOHNSON  
s.t.u.d.i.o

9720 COTT ROAD SUITE 220-333 PLANO, TEXAS 75025  
PH: (909) 570-0162  
EMAIL: CODY@CODYJOHNSONSTUDIO.COM

STATE OF TEXAS  
RICHARD REAVES  
91128  
LICENSED PROFESSIONAL ENGINEER

April 1, 2020

REAVES CONSULTING  
831 ARROWHEAD DRIVE  
FROSTSPR, TEXAS 75078  
972.347.3908  
RICHARD@REAVESCONSULTINGLLC.COM  
F-10826

Bar is one inch on original drawing. If not one inch on this sheet, adjust scale as necessary.

One Inch

SCREENING AND BUFFERING

Hardscape Details

Northgate Phase 1

City of Rockwall, Tarrant County, Texas


CJS PROJECT NO.  
MJP001

SHEET NO.  
HS8 of 10



1. CONCRETE MASONRY UNITS SHALL BE HOLLOW LOAD-BEARING TYPE N-1 CONFORMING TO ASTM C90 AND HAVE A MINIMUM COMPRESSIVE STRENGTH OF 1900 PSI.
2. CONCRETE MASONRY UNITS SHALL HAVE A MINIMUM PRISM STRENGTH OF 1500 PSI AT 28 DAYS.
3. MORTAR SHALL BE ASTM C270, TYPE S, WITH A MINIMUM COMPRESSIVE STRENGTH OF 1800 PSI IN ACCORDANCE WITH ASTM C780. MASONRY CEMENT IS PROHIBITED.
4. PLACEMENT OF GROUT SHALL BE IN ACCORDANCE WITH ASTM C1107, COMPRESSIVE STRENGTH OF 2500 PSI AND A MAXIMUM AGGREGATE SIZE OF 3/4" IN ACCORDANCE WITH ASTM C476/REFER TO DETAILS FOR WALL REINFORCING BAR SIZE AND SPACING.
5. REINFORCE HORIZONTAL JOINTS WITH GALVANIZED LADDER-TYPE STEEL IN ACCORDANCE WITH ASTM A618. REINFORCING BARS SHALL BE 3/8" MINIMUM.
6. HORIZONTAL REINFORCEMENT SHALL BE SPACED AT 16" MAXIMUM. PROVIDE A 6" LAP AT SPLICES.
7. JOINT REINFORCING SHALL BE DISCONTINUOUS AT CONTROL AND EXPANSION JOINTS.
8. VERTICAL REINFORCING BARS AT 72" BAR DIAMETERS.
9. LAP HORIZONTAL REINFORCING BARS AT 48" BAR DIAMETERS.
10. PLACE GROUT USING LOW-LIFT METHOD, 6"-8" MAXIMUM LIFTS.

One Inch

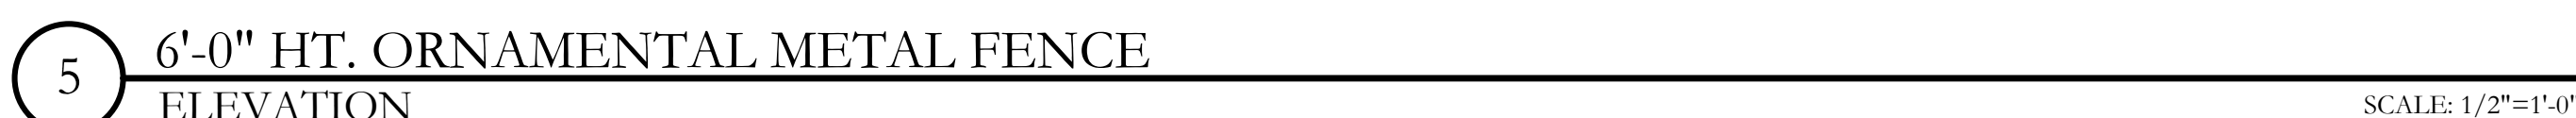

NOTE:  
DESIGN BASED ON PRELIMINARY  
GEOTECHNICAL REPORT (ALPHA NO. G190837).  
FINAL GEOTECHNICAL REPORT NOT  
AVAILABLE AT TIME OF DESIGN. FINAL  
REPORT SHALL BE PROVIDED TO ENGINEER  
FOR REVIEW PRIOR TO CONSTRUCTION  
TAKING PLACE.

## SCREENING AND BUFFERING

### Hardscape Details

## Northgate Phase I


City of Rockwall, Tarrant County, Texas

US PROJECT NO.

MJP001


SHEET NO.

IS9 of 10

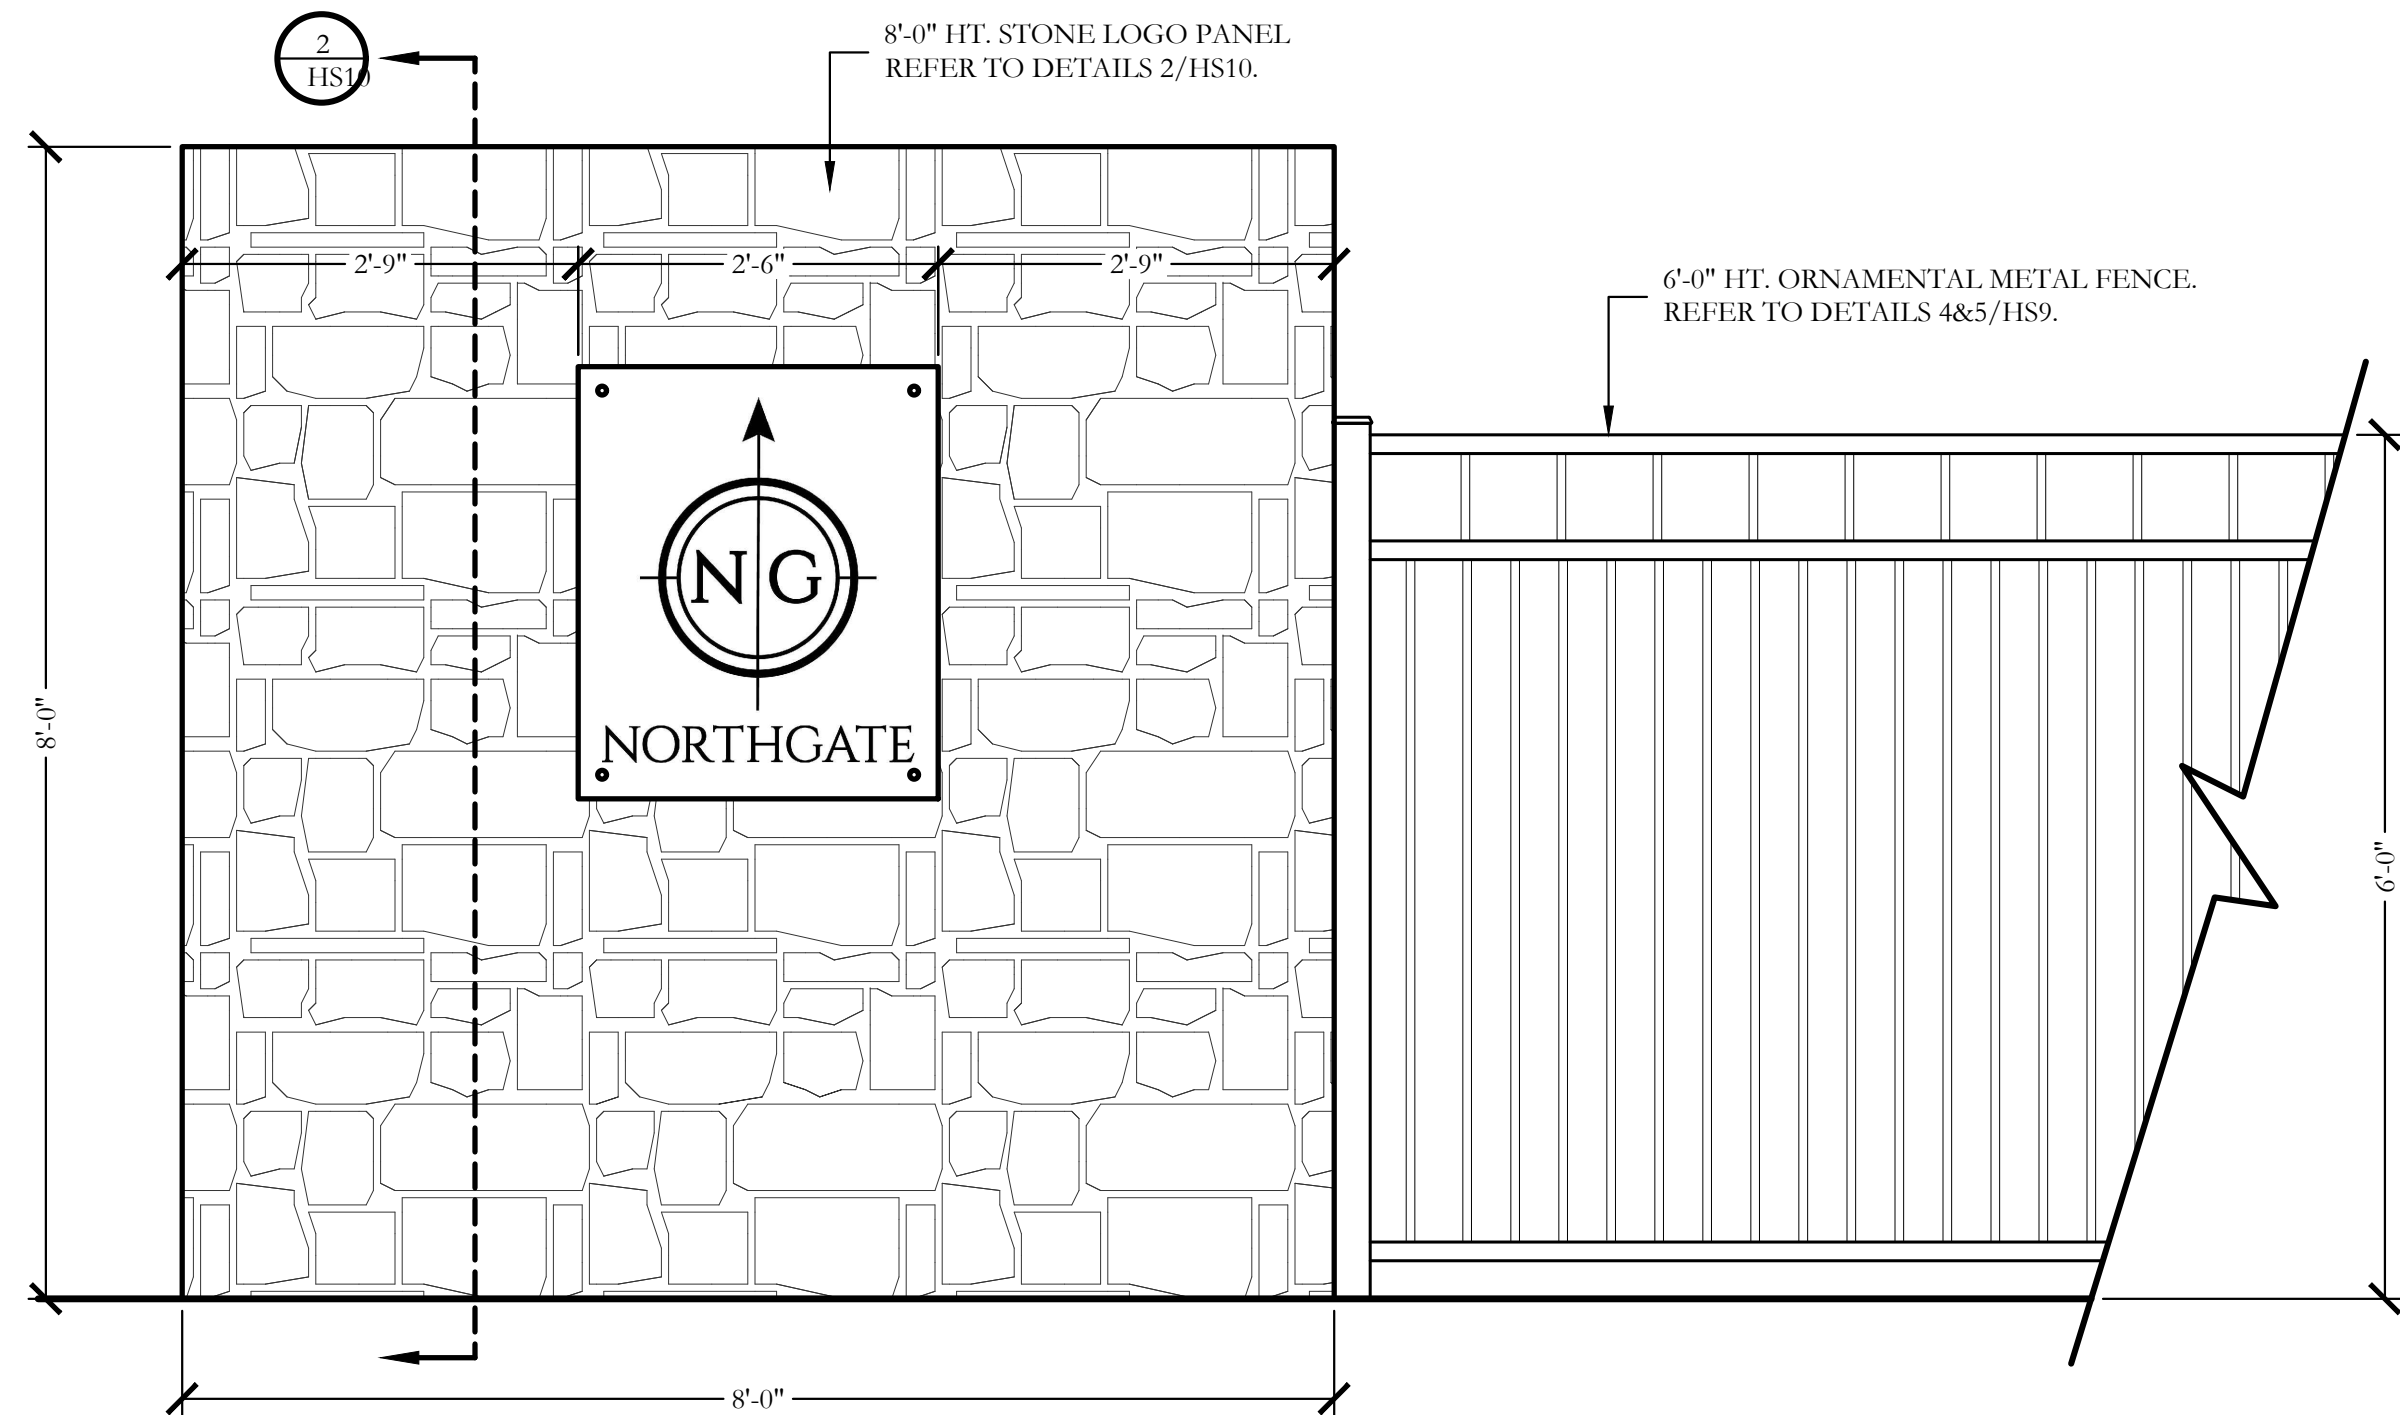

1 8'-0" HT. SECONDARY ENTRY SEQUENCE  
ELEVATION

SCALE: 3/4"=1'-0"

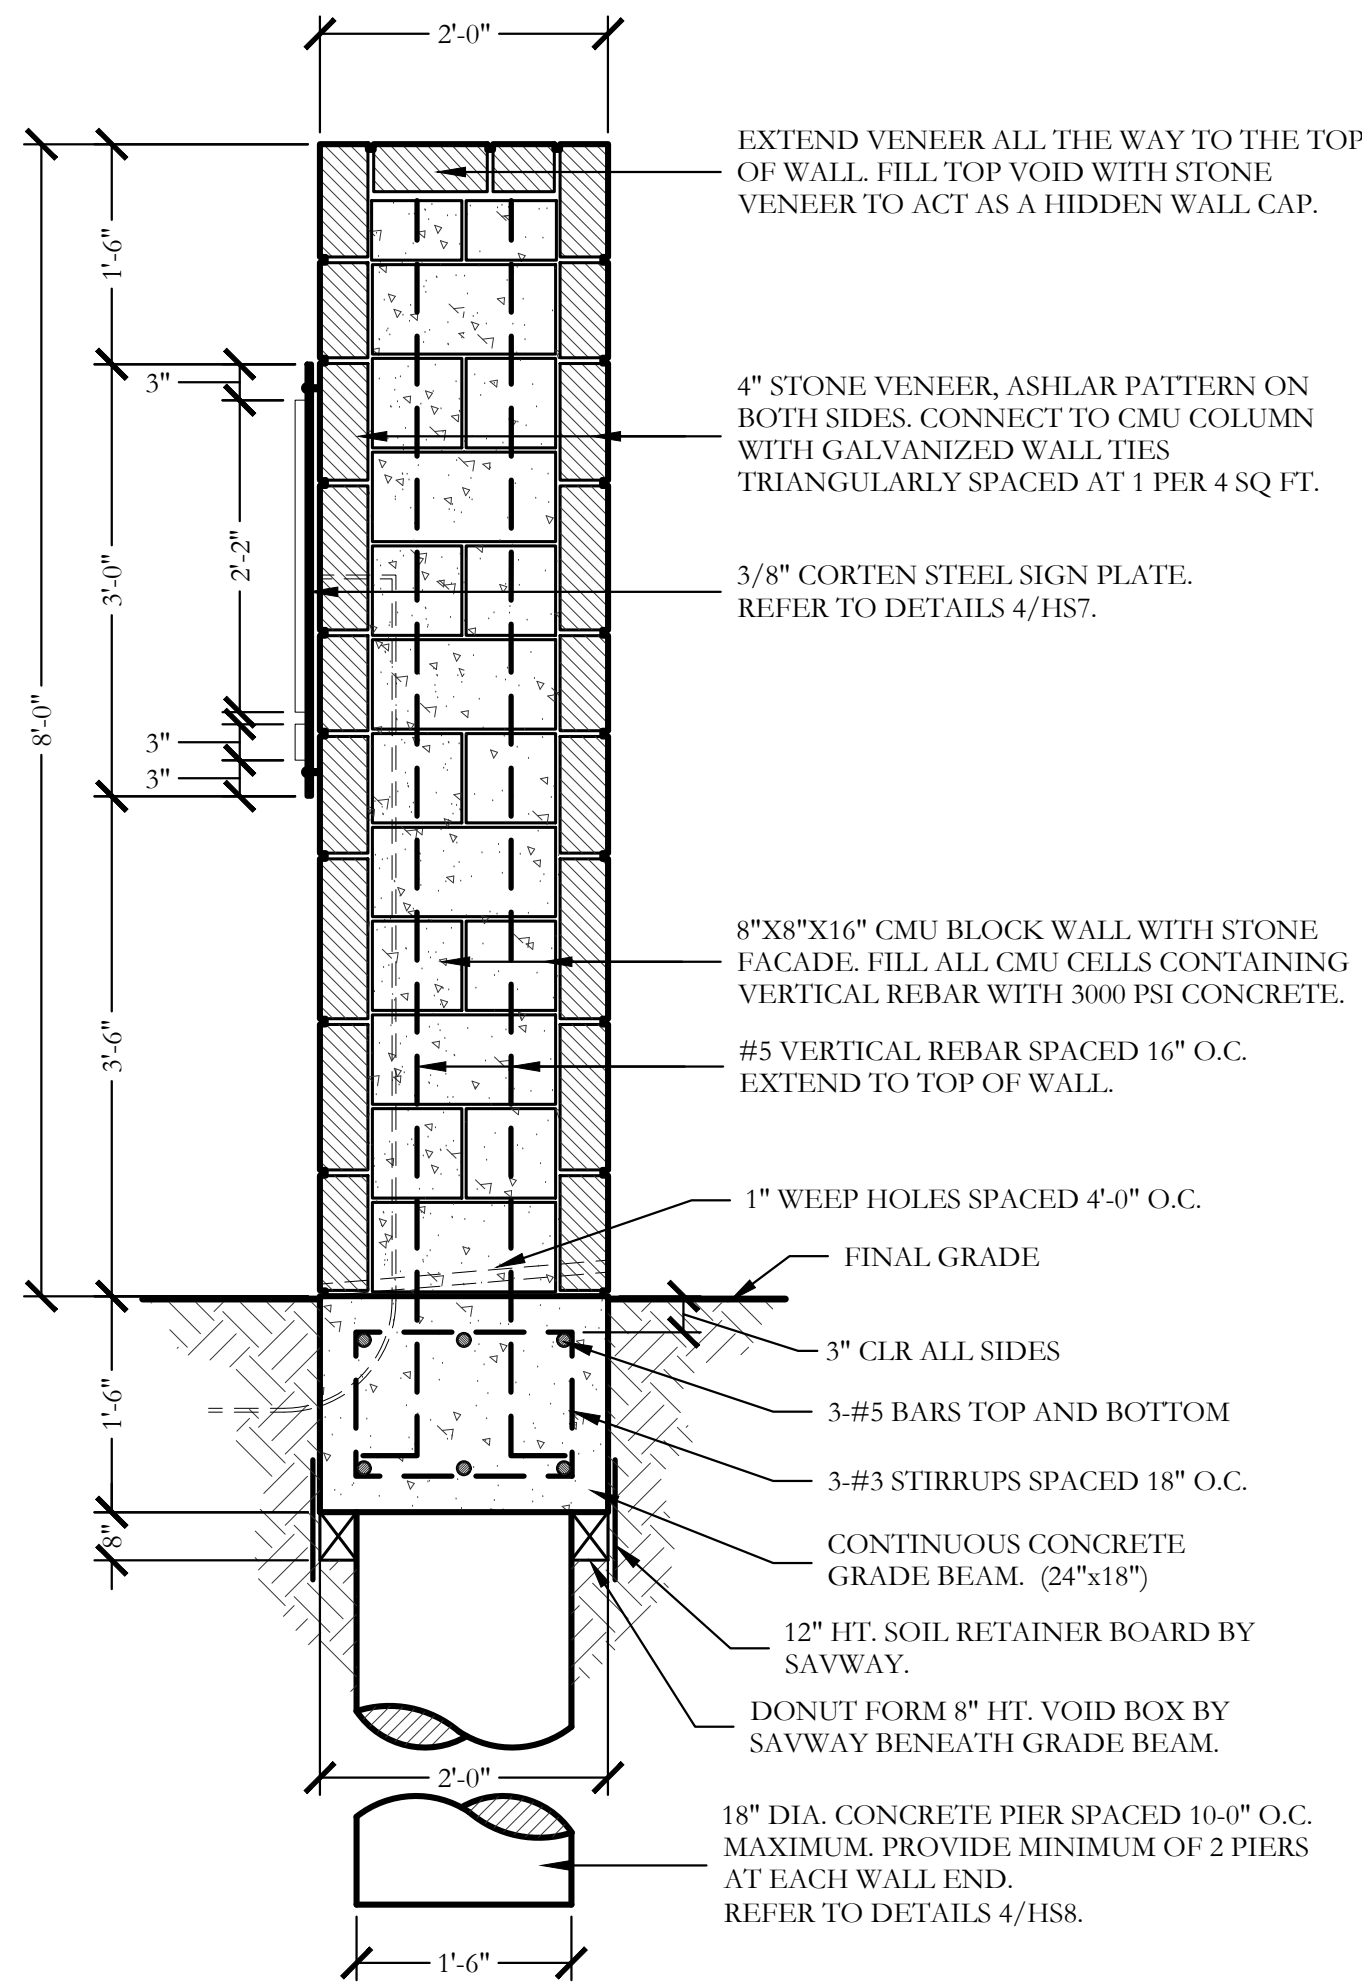

2 8'-0" HT. STONE LOGO PANEL  
SECTION

SCALE: 3/4"=1'-0"



RECORD DRAWINGS


To the best of our knowledge Engineering Concepts & Design, L.P., hereby states that this plan is As-Built. This information provided is based on surveying at the site and information provided by the contractor.

*Ryan C. King*  
RYAN C. KING

1/27/2021  
DATE

NOTE:  
DESIGN BASED ON PRELIMINARY GEOTECHNICAL REPORT (ALPHA NO. G190837). FINAL GEOTECHNICAL REPORT NOT AVAILABLE AT TIME OF DESIGN. FINAL REPORT SHALL BE PROVIDED TO ENGINEER FOR REVIEW PRIOR TO CONSTRUCTION TAKING PLACE.

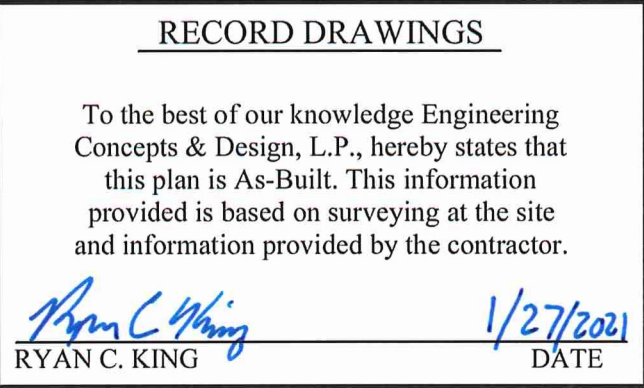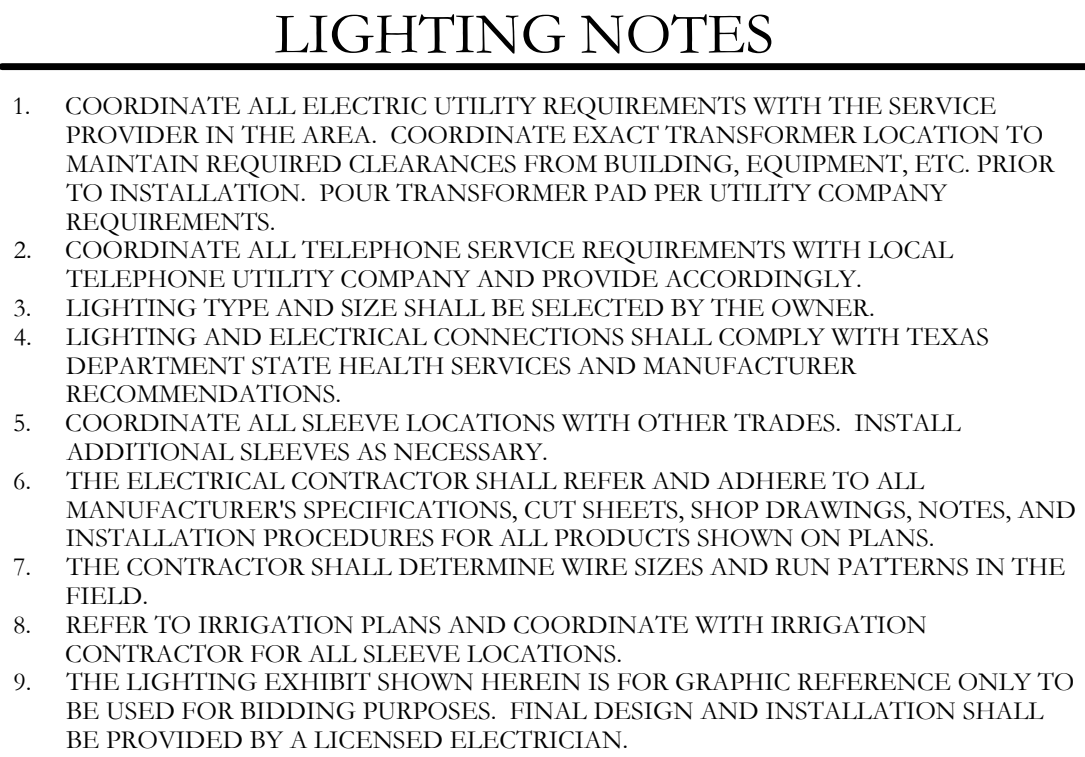

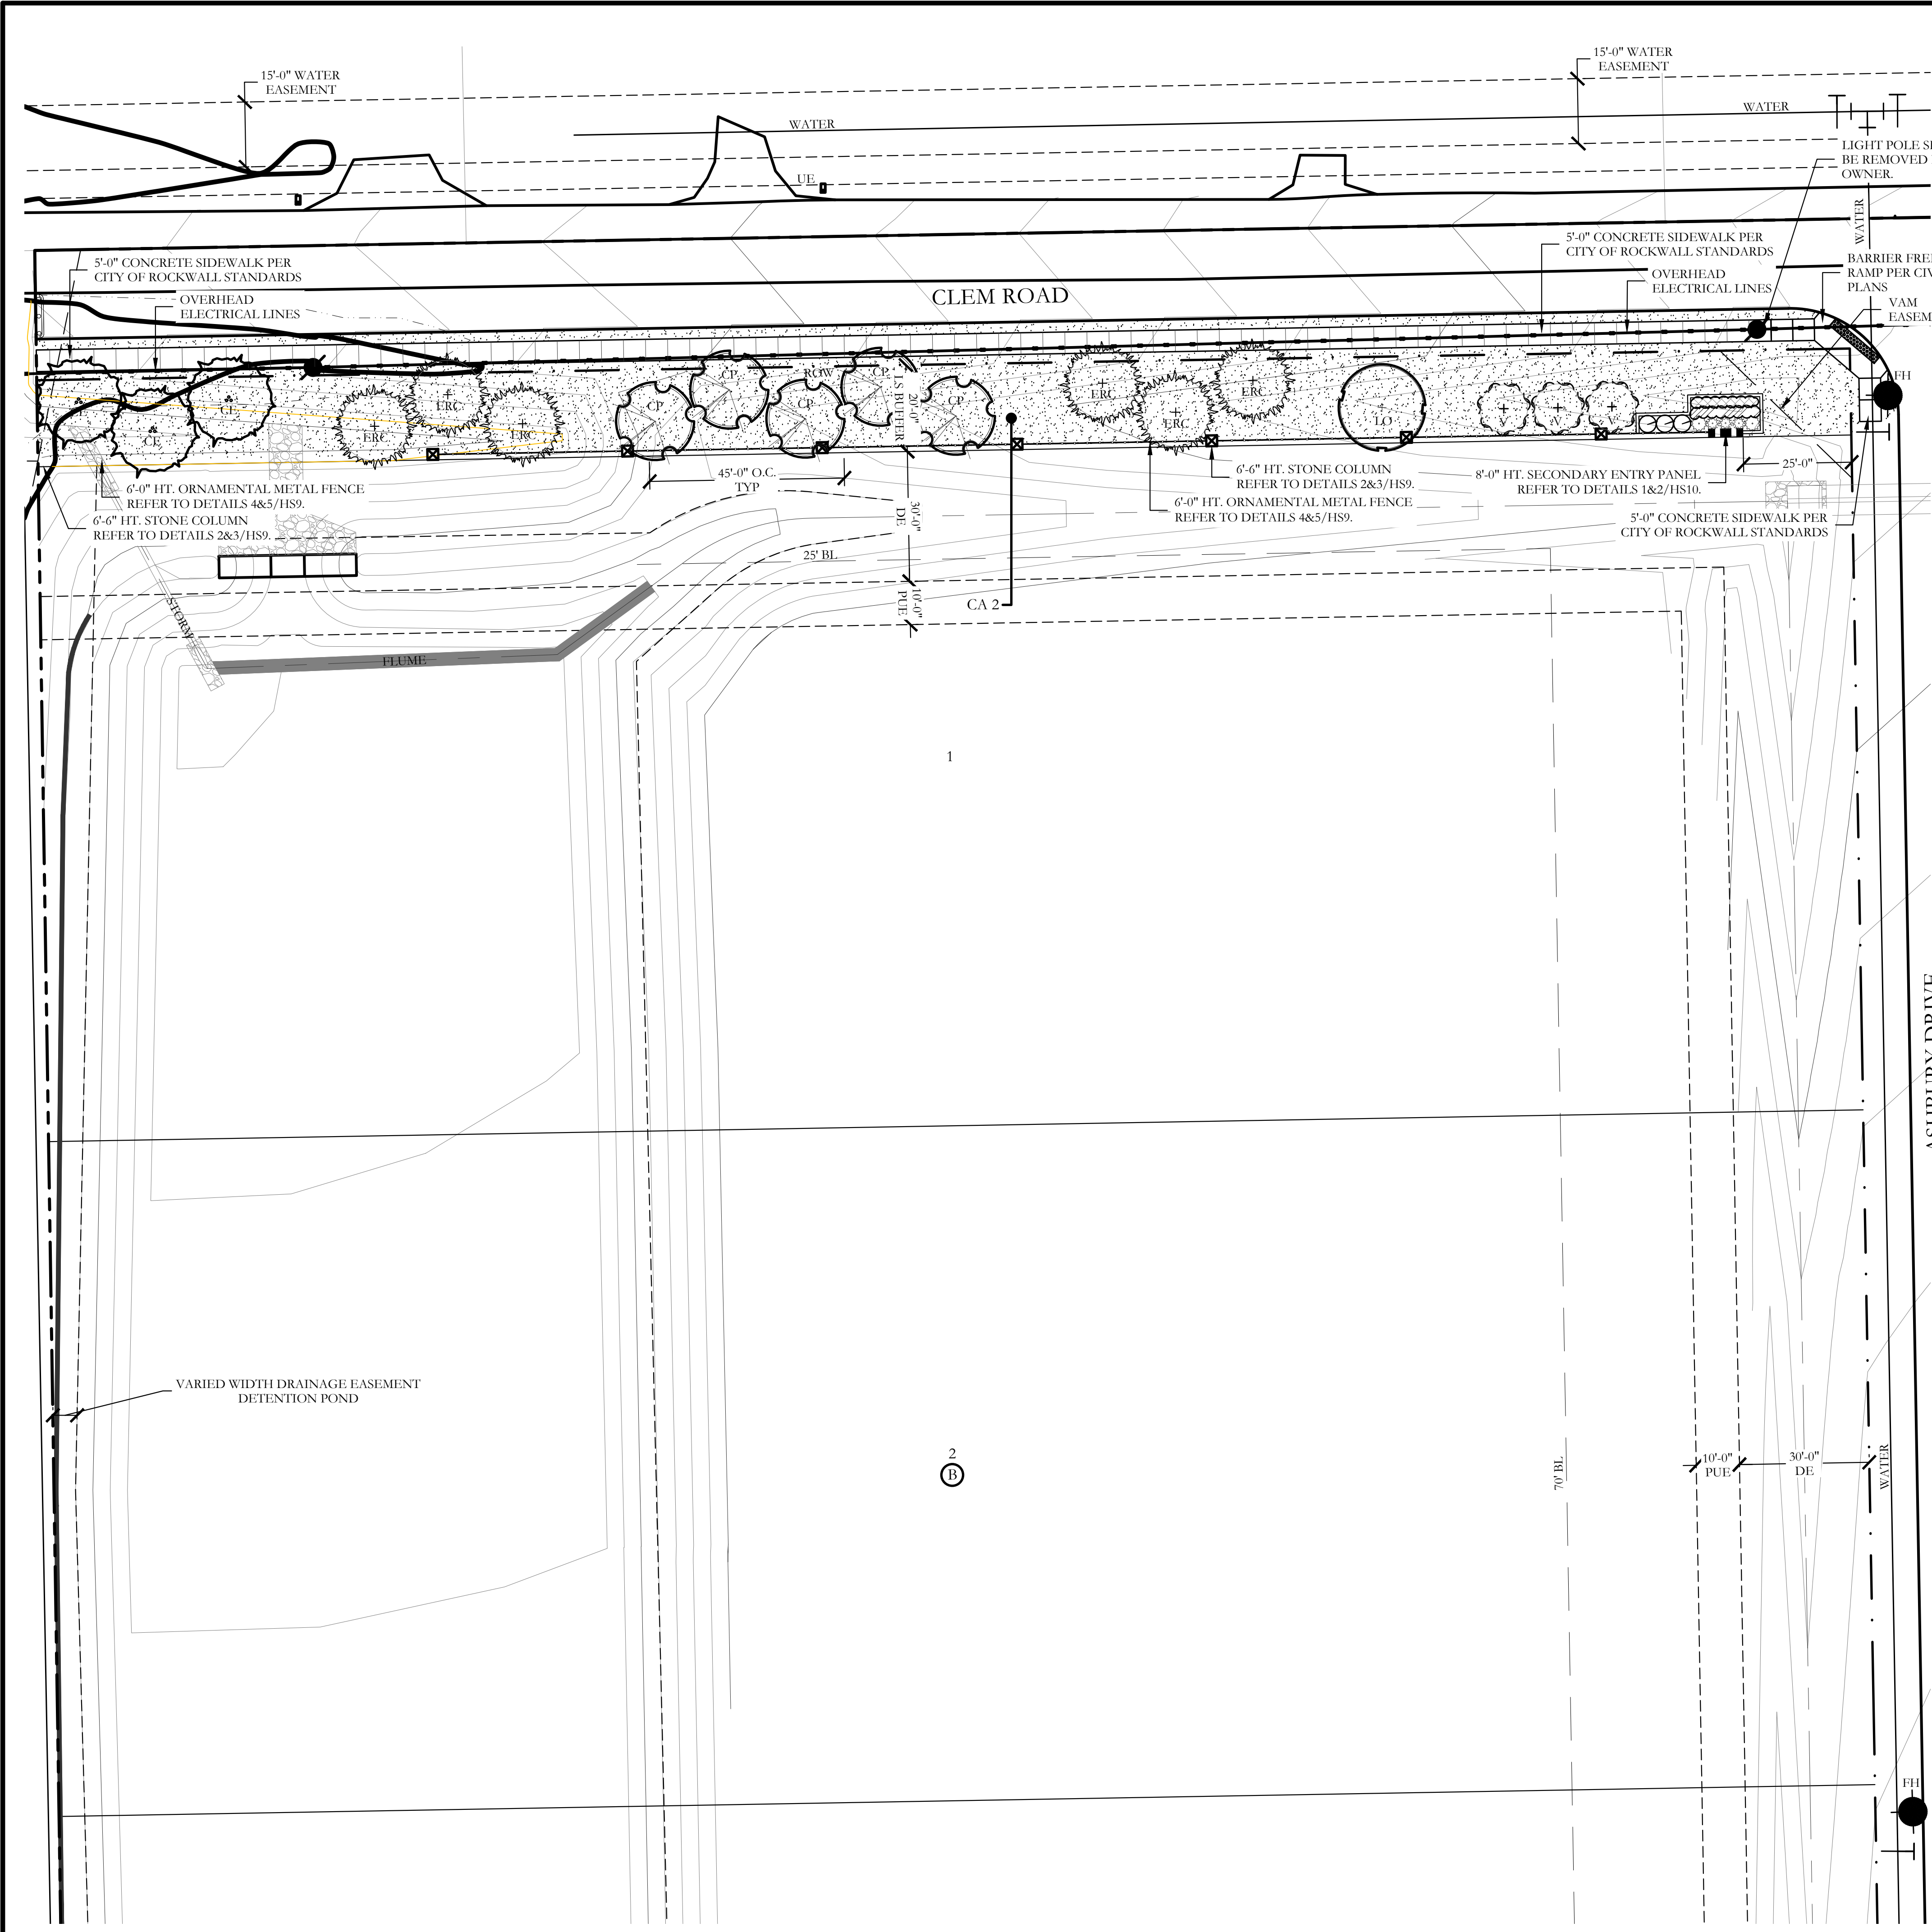

PLANT LEGEND					
SYMBOL	KEY	COMMON NAME	SCIENTIFIC NAME	SIZE	SPACING
	LO	LIVE OAK	QUERCUS VIRGINIANA	4" CALIPER	AS SHOWN
	LE	LACEBARK ELM	ULMUS PARVIFOLIA	4" CALIPER	AS SHOWN
	CP	CHINESE PISTACHE	PISTACIA CHINENSIS	4" CALIPER	AS SHOWN
	CE	CEDAR ELM	ULMUS CRASSIFOLIA	4" CALIPER	AS SHOWN
	ERC	EASTERN RED CEDAR AS PROVIDED BY OWNER	JUNIPERUS VIRGINIANA	MINIMUM 4" CALIPER	AS SHOWN
	V	CHASTE TREE	VITEX ANGUS-CASTUS	2" CALIPER	AS SHOWN
	DW	DESERT WILLOW	CHILOPSIS LINEARIS	2" CALIPER	AS SHOWN
	BA	BLUE ATLAS CEDAR	CEDRUS ATLANTICA 'GLAUCA'	2" CALIPER	AS SHOWN
		TEXAS SAGE	LEUCOPHYLLUM FRUTESCENS	5 GALLON	48" O.C.
		UPRIGHT ROSEMARY	ROSMARINUS OFFICINALIS 'UPRIGHT'	5 GALLON	36" O.C.
		MORNING LIGHT MISCANTHUS	MISCANTHUS SINENSIS 'MORNING LIGHT'	5 GALLON	36" O.C.
		GOLD STAR JUNIPER	JUNIPERUS CHINENSIS 'BAKAUREA'	5 GALLON	48" O.C.
		SHORE JUNIPER	JUNIPERUS CONFERTA 'BLUE PACIFIC'	5 GALLON	36" O.C.
		GULF MUHLY GRASS	MUHLENBERGIA CAPILLARIS 'REGAL MIST'	5 GALLON	36" O.C.
		COMMON BERMUDA GRASS	CYNODON DACTYLON	SQUARE FEET	SOLID SOD
		NATIVE DRAINFIELD SEED MIX	BY NATIVE AMERICAN SEED CO.	SQUARE FEET	HYDROMULCH

RECORD DRAWINGS

To the best of our knowledge Engineering Concepts & Design, L.P., hereby states that this plan is As-Built. This information provided is based on surveying at the site and information provided by the contractor.

*Ryan C. King*  
RYAN C. KING

1/27/2021  
DATE

CODY JOHNSON  
s.t.u.d.i.o

9720 COTT ROAD SUITE 220A333 PLANO, TEXAS 75025  
PH: (972) 570-0162  
EMAIL: CODY@CODYJOHNSONSTUDIO.COM

REGISTERED LANDSCAPE ARCHITECT  
CODY L. JOHNSON  
2893  
STATE OF TEXAS  
June 1, 2020

NORTH

Scale: 1" = 20'-0"

Bar is one inch on original drawing. If not one inch on this sheet, adjust scale as necessary.

One Inch

SCREENING AND BUFFERING

Landscape Plan

Northgate Phase 1


City of Rockwall, Tarrant County, Texas

CJS PROJECT NO.

MJP001

SHEET NO.



L1 of 6

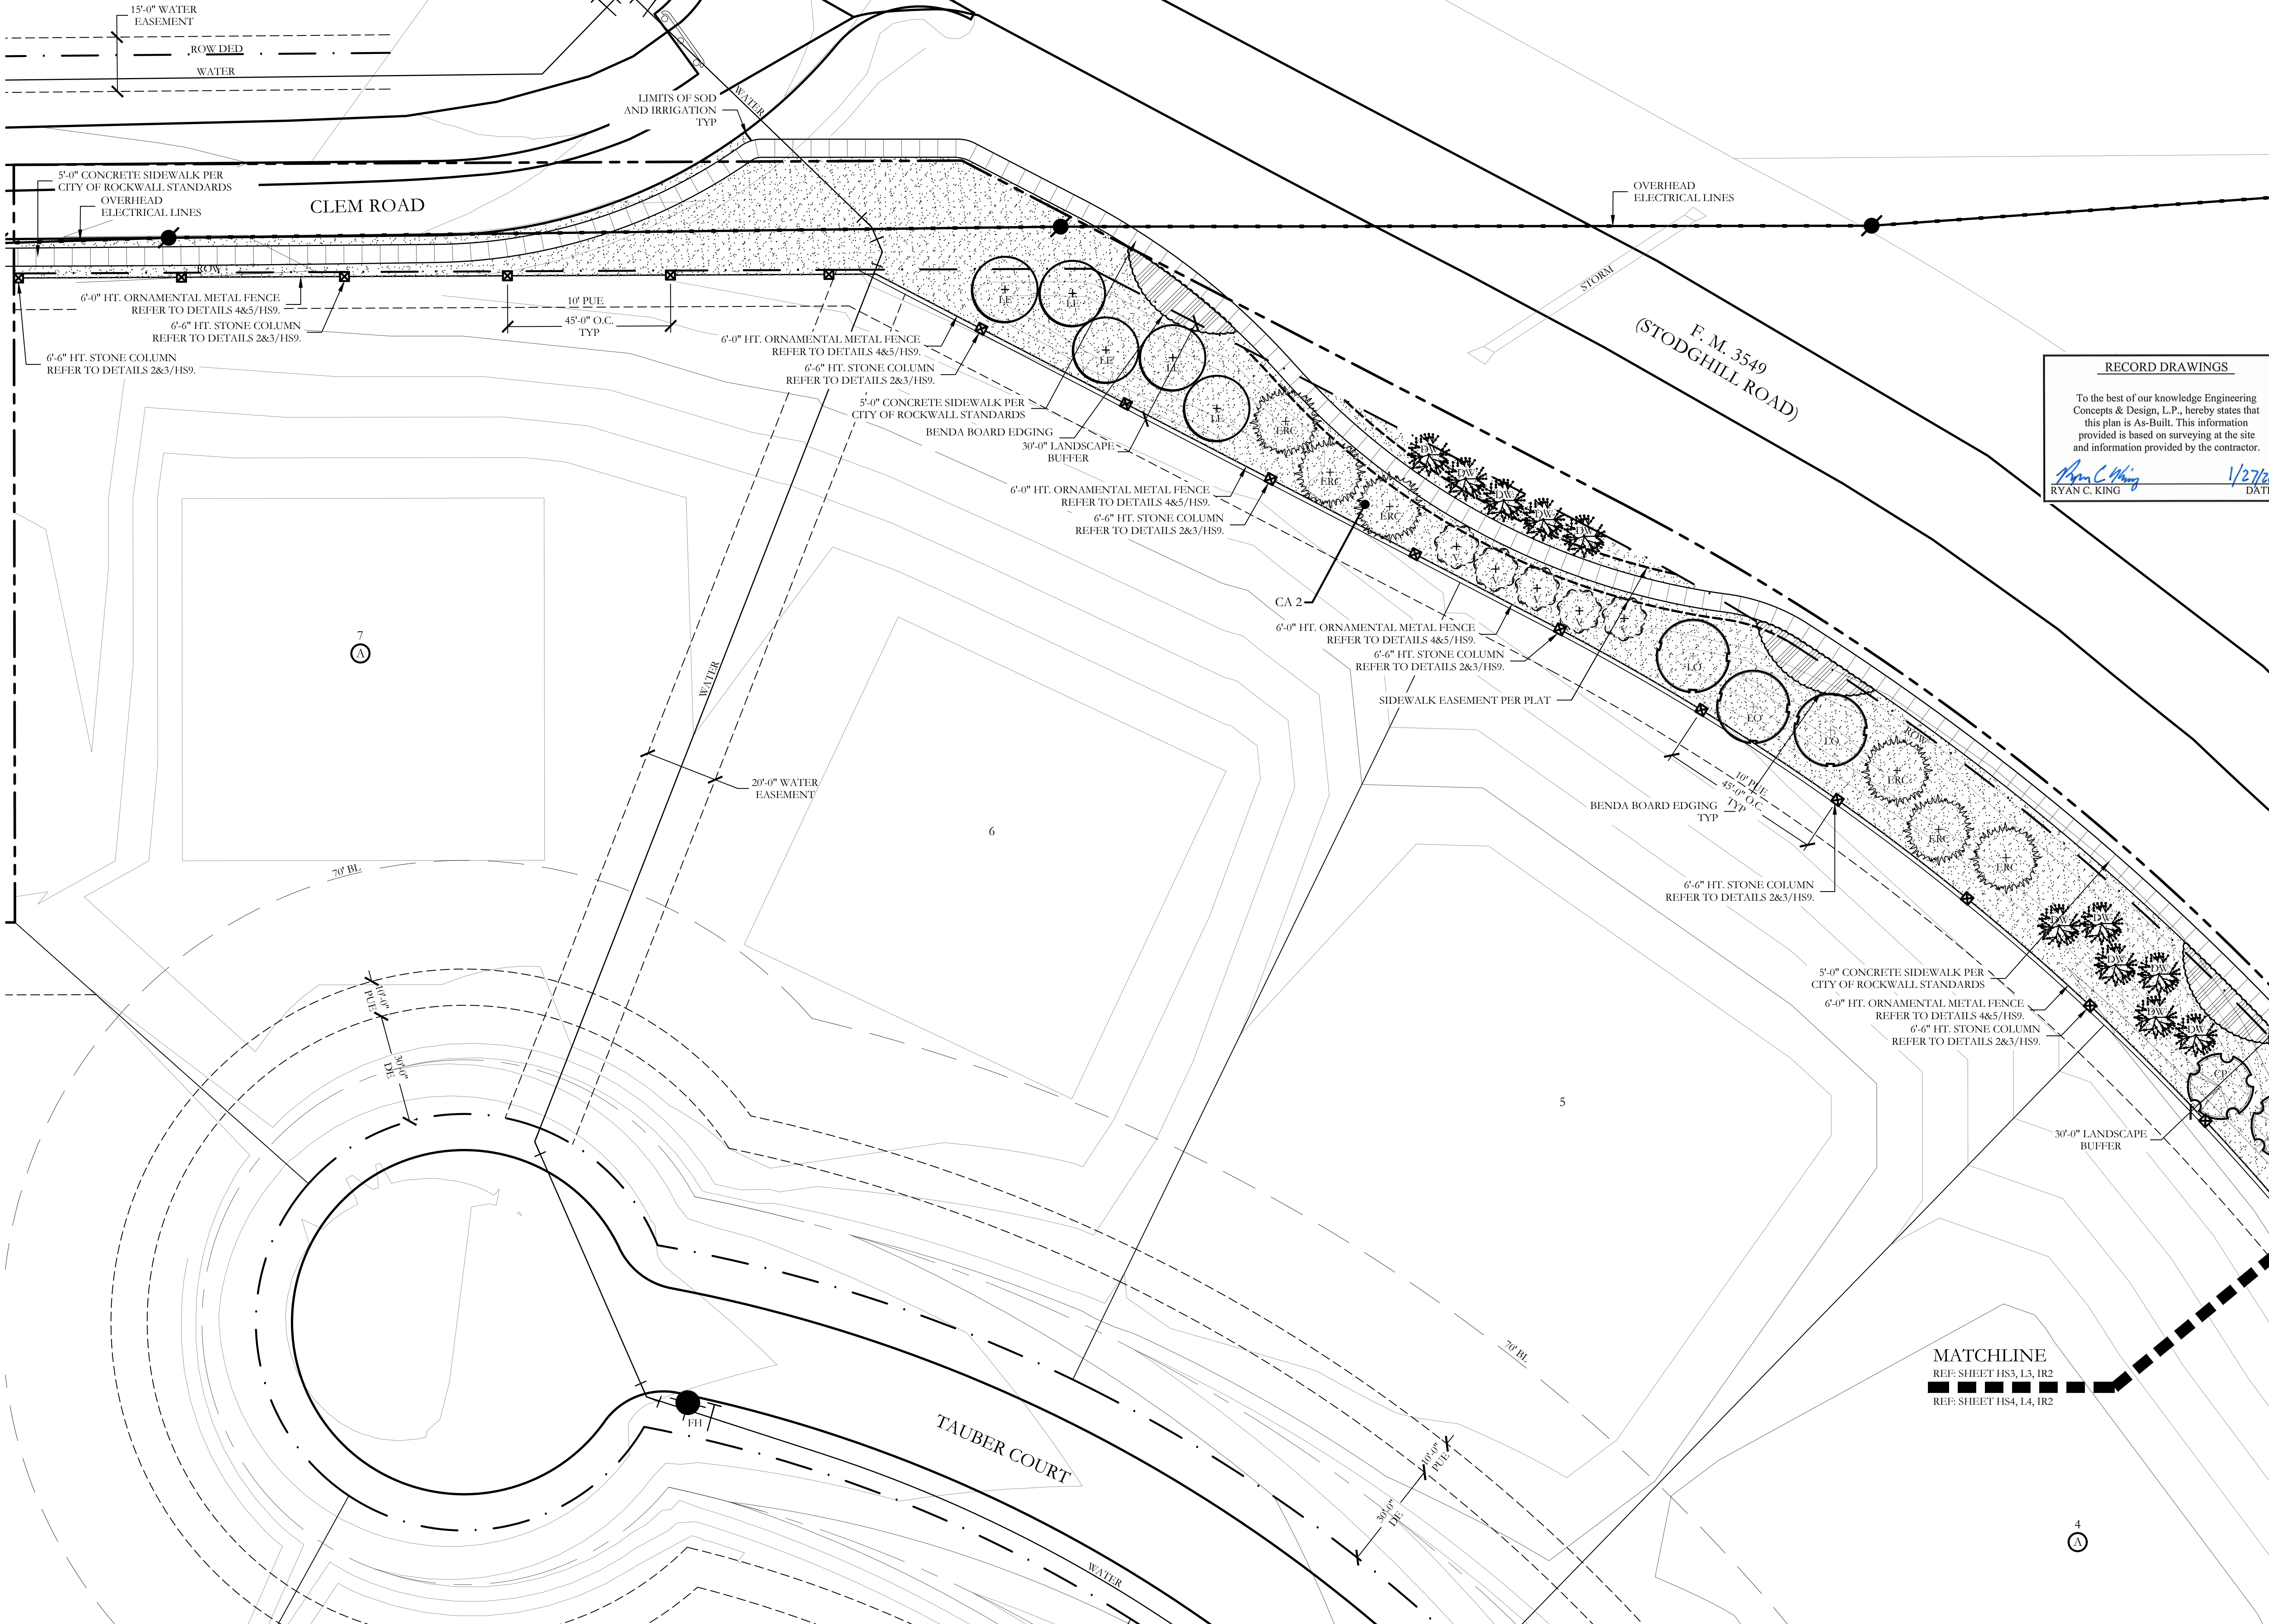

**RECORD DRAWINGS**

To the best of our knowledge Engineering Concepts & Design, L.P., hereby states that this plan is As-Built. This information provided is based on surveying at the site and information provided by the contractor.

*Ryan C. King*  
RYAN C. KING  
1/27/2021  
DATE

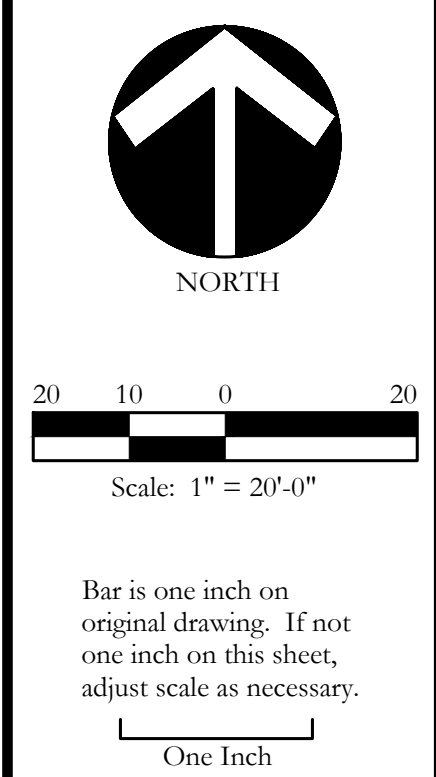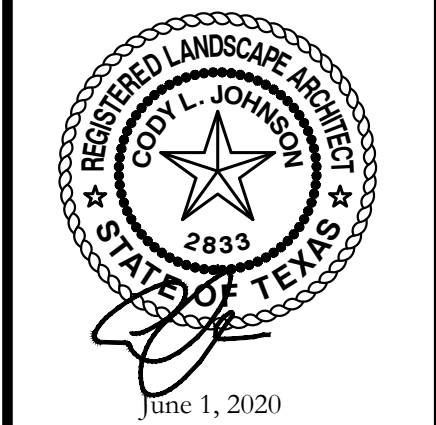


**SCREENING AND BUFFERING**

Landscape Plan

Northgate Phase 1


City of Rockwall, Tarrant County, Texas

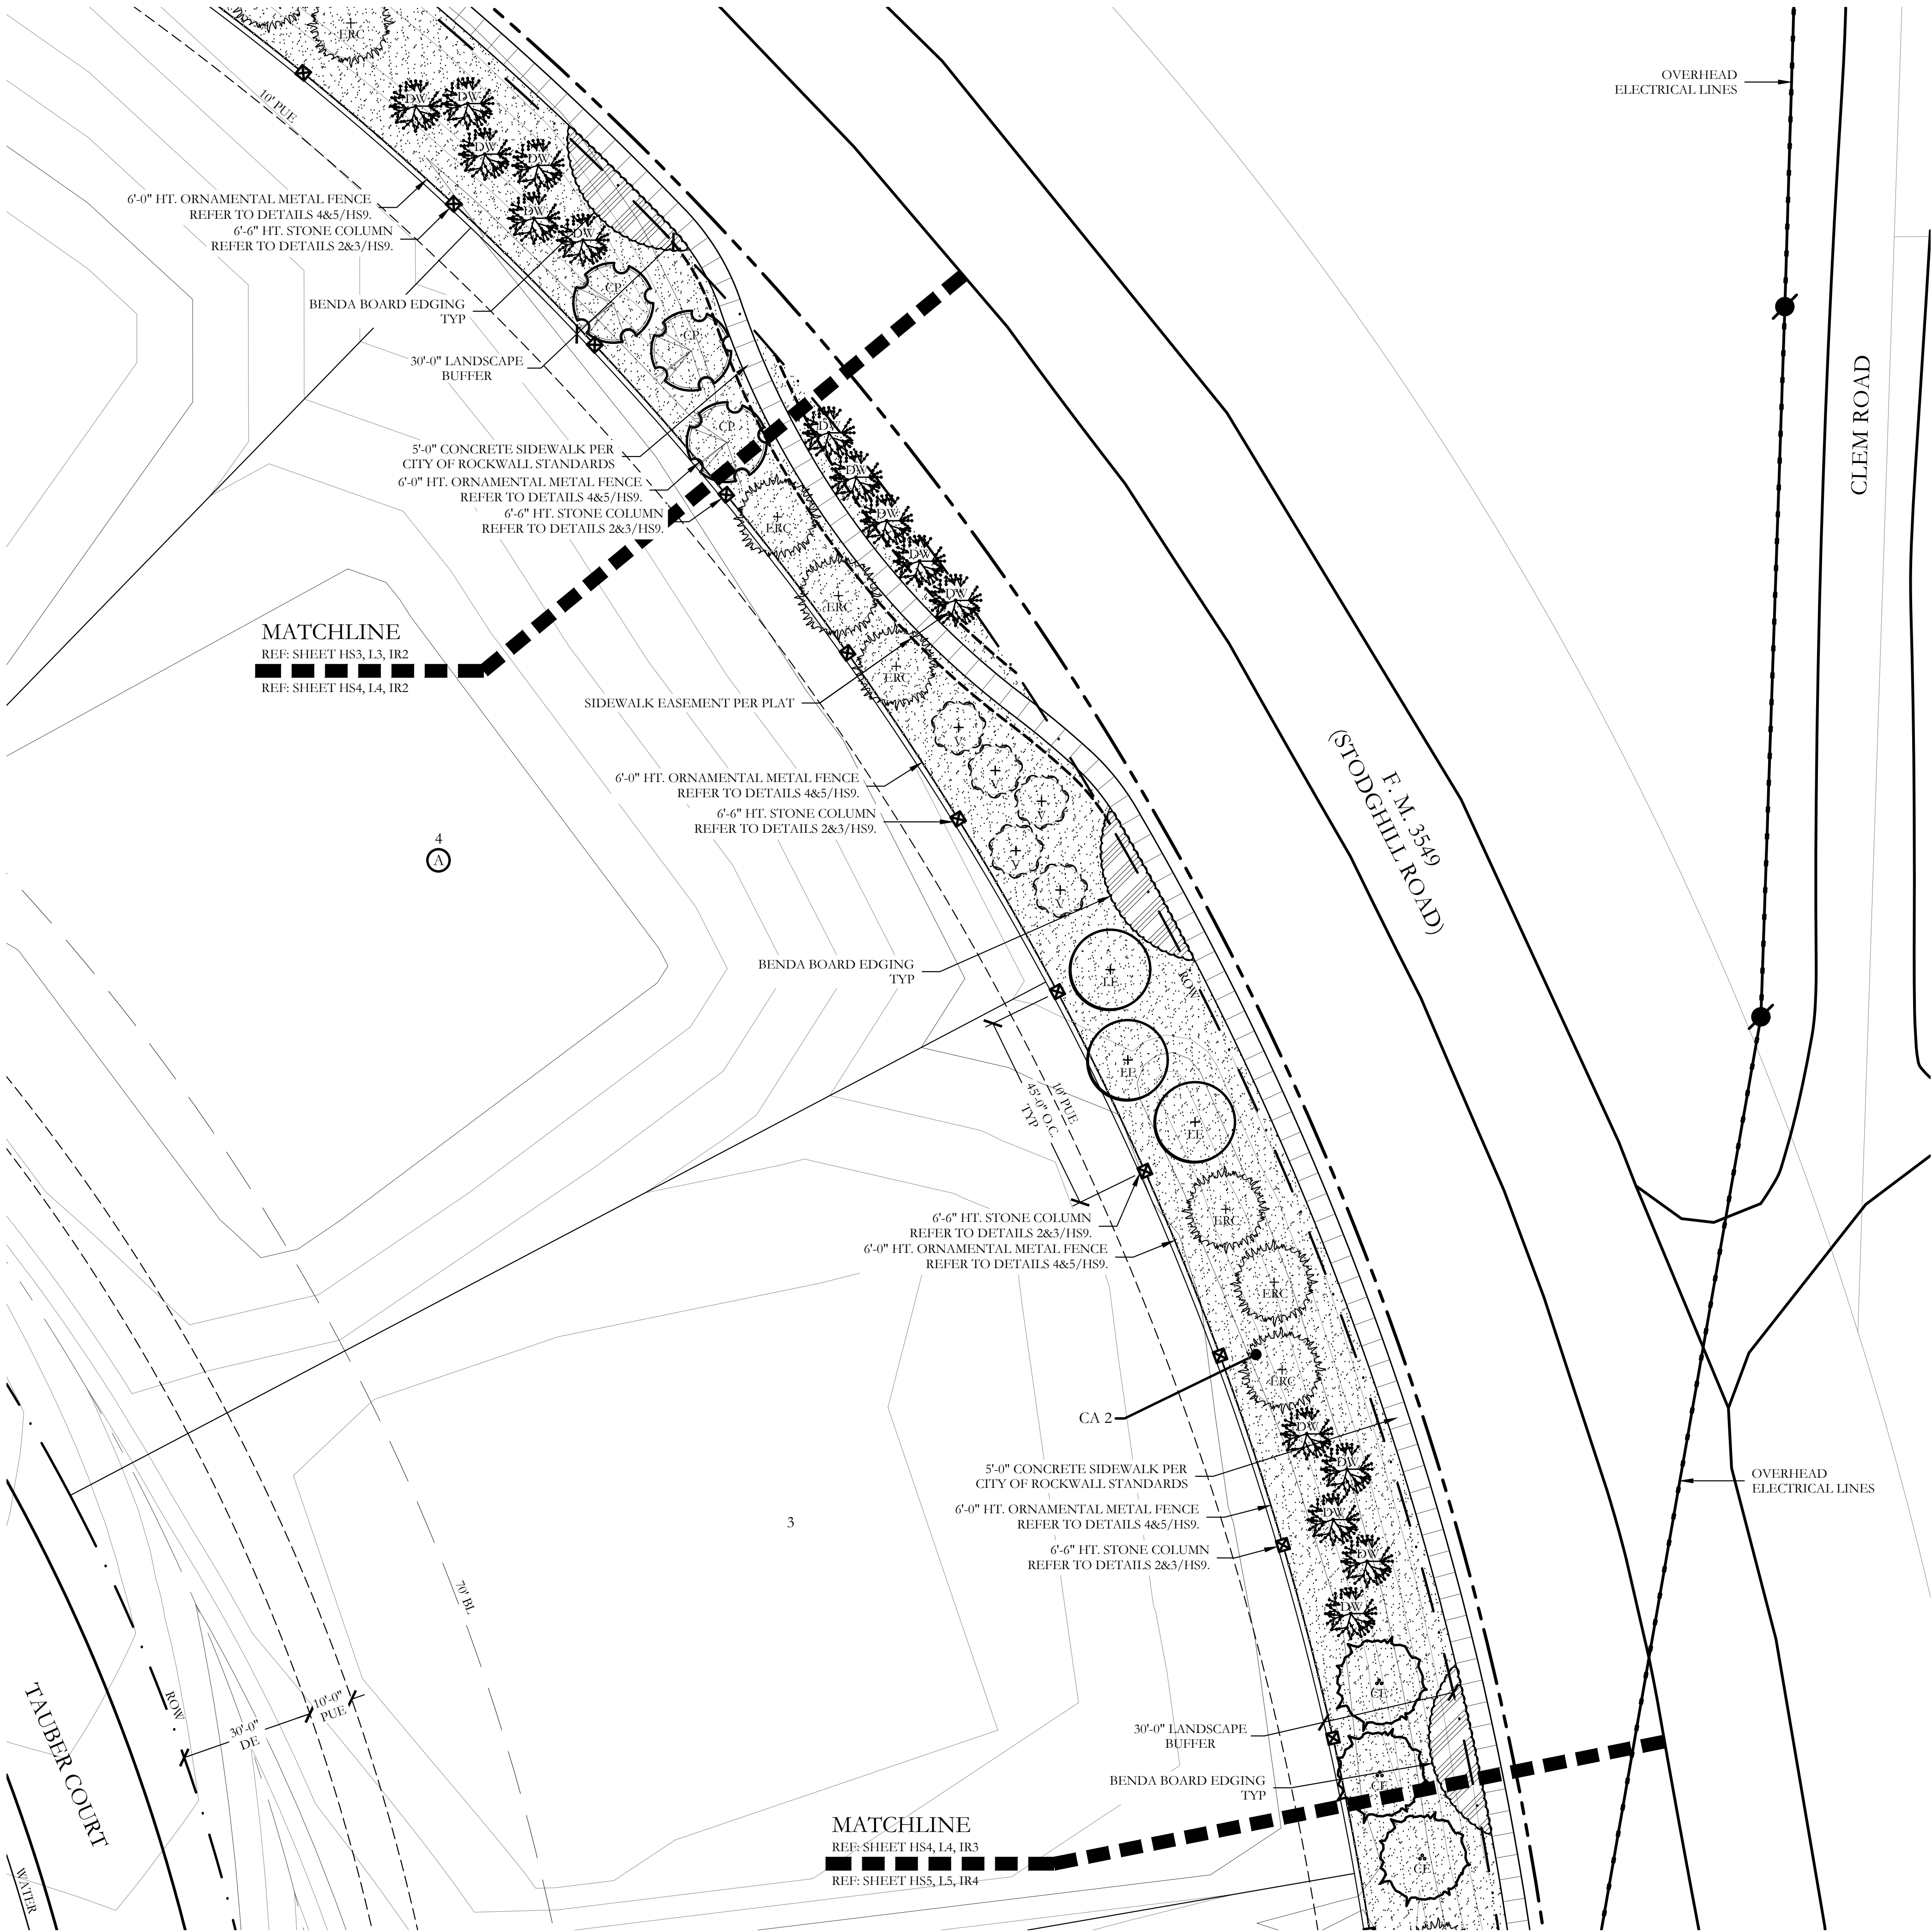


PLANT LEGEND					
SYMBOL	KEY	COMMON NAME	SCIENTIFIC NAME	SIZE	SPACING
	LO	LIVE OAK	QUERCUS VIRGINIANA	4" CALIPER	AS SHOWN
	LE	LACEBARK ELM	ULMUS PARVIFOLIA	4" CALIPER	AS SHOWN
	CP	CHINESE PISTACHE	PISTACIA CHINENSIS	4" CALIPER	AS SHOWN
	CE	CEDAR ELM	ULMUS CRASSIFOLIA	4" CALIPER	AS SHOWN
	ERC	EASTERN RED CEDAR AS PROVIDED BY OWNER	JUNIPERUS VIRGINIANA	MINIMUM 4" CALIPER	AS SHOWN
	V	CHASTE TREE	VITEX ANGUS-CASTUS	2" CALIPER	AS SHOWN
	DW	DESERT WILLOW	CHILOPSIS LINEARIS	2" CALIPER	AS SHOWN
	BA	BLUE ATLAS CEDAR	CEDRUS ATLANTICA 'GLAUCA'	2" CALIPER	AS SHOWN
		TEXAS SAGE	LEUCOPHYLLUM FRUTESCENS	5 GALLON	48" O.C.
		UPRIGHT ROSEMARY	ROSMARINUS OFFICINALIS 'UPRIGHT'	5 GALLON	36" O.C.
		MORNING LIGHT MISCANTHUS	MISCANTHUS SINENSIS 'MORNING LIGHT'	5 GALLON	36" O.C.
		GOLD STAR JUNIPER	JUNIPERUS CHINENSIS 'BAKAUREA'	5 GALLON	48" O.C.
		SHORE JUNIPER	JUNIPERUS CONFERTA 'BLUE PACIFIC'	5 GALLON	36" O.C.
		GULF MUHLY GRASS	MUHLENBERGIA CAPILLARIS 'REGAL MIST'	5 GALLON	36" O.C.
		COMMON BERMUDA GRASS	CYNODON DACTYLON	SQUARE FEET	SOLID SOD
		NATIVE DRAINFIELD SEED MIX	BY NATIVE AMERICAN SEED CO.	SQUARE FEET	HYDROMULCH

RECORD DRAWINGS

To the best of our knowledge Engineering Concepts & Design, L.P., hereby states that this plan is As-Built. This information provided is based on surveying at the site and information provided by the contractor.

 1/27/2021  
RYAN C. KING DATE

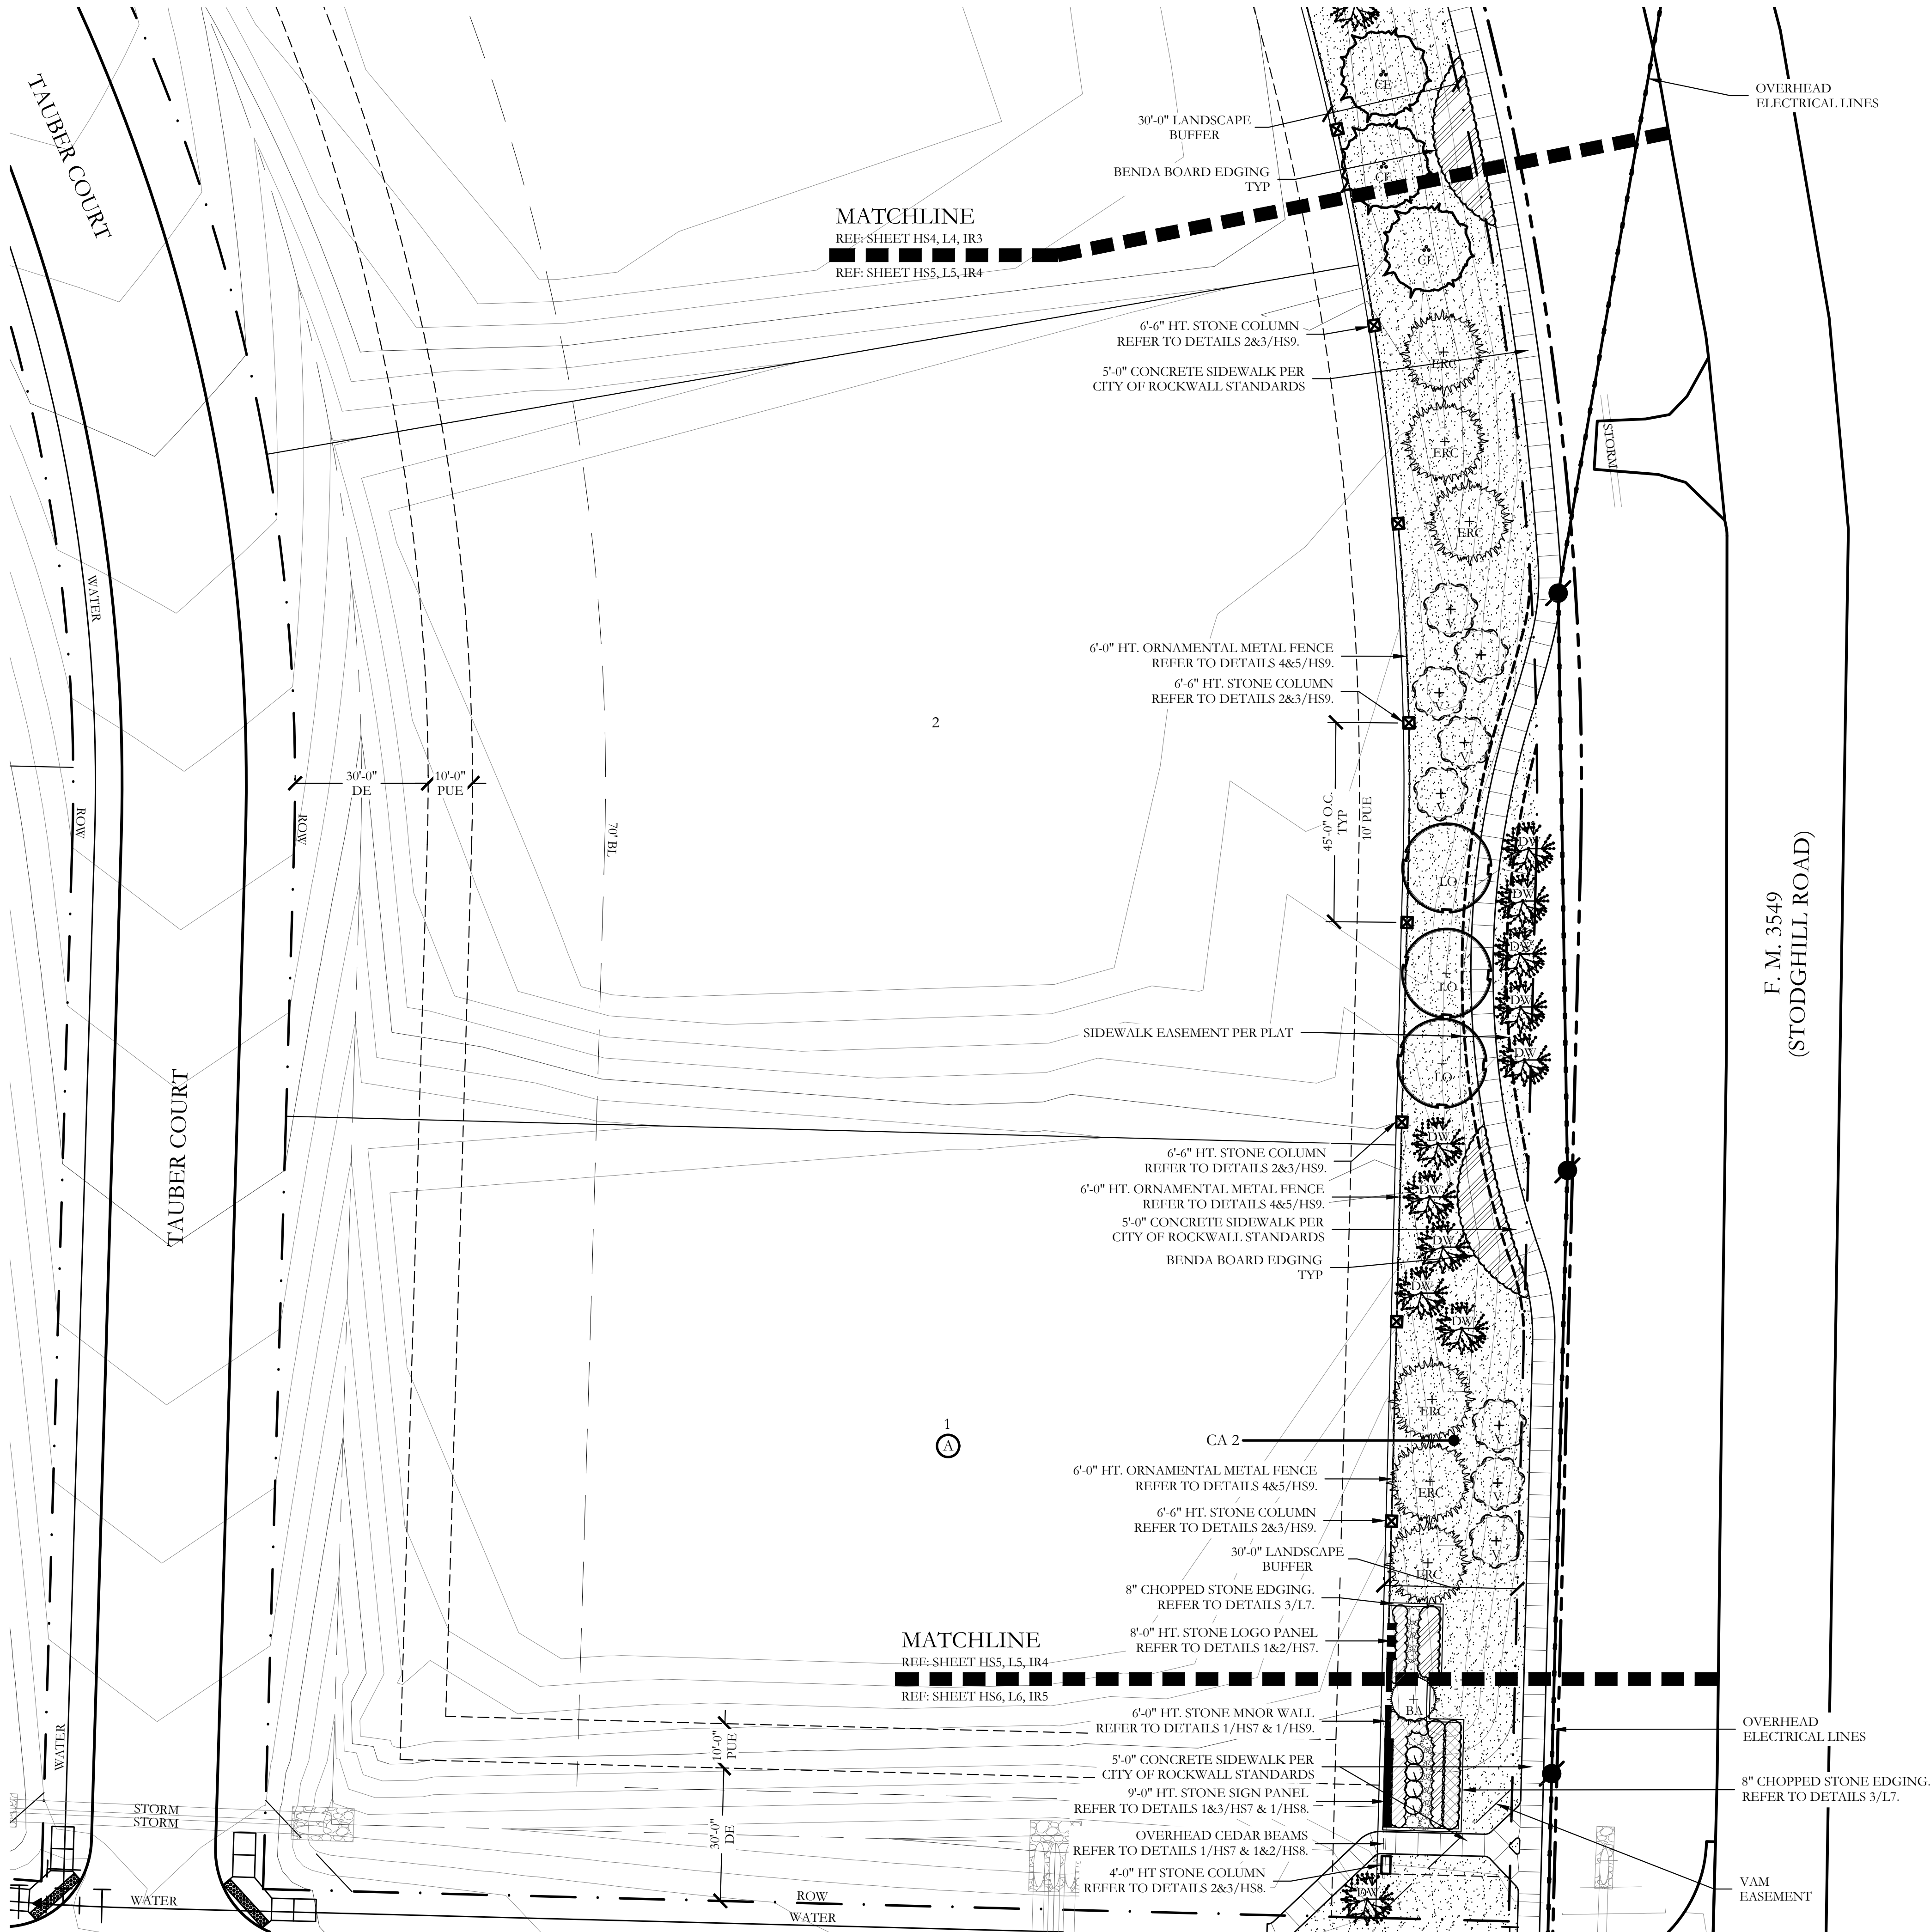

PLANT LEGEND					
SYMBOL	KEY	COMMON NAME	SCIENTIFIC NAME	SIZE	SPACING
	LO	LIVE OAK	QUERCUS VIRGINIANA	4" CALIPER	AS SHOWN
	LE	LACEBARK ELM	ULMUS PARVIFOLIA	4" CALIPER	AS SHOWN
	CP	CHINESE PISTACHE	PISTACIA CHINENSIS	4" CALIPER	AS SHOWN
	CE	CEDAR ELM	ULMUS CRASSIFOLIA	4" CALIPER	AS SHOWN
	ERC	EASTERN RED CEDAR AS PROVIDED BY OWNER	JUNIPERUS VIRGINIANA	MINIMUM 4" CALIPER	AS SHOWN
	V	CHASTE TREE	VITEX ANGUS-CASTUS	2" CALIPER	AS SHOWN
	DW	DESERT WILLOW	CHILOPSIS LINEARIS	2" CALIPER	AS SHOWN
	BA	BLUE ATLAS CEDAR	CEDRUS ATLANTICA 'GLAUCA'	2" CALIPER	AS SHOWN
		TEXAS SAGE	LEUCOPHYLLUM FRUTESCENS	5 GALLON	48" O.C.
		UPRIGHT ROSEMARY	ROSMARINUS OFFICINALIS 'UPRIGHT'	5 GALLON	36" O.C.
		MORNING LIGHT MISCANTHUS	MISCANTHUS SINENSIS 'MORNING LIGHT'	5 GALLON	36" O.C.
		GOLD STAR JUNIPER	JUNIPERUS CHINENSIS 'BAKAUREA'	5 GALLON	48" O.C.
		SHORE JUNIPER	JUNIPERUS CONFERTA 'BLUE PACIFIC'	5 GALLON	36" O.C.
		GULF MUHLY GRASS	MUHLENBERGIA CAPILLARIS 'REGAL MIST'	5 GALLON	36" O.C.
		COMMON BERMUDA GRASS	CYNODON DACTYLON	SQUARE FEET	SOLID SOD
		NATIVE DRAINFIELD SEED MIX	BY NATIVE AMERICAN SEED CO.	SQUARE FEET	HYDROMULCH

RECORD DRAWINGS

To the best of our knowledge Engineering Concepts & Design, L.P., hereby states that this plan is As-Built. This information provided is based on surveying at the site and information provided by the contractor.

*Ryan C. King* 1/27/2021  
RYAN C. KING DATE

CODY JOHNSON  
s.t.u.d.i.o

SCREENING AND BUFFERING

Landscape Plan

Northgate Phase 1


City of Rockwall, Tarrant County, Texas

CJS PROJECT NO.

MJP001

SHEET NO.

L4 of 6

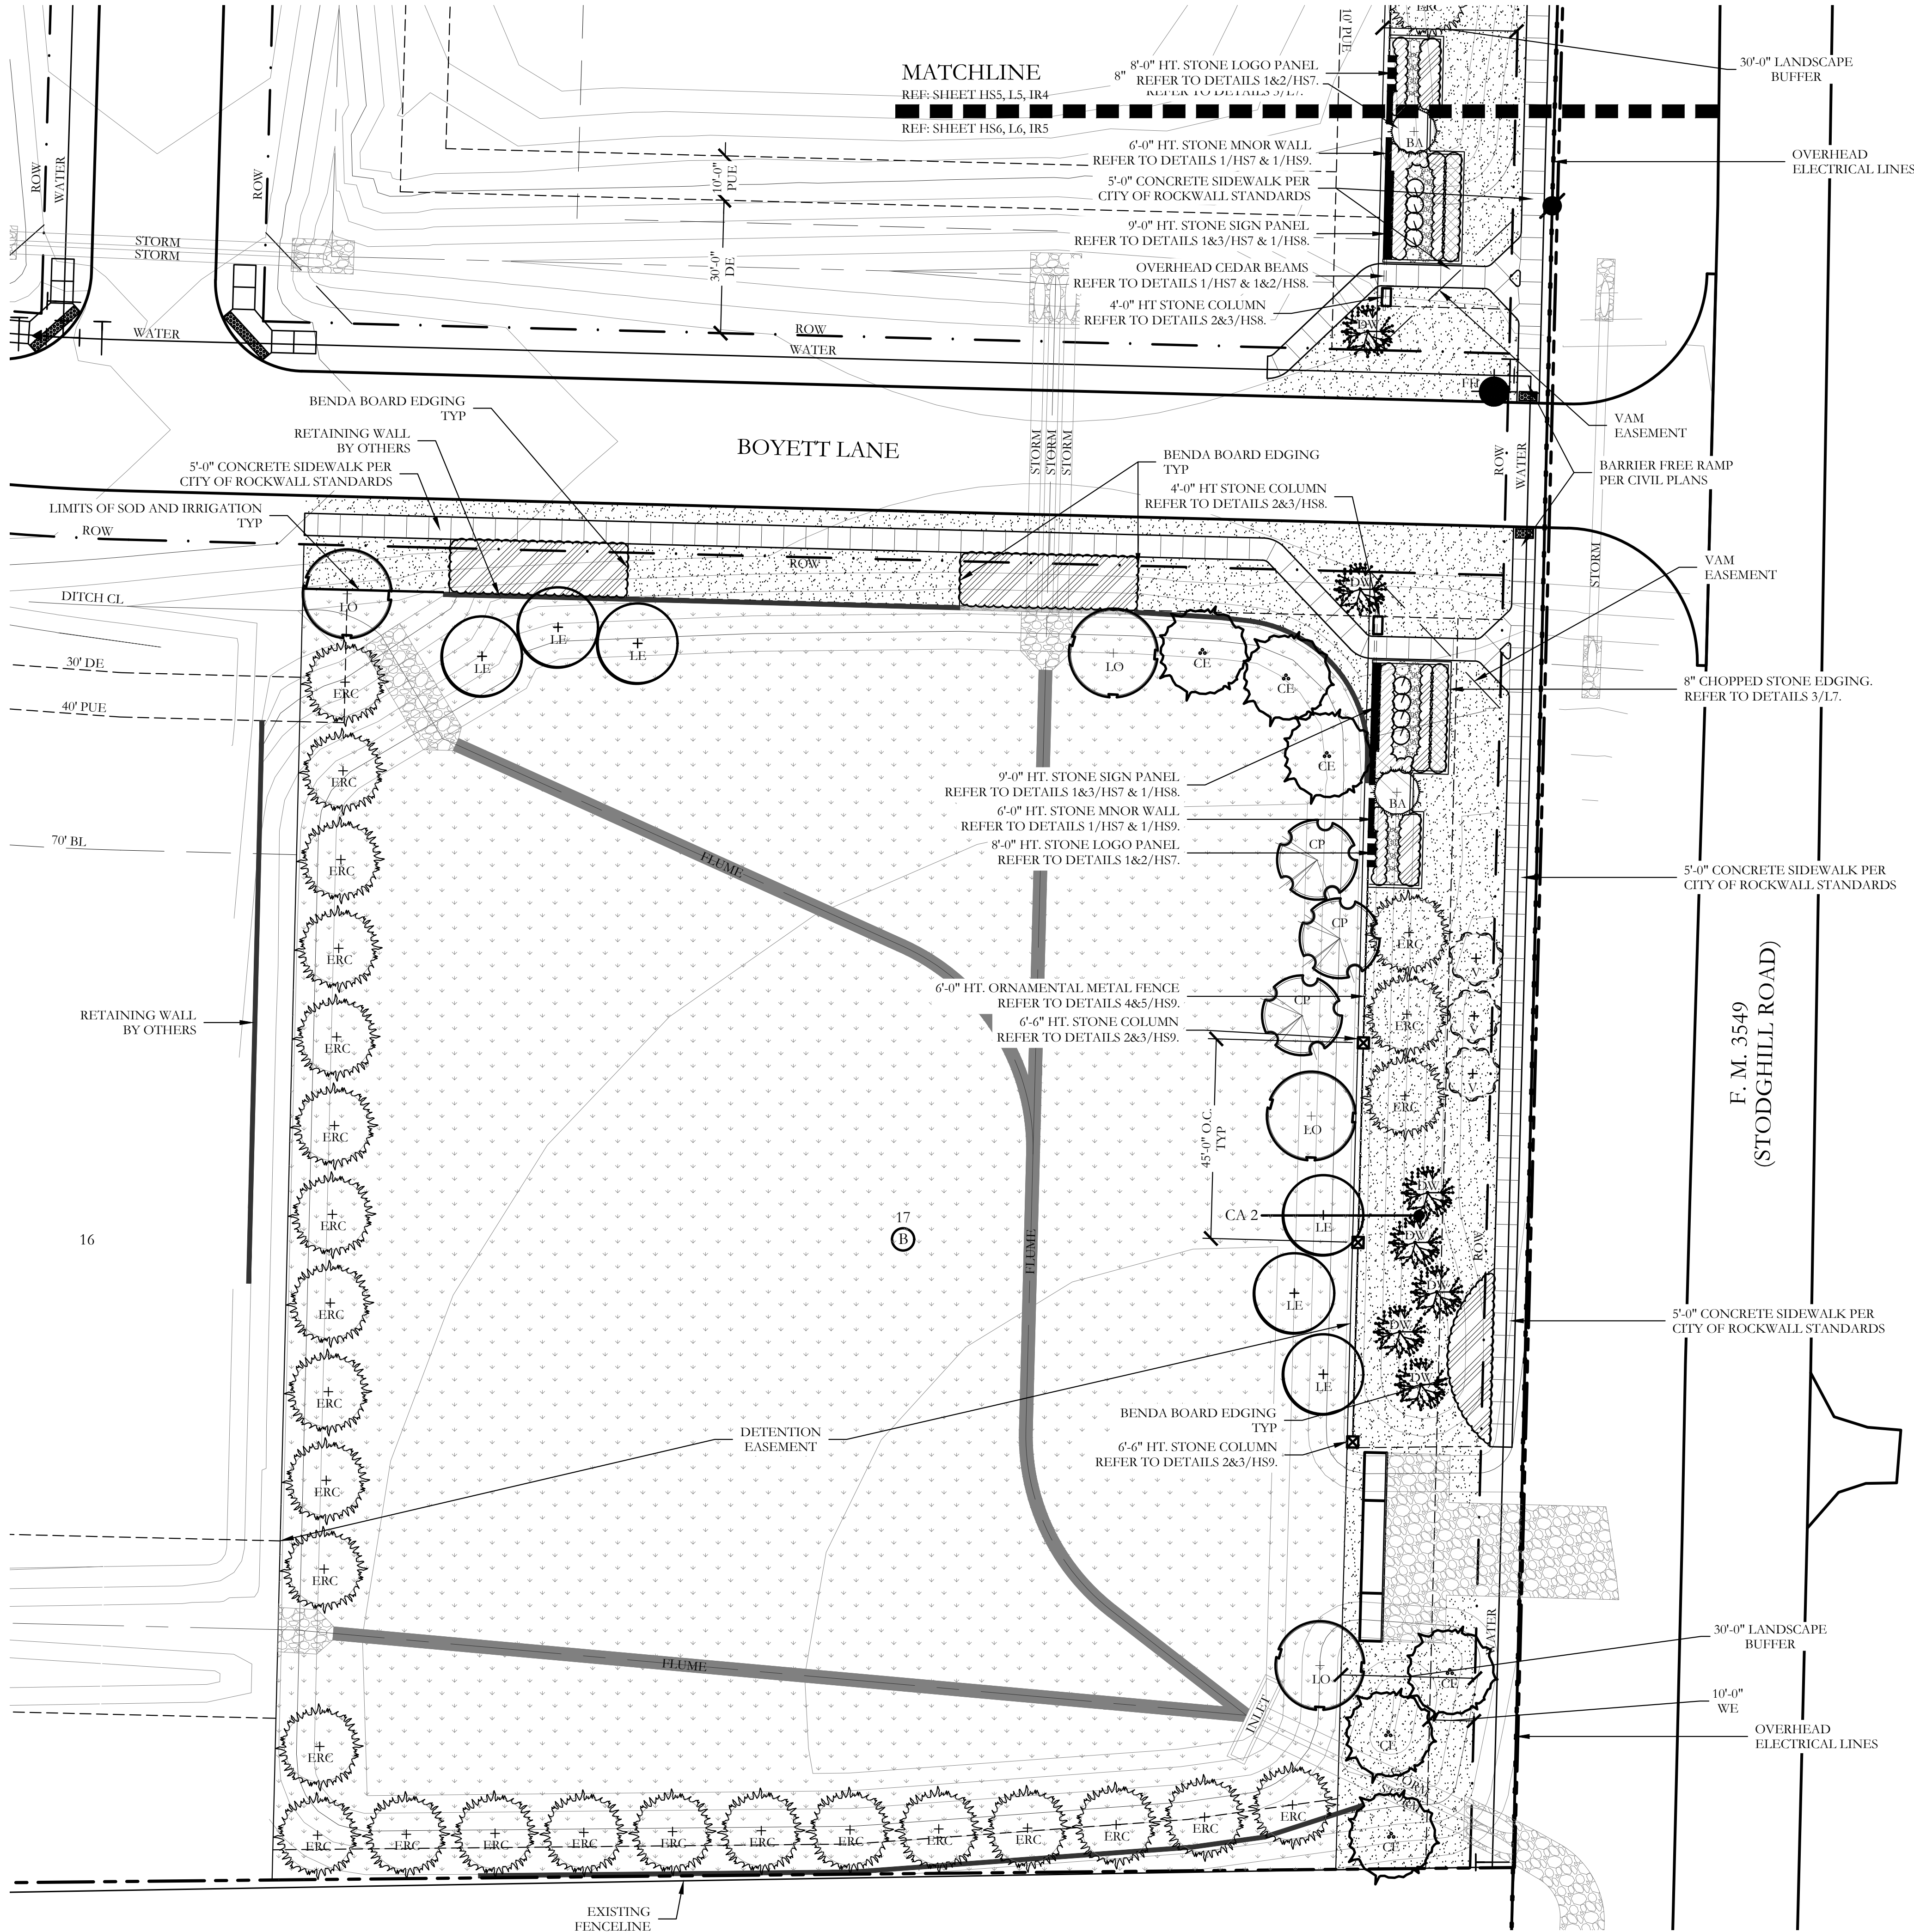

PLANT LEGEND					
SYMBOL	KEY	COMMON NAME	SCIENTIFIC NAME	SIZE	SPACING
	LO	LIVE OAK	QUERCUS VIRGINIANA	4" CALIPER	AS SHOWN
	LE	LACEBARK ELM	ULMUS PARVIFOLIA	4" CALIPER	AS SHOWN
	CP	CHINESE PISTACHE	PISTACIA CHINENSIS	4" CALIPER	AS SHOWN
	CE	CEDAR ELM	ULMUS CRASSIFOLIA	4" CALIPER	AS SHOWN
	ERC	EASTERN RED CEDAR AS PROVIDED BY OWNER	JUNIPERUS VIRGINIANA	MINIMUM 4" CALIPER	AS SHOWN
	V	CHASTE TREE	VITEX ANGUS-CASTUS	2" CALIPER	AS SHOWN
	DW	DESERT WILLOW	CHILOPSIS LINEARIS	2" CALIPER	AS SHOWN
	BA	BLUE ATLAS CEDAR	CEDRUS ATLANTICA 'GLAUCU'	2" CALIPER	AS SHOWN
		TEXAS SAGE	LEUCOPHYLLUM FRUTESCENS	5 GALLON	48" O.C.
		UPRIGHT ROSEMARY	ROSMARINUS OFFICINALIS 'UPRIGHT'	5 GALLON	36" O.C.
		MORNING LIGHT MISCANTHUS	MISCANTHUS SINENSIS 'MORNING LIGHT'	5 GALLON	36" O.C.
		GOLD STAR JUNIPER	JUNIPERUS CHINENSIS 'BAKAUREA'	5 GALLON	48" O.C.
		SHORE JUNIPER	JUNIPERUS CONFERTA 'BLUE PACIFIC'	5 GALLON	36" O.C.
		GULF MUHLY GRASS	MUHLENBERGIA CAPILLARIS 'REGAL MIST'	5 GALLON	36" O.C.
		COMMON BERMUDA GRASS	CYNODON DACTYLON	SQUARE FEET	SOLID SOD
		NATIVE DRAINFIELD SEED MIX	BY NATIVE AMERICAN SEED CO.	SQUARE FEET	HYDROMULCH

RECORD DRAWINGS

To the best of our knowledge Engineering Concepts & Design, L.P., hereby states that this plan is As-Built. This information provided is based on surveying at the site and information provided by the contractor.

RYAN C. KING

1/27/2021  
DATE

CODY JOHNSON  
s.t.u.d.i.o

NORTH

Scale: 1" = 20'-0"

Bar is one inch on original drawing. If not one inch on this sheet, adjust scale as necessary.  
One Inch

SCREENING AND BUFFERING

Landscape Plan

Northgate Phase 1

City of Rockwall, Tarrant County, Texas

CJS PROJECT NO.  
MJP001

SHEET NO.  
L5 of 6




- ## IRRIGATION LEGEND AND SCHEDULE

	←	PROGRAM AND STATION NUMBER FOR AUTOMATIC CONTROLLER
	←	VALVE SIZE IN INCHES
	←	GALLONS PER MINUTE, PER VALVE

REFER TO SHEET IR6 FOR FULL IRRIGATION LEGEND  
AND SCHEDULE

ZONE VALVES LABELED AS "OPEN" ARE INTENDED FOR THE USE OF SUPPLYING HUNTER AFB-ADJ TREE BUBBLERS ON EACH PROPOSED TREE. IRRIGATION CONTRACTOR SHALL FIELD VERIFY THAT THESE ZONES DO NOT EXCEED 20 GALLONS PER MINUTE. THE IRRIGATION CONTRACTOR SHALL STAKE EACH TREE BUBBLER HEAD LOCATION AND RECEIVE APPROVAL FROM THE OWNER AND/OR THE OWNER'S REPRESENTATIVE PRIOR TO INSTALLATION.

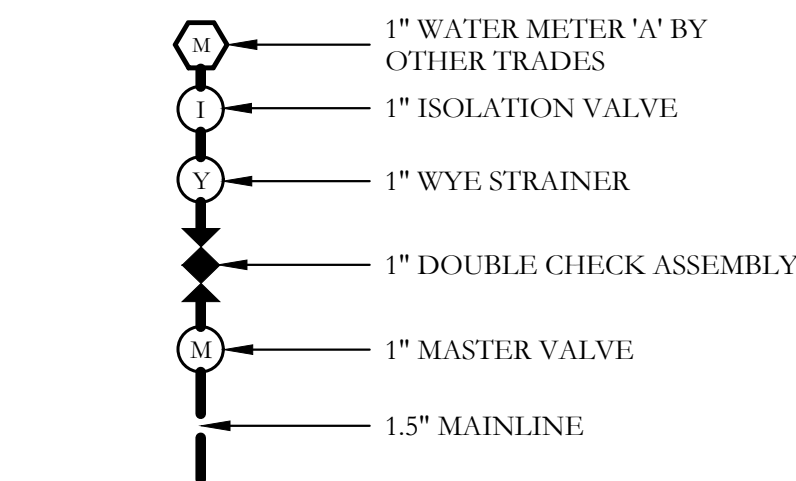

## 1 BACKFLOW AND RELATED COMPONENTS

## RECORD DRAWINGS

To the best of our knowledge Engineering Concepts & Design, L.P., hereby states that this plan is As-Built. This information provided is based on surveying at the site and information provided by the contractor.

*Ryan C King*  
RYAN C. KING


1/27/2021  
DATE

 **CODY JOHNSON**  
s.t.u.d.i.o

9720 COTT ROAD SUITE 220-333 PLANO, TEXAS 75025  
PH: (936) 570-0162  
EMAIL: [CODY@CODYJOHNSONSTUDIO.COM](mailto:CODY@CODYJOHNSONSTUDIO.COM)



December 7, 2020

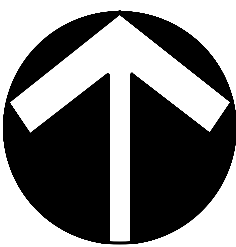

Bar is one inch on original drawing. If not one inch on this sheet, adjust scale as necessary

One Inch

# SCREENING AND BUFFERING

## Irrigation Plan

# Northgate Phase 1

City of Rockwall, Tarrant County, Texas




CJS PROJECT NO.

MJP001

SHEET NO.

IR1 of 7

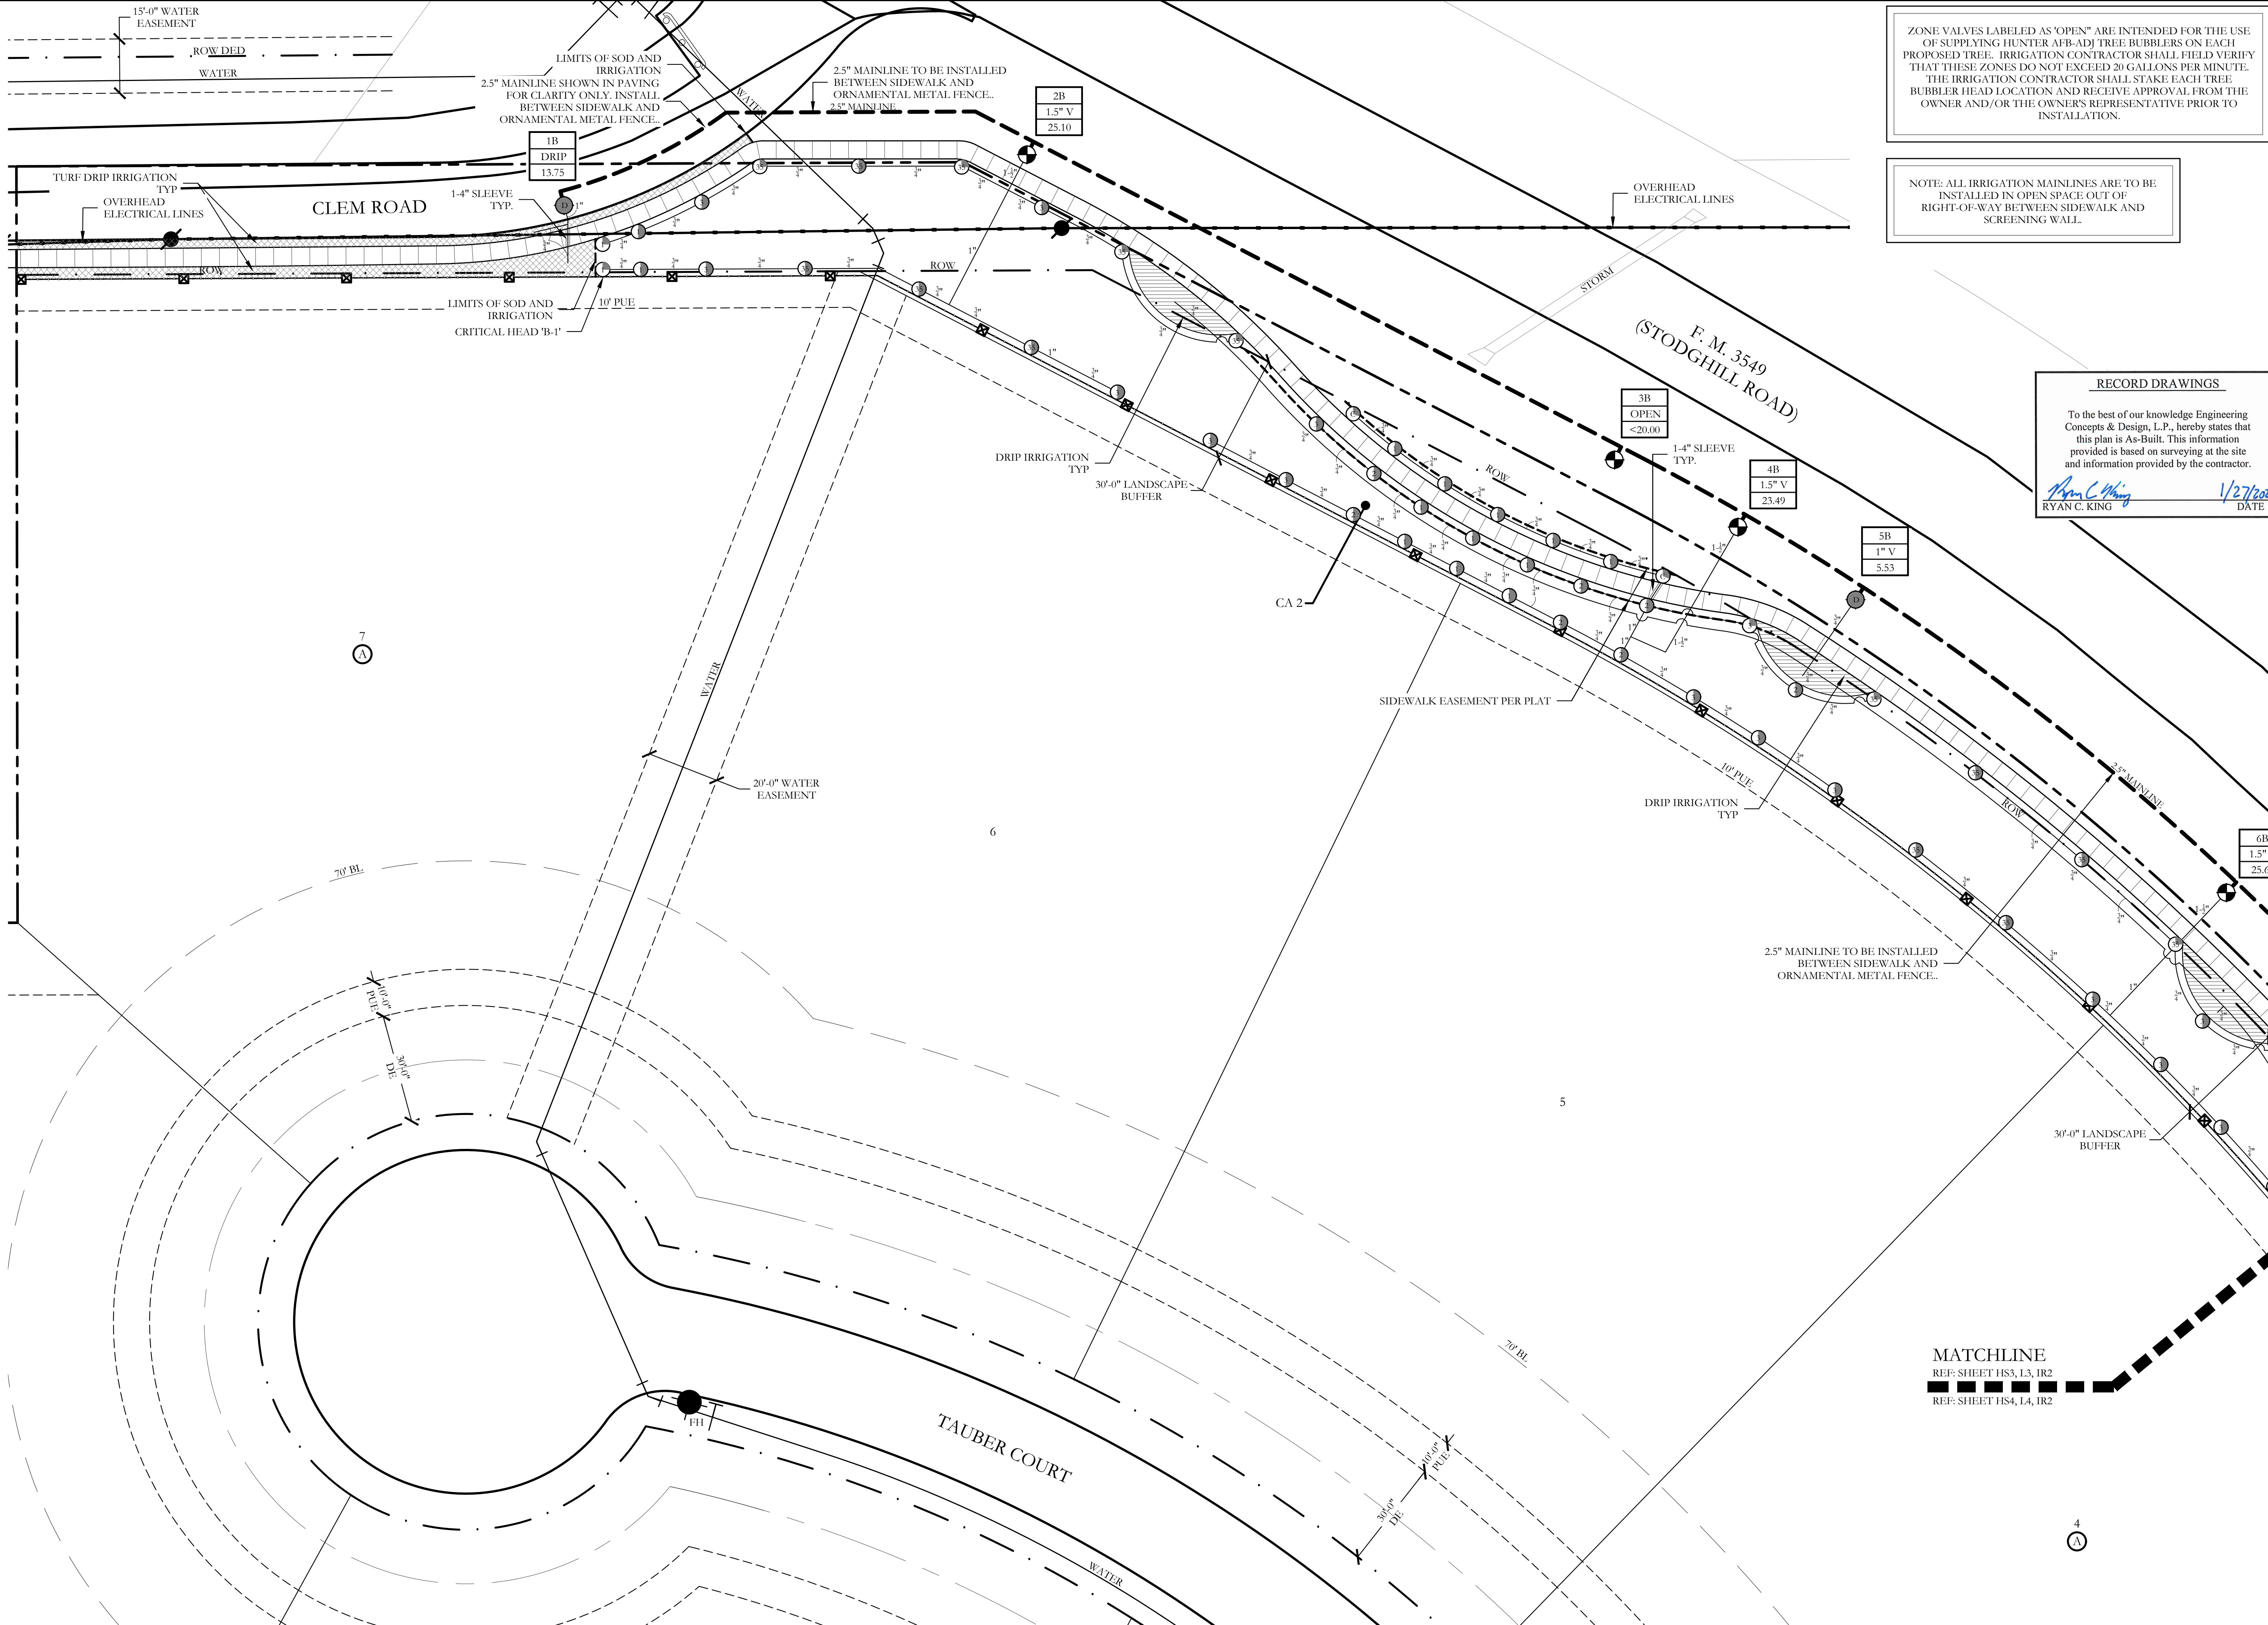

ZONE VALVES LABELED AS "OPEN" ARE INTENDED FOR THE USE OF SUPPLYING HUNTER AFB-ADJ TREE BUBBLERS ON EACH PROPOSED TREE. IRRIGATION CONTRACTOR SHALL FIELD VERIFY THAT THESE ZONES DO NOT EXCEED 20 GALLONS PER MINUTE. THE IRRIGATION CONTRACTOR SHALL STAKE EACH TREE BUBBLER HEAD LOCATION AND RECEIVE APPROVAL FROM THE OWNER AND/OR THE OWNER'S REPRESENTATIVE PRIOR TO INSTALLATION.

NOTE: ALL IRRIGATION MAINLINES ARE TO BE INSTALLED IN OPEN SPACE OUT OF RIGHT-OF-WAY BETWEEN SIDEWALK AND SCREENING WALL.

**RECORD DRAWINGS**  
To the best of our knowledge Engineering Concepts & Design, L.P., hereby states that this plan is As-Built. This information provided is based on surveying at the site and information provided by the contractor.  
*Ryan C. King* 1/27/2021  
RYAN C. KING DATE

**CODY JOHNSON**  
s.t.u.d.i.o

9720 COTT ROAD SUITE 220-333 PLANO, TEXAS 75025  
PH: (972) 570-0162  
EMAIL: CODY@CODYJOHNSONSTUDIO.COM


STATE OF TEXAS  
CODY L. JOHNSON  
17132  
REGISTERED PROFESSIONAL ENGINEER  
December 7, 2020

NORTH

20 10 0 20  
Scale: 1" = 20'-0"

Bar is one inch on original drawing. If not one inch on this sheet, adjust scale as necessary.  
One Inch

**SCREENING AND BUFFERING**  
Irrigation Plan  
Northgate Phase 1  
City of Rockwall, Tarrant County, Texas

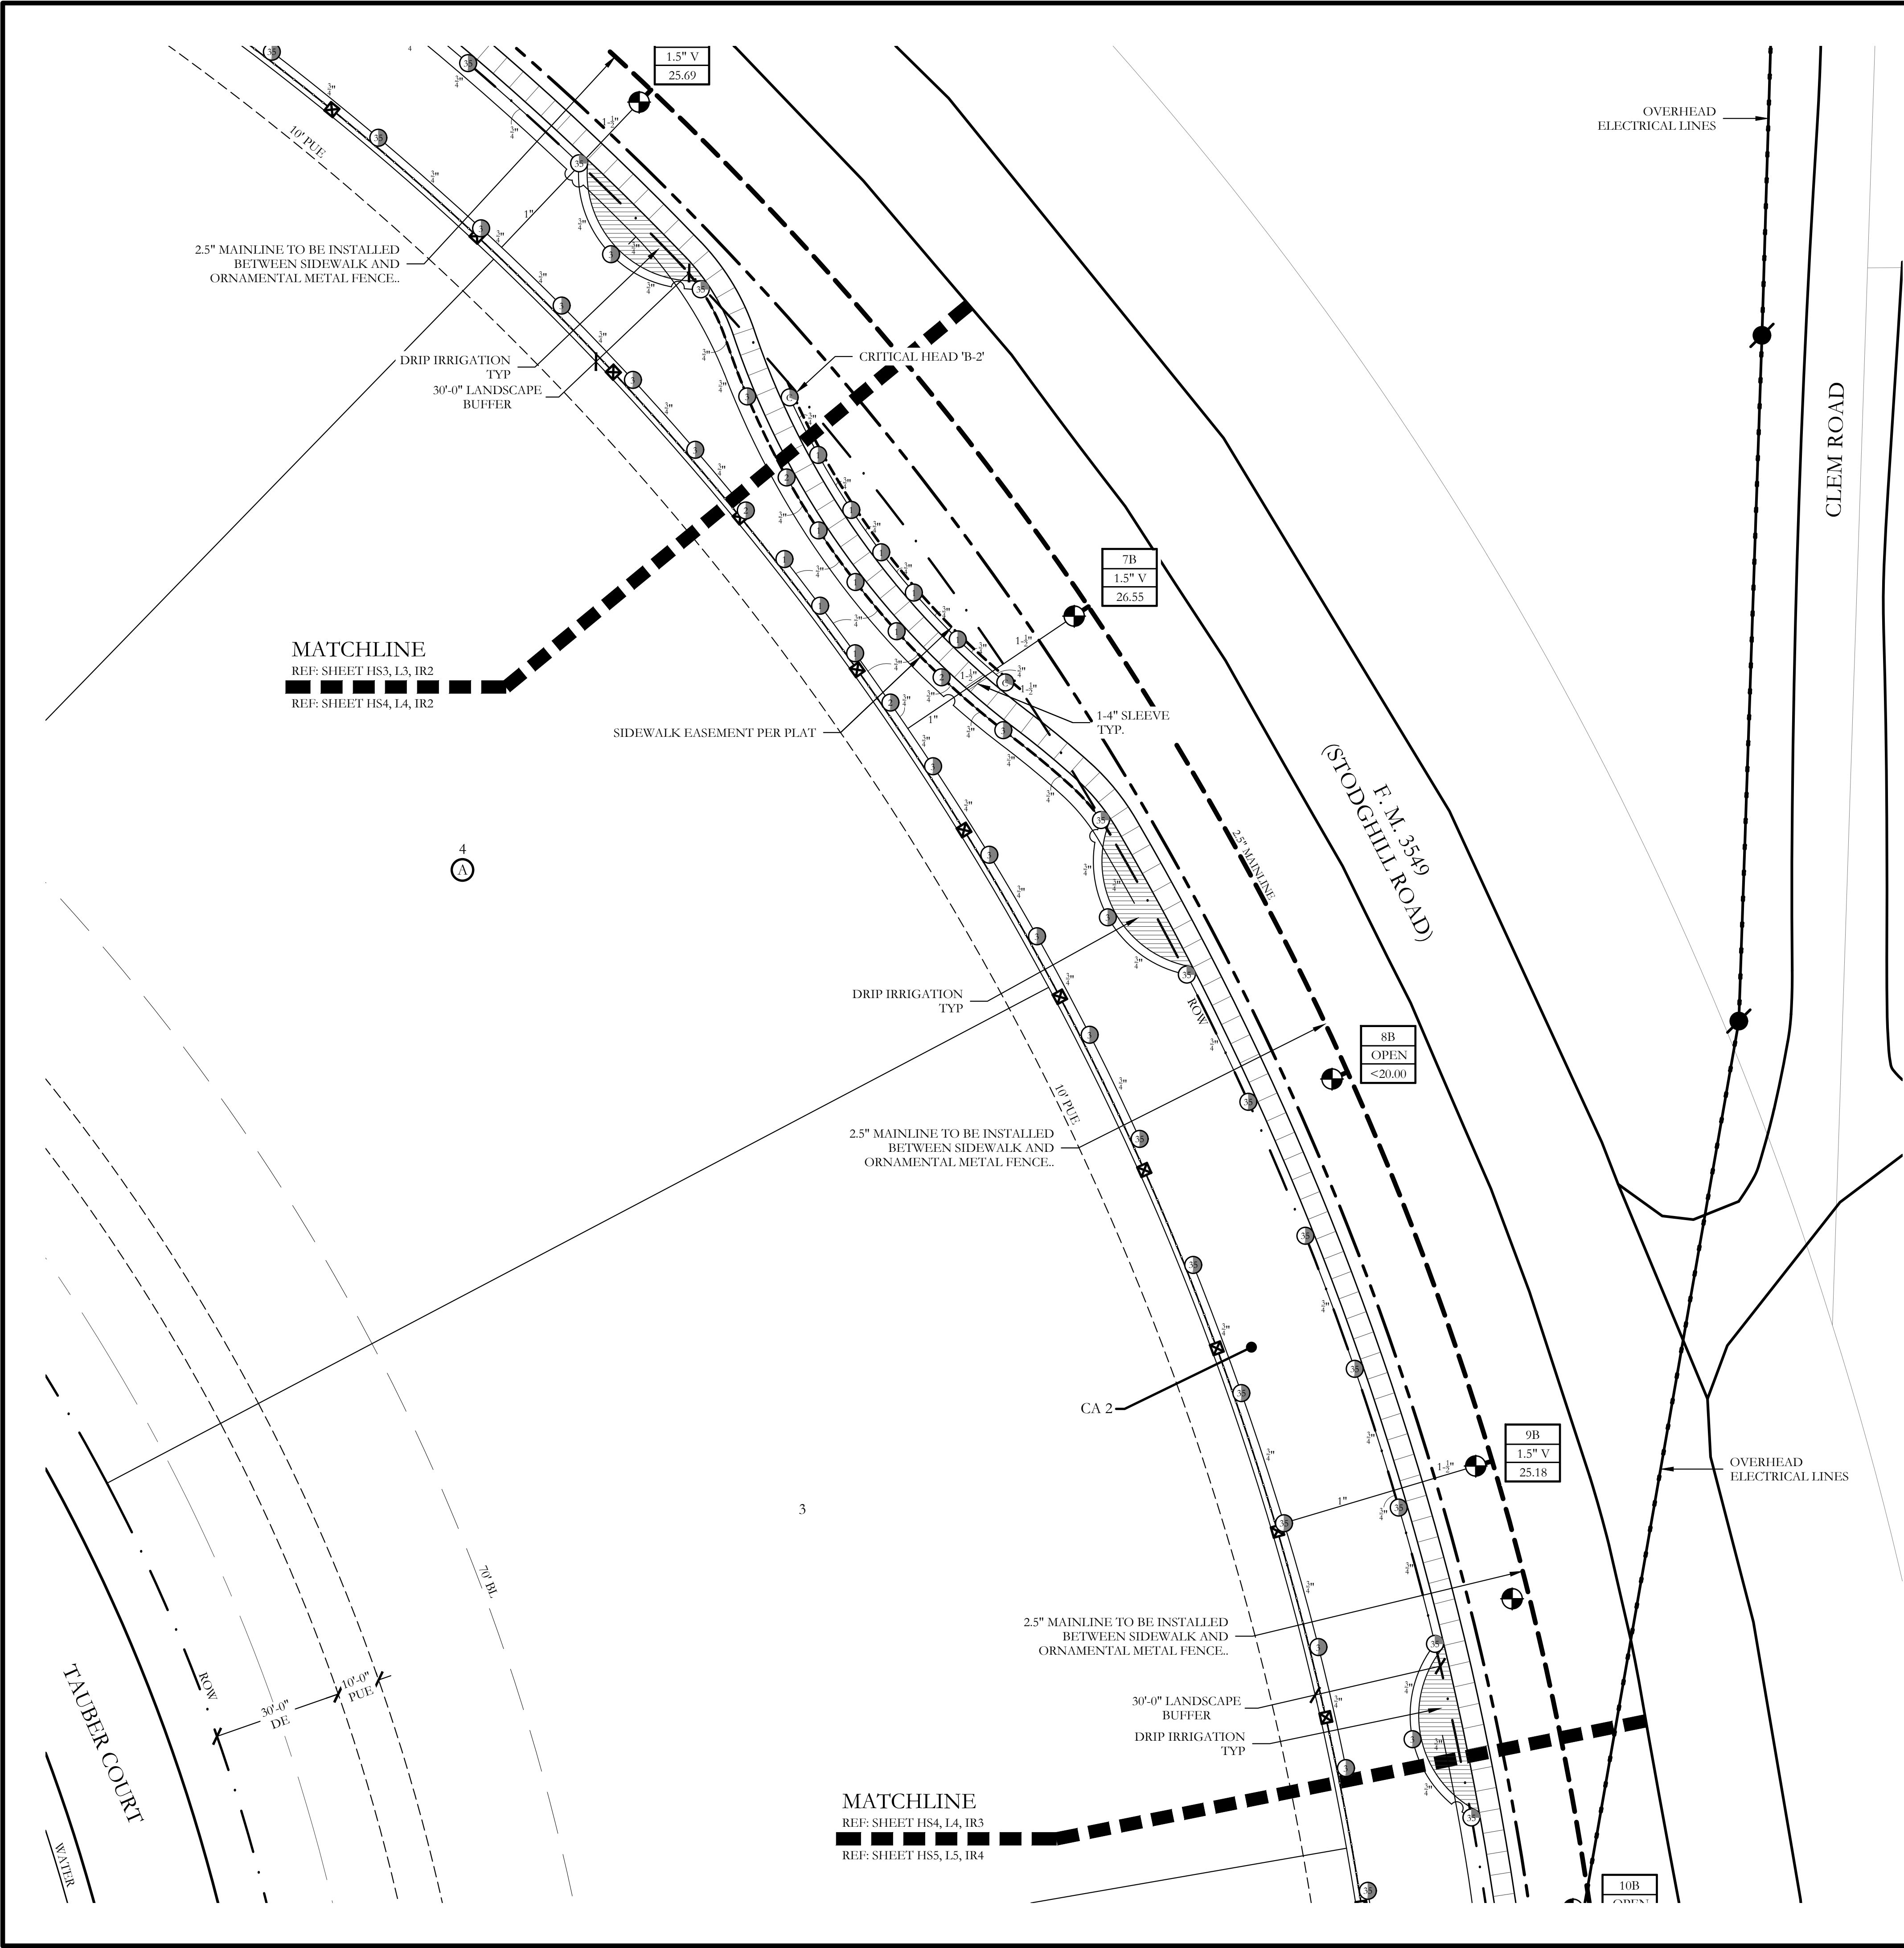

IRRIGATION LEGEND AND SCHEDULE

SYM	DESCRIPTION	MANUFACTURER	MODEL	SIZE / NOZZLE
	AUTOMATIC CONTROLLER	HUNTER	REFER TO PLANS	N/A
	DRIP IRRIGATION CONTROL VALVE	HUNTER	ICZ-101	1"
	DRIP IRRIGATION (LANDSCAPE BEDS)	HUNTER	PLD-06-18	N/A
	DRIP IRRIGATION (TURF BEDS)	HUNTER	PLD-06-12	N/A
	TEMPORARY IRRIGATION	N/A	N/A	N/A
	DRIP IRRIGATION	HUNTER	AFB-ADJ BUBBLER (0.5 GPM EACH BUBBLER)	1/2"
	REMOTE CONTROL VALVE	HUNTER	ICV-101G ICV-151G	REFER TO PLAN FOR SIZE
	LAWN MP ROTATOR	HUNTER	MP ROTATOR	MP1000, MP2000, MP3000, MP3500
	4" POP UP MP ROTATOR CORNER STRIP	HUNTER	STRIP SERIES	MP1C315 IVORY MPRC3515 COPPER MPRS530 BROWN
	4" POP UP MP ROTATOR CORNER	HUNTER	CORNER SERIES	MP CORNER SERIES ADJUSTABLE ARC 8-15"
	WATER METER	----	PER CITY	REFER TO PLAN FOR SIZE
	DOUBLE CHECK VALVE	FEBCO	850-BV Series	REFER TO PLAN FOR SIZE
	ISOLATION VALVE	NIBCO	*T-113	LINE SIZE
	WYE STRAINER	FEBCO	*850	REFER TO PLAN FOR SIZE
	MASTER VALVE	HUNTER	ICV-101G ICV-151G	REFER TO PLAN FOR SIZE
	IRRIGATION SLEEVE	----	SCH. 40 w/ 12 GA. PULL WIRE IN SLEEVE	REFER TO PLAN FOR SIZE
	IRRIGATION MAIN LINE	----	SCH. 40	REFER TO PLAN FOR SIZE
	IRRIGATION LATERAL LINE	----	CLASS 200	REFER TO PLAN FOR SIZE

	PROGRAM AND STATION NUMBER FOR AUTOMATIC CONTROLLER
	VALVE SIZE IN INCHES
	GALLONS PER MINUTE, PER VALVE

REFER TO SHEET IR6 FOR FULL IRRIGATION LEGEND AND SCHEDULE

NOTE: ALL LATERAL LINES SHALL BE 3/4" CLASS 200 PVC UNLESS OTHERWISE NOTED ON PLANS.

ZONE VALVES LABELED AS "OPEN" ARE INTENDED FOR THE USE OF SUPPLYING HUNTER AFB-ADJ TREE BUBBLERS ON EACH PROPOSED TREE. IRRIGATION CONTRACTOR SHALL FIELD VERIFY THAT THESE ZONES DO NOT EXCEED 20 GALLONS PER MINUTE. THE IRRIGATION CONTRACTOR SHALL STAKE EACH TREE BUBBLER HEAD LOCATION AND RECEIVE APPROVAL FROM THE OWNER AND/OR THE OWNER'S REPRESENTATIVE PRIOR TO INSTALLATION.

NOTE: ALL IRRIGATION MAINLINES ARE TO BE INSTALLED IN OPEN SPACE OUT OF RIGHT-OF-WAY BETWEEN SIDEWALK AND SCREENING WALL.

RECORD DRAWINGS  
To the best of our knowledge Engineering Concepts & Design, L.P., hereby states that this plan is As-Built. This information provided is based on surveying at the site and information provided by the contractor.  
*Ryan C. King*  
RYAN C. KING  
1/27/2021  
DATE

CODY JOHNSON  
s.t.u.d.i.o

9720 COTT ROAD SUITE 220-333 PLANO, TEXAS 75025  
PH: (972) 570-0162  
EMAIL: CODY@CODYJOHNSONSTUDIO.COM

December 7, 2020

NORTH

Scale: 1" = 20'-0"

Bar is one inch on original drawing. If not one inch on this sheet, adjust scale as necessary.

One Inch

SCREENING AND BUFFERING

Irrigation Plan


Northgate Phase 1

City of Rockwall, Tarrant County, Texas

CJS PROJECT NO.  
MJP001

SHEET NO.  
IR3 of 7



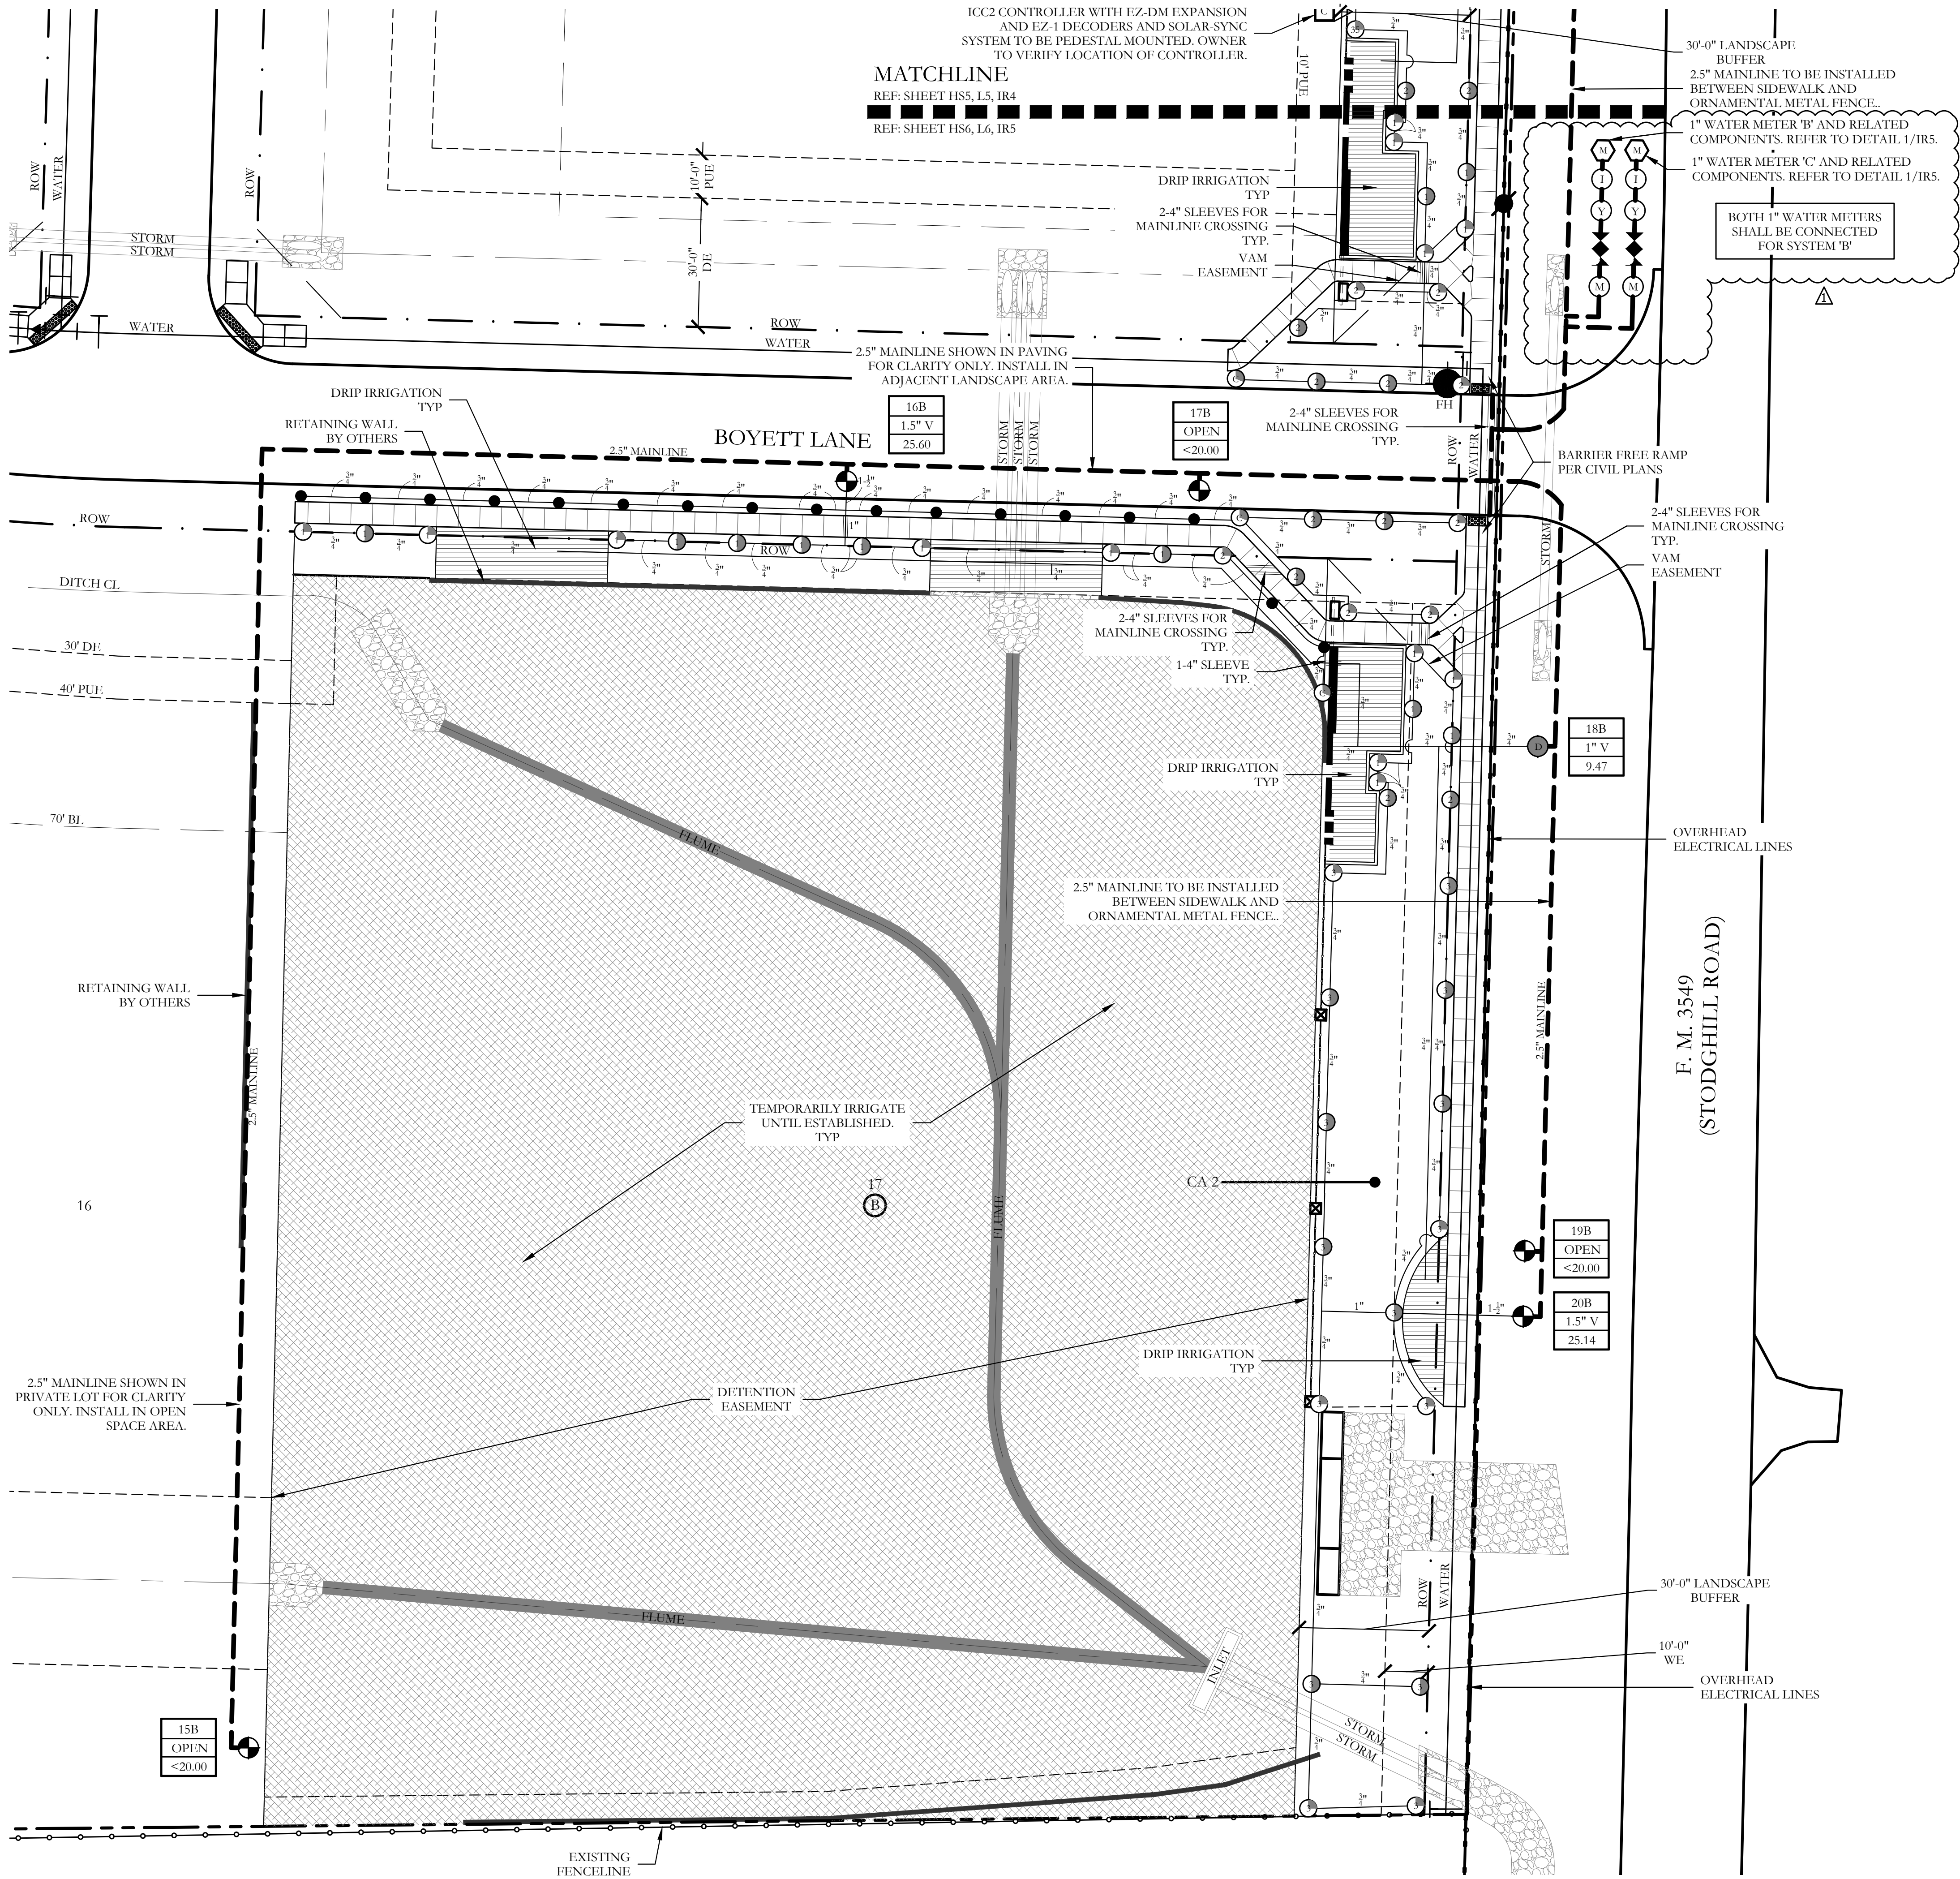

IRRIGATION LEGEND AND SCHEDULE

SYM	DESCRIPTION	MANUFACTURER	MODEL	SIZE / NOZZLE
CA	AUTOMATIC CONTROLLER	HUNTER	REFER TO PLANS	N/A
D	DRIP IRRIGATION CONTROL VALVE	HUNTER	ICZ-101	1"
	DRIP IRRIGATION (LANDSCAPE BEDS)	HUNTER	PLD-06-18	N/A
	DRIP IRRIGATION (TURF BEDS)	HUNTER	PLD-06-12	N/A
	TEMPORARY IRRIGATION	N/A	N/A	N/A
	DRIP IRRIGATION	HUNTER	AFB-ADJ BUBBLER (0.5 GPM EACH BUBBLER)	1/2"
	REMOTE CONTROL VALVE	HUNTER	ICV-101G ICV-151G	REFER TO PLAN FOR SIZE
	LAWN MP ROTATOR	HUNTER	MP ROTATOR	MP1000, MP2000, MP5000, MP3500
	4" POP UP MP ROTATOR CORNER STRIP	HUNTER	STRIP SERIES	MP1CS15 IVORY MPRCS15 COPPER MPSS350 BROWN
	4" POP UP MP ROTATOR CORNER	HUNTER	CORNER SERIES	MP CORNER SERIES ADJUSTABLE ARC 8"-15"
M	WATER METER	---	PER CITY	REFER TO PLAN FOR SIZE
	DOUBLE CHECK VALVE	FEBCO	850-BV Series	REFER TO PLAN FOR SIZE
I	ISOLATION VALVE	NIBCO	*T-113	LINE SIZE
Y	WYE STRAINER	FEBCO	*850	REFER TO PLAN FOR SIZE
M	MASTER VALVE	HUNTER	ICV-101G ICV-151G	REFER TO PLAN FOR SIZE
	IRRIGATION SLEEVE	---	SCH. 40 w/ 12 GA. PULL WIRE IN SLEEVE	REFER TO PLAN FOR SIZE
	IRRIGATION MAIN LINE	---	SCH. 40	REFER TO PLAN FOR SIZE
	IRRIGATION LATERAL LINE	---	CLASS 200	REFER TO PLAN FOR SIZE

- PROGRAM AND STATION NUMBER FOR AUTOMATIC CONTROLLER
- VALVE SIZE IN INCHES
- GALLONS PER MINUTE, PER VALVE

REFER TO SHEET IR6 FOR FULL IRRIGATION LEGEND AND SCHEDULE

NOTE: ALL LATERAL LINES SHALL BE 3/4" CLASS 200 PVC UNLESS OTHERWISE NOTED ON PLANS.


ZONE VALVES LABELED AS "OPEN" ARE INTENDED FOR THE USE OF SUPPLYING HUNTER AFB-ADJ TREE BUBBLERS ON EACH PROPOSED TREE. IRRIGATION CONTRACTOR SHALL FIELD VERIFY THAT THESE ZONES DO NOT EXCEED 20 GALLONS PER MINUTE. THE IRRIGATION CONTRACTOR SHALL STAKE EACH TREE BUBBLER HEAD LOCATION AND RECEIVE APPROVAL FROM THE OWNER AND/OR THE OWNER'S REPRESENTATIVE PRIOR TO INSTALLATION.

NOTE: ALL IRRIGATION MAINLINES ARE TO BE INSTALLED IN OPEN SPACE OUT OF RIGHT-OF-WAY BETWEEN SIDEWALK AND SCREENING WALL.

- 1" WATER METER 'B' AND 'C' BY OTHER TRADES
- 1" ISOLATION VALVE
- 1" WYE STRAINER
- 1" DOUBLE CHECK ASSEMBLY
- 1.5" MASTER VALVE
- 2.5" MAINLINE

1 BACKFLOW AND RELATED COMPONENTS NOT TO SCALE

RECORD DRAWINGS  
To the best of our knowledge Engineering Concepts & Design, L.P., hereby states that this plan is As-Built. This information provided is based on surveying at the site and information provided by the contractor.  
Ryan C. King 1/27/2021  
DATE

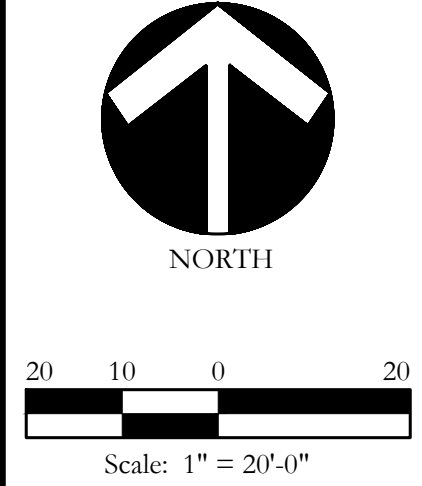










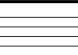


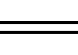
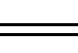




Bar is one inch on original drawing. If not one inch on this sheet, adjust scale as necessary.  
One Inch

TWO-WIRE IRRIGATION NOTES


1. PROVIDE A COMPLETE, FUNCTIONING AUTOMATIC IRRIGATION SYSTEM INCLUDING LABOR, MATERIALS, FEES, TAXES, EQUIPMENT, AND OTHER COSTS INCIDENTAL TO ACCOMPLISHING WORK.
2. ACQUIRE WRITTEN APPROVAL FROM THE LANDSCAPE ARCHITECT OR LICENSED IRRIGATOR FOR MATERIAL SUBSTITUTES PRIOR TO BEGINNING INSTALLATION.
3. FORTY EIGHT (48) HOURS BEFORE IRRIGATION CONSTRUCTION BEGINS, IRRIGATION CONTRACTOR MUST CALL (940) 376-7755 AND IS RESPONSIBLE FOR LOCATING EXISTING UNDERGROUND UTILITIES AND/OR OBSTACLES PRIOR TO BEGINNING WORK. ANY DAMAGE TO UTILITIES AND/OR FINISHES FROM INFERIOR WORKMANSHIP BY THE IRRIGATION CONTRACTOR SHALL BE REPAIRED AT NO ADDITIONAL COST TO THE OWNER.
4. PIPING IS DIAGRAMMATIC AND SHOWN FOR CLARITY ONLY. ADJUST AS REQUIRED FOR EXISTING UTILITIES, OBSTRUCTIONS, TREE ROOT BALLS, ETC. PIPING AND VALVES SHOWN IN PAVING FOR CLARITY ONLY AND SHALL BE INSTALLED IN ADJACENT LANDSCAPE AREA. COORDINATE WITH THE CITY OR ENTITY INSPECTING THE IRRIGATION SYSTEM AND DETERMINE THE LOCAL RULES AND CODES TO ABIDE BY REGARDING MAINLINE AND LATERAL PIPING LOCATIONS.
5. COORDINATE SLEEVE AND CONDUIT REQUIREMENTS WITH GENERAL CONTRACTOR. IRRIGATION SLEEVES SHALL BE AS FOLLOWS:
- 5.1. SLEEVES INTENDED FOR LATERAL LINES ARE TO BE ONE-FOUR INCH SLEEVE AND ARE TO BE NO MORE THAN A DEPTH OF TWO FEET BELOW TOP OF CURB. SLEEVES SHOULD EXTEND A MINIMUM OF 2'-0" BEYOND BACK OF CURB.
- 5.2. SLEEVES INTENDED FOR THE 2.5" MAINLINE ARE TO BE TWO-FOUR INCH SLEEVES SIDE BY SIDE AND ARE TO BE NO MORE THAN A DEPTH OF TWO FEET BELOW TOP OF CURB. SLEEVES SHOULD EXTEND A MINIMUM OF 2'-0" BEYOND BACK OF CURB.
6. LOCATE EACH END OF IRRIGATION SLEEVES DIMENSIONALLY ON THE RECORD "AS BUILT" DRAWINGS.
7. THE IRRIGATION CONTRACTOR SHALL COORDINATE THE INSTALLATION OF THE IRRIGATION SYSTEM WITH THE LANDSCAPE CONTRACTOR TO ENSURE ALL PLANT MATERIAL WILL BE WATERED IN ACCORDANCE WITH THE INTENT OF THE PLANS AND SPECIFICATIONS.
8. THE IRRIGATION CONTRACTOR SHALL BE RESPONSIBLE FOR DAMAGE TO PLANT MATERIAL DUE TO SYSTEM FAILURE FROM INFERIOR WORKMANSHIP FOR THE DURATION OF THE INSTALLATION OF PLANT MATERIAL AND MAINTENANCE PERIOD FOLLOWING INSTALLATION.
9. THE IRRIGATION CONTRACTOR SHALL PROVIDE ALL LABOR AND MATERIAL NECESSARY TO HAND DIG WITHIN ALL EXISTING TREE DRIPLINE ZONES AT NO ADDITIONAL COST TO THE OWNER. THE IRRIGATION CONTRACTOR SHALL BE RESPONSIBLE TO STAKE AND RECEIVE APPROVAL FROM ALL DISCIPLINES PRIOR TO ANY TRENCHING AND HAND DIGGING IN AREAS OF EXISTING TREE COVERAGE OR ANY ADDITIONAL AREAS THAT MIGHT BE QUESTIONABLE.
10. EXTEND EXTRA WIRE AND MAINLINE PAST THE FARTHEST VALVE, ROUTED PARALLEL AND PLACE IN 12"x17" PENTEK VALVE BOX WERE NOTED ON PLANS FOR FUTURE EXPANSION OF IRRIGATION SYSTEM AT A LATER DATE.
11. TWO WIRE PATH SHALL BE DIRECT BURIAL, 14 AWG OR STANDARD DECODER CABLE BY HUNTER WITH YELLOW JACKET (ID1YLW), RATED FOR DIRECT BURIAL APPLICATIONS, UF-, UL, APPROVED. HUNTER ICD DECODERS SHALL BE USED ON ALL ZONE VALVE CONNECTIONS TO TWO WIRE PATH. CONTRACTOR TO USE MANUFACTURERS RECOMMENDATIONS OF WIRE SPLICING AND BURIAL TECHNIQUES AS DETAILED AT WWW.HUNTERINDUSTRIES.COM.
12. THE OWNER AND/OR LANDSCAPE ARCHITECT SHALL DETERMINE THE FINAL CONTROLLER LOCATION. THE IRRIGATION CONTRACTOR SHALL MAKE FINAL ELECTRICAL CONNECTION OF CONTROLLER PER LOCAL ELECTRICAL CODE. PROVIDE ALL NECESSARY FUSE BOXES, CONDUIT, FITTINGS, CONNECTORS OR OTHER ELECTRICAL DEVICES TO MAKE CONNECTION. OWNER SHALL PROVIDE ELECTRICAL SERVICE WITHIN 10 LINEAR FEET OF CONTROLLER LOCATION UNLESS NOTED OTHERWISE ON DRAWINGS.
13. CONNECT REMOTE SENSORS TO CONTROLLER WITH GROUND WIRE IN SERIES PRIOR TO CONNECTING TO REMOTE CONTROL VALVES.
14. ALL PVC MAINLINES AND LATERAL LINES SHALL RECEIVE AS FOLLOWS:
- 14.1. 18" MINIMUM COVER FOR MAIN LINES
- 14.2. 18" MINIMUM COVER FOR PIPING LOCATED UNDER PAVING
- 14.3. 12" MINIMUM COVER FOR LATERAL LINES
15. THE MINIMUM DISTANCE BETWEEN THE MAINLINE AND LATERAL LINE FITTINGS (EXCEPT FOR REDUCER BUSHINGS) SHALL BE 18".
16. THE MINIMUM HORIZONTAL DISTANCE OF 36" SHALL BE MAINTAINED BETWEEN ANY VALVES THAT ARE INSTALLED SIDE BY SIDE.
17. WHERE SERVICE TREES ARE INSTALLED ON THE MAINLINE FOR INSTALLATION OF THE ELECTRIC VALVES AND/OR QUICK COUPLING VALVES, THE CONTRACTOR SHALL LIMIT THE NUMBER OF THESE PER SERVICE TREE. DO NOT INSTALL MORE THAN A TOTAL OF EITHER THREE ELECTRIC VALVES OR A COMBINATION OF TWO ELECTRIC VALVES AND ONE QUICK COUPLER VALVE AT EACH TREE. THE MINIMUM DISTANCE BETWEEN FITTINGS SHALL BE 18" AS REFERENCED IN THE ABOVE NOTES.
18. ALL PVC PIPE AND FITTINGS ARE TO BE PRIMED WITH PURPLE PVC PRIMER SOLVENT BEFORE APPLYING PVC CEMENT IN ACCORDANCE WITH THE UNIFORM PLUMBING CODE.
19. INSTALL QUICK COUPLING VALVES IN 12"x17" PENTEK VALVE BOXES PER DETAIL SHOWN. CONNECT QUICK COUPLING VALVES TO MAINLINE PIPE WITH LASCO UNITIZED, O-RING SWING JOINTS PER DETAIL SHOWN, #7722-22. SUPPLY OWNER WITH THREE COUPLER KEYS WITH SWIVEL HOSE BIBB EACH, #33DK-10 AND #314-0 RESPECTIVELY. VALVES TO BE INSTALLED SUCH THAT THE TOP OF THE QUICK COUPLER IS 2" BELOW BOTTOM OF VALVE BOX LID. PURPLE LID SHALL READ "NON-POTABLE, NOT SAFE FOR DRINKING" IN ENGLISH AND SPANISH.
20. ALL LATERAL LINES SHALL BE 3/4" CLASS 200 PVC UNLESS OTHERWISE NOTED ON PLANS.
21. ZONE VALVES LABELED AS "OPEN" ARE INTENDED FOR THE USE OF SUPPLYING HUNTER AFB-ADJ TREE BUBBLERS ON EACH PROPOSED TREE. IRRIGATION CONTRACTOR SHALL FIELD VERIFY THAT THESE ZONES DO NOT EXCEED 20 GALLONS PER MINUTE. THE IRRIGATION CONTRACTOR SHALL STAKE EACH TREE BUBBLER HEAD LOCATION AND RECEIVE APPROVAL FROM THE OWNER AND/OR THE OWNERS REPRESENTATIVE PRIOR TO INSTALLATION.
22. ALL STATE OF TEXAS LAWS/RULES AND ALL LOCAL CODES/ORDINANCES AREA MADE PART OF THESE PLANS AND SPECIFICATIONS WHETHER SHOWN OR NOT. THESE LAWS AND ORDINANCES WILL SUPERCEDE THE PLANS, DETAILS, AND/OR SPECIFICATIONS FOR THIS PROJECT. THE IRRIGATION CONTRACTOR IS CAUTIONED THAT HE/SHE IS TO INCLUDE ANY AND ALL COST NECESSARY TO MEET OR EXCEED THE LAWS OF THE STATE OF TEXAS AND LOCAL CODES CONCERNING LANDSCAPE IRRIGATION.
24. INCLUDE THE FOLLOWING ALLOWANCES FOR PROVIDING AND INSTALLING AIR RELIEF VALVES AND FLUSH VALVES FOR THE DRIP SYSTEM. EXACT QUANTITY AND LOCATION OF THESE DEVICES WILL BE DETERMINED AT THE TIME OF INSTALLATION. IN GENERAL, ALL AIR RELIEF VALVES WILL BE INSTALLED AT THE HIGH POINTS AND FLUSH VALVES WILL BE INSTALLED AT THE LOW POINTS OF EXHAUST HEADER. ALLOW FOR APPROXIMATELY (1) AIR RELIEF AND APPROXIMATELY ONE (1) FLUSH VALVE FOR EACH DRIP ZONE.
25. INCLUDE THE FOLLOWING ALLOWANCE FOR PROVIDING AND INSTALLING DRIP INDICATOR FOR THE DRIP SYSTEM. LOCATION OF DRIP INDICATOR SHOULD BE CENTERED IN DRIP ZONE.

IRRIGATION LEGEND AND SCHEDULE

SYM	DESCRIPTION	MANUFACTURER	MODEL	SIZE / NOZZLE	NOTES
	AUTOMATIC CONTROLLER	HUNTER	REFER TO PLANS	N/A	INSTALL PER MANUFACTURER'S STANDARDS. IN ADDITION, INSTALL SOLAR-SYNC SYSTEM BY HUNTER.
	DRIP IRRIGATION CONTROL VALVE	HUNTER	ICZ-101	1"	INSTALL PER DETAIL IN 10" ROUND BOX w/ BOLT DOWN LID. ROUT AND PAINT VALVE NUMBER ON LID.
	DRIP IRRIGATION (LANDSCAPE BEDS)	HUNTER	PLD-06-18	N/A	INSTALL PER DETAIL w/ 40 PSI AT OUTFLOW OF DRIP ZONE VALVE.
	DRIP IRRIGATION (TURF BEDS)	HUNTER	PLD-06-12	N/A	INSTALL PER DETAIL w/ 40 PSI AT OUTFLOW OF DRIP ZONE VALVE.
	TEMPORARY IRRIGATION	N/A	N/A	N/A	INSTALL PER MANUFACTURER'S STANDARDS. TO BE REMOVED ONCE AREA IS ESTABLISHED.
	DRIP IRRIGATION	HUNTER	AFB-ADJ BUBBLER (0.5 GPM EACH BUBBLER)	1/2"	INSTALL PER DETAIL w/ 40 PSI AT BASE OF HEAD. INSTALL 1.0 GPM/LARGE SHADE TREE AND 0.5 GPM/ORN. TREES. INSTALL ON ALL PROPOSED TREES, SEE LANDSCAPE PLANS.
	REMOTE CONTROL VALVE	HUNTER	ICV-101G ICV-151G	Refer to Plan for Size	INSTALL PER DETAIL IN 10" ROUND PENTEK VALVE BOX WITH BOLT DOWN LID. ROUT AND PAINT VALVE NUMBER ON LID.
	LAWN MP ROTATOR	HUNTER	MP ROTATOR	MP1000, MP2000, MP3000, MP3500	INSTALL PER DETAIL w/ 40 PSI AT BASE OF HEAD. INSTALL ON IPS FLEX PIPE ALL SPRAY BODIES. INSTALL NOZZLES ON 4" PRS40 SPRAY BODIES.
	WATER METER	----	PER CITY	REFER TO PLAN FOR SIZE	INSTALLED BY GENERAL CONTRACTOR
	DOUBLE CHECK VALVE	FEBCO	850-BV Series	REFER TO PLAN FOR SIZE	FURNISH AND INSTALL PER LOCAL CODE BY LICENSED IRRIGATION CONTRACTOR.
	ISOLATION VALVE	NIBCO	*T-113	LINE SIZE	INSTALL PER DETAIL IN 12"x17" PENTEK VALVE BOX WITH BOLT DOWN LID.
	WYE STRAINER	FEBCO	*850	REFER TO PLAN FOR SIZE	INSTALL PER DETAIL IN 12"x17" PENTEK VALVE BOX WITH BOLT DOWN LID.
	MASTER VALVE	HUNTER	ICV-101G ICV-151G	REFER TO PLAN FOR SIZE	INSTALL PER DETAIL IN 12"x17" PENTEK VALVE BOX WITH BOLT DOWN LID.
	IRRIGATION SLEEVE	----	SCH. 40 w/ 1/2 GA. PULL WIRE IN SLEEVE	REFER TO PLAN FOR SIZE	DRIVEWAY SLEEVES INSTALLED BY GENERAL CONTRACTOR. SIDEWALK SLEEVES INSTALLED BY IRRIGATION CONTRACTOR.
	IRRIGATION MAIN LINE	----	SCH. 40	REFER TO PLAN FOR SIZE	18" INSTALLATION DEPTH
	IRRIGATION LATERAL LINE	----	CLASS 200	REFER TO PLAN FOR SIZE	12" INSTALLATION DEPTH STANDARD. 18" INSTALLATION DEPTH UNDER PAVING.

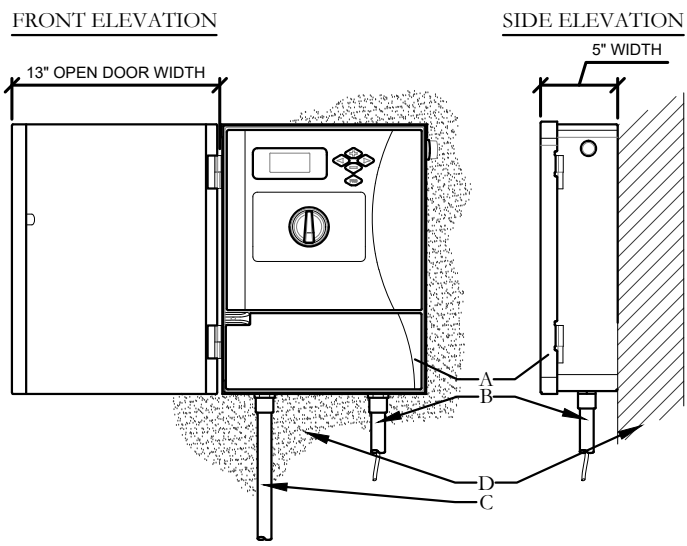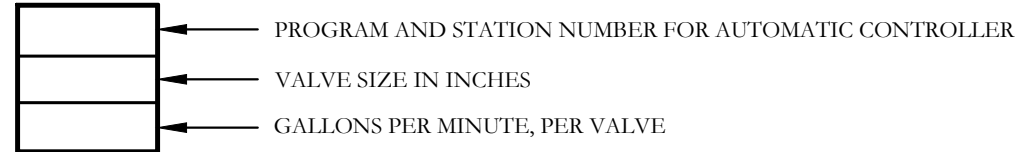

ICC2 CONTROLLER - WALL MOUNT  
(NOT TO SCALE)

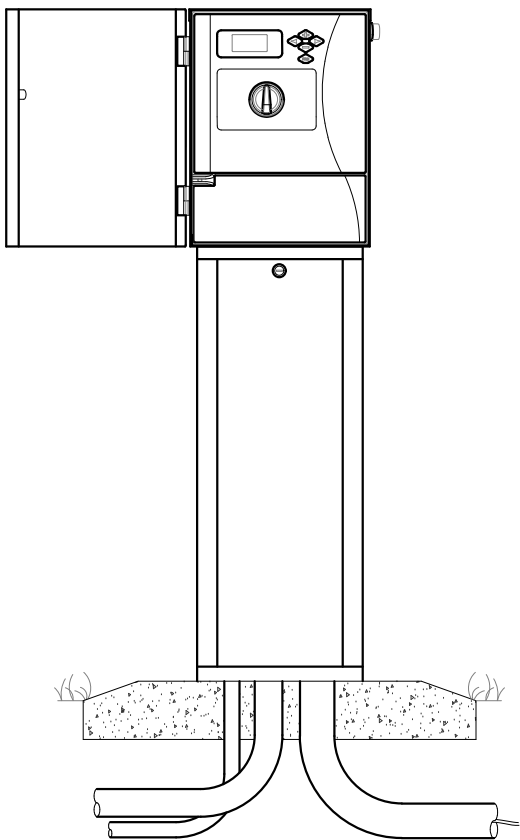


ICC2 CONTROLLER - PEDESTAL MOUNT  
(NOT TO SCALE)

- CONSTRUCTION NOTES:**
- A. IRRIGATION CONTROLLER (12C-800-M) PER PLAN
- B. IRRIGATION CONTROL WIRE IN CONDUIT SIZE AND TYPE PER LOCAL CODES
- C. ELECTRICAL SUPPLY CONDUIT, CONNECT TO POWER SOURCE, J-BOX INSIDE CONTROLLER
- D. ADJACENT SURFACE TO MOUNT CONTROLLER PER PLAN
- NOTES:**
1. INSTALLATION TO BE COMPLETED IN ACCORDANCE WITH MANUFACTURER'S SPECIFICATIONS
2. CONTROLLER ACCEPTS 120 VOLTS AC
3. SEE PLAN LEGEND FOR MODEL NUMBER AND SPECIFICATIONS
4. ALWAYS REFER TO PRODUCT INSTALLATION NOTES PRIOR TO INSTALLATION
5. MOUNT CONTROLLER LCD SCREEN EYE LEVEL, CONTROLLER SHALL BE HARD WIRE TO GROUNDED 110 VAC POWER SOURCE

- CONSTRUCTION NOTES:**
- A. IRRIGATION CONTROLLER (ICC-PED) PER PLAN
- B. ELECTRICAL SUPPLY CONDUIT, CONNECT TO POWER SOURCE, J-BOX INSIDE CONTROLLER
- C. GROUND WIRE CODUIT GROUND PER ASIC GUIDELINES
- D. IRRIGATION CONTROL WIRE IN CONDUIT SIZE AND TYPE PER LOCAL CODES
- E. PEDESTAL BASE PER PLAN, ENSURE POSITIVE DRAINAGE AWAY FROM PEDESTAL

- NOTES:**
1. INSTALLATION TO BE COMPLETED IN ACCORDANCE WITH MANUFACTURER'S SPECIFICATIONS
2. SEE PLAN LEGEND FOR MODEL NUMBER AND SPECIFICATIONS
3. ALWAYS REFER TO PRODUCT INSTALLATION NOTES PRIOR TO INSTALLATION
4. CONTROLLER SHALL BE HARD WIRE TO GROUNDED 110 VAC POWER SOURCE

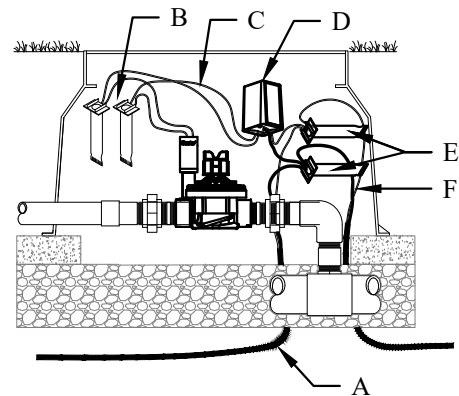

DUAL-1 DECODER  
(NOT TO SCALE)

**RECORD DRAWINGS**

To the best of our knowledge Engineering Concepts & Design, L.P., hereby states that this plan is As-Built. This information provided is based on surveying at the site and information provided by the contractor.

*Ryan C. King*  
RYAN C. KING

1/27/2021  
DATE

- CONSTRUCTION NOTES:**
- A. JACKETED ID WIRE PATH TWISTED TO NEXT DECODER
- B. DBY-2
- C. TWO BLACK WIRES TO VALVE SOLENOID/ UP TO 100 FT/30M
- D. MODEL DUAL-1 DECODER
- E. DBR/T-6 (2)
- F. JACKETED ID: WIRE PATH FROM CONTROLLER ALLOW 5 FT-1.5M SLACK PER DECODER/1/3 ON EITHER SIDE OF DECODER.


HYDRAULIC CALCULATION NOTES

TEN DAYS PRIOR TO COMMENCING WORK, VERIFY STATIC PRESSURE. IF STATIC PRESSURE IS LESS THAN THE ASSUMED STATIC PRESSURE DO NOT START WORK UNTIL NOTIFIED IN WRITING TO PROCEED BY OWNER. IF CONTRACTOR PROCEEDS WITH WORK WITHOUT AUTHORIZATION FROM OWNER, THE CONTRACTOR SHALL BE FINANCIALLY RESPONSIBLE TO CORRECT, MODIFY OR REPAIR ANY ITEMS OR MATERIALS THAT MAY BE REQUIRED TO PROVIDE A FULLY FUNCTIONING AND OPERATIONAL IRRIGATION SYSTEM IN COMPLIANCE WITH THE PLANS AND SPECIFICATIONS. HYDRAULIC CALCULATIONS FOR THIS SYSTEM ARE BASED ON THE STATIC PRESSURE AS STATED ABOVE. THE STATIC PRESSURE SHOWN IS AN ASSUMED PRESSURE, A PRESSURE MEASURED AT THE SITE, OR AN ESTIMATED PRESSURE PROVIDED BY THE COUNTY OR CITY. THE OWNER UNDERSTANDS THIS PROJECT MAY NOT PROVIDE 100% COVERAGE AT ALL TIMES.

HYDRAULIC CALCULATION (LARGEST HEAD)			
ITEM	SIZE	PSI	NOTES
SERVICE	1.25"	0.70	TYPE "K" COPPER 20 LN. FT. (17.34 GPM)
WATER METER 'A'	1"	1.80	(17.34 GPM)
BALL VALVE	1"	1.00	(17.34 GPM)
WYE FILTER	1"	0.30	(17.34 GPM)
BACKFLOW PREVENTER	1"	4.00	(17.34 GPM)
MASTER VALVE	1"	3.00	(17.34 GPM)
MAIN LINE	1.5"	0.75	40 LINEAR FEET (17.34 GPM)
ZONE VALVE (3A)	1"	3.00	(17.34 GPM)
LATERAL PIPING	N/A	2.18	
CRITICAL HEAD 'A'	N/A	40.00	
TOTAL LOSS		56.74	
ASSUMED STATIC PRESSURE		70.00	
PRESSURE DIFFERENTIAL		-13.26	

HYDRAULIC CALCULATION (FARTHEST ZONE)			
ITEM	SIZE	PSI	NOTES
SERVICE	1.25"	1.39	TYPE "K" COPPER 20 LN. FT. (25.10 GPM)
WATER METER 'B'	1"	4.00	(25.10 GPM)
BALL VALVE	1"	1.00	(25.10 GPM)
WYE FILTER	1"	0.30	(25.10 GPM)
BACKFLOW PREVENTER	1"	4.00	(25.10 GPM)
MASTER VALVE	1.5"	1.50	(25.10 GPM)
MAIN LINE	2.5"	5.70	1240 LINEAR FEET (25.10 GPM)
ZONE VALVE (2B)	1.5"	1.50	(25.10 GPM)
LATERAL PIPING	N/A	2.49	
CRITICAL HEAD 'B-1'	N/A	40.00	
TOTAL LOSS		61.88	
ASSUMED STATIC PRESSURE		70.00	
PRESSURE DIFFERENTIAL		-8.12	

HYDRAULIC CALCULATION (LARGEST ZONE)			
ITEM	SIZE	PSI	NOTES
SERVICE	1.25"	1.39	TYPE "K" COPPER 20 LN. FT. (26.55 GPM)
WATER METER 'B'	1"	4.60	(26.55 GPM)
BALL VALVE	1"	1.00	(26.55 GPM)
WYE FILTER	1"	0.30	(26.55 GPM)
BACKFLOW PREVENTER	1"	4.00	(26.55 GPM)
MASTER VALVE	1.5"	1.50	(26.55 GPM)
MAIN LINE	2.5"	3.57	690 LINEAR FEET (26.55 GPM)
ZONE VALVE (7B)	1.5"	1.50	(26.55 GPM)
LATERAL PIPING	N/A	3.91	
CRITICAL HEAD 'B-2'	N/A	40.00	
TOTAL LOSS		61.97	
ASSUMED STATIC PRESSURE		70.00	
PRESSURE DIFFERENTIAL		-8.03	

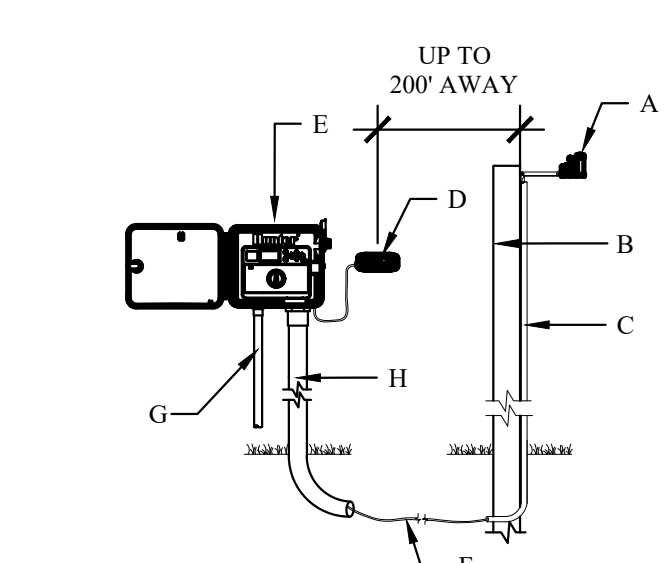

SOLAR SYNC SYSTEM (ICC2 CONTROLLER)  
(NOT TO SCALE)

- CONSTRUCTION NOTES:**
- A. MODEL: SOLAR SYNC SENSOR
- B. SUITABLE POST, POLE, OR GUTTER MOUNT. MOUNT IN LOCATION WHERE SENSOR CAN RECEIVE FULL SUN, IS OPEN TO RAINFALL AND OUT OF SPRINKLER SPRAY PATTERN.
- C. CONDUIT FROM SOLAR SYNC SENSOR TO CONTROLLER OR TO A POINT 12" BELOW GRADE
- D. MODEL SOLAR SYNC MODULE. MOUNT LESS THAN 6" AWAY FROM CONTROLLER. MODULE CAN BE MOUNTED INTERNALLY WHEN PAIRED WITH THE PCC CONTROLLER.\*
- E. HUNTER ICC2 CONTROLLER
- F. COMMUNICATION WIRE, 18-2(WIRE TYPE TO MEET INSTALLATION CODE REQUIREMENTS), FROM MODULE TO SENSOR. MAXIMUM TOTAL WIRE DISTANCE, 200 FEET.
- G. POWER SOURCE
- H. CONDUIT FOR VALVE CONTROL WIRE AND SOLAR SYNC COMMUNICATION WIRE

**CODY JOHNSON**  
s · t · u · d · i · o

9720 COTT ROAD SUITE 220-333 PLANO, TEXAS 75025  
PH: (940) 570-0162  
EMAIL: CODY@CODYJOHNSONSTUDIO.COM

STATE OF TEXAS  
CODY L. JOHNSON  
17132  
REGISTERED PROFESSIONAL LANDSCAPE ARCHITECT  
December 7, 2020

Bar is one inch on original drawing. If not one inch on this sheet adjust scale as necessary.

One Inch

LANDSCAPE AND SCREENING


Irrigation Details

Northgate Phase 1

City of Rockwall, Tarrant County, Texas


CJS PROJECT NO.  
MJP001

SHEET NO.  
IR6 of 7

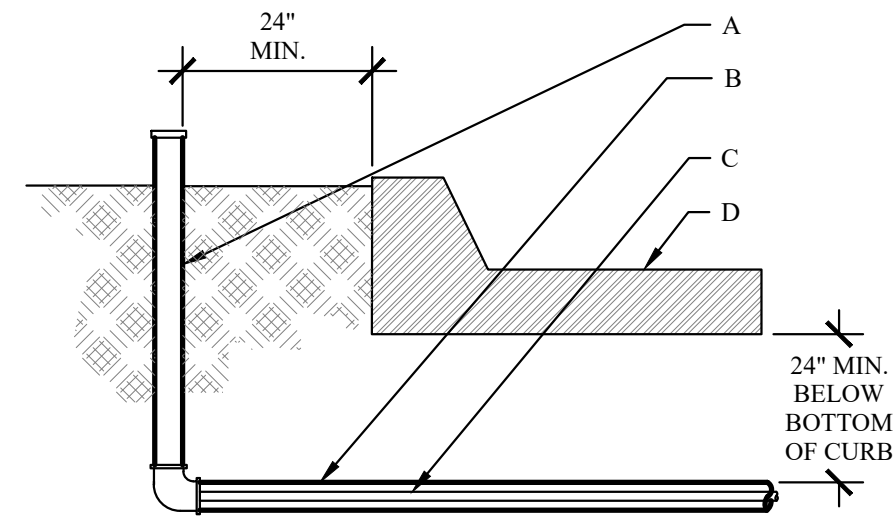


- GENERAL NOTES:**
- NO DIRECT CONNECTION TO SLEEVE SHALL BE ALLOWED. SLEEVE SIZE SHALL BE TWO (2) SIZES LARGER THAN THE PIPE TO BE SLEEVED.
  - MARK HARDSCAPE WITH SYMBOL "S" TO INDICATE THAT A SLEEVE IS BELOW.
  - INSTALL WIRING IN SEPARATE SLEEVE FROM LATERAL AND MAINLINE PIPING.


- CONSTRUCTION NOTES:**
- TEMPORARY RISER AND CAP.
  - SCH 40 PVC IRRIGATION SLEEVE - SEE PLAN.
  - PVC MAINLINE, LATERAL OR WIRING - SEE PLAN.
  - PAVING

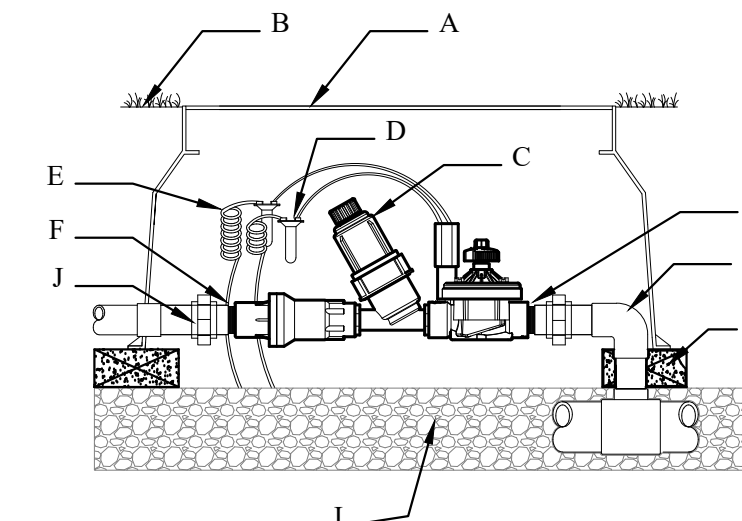


- CONSTRUCTION NOTES:**
- JUMBO VALVE BOX
  - FINISH GRADE
  - DRIP ZONE KIT, MODEL ICZ-101
  - WATERPROOF CONNECTORS (2)
  - 18-24" COILED WIRE
  - SCH 80 T.O.W. NIPPLE
  - MAINLINE PIPING AND FITTINGS
  - BRICK SUPPORTS (4)
  - 3/4" MINUS WASHED GRAVEL
  - PVC SLIP UNIONS (2)

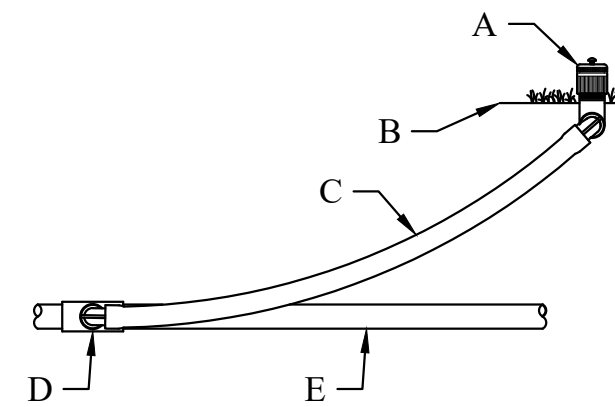


- CONSTRUCTION NOTES:**
- MODEL AFB BUBBLER
  - FINISH GRADE
  - SWING JOINT: HUNTER "PRO-FLEX" TUBING 24"-36", HSBE-050 ELBOWS (2), & MARLEX STREET ELBOW (1)
  - LATERAL TEE OR ELL
  - LATERAL PIPE

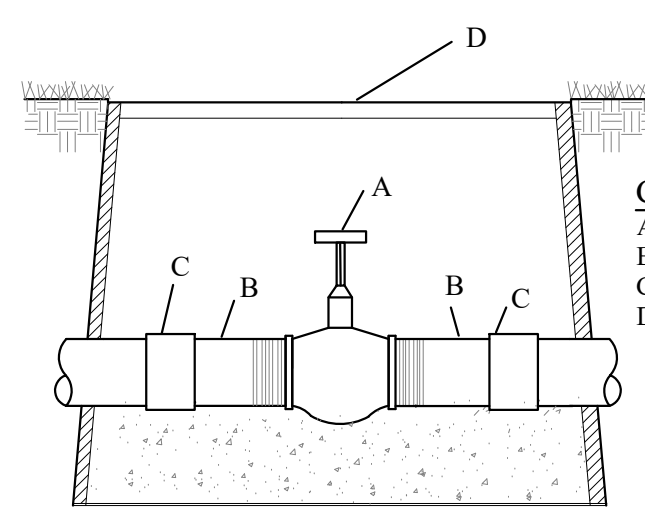

- CONSTRUCTION NOTES:**
- GATE VALVE
  - SCH 80 TOE NIPPLE
  - COUPLING
  - 11x17 VALVE BOX

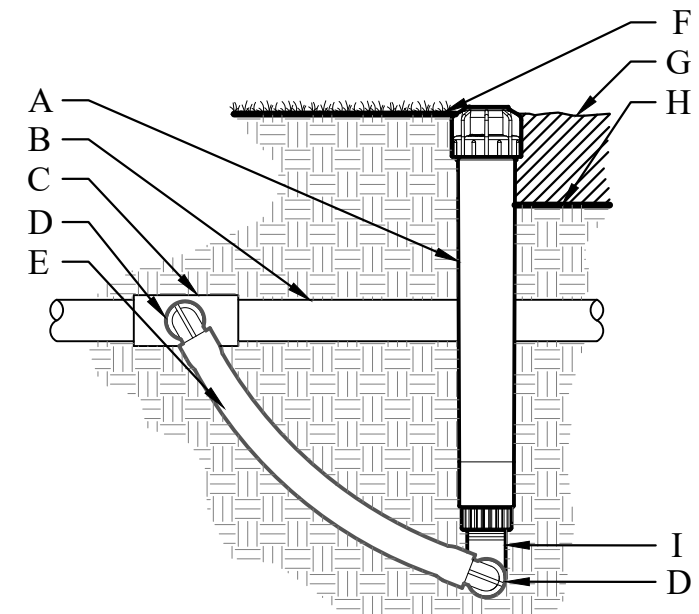


- CONSTRUCTION NOTES:**
- ECO INDICATOR - ECOID
  - LATERAL PIPE PER PLAN
  - FPT CONNECTION FROM LATERAL
  - SPIRAL BARB ELBOW - HSBE-XXX
  - FLEXx<sub>2</sub> TUBING - FLEXxG
  - FINISHED GRADE IN TURF
  - ADJACENT MULCH
  - FINISHED GRADE IN PLANTER BED
  - MARLEX STREET ELBOW

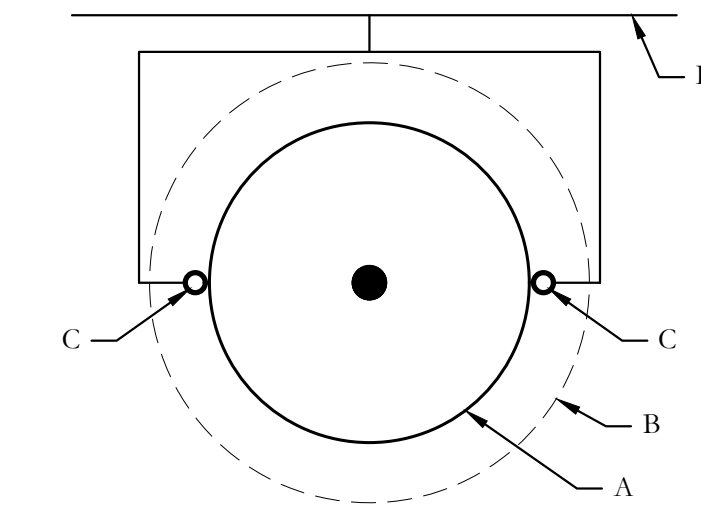

- GENERAL NOTES:**
- TREE BUBBLERS TO BE ALIGNED PARALLEL WITH MEDIAN CURBS.
  - NO TRENCHING ALLOWED WITHIN THE TREES ROOTBALL.
  - TREE BUBBLERS TO BE ON UPHILL SIDE OF THE TREE IN THE RETENTION BASIN OR AS SHOWN.
  - COORDINATE THE LOCATION OF THE BUBBLERS WITH THE PROPOSED TREE LOCATIONS AS SHOWN ON THE LANDSCAPE PLANTING PLANS.

- CONSTRUCTION NOTES:**
- TREE ROOTBALL
  - EDGE OF TREE PIT (RETENTION BASIN)
  - TREE BUBBLER NOZZLE AFB
  - LATERAL LINE (SIZED AS SPECT'D)

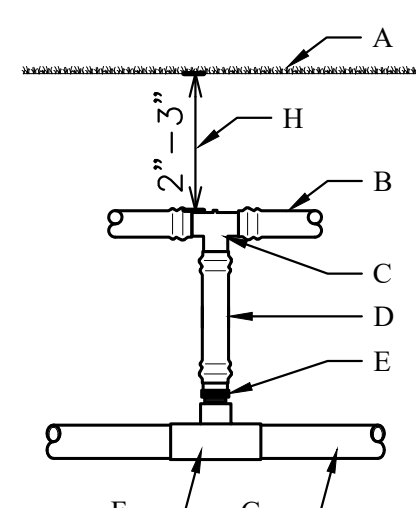


- CONSTRUCTION NOTES:**
- FINISH GRADE
  - HUNTER PLD 06-18
  - PLD-TEE TMM BARBxBARB
  - PLD-BLANK
  - PLD-075 3/4" MPTxBARB
  - 3/4" MPT TEE
  - LATERAL PIPE
  - MINIMUM DRIPLINE DEPTH

#### RECORD DRAWINGS

To the best of our knowledge Engineering Concepts & Design, L.P., hereby states that this plan is As-Built. This information provided is based on surveying at the site and information provided by the contractor.


*Ryan C. King*  
RYAN C. KING

*1/27/2021*  
DATE

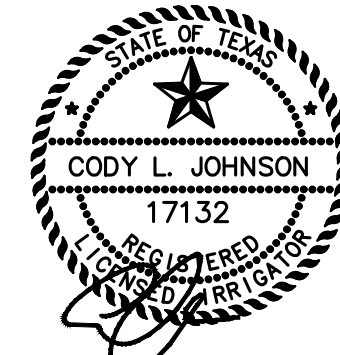

#### ECO INDICATOR WITH FLEX TUBING

NOT TO SCALE

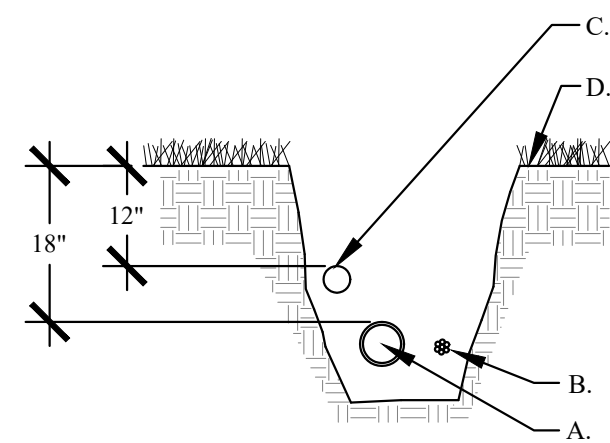


- GENERAL NOTES:**
- REST PIPE FIRMLY ON TRENCH BOTTOM.
  - SNAKE PIPE FROM SIDE TO SIDE.
  - DO NOT STACK PIPE IN TRENCH. PROVIDE HORIZONTAL SEPARATION.
  - MAINTAIN 2" MINIMUM SEPARATION BETWEEN MAINLINE AND LATERAL LINE PIPING.
  - BUNDLE WIRE(S) AT 20 FT. INTERVALS.

- CONSTRUCTION NOTES:**
- MAINLINE PIPING - 18" MINIMUM COVER
  - WIRE BUNDLE - TAPE PER SPECIFICATIONS
  - LATERAL LINE PIPING - 12" MINIMUM COVER
  - FINISH GRADE

#### TREE BUBBLER PLAN

NOT TO SCALE

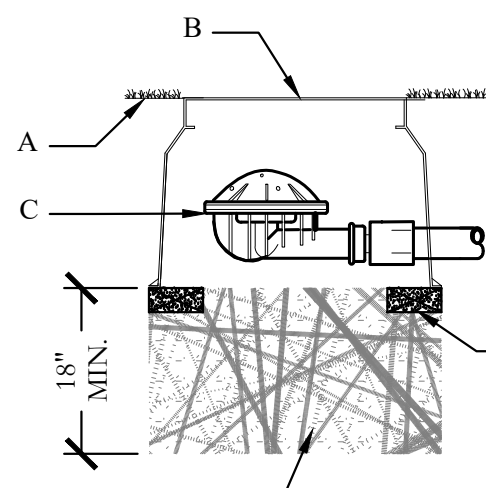


- CONSTRUCTION NOTES:**
- FINISH GRADE
  - 10" ROUND VALVE BOX
  - LINE FLUSHING VALVE
  - PLD-050 OR 1/2" FPT ADAPTER
  - TREE BUBBLER NOZZLE AFB
  - 3/4" GRAVEL SUMP

#### DRIP IRRIGATION - FLUSH VALVE

NOT TO SCALE


#### BELOW GRADE START CONNECTION

NOT TO SCALE

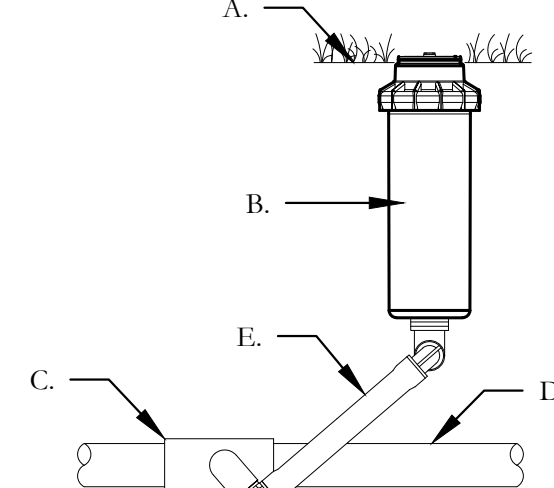

- GENERAL NOTES:**
- REST PIPE FIRMLY ON TRENCH BOTTOM.
  - SNAKE PIPE FROM SIDE TO SIDE.
  - DO NOT STACK PIPE IN TRENCH. PROVIDE HORIZONTAL SEPARATION.
  - MAINTAIN 2" MINIMUM SEPARATION BETWEEN MAINLINE AND LATERAL LINE PIPING.
  - BUNDLE WIRE(S) AT 20 FT. INTERVALS.

- CONSTRUCTION NOTES:**
- FINISHED GRADE
  - ROTOR HEAD
  - LATERAL TEE OR ELL
  - LATERAL PIPE
  - LASCO SWING JOINT

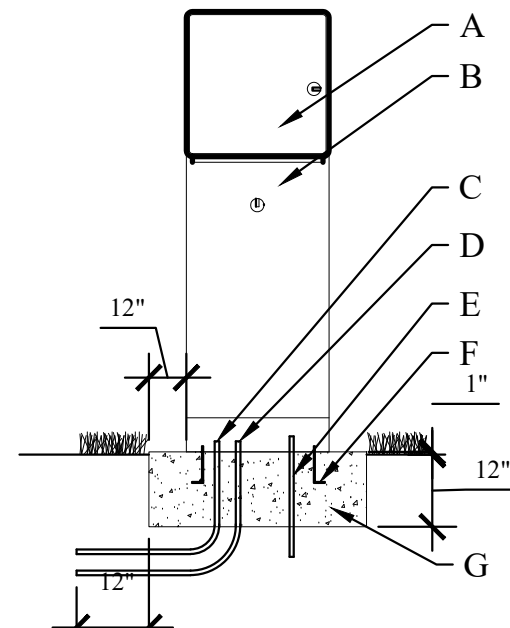


- GENERAL NOTES:**
- INSTALL ELECTRICAL WIRING PER LOCAL CODES.
  - CONTRACTOR SHALL BE RESPONSIBLE FOR ALL ELECTRICAL WORK.
  - PROVIDE DRAINAGE AWAY FROM BASE OF PEDESTAL.
  - GROUND IRRIGATION BOXES WITH GROUNDING ROD PER N.E.C.
  - INSTALL TEMPERATURE SENSOR TO NORTH SIDE OF CONTROLLER PEDESTAL W/ STAINLESS STEEL SCREWS

- CONSTRUCTION NOTES:**
- CONTROLLER
  - PEDESTAL
  - ELECTRICAL SERVICE CONDUIT
  - REMOTE CONTROL VALVE WIRING CONDUIT
  - GROUNDING ROD(S) PER MANUFACTURER'S REQUIREMENTS
  - ANCHOR BOLTS
  - CONCRETE BASE, 3,000 PSI


#### PEDESTAL MOUNTED CONTROLLER

NOT TO SCALE

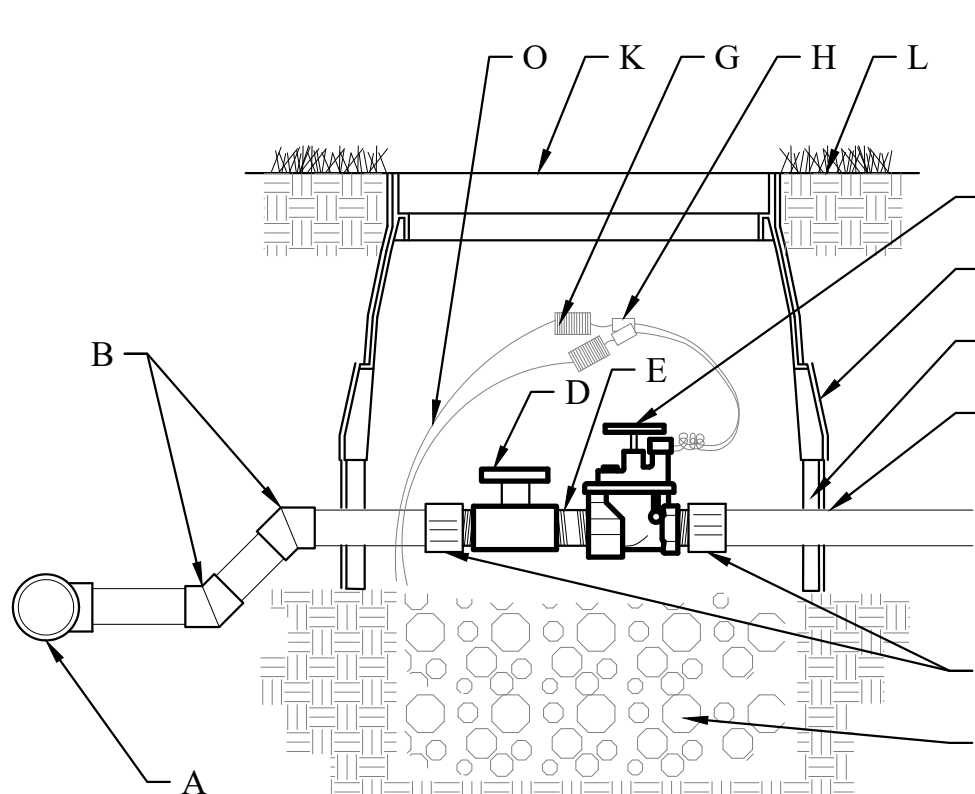

- GENERAL NOTES:**
- INSTALL PEA GRAVEL FLUSH WITH BOTTOM OF PIPE AND VALVE.
  - MAINLINE SHALL HAVE A MINIMUM OF 18" COVER AND LATERAL LINE SHALL HAVE A MINIMUM OF 12" COVER.
  - PROVIDE A 24" WIRE EXPANSION COIL AT EACH DRY SPLICE WIRE CONNECTION.
  - CENTER VALVE ASSEMBLY IN VALVE BOX.


- CONSTRUCTION NOTES:**
- PVC SERVICE TEE
  - SCH 40 45° BEND
  - SCH 40 MALE ADAPTER
  - SCH 40 BALL VALVE
  - GRAY SCH 80 SHORT NIPPLE (TBE)
  - AUTOMATIC VALVE
  - WIRE COIL
  - WATERPROOF WIRE CONNECTORS
  - 10 ML BLACK PLASTIC
  - ARMOR 12" STANDARD VALVE BOX WITH COVER AND PENTAGON LOCK. ROUT AND PAINT VALVE NUMBER ON TOP OF LID. SET 1/2" ABOVE FINISH GRADE.
  - FINISH GRADE
  - WASHED PEA GRAVEL - 6" DEPTH MIN.
  - 6" VALVE BOX EXTENSIONS AS REQUIRED
  - VALVE WIRING

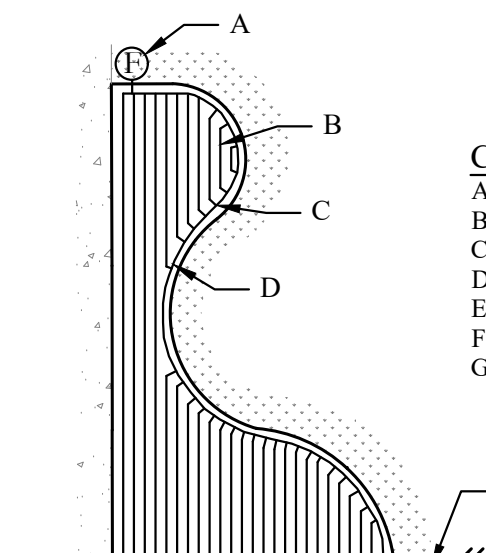

- CONSTRUCTION NOTES:**
- FLUSH VALVE
  - HUNTER PLD 06-18
  - HUNTER PLD TEE
  - TUBING STAKE
  - LATERAL TO PLD CONNECTION
  - DRIP CONTROL VALVE, MODEL ICZ-101
  - LATERAL PIPE TO PLANTING BED

#### DRIP IRRIGATION - BED

NOT TO SCALE

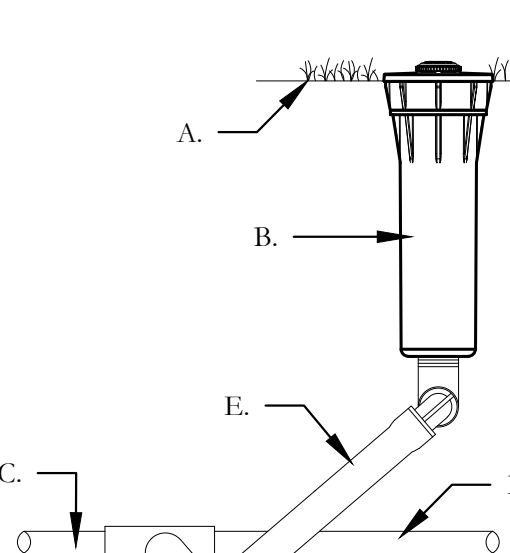


- GENERAL NOTES:**
- REST PIPE FIRMLY ON TRENCH BOTTOM.
  - SNAKE PIPE FROM SIDE TO SIDE.
  - DO NOT STACK PIPE IN TRENCH. PROVIDE HORIZONTAL SEPARATION.
  - MAINTAIN 2" MINIMUM SEPARATION BETWEEN MAINLINE AND LATERAL LINE PIPING.
  - BUNDLE WIRE(S) AT 20 FT. INTERVALS.

- CONSTRUCTION NOTES:**
- FINISHED GRADE
  - ROTOR HEAD PER PLANS
  - LATERAL TEE OR ELL
  - LATERAL PIPE
  - IPS FLEX PIPE

#### PRS40-CV - MP ROTATOR SPRAY HEAD

NOT TO SCALE

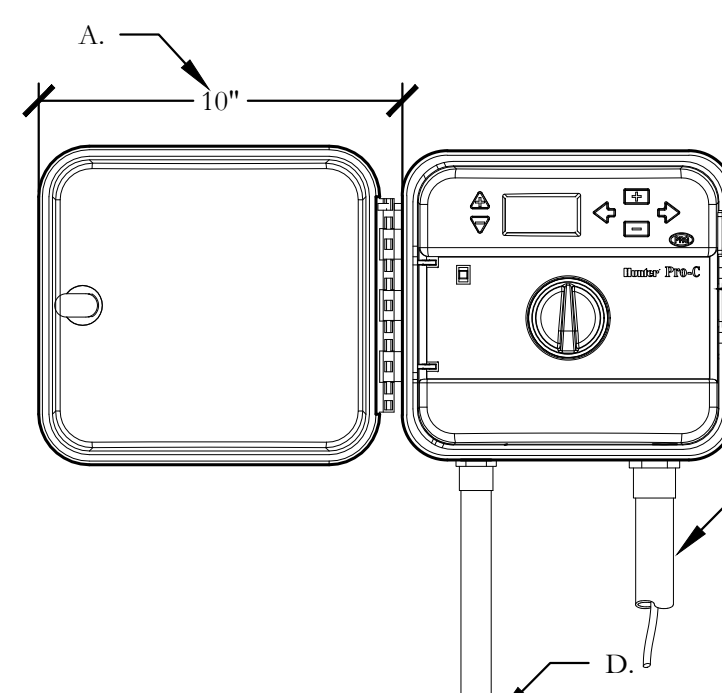


- GENERAL NOTES:**
- REST PIPE FIRMLY ON TRENCH BOTTOM.
  - SNAKE PIPE FROM SIDE TO SIDE.
  - DO NOT STACK PIPE IN TRENCH. PROVIDE HORIZONTAL SEPARATION.
  - MAINTAIN 2" MINIMUM SEPARATION BETWEEN MAINLINE AND LATERAL LINE PIPING.
  - BUNDLE WIRE(S) AT 20 FT. INTERVALS

- CONSTRUCTION NOTES:**
- MINIMAL CLEARANCE FOR OPENING
  - CONTROLLER MODEL AS LABELED ON LEGEND.
  - CONTROL WIRE IN ELECTRICAL CONDUIT SIZE AND TYPE PER LOCAL CODE.
  - ELECTRICAL SUPPLY CONDUIT. CONNECT TO POWER SOURCE. J BOX INSIDE CONTROLLER.


#### PRO-C CONTROLLER

NOT TO SCALE

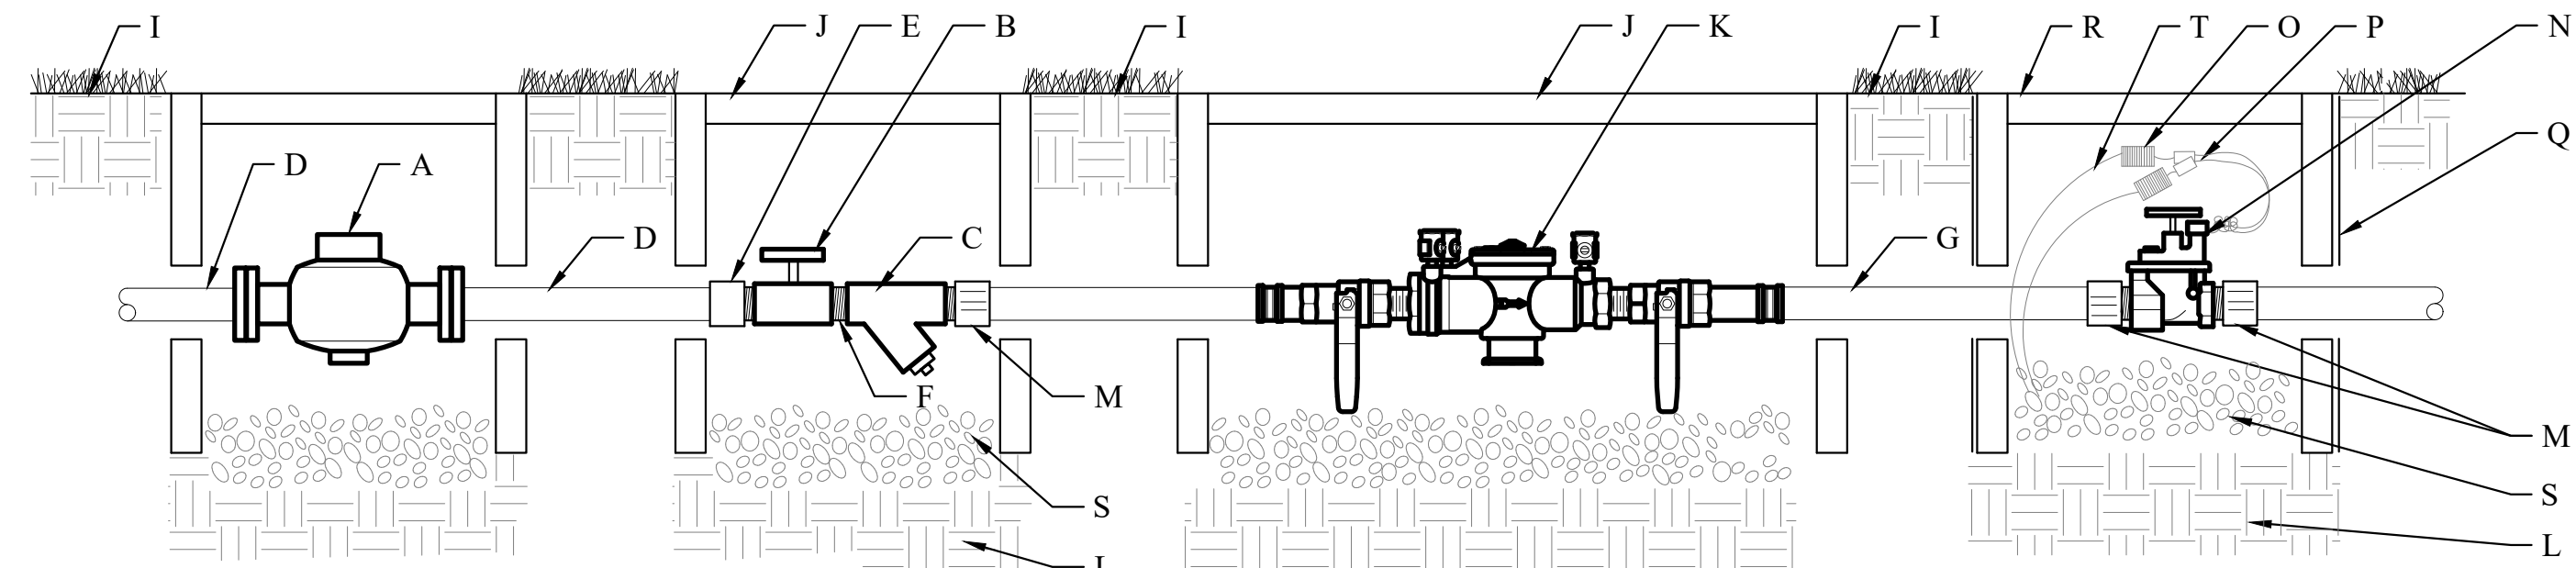

- CONSTRUCTION NOTES:**
- WATER METER (SIZE PER PLAN)
  - BALL VALVE (SIZE PER LINE)
  - WYE STRAINER (SIZE PER LINE)
  - TYPE "K" COPPER PIPE
  - COPPER SXT COUPLING
  - TBE NIPPLE
  - PIPE PER CITY CODE
  - COUPLING
  - FINISH GRADE
  - 12"x17" VALVE BOX. SET FLUSH WITH FINISH GRADE
  - DOUBLE CHECK VALVE ASSEMBLY
  - COMPACTED SUBGRADE
  - MALE ADAPTER
  - MASTER ELECTRIC VALVE
  - WIRE COIL
  - WATERPROOF WIRE CONNECTORS
  - 10 ML BLACK PLASTIC
  - 10" RD VALVE BOX. SET 1/2" ABOVE FINISH GRADE
  - WASHED PEA GRAVEL - 6" DEPTH MIN
  - VALVE WIRING

- GENERAL NOTES:**
- INSTALL WASHED PEA GRAVEL BELOW DCA TO ALLOW ACCESS TO TEST COCKS AND OPERATION OF BALL VALVES
  - INSTALL PEA GRAVEL FLUSH WITH ELECTRIC VALVE.
  - PROVIDE A 24" WIRE EXPANSION COIL AT EACH DRY SPLICE WIRE CONNECTION.
  - CENTER VALVE ASSEMBLY IN VALVE BOX.

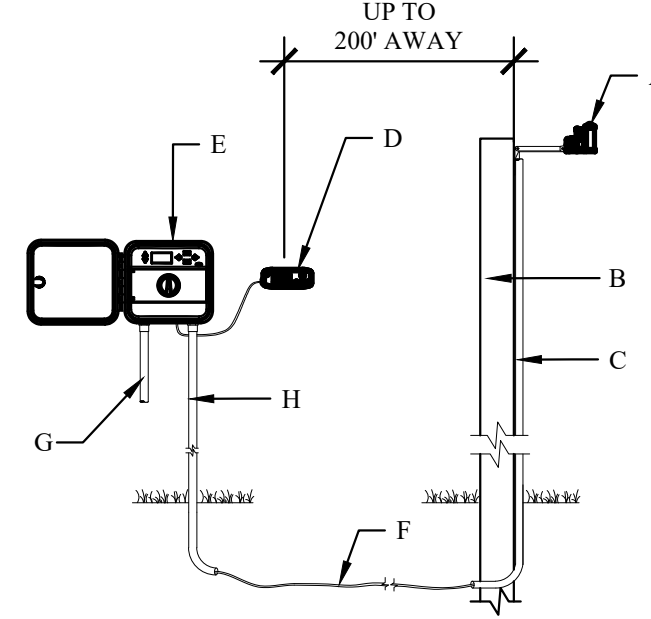

- CONSTRUCTION NOTES:**
- MODEL SOLAR SYNC SENSOR
  - SUITABLE POST, POLE, OR GUTTER MOUNT. MOUNT IN LOCATION WHERE SENSOR CAN RECEIVE FULL SUN, IS OPEN TO RAINFALL AND OUT OF SPRINKLER SPRAY PATTERN.
  - CONDUIT FROM SOLAR SYNC SENSOR TO CONTROLLER OR TO A POINT 12" BELOW GRADE.
  - MODEL SOLAR SYNC MODULE. MOUNT LESS THAN 6" AWAY FROM CONTROLLER. MODULE CAN BE MOUNTED INTERNALLY WHEN PAIRED WITH THE PCC CONTROLLER.\*
  - HUNTER PRO-C CONTROLLER
  - COMMUNICATION WIRE, 18-24 WIRE TYPE TO MEET INSTALLATION CODE REQUIREMENTS, FROM MODULE TO SENSOR. MAXIMUM TOTAL WIRE DISTANCE, 200 FEET.
  - POWER SOURCE
  - CONDUIT FOR VALVE CONTROL WIRE AND SOLAR SYNC COMMUNICATION WIRE

#### SOLAR SYNC SYSTEM (PRO-C CONTROLLER)

NOT TO SCALE

## LANDSCAPE AND SCREENING

### Irrigation Details

### Northgate Phase 1

City of Rockwall, Tarrant County, Texas

CJS PROJECT NO.

MJP001

SHEET NO.

IR7 of 7

LANDSCAPE PROVIDED

CLEM ROAD


- A. MINIMUM TWENTY (20) FOOT LANDSCAPE EDGE PROVIDED.  
B. 6' HT. ORNAMENTAL METAL FENCE PROVIDED.  
C. 1-4" CAL. CANOPY TREE / 50 LF OF LANDSCAPE EDGE  
717 LF OF FRONTAGE / 50 LF = 15 - 4" CAL. TREES REQUIRED.  
PROVIDED: 15 - 4" CALIPER CANOPY TREES PROVIDED

STODGHILL ROAD (F.M. 3549)

- A. MINIMUM THIRTY (30) FOOT LANDSCAPE EDGE PROVIDED.  
B. 6' HT. ORNAMENTAL METAL FENCE PROVIDED.  
C. 1-4" CAL. CANOPY TREE / 35 LF OF LANDSCAPE EDGE  
1,524 LF OF FRONTAGE / 35 LF = 44 - 4" CAL. TREES REQUIRED.  
PROVIDED: 44 - 4" CALIPER CANOPY TREES PROVIDED  
D. 4-2" CAL. ORNAMENTAL TREE / 100 LF OF FRONTAGE  
1,524 LF OF FRONTAGE / 100 LF x 4 = 61 - 2" CAL. TREES REQUIRED.  
PROVIDED: 61 - 2" CALIPER ORNAMENTAL TREES PROVIDED


OPEN SPACE LOT 17, BLOCK B

- A. PROVIDED 40 - 4" CALIPER CANOPY TREES.  
PROVIDED 968 SF OF ORNAMENTAL GRASSES.  
REMAINDER OF OPEN SPACE SHALL BE HYDROMULCHED WITH  
NATIVE DRAINFIELD SEED MIX BY NATIVE AMERICAN SEED CO.

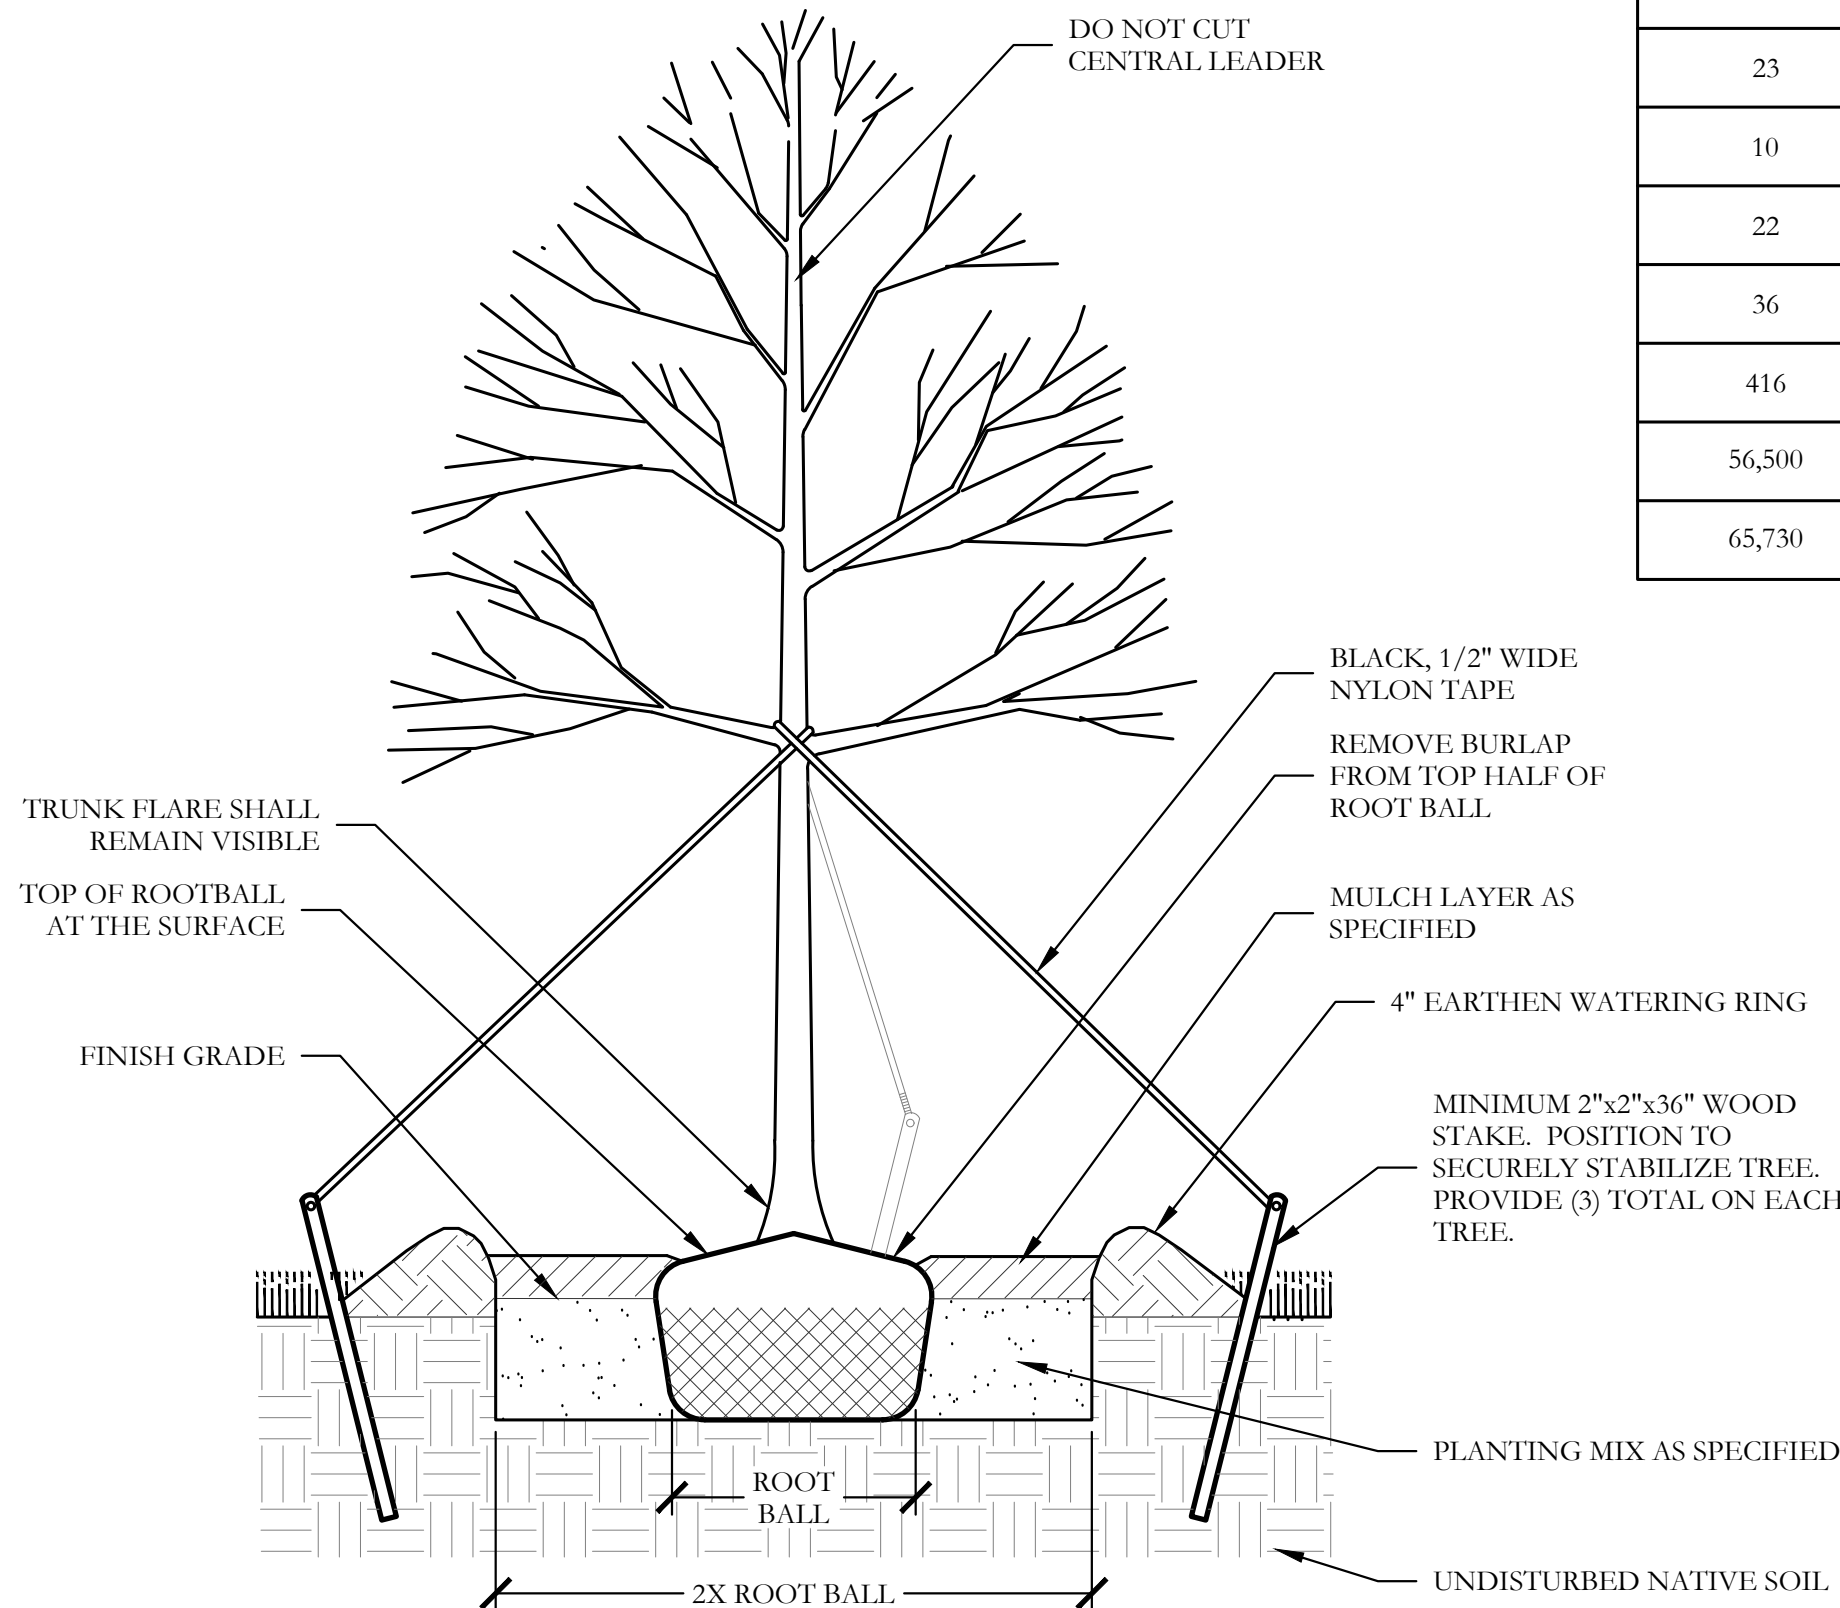


1 TYPICAL TREE PLANTING SECTION

NOT TO SCALE

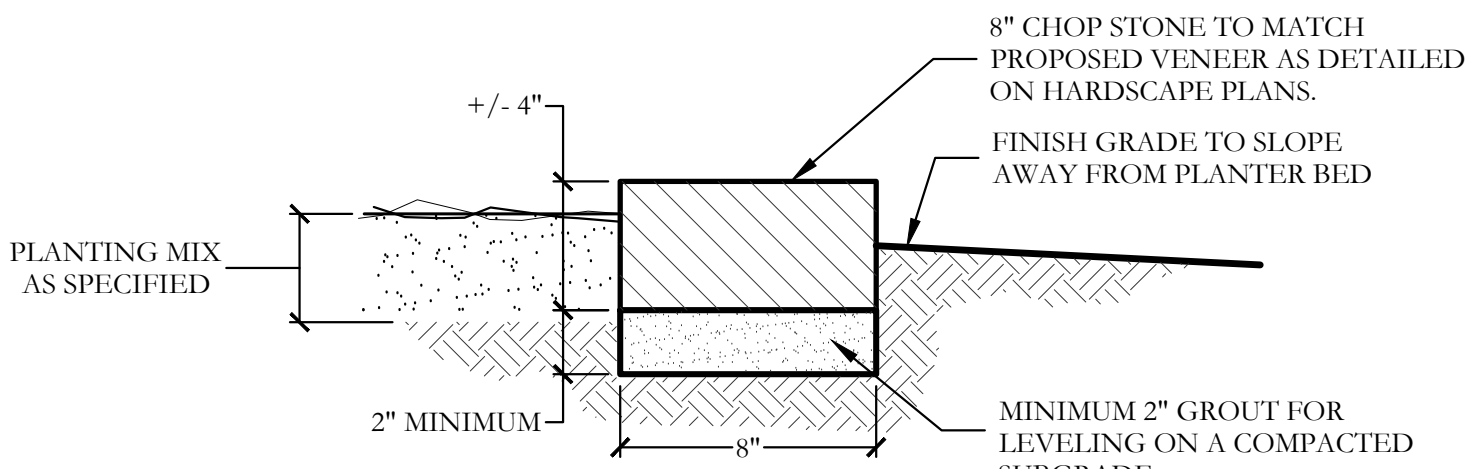


3 8" CHOP STONE EDGING DETAIL SECTION

NOT TO SCALE

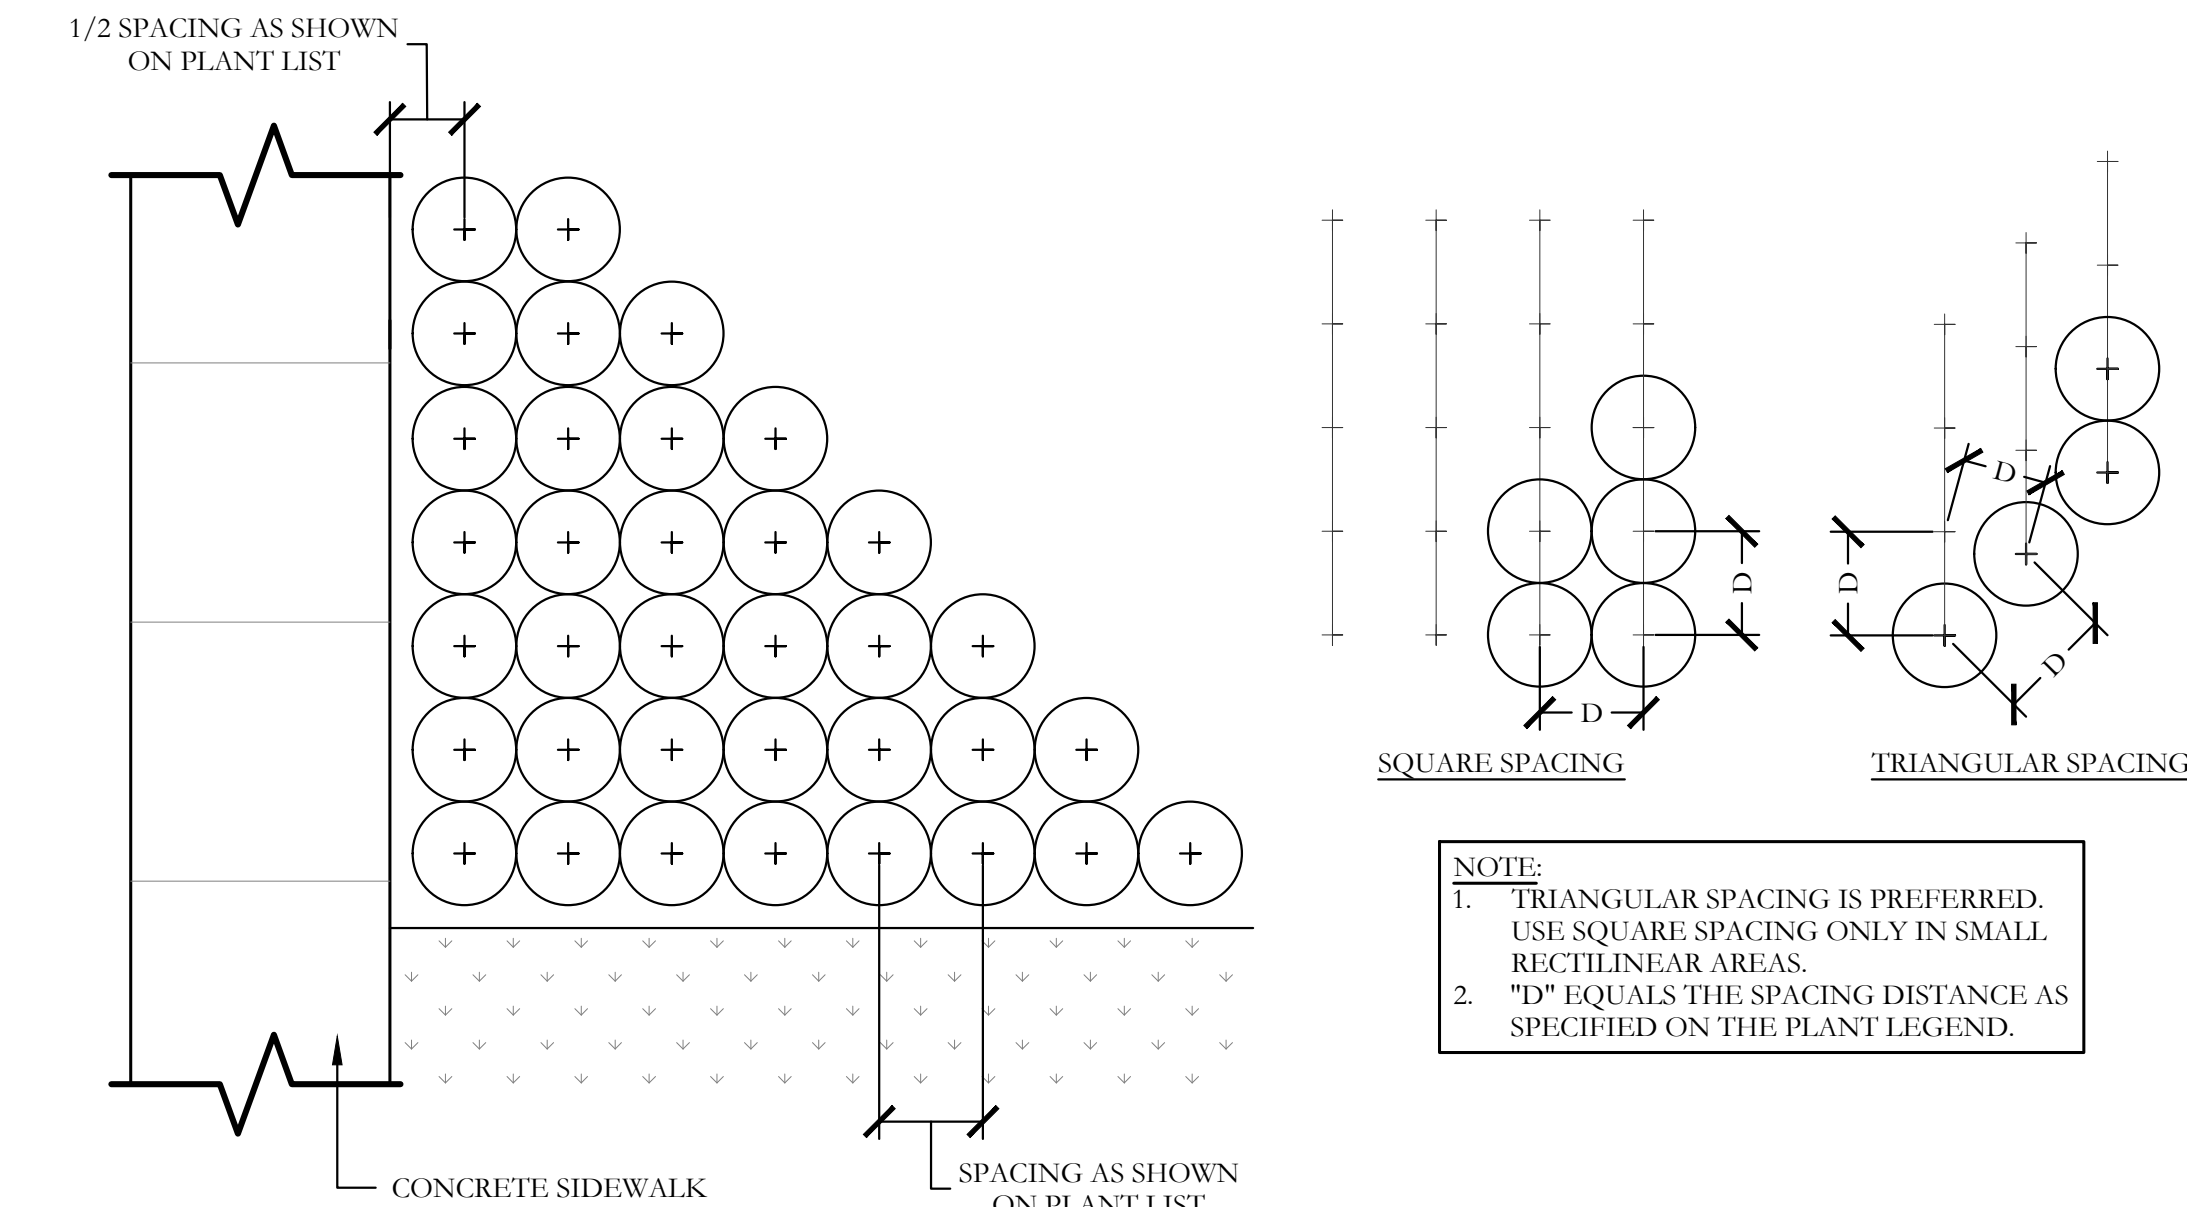

2 TYPICAL SHRUB AND GROUNDCOVER PLANTING PLAN/SECTION

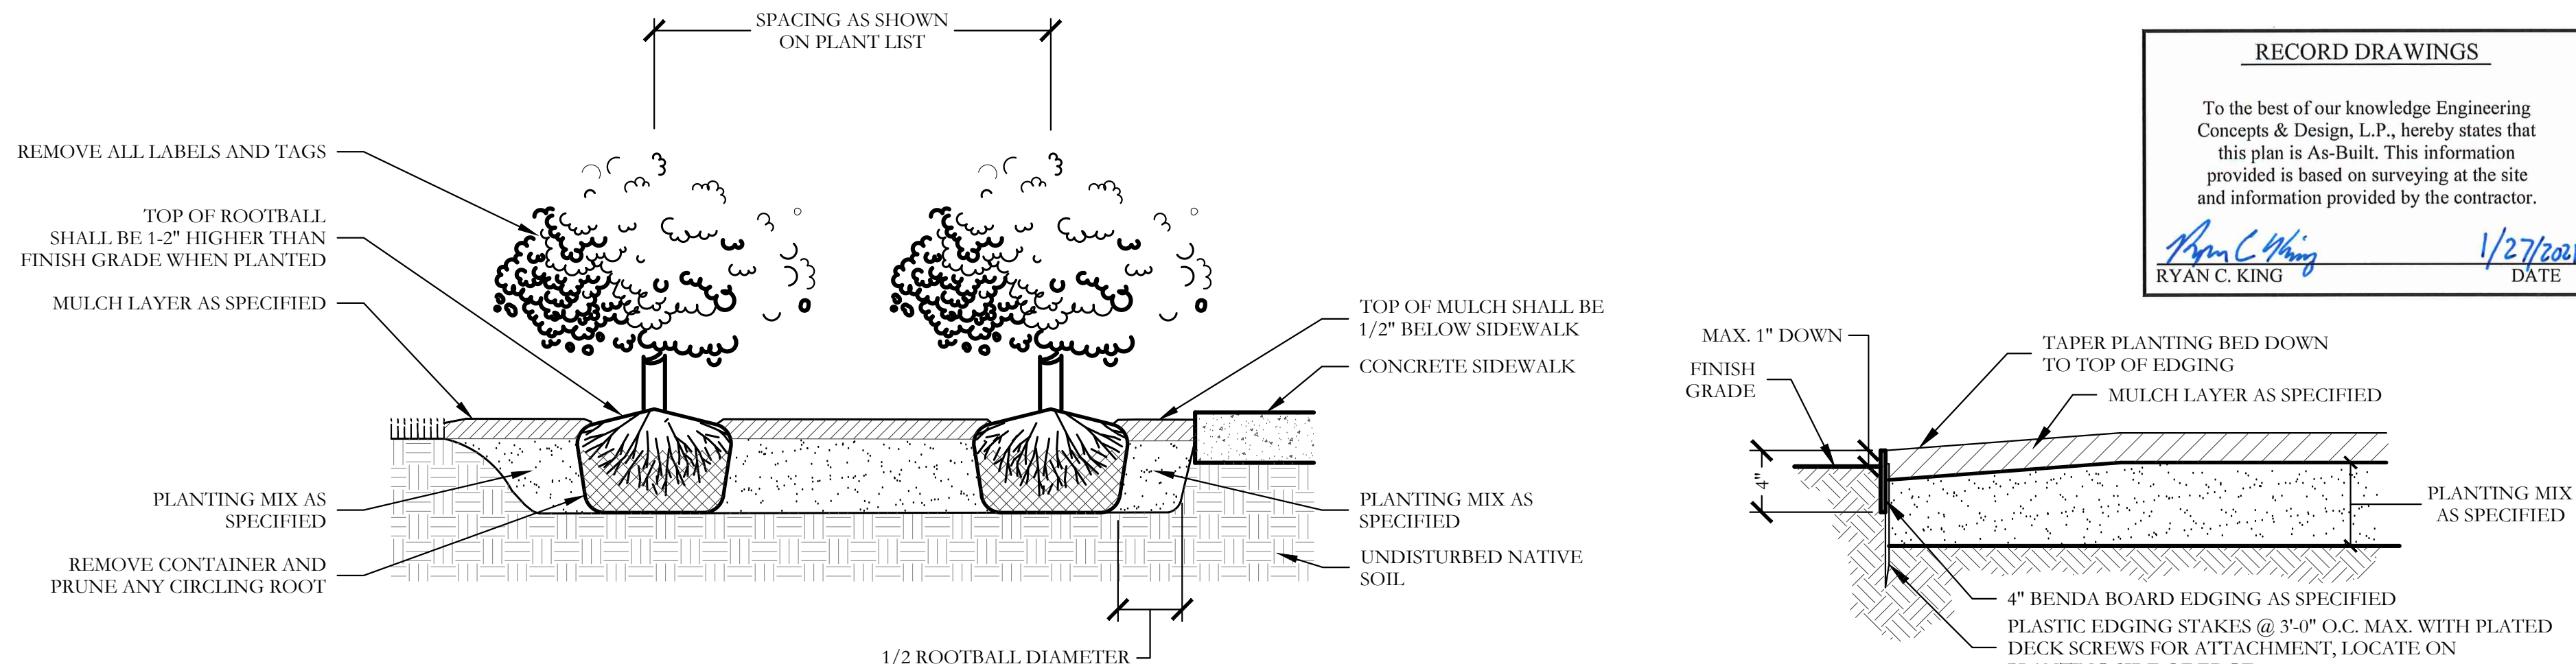

4 BENDER BOARD EDGING DETAIL SECTION

NOT TO SCALE

NOT TO SCALE

PLANT LIST

ESTM. QUANTITY	KEY	COMMON NAME	SCIENTIFIC NAME	SIZE	SPACING	REMARKS
11	LO	LIVE OAK	QUERCUS VIRGINIANA	4" CALIPER	AS SHOWN	NURSERY GROWN; FULL HEAD; MINIMUM BRANCHING HEIGHT AT 6'-0"; MINIMUM 10'-0" OVERALL HEIGHT.
14	LE	LACEBARK ELM	ULMUS PARVIFOLIA	4" CALIPER	AS SHOWN	NURSERY GROWN; FULL HEAD; MINIMUM BRANCHING HEIGHT AT 6'-0"; MINIMUM 10'-0" OVERALL HEIGHT.
11	CP	CHINESE PISTACHE	PISTACIA CHINENSIS	4" CALIPER	AS SHOWN	NURSERY GROWN; FULL HEAD; MINIMUM BRANCHING HEIGHT AT 6'-0"; MINIMUM 10'-0" OVERALL HEIGHT.
12	CE	CEDAR ELM	ULMUS CRASSIFOLIA	4" CALIPER	AS SHOWN	NURSERY GROWN; FULL HEAD; MINIMUM BRANCHING HEIGHT AT 6'-0"; MINIMUM 10'-0" OVERALL HEIGHT.
51	ERC	EASTERN RED CEDAR (PROVIDED BY OWNER)	JUNIPERUS VIRGINIANA	MINIMUM 4" CALIPER	AS SHOWN	NURSERY GROWN; FULL HEAD; MINIMUM BRANCHING HEIGHT AT 6'-0"; MINIMUM 10'-0" OVERALL HEIGHT.
25	V	CHASTE TREE	VITEX ANGUS-CASTUS	2" CALIPER	AS SHOWN	NURSERY GROWN; FULL HEAD; MINIMUM 8'-0" OVERALL HEIGHT.
38	DW	DESERT WILLOW	CHILOPSIS LINEARIS	2" CALIPER	AS SHOWN	NURSERY GROWN; FULL HEAD; MINIMUM 8'-0" OVERALL HEIGHT.
2	BA	BLUE ATLAS CEDAR	CEDRUS ATLANTICA 'GLAUCA'	2" CALIPER	AS SHOWN	NURSERY GROWN; FULL HEAD; MINIMUM 8'-0" OVERALL HEIGHT.
11		TEXAS SAGE	LEUCOPHYLLUM FRUTESCENS	5 GALLON	48" O.C.	CONTAINER GROWN; FULL PLANT.
23		UPRIGHT ROSEMARY	ROSMARINUS OFFICINALIS 'UPRIGHT'	5 GALLON	36" O.C.	CONTAINER GROWN; FULL PLANT.
10		MORNING LIGHT MISCANTHUS	MISCANTHUS SINENSIS 'MORNING LIGHT'	5 GALLON	36" O.C.	CONTAINER GROWN; FULL PLANT.
22		GOLD STAR JUNIPER	JUNIPERUS CHINENSIS 'BAKAUREA'	5 GALLON	48" O.C.	CONTAINER GROWN; FULL PLANT.
36		SHORE JUNIPER	JUNIPERUS CONFERTA 'BLUE PACIFIC'	5 GALLON	36" O.C.	CONTAINER GROWN; FULL PLANT.
416		GULF MUHLY GRASS	MUHLENBERGIA CAPILLARIS 'REGAL MIST'	5 GALLON	36" O.C.	CONTAINER GROWN; FULL PLANT.
56,500		COMMON BERMUDA GRASS	CYNODON DACTYLON	SQUARE FEET	SOLID SOD	MINIMUM 100% COVERAGE ALL AREAS SHOWN
65,730		NATIVE DRAINFIELD SEED MIX	BY NATIVE AMERICAN SEED CO.	SQUARE FEET	HYDROMULCH	MINIMUM 75% DENSITY ALL AREAS SHOWN

GENERAL LANDSCAPE NOTES

INSPECTIONS:

- NO EXCAVATION SHALL OCCUR IN CITY R.O.W. WITHOUT A R.O.W. PERMIT-CONTACT THE PUBLIC WORKS DEPARTMENT.
- THE CONTRACTOR SHALL MARK ALL WATER LINES, SEWER LINES, AND TREE LOCATIONS PRIOR TO CALLING FOR ROW INSPECTION AND PERMIT.
- THE LANDSCAPE INSTALLATION SHALL COMPLY WITH APPROVED LANDSCAPE DRAWINGS PRIOR TO FINAL ACCEPTANCE BY THE CITY AND ISSUANCE OF A CERTIFICATE OF OCCUPANCY.
- WATER METERS, CLEANOUTS AND OTHER APPURTENANCES, SHALL BE ACCESSIBLE, ADJUSTED TO GRADE, CLEARLY MARKED WITH FLAGGING AND COMPLIANT WITH PUBLIC WORKS DEPARTMENT STANDARDS PRIOR TO CALLING FOR FINAL LANDSCAPE AND ROW INSPECTIONS.

LANDSCAPE STANDARDS:

- PLANTINGS AND LANDSCAPE ELEMENTS SHALL COMPLY WITH THE CITY'S ENGINEERING DESIGN STANDARDS, PUBLIC R.O.W. VISIBILITY REQUIREMENTS.
- UNLESS OTHERWISE SPECIFIED, TREES SHALL BE PLANTED NO LESS THAN 4' FROM CURBS, SIDEWALKS, UTILITY LINES, SCREENING WALLS AND OTHER STRUCTURES. THE CITY HAS FINAL APPROVAL FOR ALL TREE PLACEMENTS.
- A MINIMUM THREE FEET (3') RADIUS AROUND A FIRE HYDRANT MUST REMAIN CLEAR OF LANDSCAPE PURSUANT TO THE FIRE CODE.
- STREET TREES, WHERE REQUIRED, SHALL BE (10') MINIMUM FROM THE EDGE OF A STORM SEWER CURB INLET BOX AND THE EDGE OF THE ROOT BALL SHALL BE (4') MINIMUM FROM THE WATER METER.
- THE AMERICAN STANDARD FOR NURSERY STOCK (ANSI Z60.1-2004) SPECIFICATIONS SHALL GOVERN PLANT QUALIFICATIONS, GRADES, AND STANDARDS.
- TREE PLANTING SHALL COMPLY WITH DETAILS HEREIN AND THE INTERNATIONAL SOCIETY OF ARBORICULTURE (ISA) STANDARDS.
- A 2-3" LAYER OF MULCH SHALL BE PROVIDED AROUND THE BASE OF THE PLANTED TREE. THE MULCH SHALL BE PULLED BACK 4" FROM THE TRUNK OF THE TREE.
- TREE PITS SHALL BE TESTED FOR WATER PERCOLATION. IF WATER DOES NOT DRAIN OUT OF TREE PIT WITHIN 24 HOURS, THE TREE SHALL BE MOVED OR DRAINAGE SHALL BE PROVIDED.
- ALL BEDS TO HAVE 3" OF COMPOSTED SOIL, LIVING EARTH TECHNOLOGY, OR APPROVED EQUAL TILLED AND TURNED TO A DEPTH OF 7" MINIMUM.
- ALL PLANT BEDS SHALL BE TOP-DRESSED WITH A MINIMUM OF 3 INCHES OF HARDWOOD MULCH.
- NATIVE SITE TOPSOIL IS TO BE PROTECTED FROM EROSION OR STOCKPILED. NATIVE SITE TOPSOIL SHALL BE LABORATORY TESTED BY AND ACCREDITED LABORATORY AND AMENDED PER SAID LABORATORY'S RECOMMENDATIONS.
- NO LANDSCAPE INCLUDING TREES IN RIGHT-OF-WAY.
- ALL RIGHT-OF-WAY TO BE SODDED.
- NO TREES WITH 5'-0" FROM ANY PUBLIC WATER, SANITARY SEWER, OR STORM LINE LESS THAN 10" AND 10'-0" FROM ANY PUBLIC WATER, SANITARY SEWER, OR STORM GREATER THAN OR EQUAL TO 10".

IRRIGATION STANDARDS:

- ANY CHANGES TO THESE APPROVED IRRIGATION DRAWINGS SHALL BE AUTHORIZED BY THE CITY.
- CONTACT DEVELOPMENT SERVICES FOR AN IRRIGATION PERMIT PRIOR TO INSTALLING THE IRRIGATION SYSTEM.
- IRRIGATION OVER-SPRAY ON STREETS AND WALKS IS PROHIBITED.
- MAINLINES, VALVES, OR CONTROL WIRES SHALL NOT BE LOCATED IN THE CITY'S ROW.
- ET IRRIGATION CONTROLLERS SHALL BE PROGRAMMED AND ADJUSTED TO NOT EXCEED THE LANDSCAPE WATER ALLOWANCE (LWA) PRIOR TO APPROVAL OF LANDSCAPE INSTALLATION.
- VALVES SHALL BE LOCATED A MINIMUM OF (3') AWAY FROM STORM SEWERS, AND SANITARY SEWER LINES AND 5 FEET FROM CITY FIRE HYDRANTS AND WATER VALVES.
- THE BORE DEPTH UNDER STREETS, DRIVE AISLES, AND FIRE LANES SHALL PROVIDE (2') OF CLEARANCE (MINIMUM).
- IRRIGATION HEADS THAT RUN PARALLEL AND NEAR PUBLIC WATER AND SANITARY SEWER LINES; SHALL BE FED FROM STUBBED LATERALS OR BULL-BEADS. A MINIMUM FIVE FOOT (5') SEPARATION IS REQUIRED BETWEEN IRRIGATION MAIN LINES AND LATERALS THAT RUN PARALLEL TO PUBLIC WATER AND SANITARY SEWER LINES.
- NO VALVES, BACKFLOW PREVENTION ASSEMBLIES, QUICK COUPLERS ETC. SHALL BE LOCATED CLOSER THAN 10' FROM THE CURB AT STREET OR DRIVE INTERSECTION.

MAINTENANCE STANDARDS:

- THE OWNER SHALL BE RESPONSIBLE FOR THE ESTABLISHMENT, MAINTENANCE, AND VIGOR OF PLANT MATERIAL IN ACCORDANCE WITH THE DESIGN INTENT AND AS APPROPRIATE FOR THE SEASON OF THE YEAR.
- LANDSCAPE AND OPEN AREAS SHALL BE FREE OF TRASH, LITTER AND WEEDS.
- NO PLANT MATERIAL SHALL BE ALLOWED TO ENCRONCH ON R.O.W., SIDEWALKS OR EASEMENTS TO THE EXTENT THAT VISION OR ROUTE OF TRAVEL FOR VEHICULAR, PEDESTRIAN, OR BICYCLE TRAFFIC IS IMPEDED.
- TREE MAINTENANCE SHALL BE IN ACCORDANCE WITH THE STANDARDS OF THE INTERNATIONAL SOCIETY OF ARBORICULTURE.
- TREE STAKING MATERIALS, IF USED, SHALL BE REMOVED AFTER (1) GROWING SEASON, NO MORE THAN (1) YEAR AFTER INSTALLATION (STEEL TREE STAKES, WIRES, AND HOSES ARE PROHIBITED).

TREE PROTECTION NOTES:

- CONTACT DEVELOPMENT SERVICES FOR A TREE REMOVAL PERMIT PRIOR TO REMOVAL OR TRANSPLANTING OF ANY TREES.
- ALL TREES WHICH ARE TO REMAIN ON SITE SHALL BE PROTECTED WITH A (4') TALL BRIGHTLY COLORED PLASTIC FENCE, OR SILT FENCE, PLACED AT THE DRIP LINE OF THE TREES.
- PRIOR TO THE PRE-CONSTRUCTION MEETING OR OBTAINING A GRADING PERMIT, ALL TREE MARKINGS AND PROTECTIVE FENCING SHALL BE INSTALLED BY THE OWNER AND BE INSPECTED BY DEVELOPMENT SERVICES.
- NO EQUIPMENT SHALL BE CLEANED, OR HARMFUL LIQUIDS DEPOSITED WITHIN THE LIMITS OF THE ROOT ZONE OF TREES WHICH REMAIN ON SITE.
- NO SIGNS, WIRES, OR OTHER ATTACHMENTS SHALL BE ATTACHED TO ANY TREE TO REMAIN ON SITE.
- VEHICULAR AND CONSTRUCTION EQUIPMENT SHALL NOT PARK OR DRIVE WITHIN THE LIMITS OF THE DRIP LINE.
- GRADE CHANGES IN EXCESS OF 3 INCHES (CUT OR FILL) SHALL NOT BE ALLOWED WITHIN A ROOT ZONE, UNLESS ADEQUATE TREE PRESERVATION METHODS ARE APPROVED BY THE CITY.
- NO TRENCHING SHALL BE ALLOWED WITHIN THE DRIP-LINE OF A TREE, UNLESS APPROVED BY THE CITY.
- ALL REMOVED TREES SHALL BE CHIPPED AND USED FOR MULCH ON SITE OR HAULED OFF-SITE.
- ALL TREE MAINTENANCE TECHNIQUES SHALL BE IN CONFORMANCE WITH INDUSTRY IDENTIFIED STANDARDS. IMPROPER OR MALICIOUS PRUNING TECHNIQUES ARE STRICTLY PROHIBITED.



RECORD DRAWINGS

To the best of our knowledge Engineering Concepts & Design, L.P., hereby states that this plan is As-Built. This information provided is based on surveying at the site and information provided by the contractor.

Ryan C. King  
DATE

1/27/2021  
DATE

CODY JOHNSON  
s.t.u.d.i.o

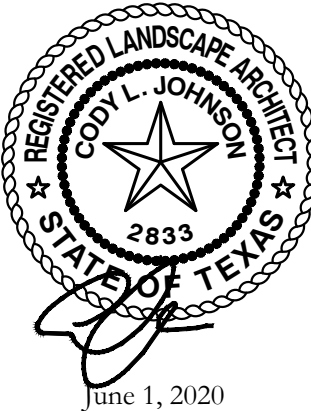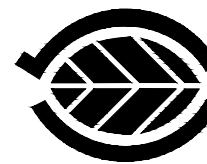

Bar is one inch on original drawing. If not one inch on this sheet, adjust scale as necessary.

One Inch

SCREENING AND BUFFERING

Landscape Details

Northgate Phase 1

City of Rockwall, Tarrant County, Texas


CJS PROJECT NO.

MJP001

SHEET NO.

L6 of 6




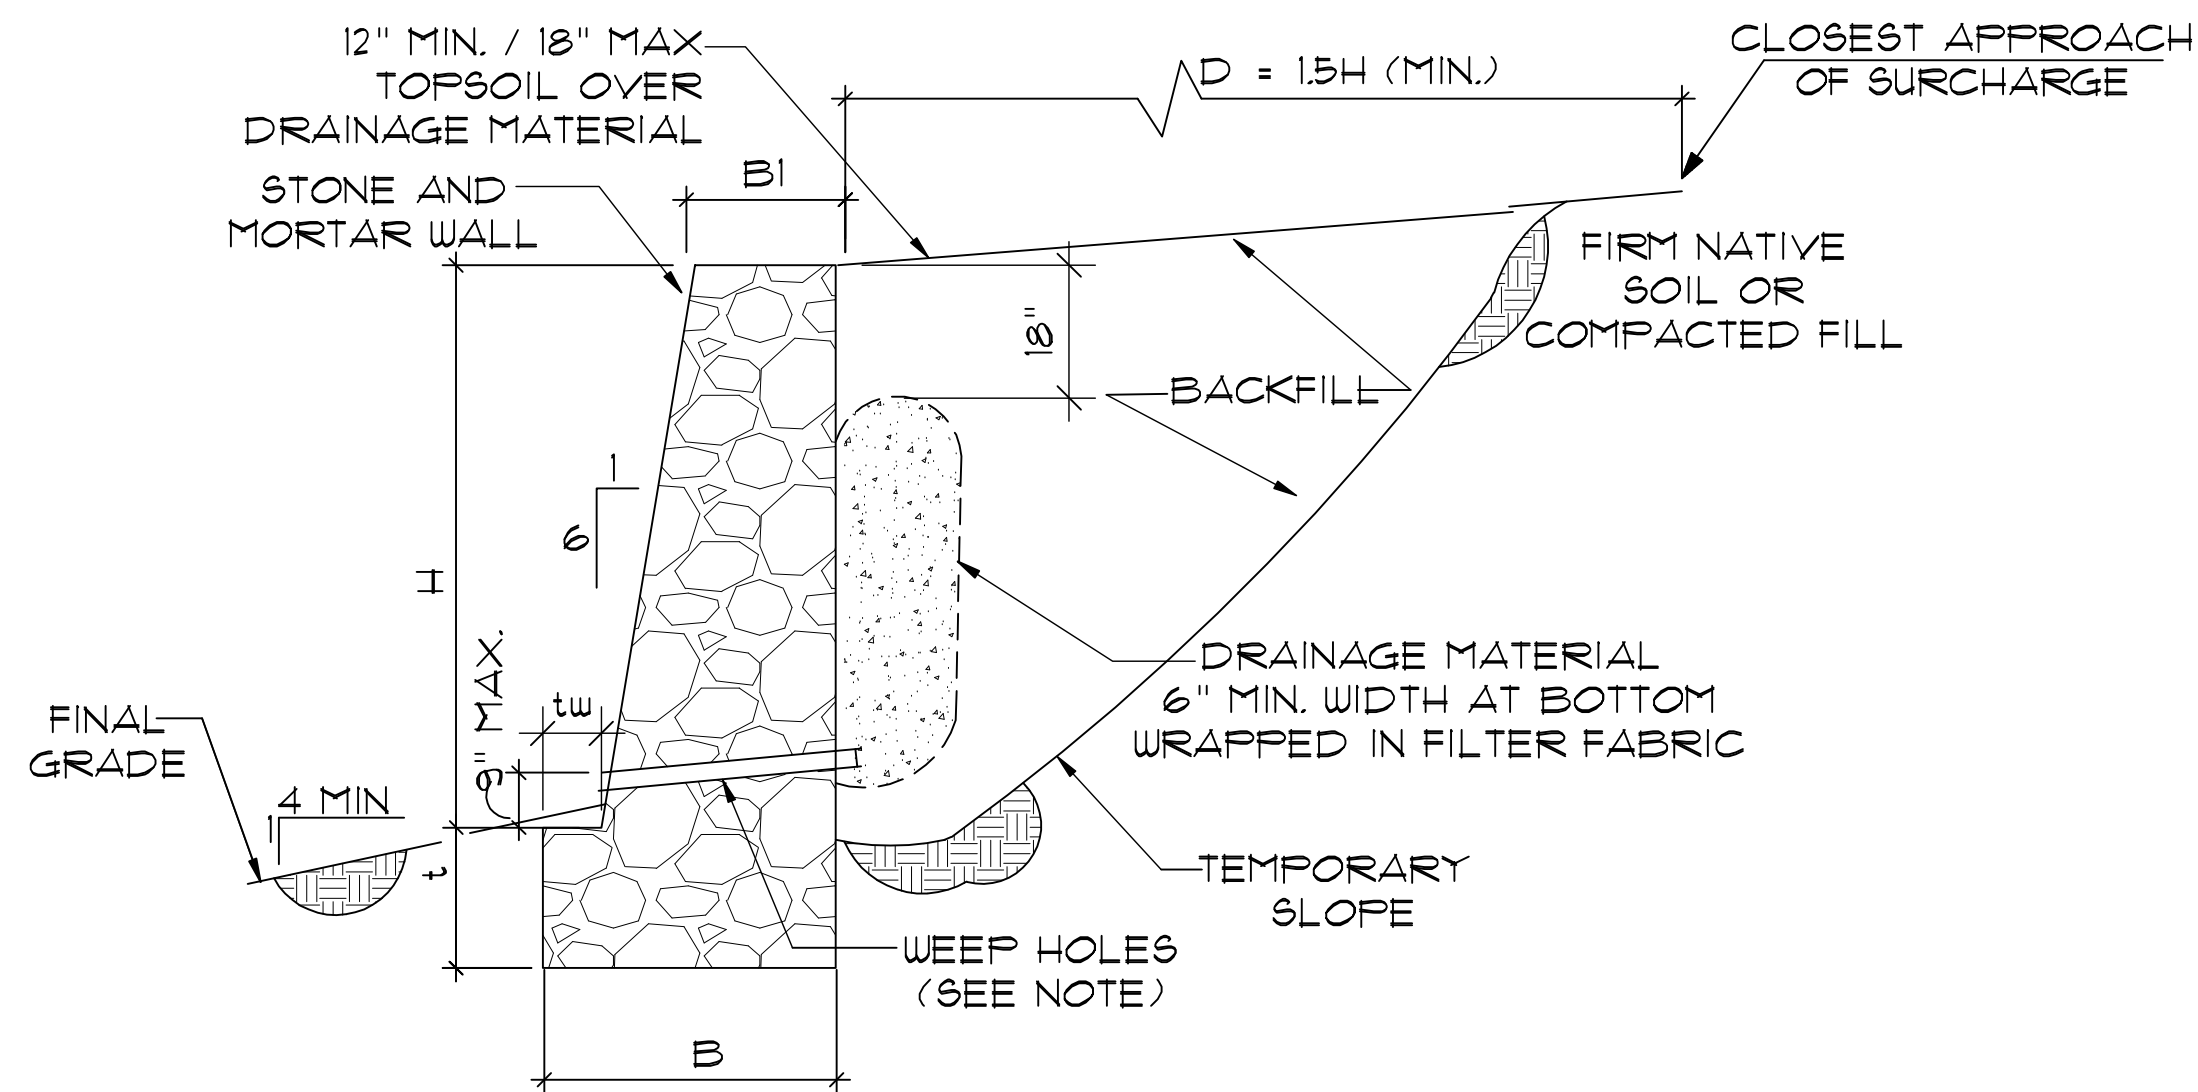

TYPICAL RETAINING WALL SECTION  
WALLS 4'-0" OR LESS IN HEIGHT

WALL SCHEDULE				
HEIGHT (H)	1.5'	2'	3'	4'
BASE WIDTH (B)	15"	16"	22"	25"
TOP WIDTH (BI)	12"	12"	12"	12"
EMBEDMENT (t)	6"	9"	10"	12"
TOE WIDTH (tw)	0"	0"	2"	5"

SCHEDULE-SURCHARGE				
HEIGHT (H)	1.5'	2'	3'	4'
BASE WIDTH (B)	18"	20"	28"	31"
TOP WIDTH (BI)	12"	12"	12"	12"
EMBEDMENT (t)	6"	11"	13"	15"
TOE WIDTH (tw)	3"	4"	10"	11"

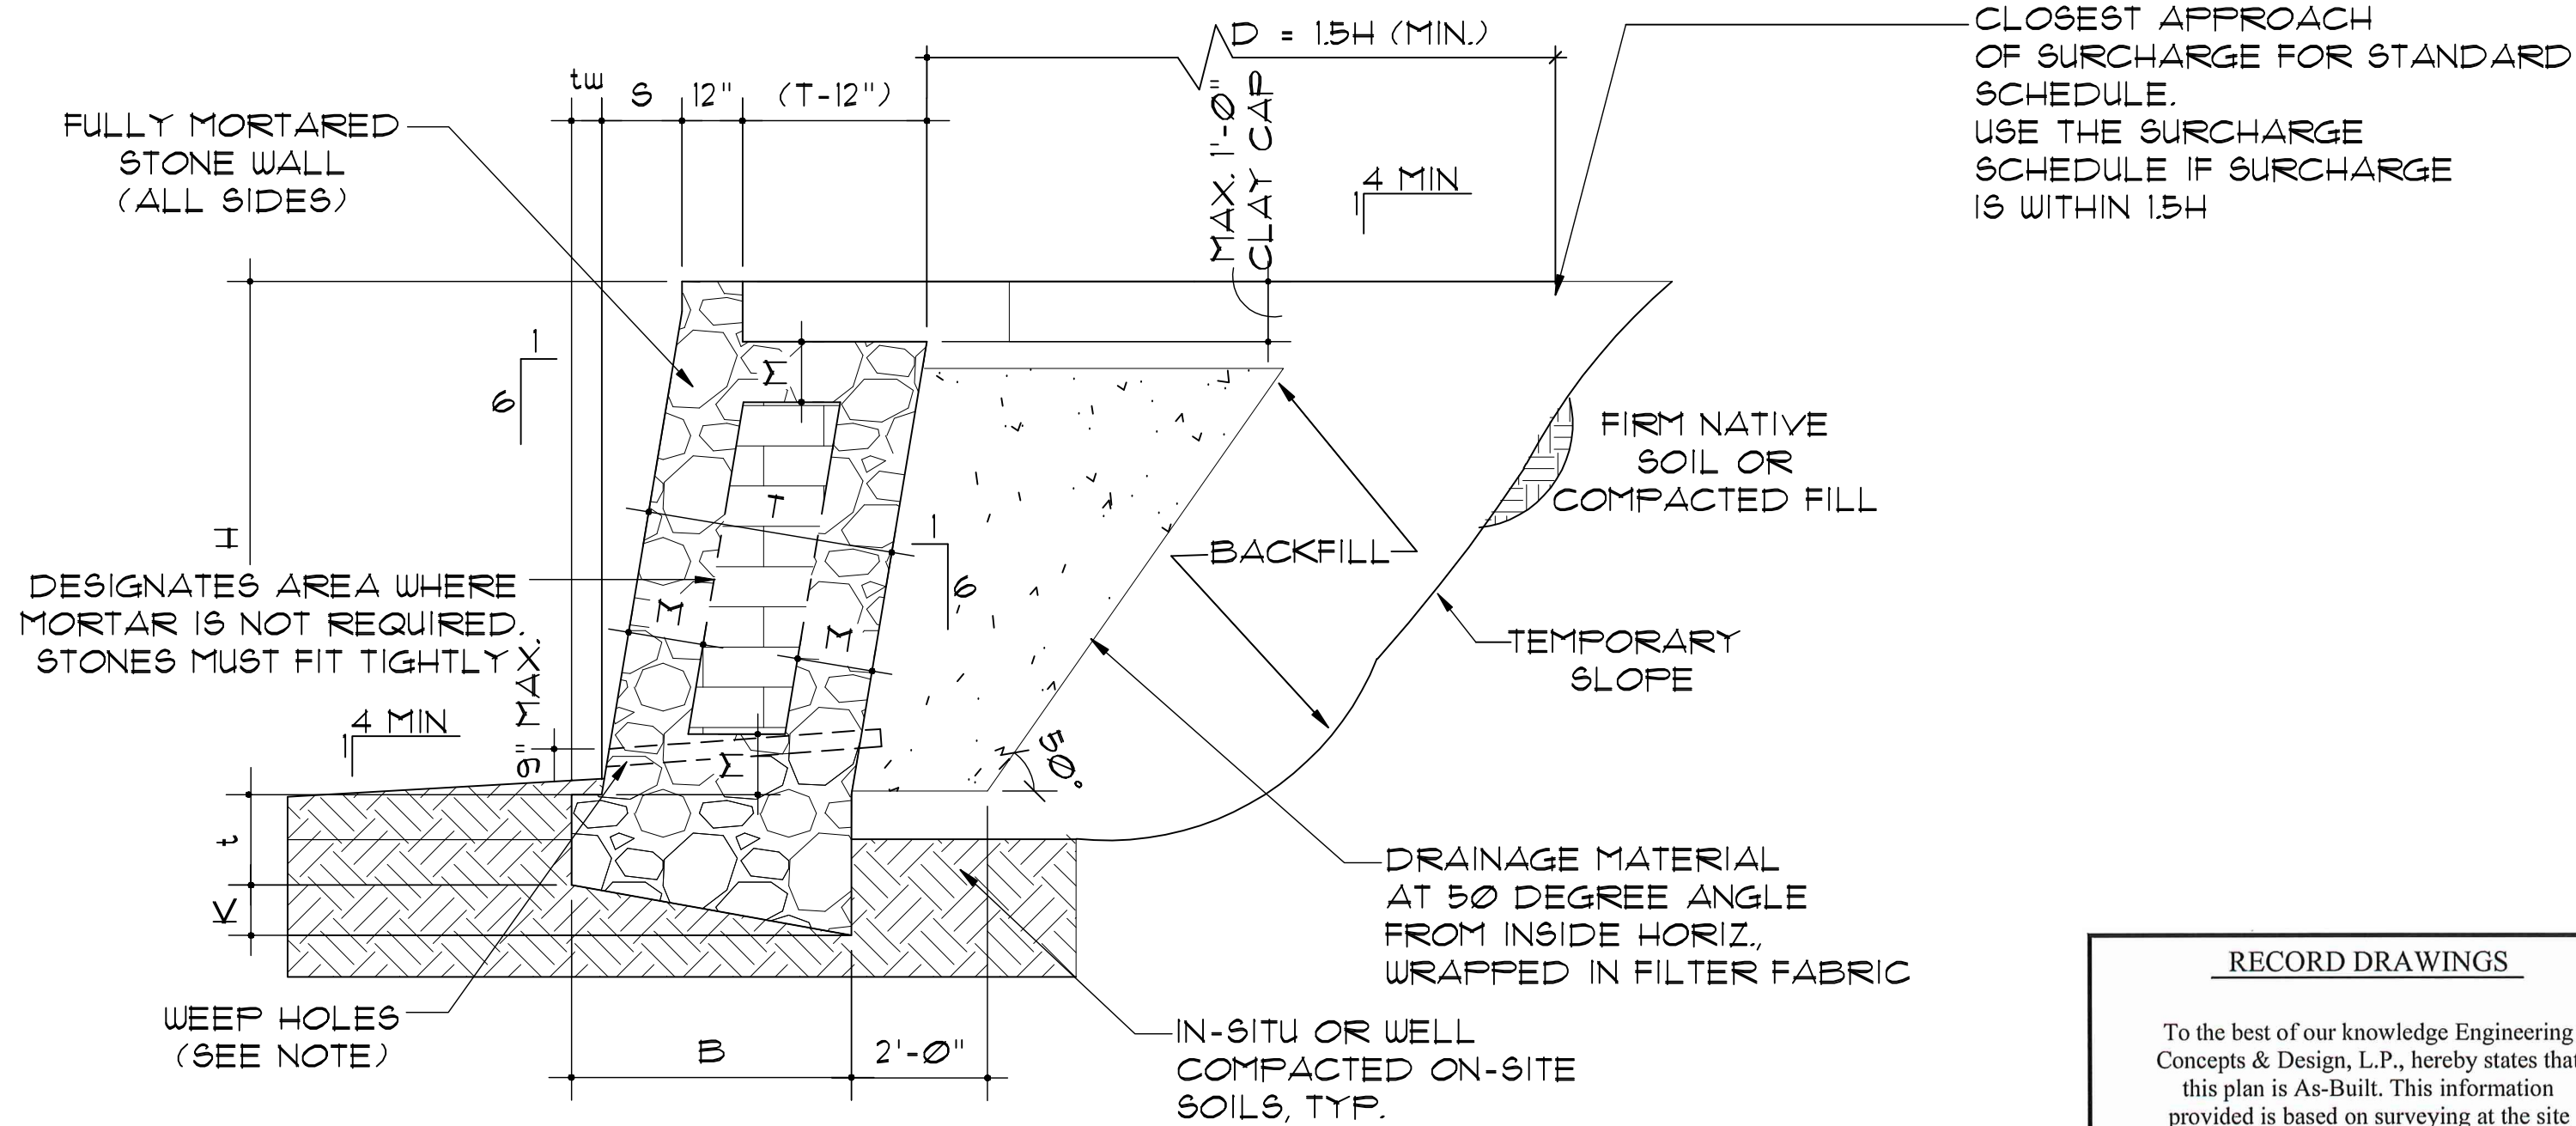

TYPICAL RETAINING WALL SECTION  
WALLS 5'-0" to 6'-0" IN HEIGHT

WALL SCHEDULE - STANDARD														
HEIGHT (H)	5'	6'												
BASE WIDTH (B)	21"	30"												
WALL THKNS (T)	23"	27"												
EMBEDMENT (t)	12"	12"												
MORTAR THICKNESS (M)	8"	10"												
BATTER WIDTH (S)	10"	12"												
KEY DEPTH (K)	5"	6"												
TOE WIDTH (tw)	2"	3"												
ALLOWABLE BEARING PRESSURE	1500 PSF													

#### SURCHARGE SCHEDULE

WALL SCHEDULE - SURCHARGE LOADING														
HEIGHT (H)	5'	6'												
BASE WIDTH (B)	34"	37.5"												
WALL THKNS (T)	29"	34"												
EMBEDMENT (t)	15"	15"												
MORTAR THICKNESS (M)	10"	12.5"												
BATTER WIDTH (S)	10"	12"												
KEY DEPTH (K)	6.5"	7.5"												
TOE WIDTH (tw)	2.5"	4"												
ALLOWABLE BEARING PRESSURE	1500 PSF													

RECORD DRAWINGS

To the best of our knowledge Engineering Concepts & Design, L.P., hereby states that this plan is As-Built. This information provided is based on surveying at the site and information provided by the contractor.

*Ryan C. King*  
RYAN C. KING  
1/27/2021  
DATE

REVISIONS

THE ENGINEER'S SEAL ON THIS PLAN WAS ELECTRONICALLY AFFIXED BY LORI KOTRAMP ON JUNE 9, 2021.

STATE OF TEXAS  
LORI KOTRAMP  
93691  
Professional Engineer  
Civil

**D&E STRUCTURES**  
CONSULTING ENGINEERS  
TX FIRM REG. #F-870

1010 E. ARAPHO ROAD, SUITE 106  
RICHARDSON, TX 75081 214-741-3095

WALLCO RETAINING WALLS, INC.  
NORTHGATE  
ROCKWALL, TEXAS  
PLAN: STANDARD RW NOTES AND DETAILS  
OFF N. STODGHILL RD & CLEM RD

JOB #  
260772-1  
DATE  
06/09/20  
DRAWN BY  
CHECKED BY  
LK  
SHEET  
**S1.01**