

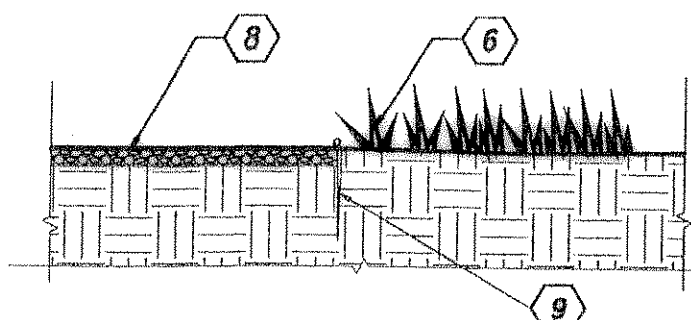



**1 SODDING WITH PINS**  
L2 SCALE: NTS

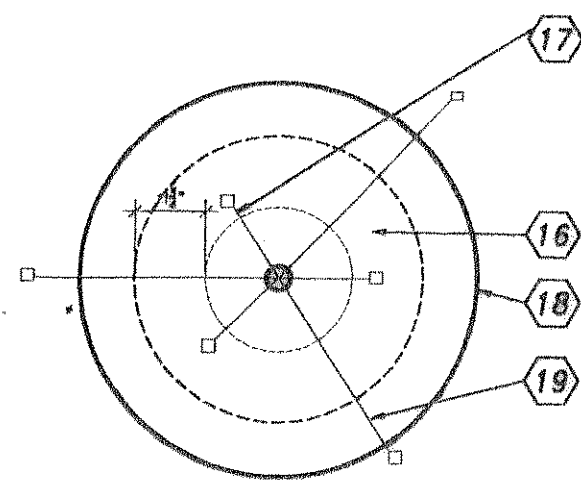


**2 GRAVEL/LANDSCAPE FABRIC**  
L2 SCALE: 3/8" = 1'-0"

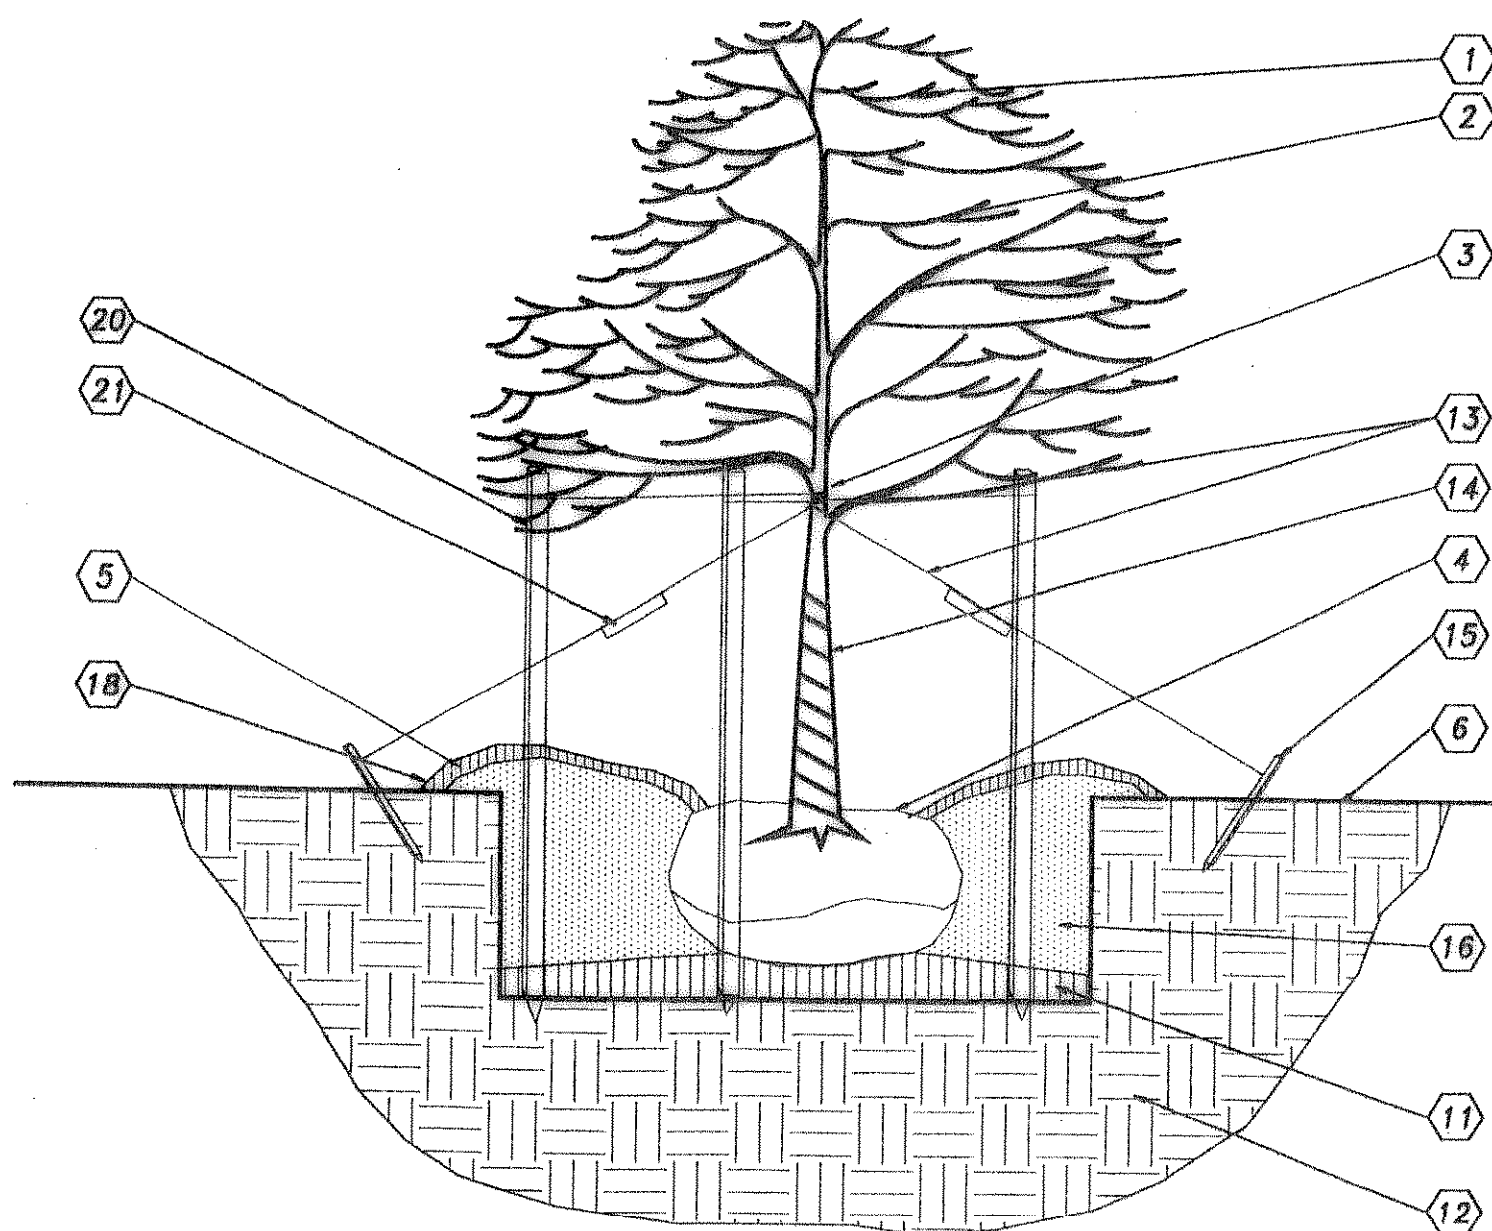


**3 LARGE DECIDUOUS TREE PLANTING**  
L2 SCALE: 1/4" = 1'-0"

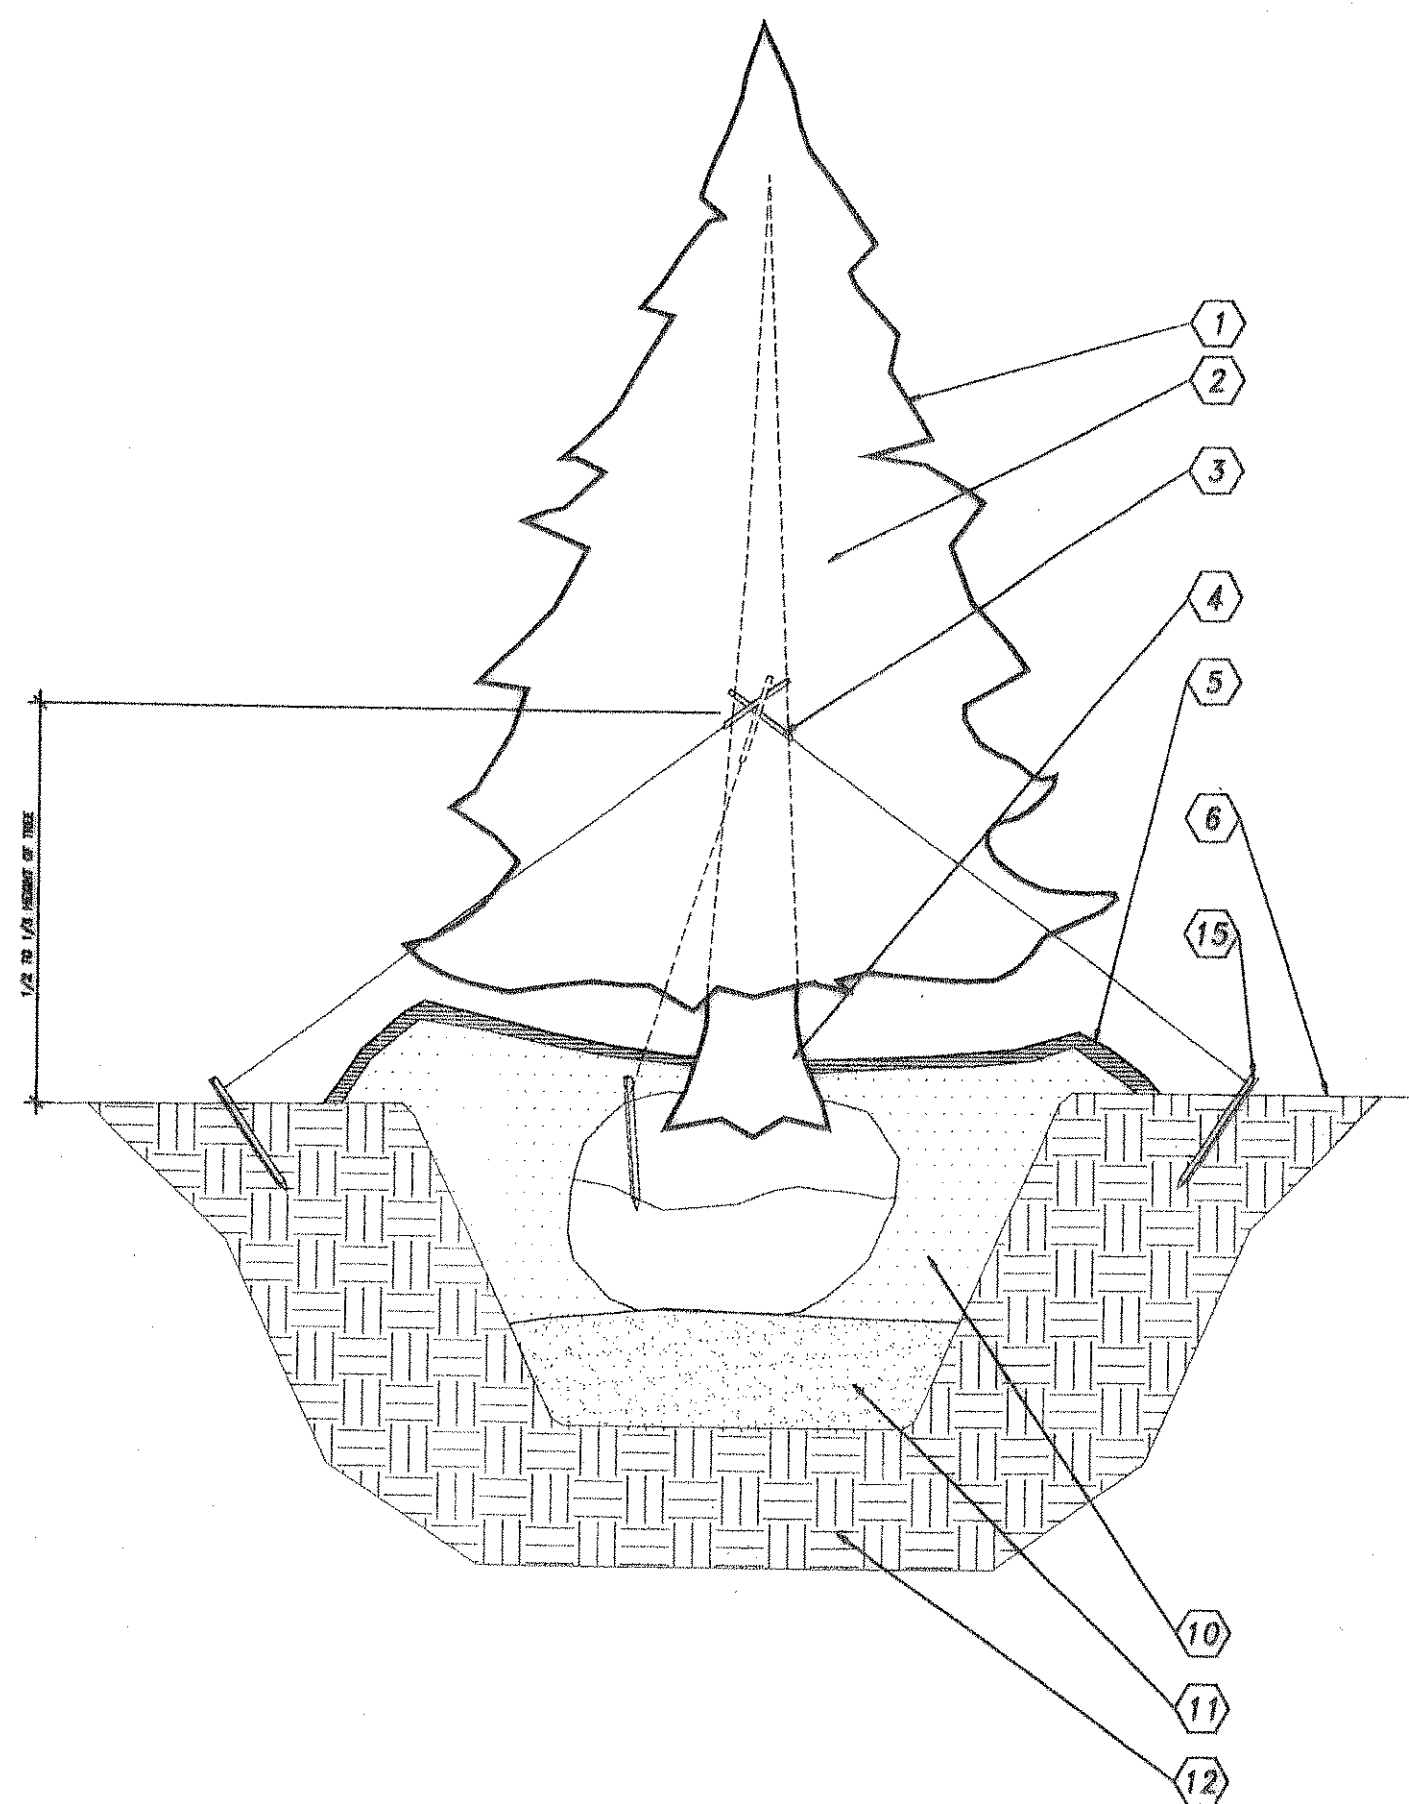


**4 LARGE EVERGREEN TREE PLANTING**  
L2 SCALE: 3/8" = 1'-0"

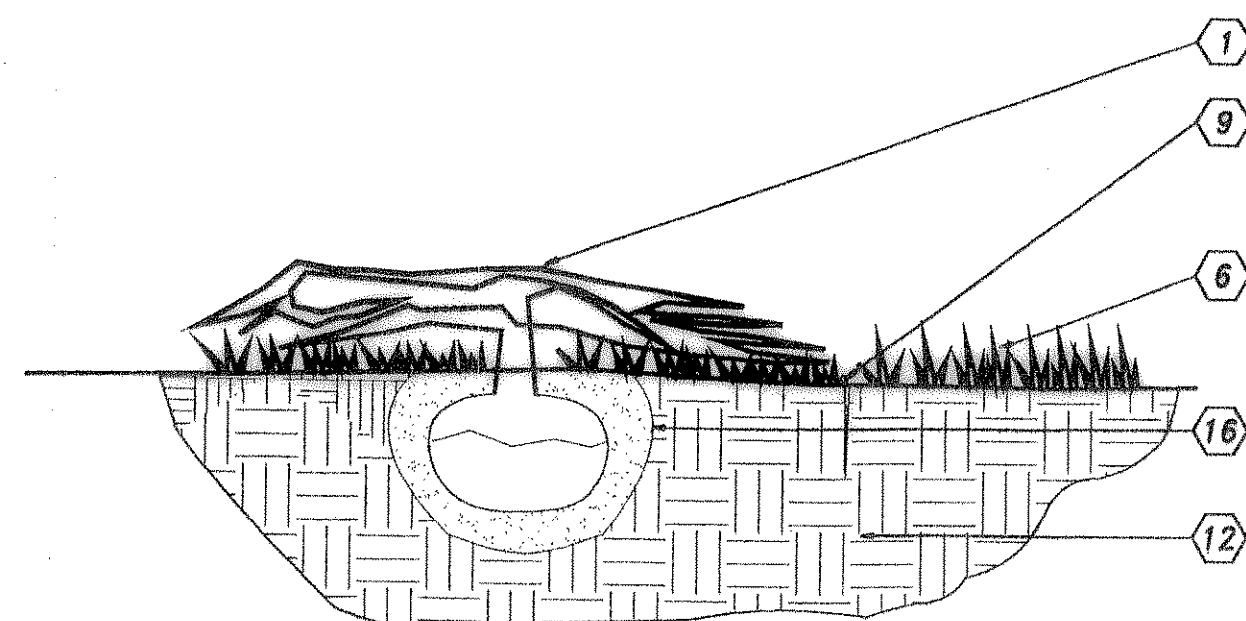

**5 SMALL SHRUB PLANTING**  
L2 SCALE: N.T.S.

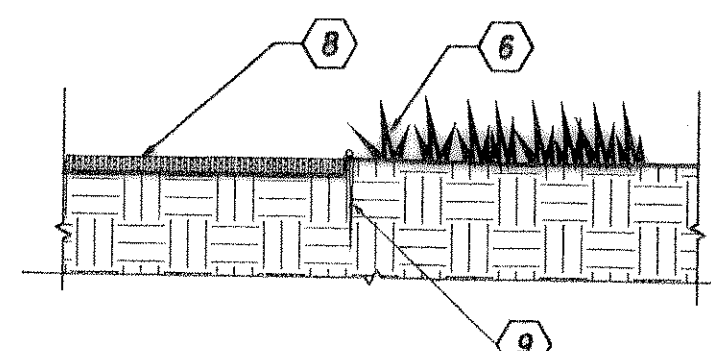

**6 MULCH/LANDSCAPE FABRIC**  
L2 SCALE: 3/8" = 1'-0"

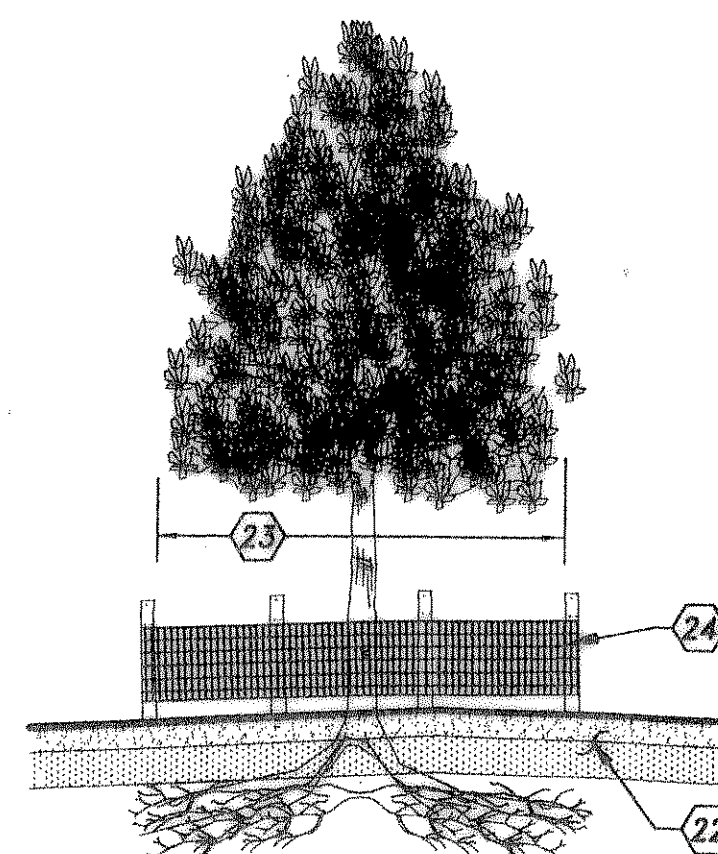

**7 TREE PROTECTION DETAIL**  
L2 SCALE: N.T.S.

## GENERAL NOTES:

- REFER TO PROJECT MANUAL FOR ADDITIONAL REQUIREMENTS.
- COORDINATE WORK WITH OTHER SITE RELATED DEVELOPMENT DRAWINGS.

## LANDSCAPE DETAIL KEY NOTES:

- PLANTING, REFER SCHEDULE FOR TYPE.
- SET TREE LEVEL & PLUM - STRAIGHTEN AFTER SETTLEMENT IF REQUIRED
- ENCASE WIRE AROUND TRUNK IN BLACK RUBBER. MOVE UP ABOVE EQUAL TO 1/2 TO 1/3 HEIGHT OF TREE
- SET TREE WITH TOP 1/3 OF ROOT ABOVE FINISH GRADE
- REFER TO LANDSCAPE PLAN FOR GROUND COVER TYPE AND LOCATIONS. PROVIDE 3" DEEP 5/8" CREEK GRAVEL OVER FILTER FABRIC - OR - 3" TO 4" SHREDDED CYPRESS MULCH OVER FILTER FABRIC.
- LAWN AREA
- REFER TO SITE GRADING PLAN FOR SLOPE. PLACE THREE PINS EVERY 2'-0", SPACING EQUALLY. SEE SPEC'S FOR ACCEPTABLE SOD VARIETIES.
- 3" DEEP 5/8" CREEK GRAVEL OR 3" SHREDDED CYPRESS MULCH OVER FILTER FABRIC
- 4" BLACK POLY VINYL EDGING
- PREFERRED SOIL
- COMPACTED PLANTING
- SUBGRADE
- TWO STRANDS OF WIRE
- TRUNK WRAP
- 2" x 2" x 10" WOOD STAKES BURY BELOW FINISH GRADE
- PREPARED PLANTING MIXTURE
- TREES 6'-0" IN HEIGHT OR LESS SHALL BE STAKED
- EXTENTS OF PLANTING BERM TO HOLD WATER
- TREES TALLER THAN 6'-0" TO BE TIED
- 2" x 4" STAKE - OR - METAL FENCE POST
- 1" x 4" x 10" WHITE WOOD FLAG
- EXISTING SOIL/GRADE
- DRIPLINE OF EXISTING TREE/SHRUB
- CHAIN LINK PROTECTIVE FENCE

**RECORD DRAWING**  
DATE: 02/02/2006


**CASCO**  
10877 WATSON ROAD  
ST. LOUIS, MO 63127  
PROJECT MANAGERS

ISSUED FOR PERMIT:	
ISSUED FOR BID:	
REVISIONS:	
NO. #	DATE
REMARKS:	
REV. 1	5/05/04
ENGINEERING PLANS RESUBMITTAL	
REV. 2	5/28/04
ENGINEERING PLANS RESUBMITTAL	
REV. 3	11/11/04
ENGINEERING PLANS RESUBMITTAL	
REV. 4	12/30/04
ENGINEERING PLANS RESUBMITTAL	

**O'Reilly** **AUTO PARTS**

PROJECT:  
**NEW O'REILLY AUTO PARTS STORE**  
**RIDGE ROAD**  
**ROCKWALL, TEXAS**

233 SOUTH PATTERSON  
SPRINGFIELD, MO 65802  
PHONE: (417) 862-3333

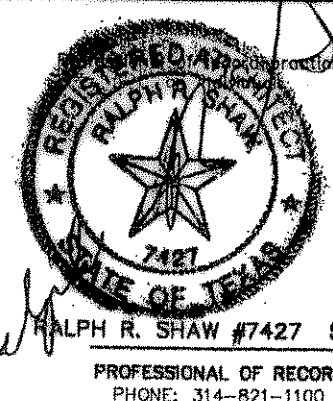

JOB NO.: 904522  
DRAWN: MAD  
CHECKED: CRM  
DATE: 3/01/04  
SCALE: AS NOTED  
SHEET:

**L2**

LANDSCAPE DETAILS