


CAC SENIOR LIVING, LLC. ROCKWALL BY-PASS ADDITION

PROJECT TITLE:

OAC SENIOR LIVING, LLC.
ROCKWALL BY-PASS ADDN.

mycoskie+mcinnis+associates
civil engineering surveying tandscape architecture plannin
the registration number: f - 2759
200 east abram

200 east abram
arlington, texas 76010
817-469-1671
fax: 817-274-8757
www.mmatexas.com

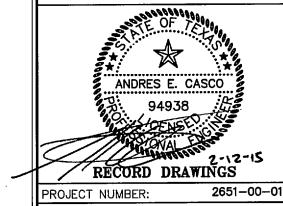

PROJECT MANAGER:

DRAWN BY:

CHECKED BY:

A. CASCO

ISSUE DATE:

O4/30/2013

TO THE BEST OF OUR KNOWLEDGE MYCOSKIE MCINNIS ASSOCIATES, INC.

TO THE BEST OF OUR KNOWLEDGE MYCOSKIE MCINNIS ASSOCIATES, INC. HEREBY STATES THAT THIS PLAN IS AS-BUILT. THIS IS BASED ON SURVEY DATA, VISUAL POST-CONSTRUCTION FIELD OBSERVATIONS AND INFORMATION PROVIDED BY THE CONTRACTOR.

02.12.15 RECORD DRAWINGS AE

REV. DATE DESCRIP. BY

SHEET CONTENT:

DRAINAGE

DETAILS

SHEET NO:

COPYRIGHT © 2013 MMA, INC.