

- 1. All materials and construction shall conform to the City of Rockwall Plans and Specifications, except as noted herein and approved by the City.
- Contractor shall be responsible for maintaining trench safety requirements in accordance with City Standards, Texas State Law, and O.S.H.A. Standards for all excavation in excess of five feet in depth.
- 3. The location of all utilities located on these plans are taken from existing public records. The exact location and elevation of all public utilities must be determined by the Contractor. It shall be the duty of the Contractor to ascertain whether any additional facilities other than those shown on the plans may be present.
- 4. It will be the responsibility of the Contractor to protect all public utilities in the construction of this project. All manholes, cleanouts, valve boxes, fire hydrants, etc. must be adjusted to proper line and grade by the Contractor prior to and after the placing of permanent paving. Utilities must be maintained to proper line and grade during construction of the paving for this development.
- 5. Contractor shall revegetate all disturbed areas.
- 6. All earthwork operations, pavement installation, etc. shall conform to the Geotechnical Investigation recommendations.

## GRADING LEGEND


Proposed Spot Elevation Proposed Contour **Existing Contour** Existing Spot Elevation

## DRAINAGE CRITERIA

Tc = 10 Min. $I_{100} = 9.8 \text{ in./Hr.}$ C = 0.9


## <u>DRAINAGE LEGEND</u>

(0.64) Area in Acres  $Q_{100} = In CFS$ Drainage Divide Direction Of Flow

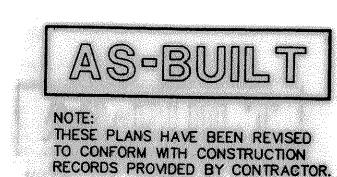


## BENCH MARK:

City of Rockwall GPS Monument #7 Located east of Mims Road along southerly side of Interstate Hwy. 30. Elevation: 566.25

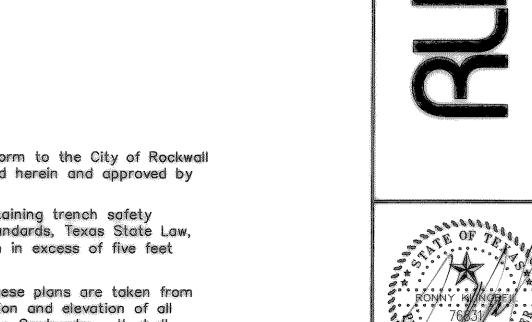

**ENGINEB** • HILEN, Texas 75002 972-359-1733 Fax 972-359-1833

BLOCK A -ROCKWALL LOT 2, HOME DEPOT-1 ROCK

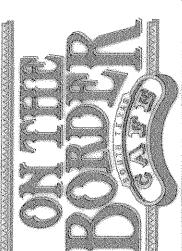

	. 6454
Revisions:	Date
1	
2	
3	
4	
5	
6	
7	
8	
9	
10	
Issue Dates:	
10/01/98	

10/26/98 1/19/99

Scale: 1" = 20" 

Checked by: ALK Project No. 98046

Sheet

**C** 4 of

