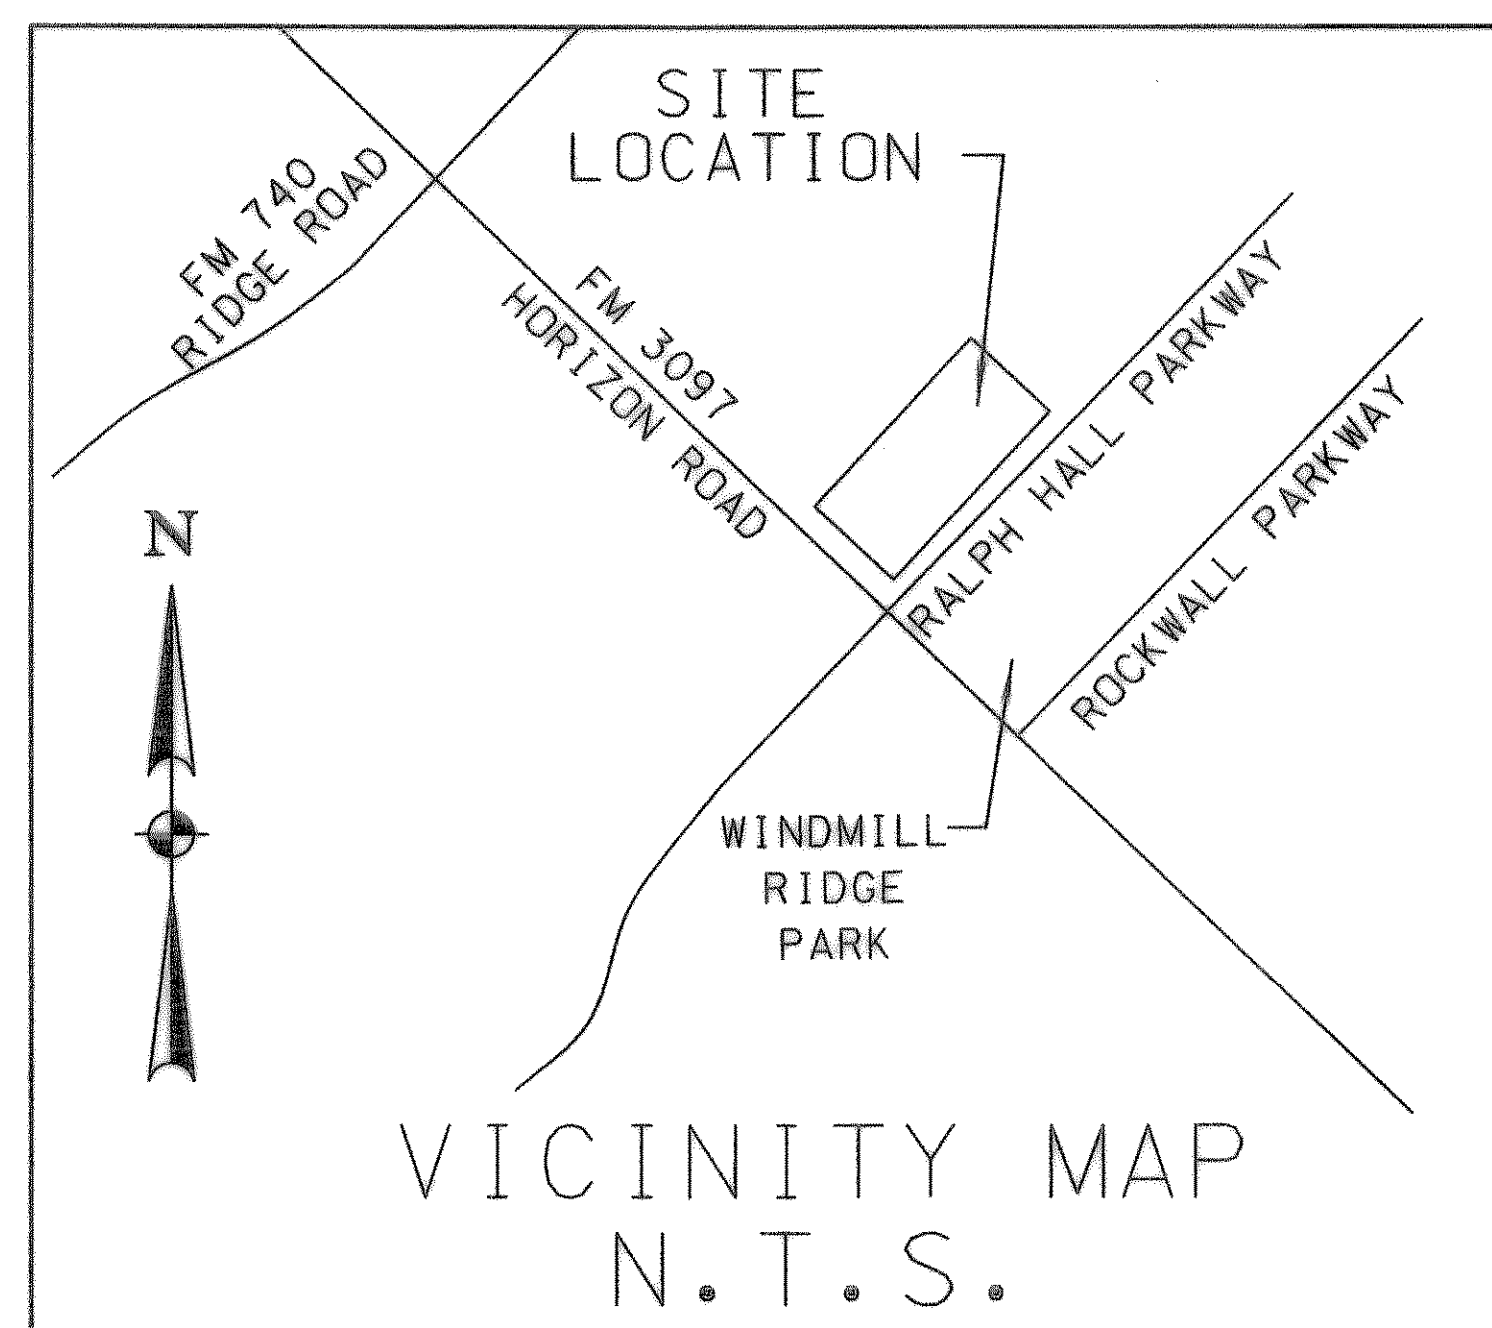
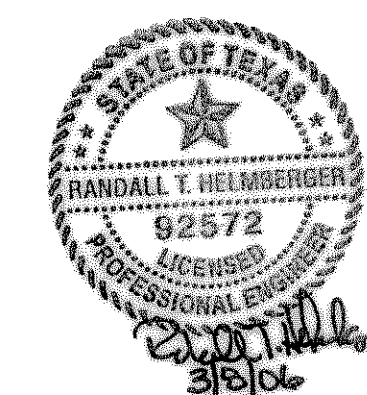


PAPILLION SALON
ON VILLAGE ADDTION, LOT 3 BLOCK 1
, DRAINAGE & UTILITY IMPROVEMENTS
CITY OF ROCKWALL, TEXAS

MR. CECIL HASTINGS
732 WINDSONG
ROCKWALL, TEXAS 75032
PH: 214-923-9052

MATTHEW KING, AIA
ROCKWALL, TEXAS, 75087
PH: 972-772-7995

HELMBERGER ASSOCIATES, INC.
124 HOOPER ROAD
WYLIE, TEXAS 75098
MR. RANDALL T. HELMBERGER, P.E.
(972) 442-7459

[illegible]

RECORD DRAWING
MARCH 08, 2006