

**ARCHITECT:**  
MATTHEW KING, AIA  
ROCKWALL, TEXAS 75087  
PH. 972-772-7995

ENGINEER:  
HELMBERGER ASSOCIATES, INC.  
124 HOOPER ROAD  
WYLIE, TEXAS 75098  
RANDALL T. HELMBERGER, PE  
(972) 442-7459

RECORD DRAWING  
MARCH 08, 2006


WATER METER SCHEDULE			
TYPE	SIZE	NUMBER	SANITARY SEWER
DOMESTIC	1.5"	1 - PROPOSED	6"
IRRIGATION	1"	1 - PROPOSED	NA

## PAVING AND DIMENSION CONTROL PLAN

## PAPILLION SALON

HORIZON VILLAGE ADDITION, LOT 3 BLOCK 1

ROCKWALL, TEXAS

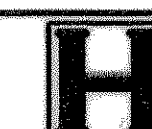

**HELMBERGER ASSOCIATES, INC.**  
CIVIL AND ENVIRONMENTAL ENGINEERS

124 HOOPER ROAD WYLIE TEXAS 75098 (972) 442-7455

DESIGN	DRAWN	DATE	SCALE	NOTES	FILE	NO
HELM.	CADD	DEC. 2005	1"=20'	PBORDER	0477	C

Topography and field surveying provided by Rockwall Surveying Co., Inc.

Asbuilt utilities, paving and drainage information obtained from record drawings on file with the City of Rockwall.