Signing shown for

one direction only.

See BC(2) for

additional advance

signing.



(0.2 - 0.5 MI.)


Work zone speed limits shall be regulatory, established in accordance with the "Procedures for Establishing Speed Zones,"

and approved by the Texas Transportation Commission.

Reduced speeds should only be posted in the vicinity of work activity and not throughout the entire project.

WORK ZONE

LIMIT

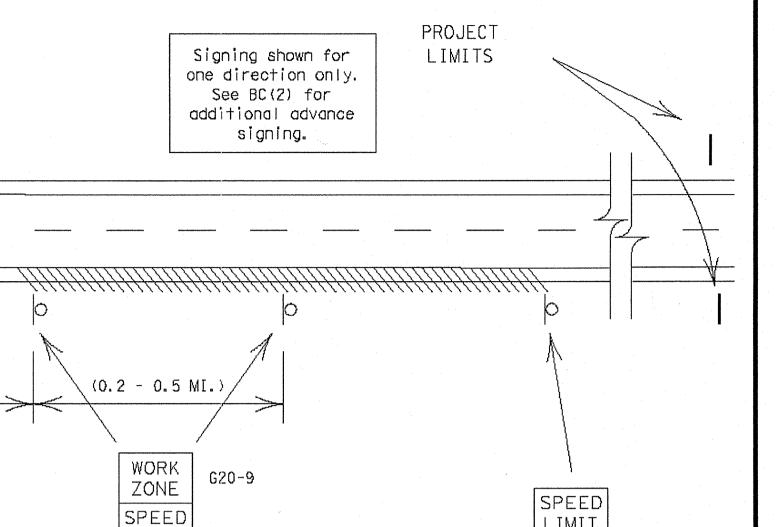

GUIDANCE FOR USE:

PROJECT

LONG/INTERMEDIATE TERM WORK ZONE SPEED LIMITS

This type of work zone speed limit should be included on the design of the traffic control plans when restricted geometrics with a lower design speed are present in the work zone and modification of the geometrics to a higher design speed is not feasible.

G20-9

(0.2 - 0.5 MI.

SPEED

LONG/INTERMEDIATE TERM WORK ZONE SPEED LIMIT signs should be posted and visible to the motorists at all times. Work activity in the area of reduced speed zone should be greater than 12 consecutive hours per day. Work activity may also be defined as a change in the roadway that requires a reduced speed for motorists to safely negotiate the work area, including:

- a) rough road or damaged pavement surface
- b) substantial alteration of roadway geometrics (diversions)
- c) construction detours
- d) grade
- e) width

f) other conditions readily apparent to the driver As long as any of these conditions exist, the work zone speed limit signs should remain in place.

SHORT TERM WORK ZONE SPEED LIMITS

This type of work zone speed limit should be included on the design of the traffic control plans when workers or equipment are not behind concrete barrier, work activity is within 15 feet of pavement edge or actually on the pavement.

SHORT TERM WORK ZONE SPEED LIMIT signs should be posted and visible to the motorists only when work activity is present. Work activity in the area of reduced speed should be less than 12 consecutive hours. When work activity is not present, signs should be covered with an approved sign cover or removed from work area.

- 1500')

- 1. Regulatory work zone speed limits should be used only for sections of construction projects where speed control is of major importance. Regulatory work zone speed signs (R2-1) should be removed during periods when they are not needed to minimize interference with traffic.
- 2. Regulatory work zone speed limit signs shall be placed on supports at a 7 foot mounting height.
- 3. Speed zone signs are illustrated for one direction of travel and are normally posted for each direction of travel.
- 4. Frequency of speed limit signs should be: 40 mph and greater 0.2 to 2 miles 35 mph and less 0.2 to 1 mile
- 5. Regulatory speed limit signs shall have black legend and border on a white reflective
- 6. Fabrication, errection and maintenance of REDUCED SPEED AHEAD sign. WORK ZONE plague and SPEED LIMIT signs shall not be paid for directly, but shall be considered subsidiary to Item 502.
- 7. Turning signs from view, laying signs over or down will not be allowed, unless other-
- 8. Techniques that may help reduce traffic speeds.
- (In order of effectiveness.) A. Flagger stationed next to sign.
- B. Law enforcement.
- C. Portable changeable message sign (PCMS).
- D. Low-power radar transmitter.
- 9. Refer to "Work Zone Speed Limit Work Sheets 1 and 2" to determine when a construction speed zone should be required.



7 of 12


BC(3) - 03


J		٤		DC (3) 03				
©T×DOT 11-4-02			TWL - :NO	ck:- GRB	D M :	-FDN	ck:- CAL	
REVISIONS	STATE DISTRICT	FEDERAL REGION	FEDERAL A1D PROJECT				SHEET	
		6					-	
	COUNTY			CONTROL	SECTION	108	HIGHWAY	
					%.			

THE CONSTRUCTED WORK, USING INFORMATION AS PROVIDED BY THE CONTRACTORS AND SURVEYED GRADES.

RECORD DRAWING KNOWLEDGE, THE APPROXIMATE LOCATION OF

Kimley-Horn and Associates, Inc.

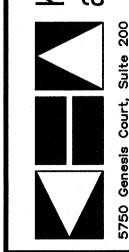

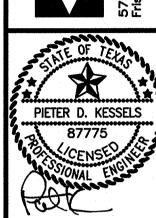

02-27-2008

TXDOT BARRICAD
AND CONSTRUCTION
WORK ZONE SPEED L
STANDARD
BC(3)-03

SHEET **C-35** OF 47