

CIVIL CONSTRUCTION PLANS

PREGNANCY RESOURCE CENTER


1010 RIDGE ROAD

B.J.T. LEWIS SURVEY, ABSTRACT NO. 255

CITY OF ROCKWALL  
ROCKWALL COUNTY, TEXAS

GENERAL NOTES  
(APPLICABLE TO ALL SHEETS)

- Excavated material shall be placed as directed by the Owner.
- Construction shall meet the requirements of the latest revision of the Standards of Design and Standard Details for the City of Rockwall & NTCOG Standards, 3rd Edition.
- All fill areas to be density controlled and compacted to 95% density at optimum moisture content. Compacted with sheep foot roller.
- Pavement thickness and strength shall be as follows:  
Fire Lanes.....6"  
Parking areas.....5"  
Sidewalks.....4"  
3600 psi at 28 days and reinforced with No.3 bar at 24" centers each way using a 6 sack mix for machine pour and a 6-1/2 sack mix for hand pour.
- All subgrade of proposed parking shall be compacted to 95% standard proctor density. All general fill material to be compacted with a sheepfoot roller.
- It shall be the responsibility of the Contractor to locate and verify all existing utilities prior to the beginning of construction to insure no conflicts between all utility lines.
- All handicap ramps shall be installed with paving.
- Contractor is responsible for acquiring NTCOG 3rd Edition and Rockwall Standards and Details.

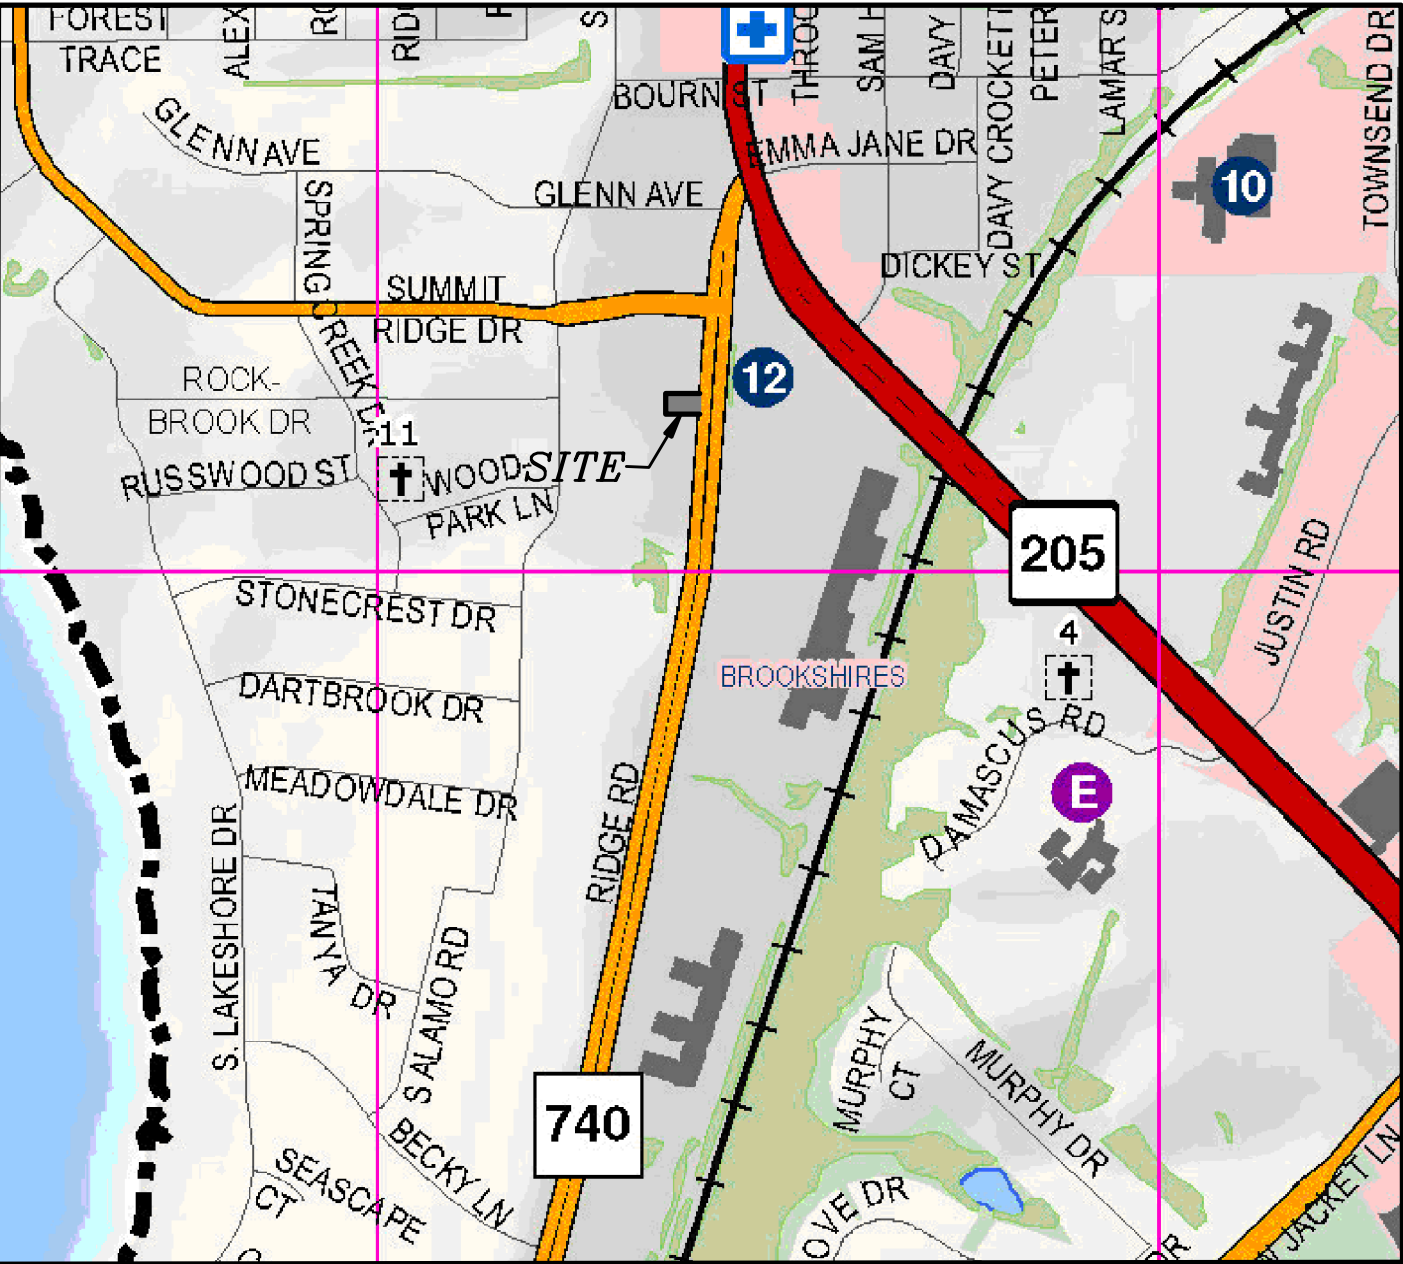

LOCATION MAP  
NTS

INDEX

ITEM	SHEET
COVER.....	1
PLAT.....	2-3
SITE PLAN.....	4
DIMENSION CONTROL.....	5
GRADING AND PAVING.....	6
DRAINAGE AREA MAP.....	7
DETENTION CALCULATIONS....	8
EROSION CONTROL.....	9
HIGHWAY PERMIT.....	10

CAUTION!!!

UNDERGROUND UTILITIES

EXISTING UTILITIES AND UNDERGROUND FACILITIES INDICATED ON THESE PLANS HAVE BEEN LOCATED FROM REFERENCE INFORMATION SUPPLIED BY THE VARIOUS OWNERS OF THE FACILITIES. THE ENGINEER DOES NOT ACCEPT THE RESPONSIBILITY FOR THE UTILITY LOCATIONS SHOWN. IT SHALL BE THE RESPONSIBILITY OF THE CONTRACTOR TO VERIFY BOTH HORIZONTALLY AND VERTICALLY THE LOCATION OF ALL EXISTING UTILITIES AND UNDERGROUND FACILITIES PRIOR TO CONSTRUCTION, TO TAKE NECESSARY PRECAUTIONS IN ORDER TO PROTECT ALL FACILITIES ENCOUNTERED, AND TO NOTIFY THE ENGINEER PROMPTLY OF ALL CONFLICTS OF THE WORK WITH EXISTING FACILITIES. THE CONTRACTOR SHALL PRESERVE AND PROTECT ALL EXISTING FACILITIES FROM DAMAGE DURING CONSTRUCTION. ANY DAMAGE BY THE CONTRACTOR TO EXISTING UTILITIES SHALL BE REPAIRED BY THE CONTRACTOR AT HIS/HER EXPENSE.


GENERAL NOTES  
(APPLICABLE TO ALL SHEETS)

- ALL WORKS ON THIS PROJECT/CONTRACT SHALL COMPLY WITH ALL THE REQUIREMENT OF CITY OF ROCKWALL AND AUTHORITIES HAVING JURISDICTION.

BENCHMARK:  
SOUTHEAST CORNER IF INLET ON  
BACK OF CURB ON WEST SIDE OF  
RIDGE ROAD (FM 740) NEAR  
SOUTHEAST PROPERTY CORNER  
ELEV.: 573.55  
BASED ON CITY MONUMENT RMS

REVISED TO CONFORM TO CONSTRUCTION RECORDS.  
\_\_\_\_\_  
DATE: 12/17/15

NOTE:  
CONTRACTOR TO VERIFY IN THE FIELD THE LOCATION OF ALL EXISTING UTILITIES PRIOR TO CONSTRUCTION. INFORMATION PROVIDED WITHIN THESE PLANS DOES NOT RELIEVE THE CONTRACTOR OF THE FULL AND TOTAL RESPONSIBILITY FOR THE PROTECTION OF EXISTING UTILITIES NOR ANY DAMAGES CAUSED BY SAID CONTRACTOR DURING CONSTRUCTION.

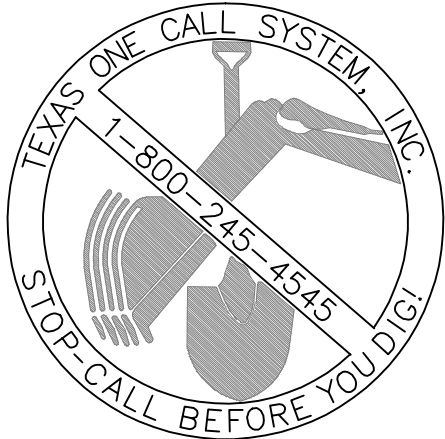

CIVIL ENGINEER  
DOUPHRATE & ASSOCIATES, INC.  
ENGINEERING • PROJECT MANAGEMENT • SURVEYING  
P.O. BOX 1336 ROCKWALL, TEXAS 75087  
PHONE: (972)771-9004 FAX: (972)771-9005

SURVEYOR  
H.D. FETTY LAND SURVEYOR, LLC  
6770 FM 1565  
ROYSE CITY, TEXAS 75189  
(972) 635-2225

Owner  
PREGNANCY RESOURCE CENTER  
713 W. RUSK STREET  
SUITE 101  
ROCKWALL, TEXAS 75087  
(972) 722-8292

