
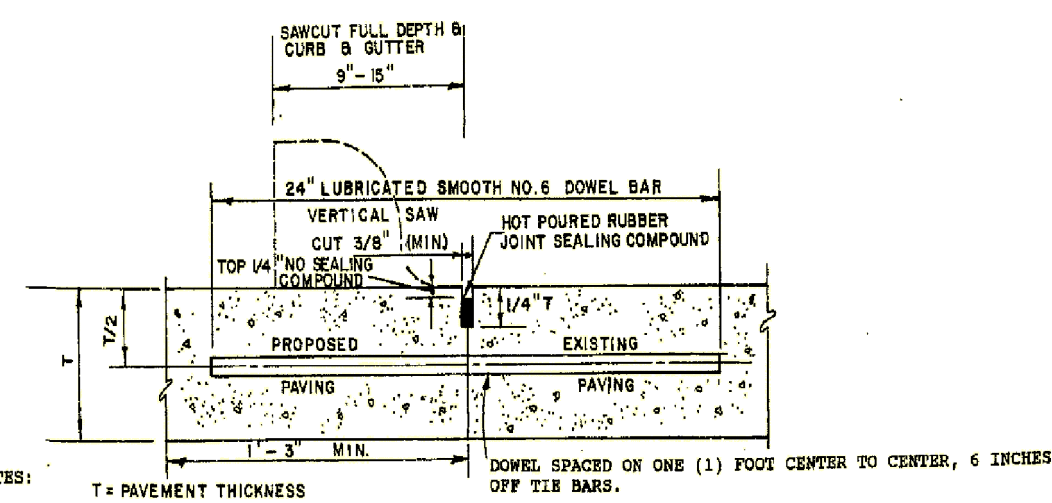


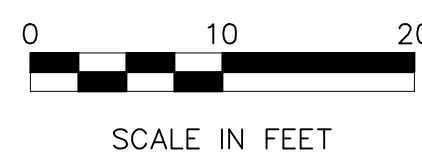

LONGITUDINAL BUTT JOINT

TYPICAL PAVING DETAIL
N.T.S.

SIDEWALK DETAIL
N.T.S.

PRECAST CONCRETE WHEEL STOP
N.T.S.

W. W. Phelps

DATE: 12/17/15

BENCHMARK:
SOUTHEAST CORNER IF INLET ON
BACK OF CURB ON WEST SIDE OF
RIDGE ROAD (FM 740) NEAR
SOUTHEAST PROPERTY CORNER
ELEV.: 573.55
BASED ON CITY MONUMENT RM5

DOUPHRATE & ASSOCIATES, INC.

GRADING AND PAVING PLAN
PREGNANCY RESOURCE CENTER
1010 RIDGE ROAD
CITY OF ROCKWALL
ROCKWALL COUNTY, TEXAS

5 OF 8

CITY CASE NO. SP2015-014